


FWHA REGION NO.	STATE	PROJECT NO.	YEAR	SHEET NO.	TOTAL SHEETS
7	KAN.	87 ER-164 (1)	1974	2	28

P.O.T. Sta 7+02.07
 $\frac{3}{4}$ " Iron Pipe @ P.O.T.
 37.15' N.E. to Chiseled "+" on top curb
 39.03' S.E.
 55.80' E. to $\frac{3}{4}$ " Iron Pipe at back of curb


P.O.T. Sta. 7+57.87
3/4" Iron Pipe @ P.O.T.
16.63' S.E. to nail & cap in Elm tree
30.54' N to Chiseled " on top curb
66.50' S.S.E. to 1/2" rebar, R-43 flood control trav.

P.O.T. Sta. 12+38.97
3/4" Iron Pipe @ P.O.T.
73.72' N.W. to 3/4" Iron Pipe prop cor.
81.72' N.E. to Chiseled " on top ret wall
60.50' S. to Fence corner post

P.O.T. Sta. 16+08.97 DAKB 574005
3/4" Iron Pipe @ P.O.T.
69.40' N. to Chiseled "prop. & or
22.72' N.E. " " near fire plug
56.76' S.E. " " on top curb
(West of Waco)

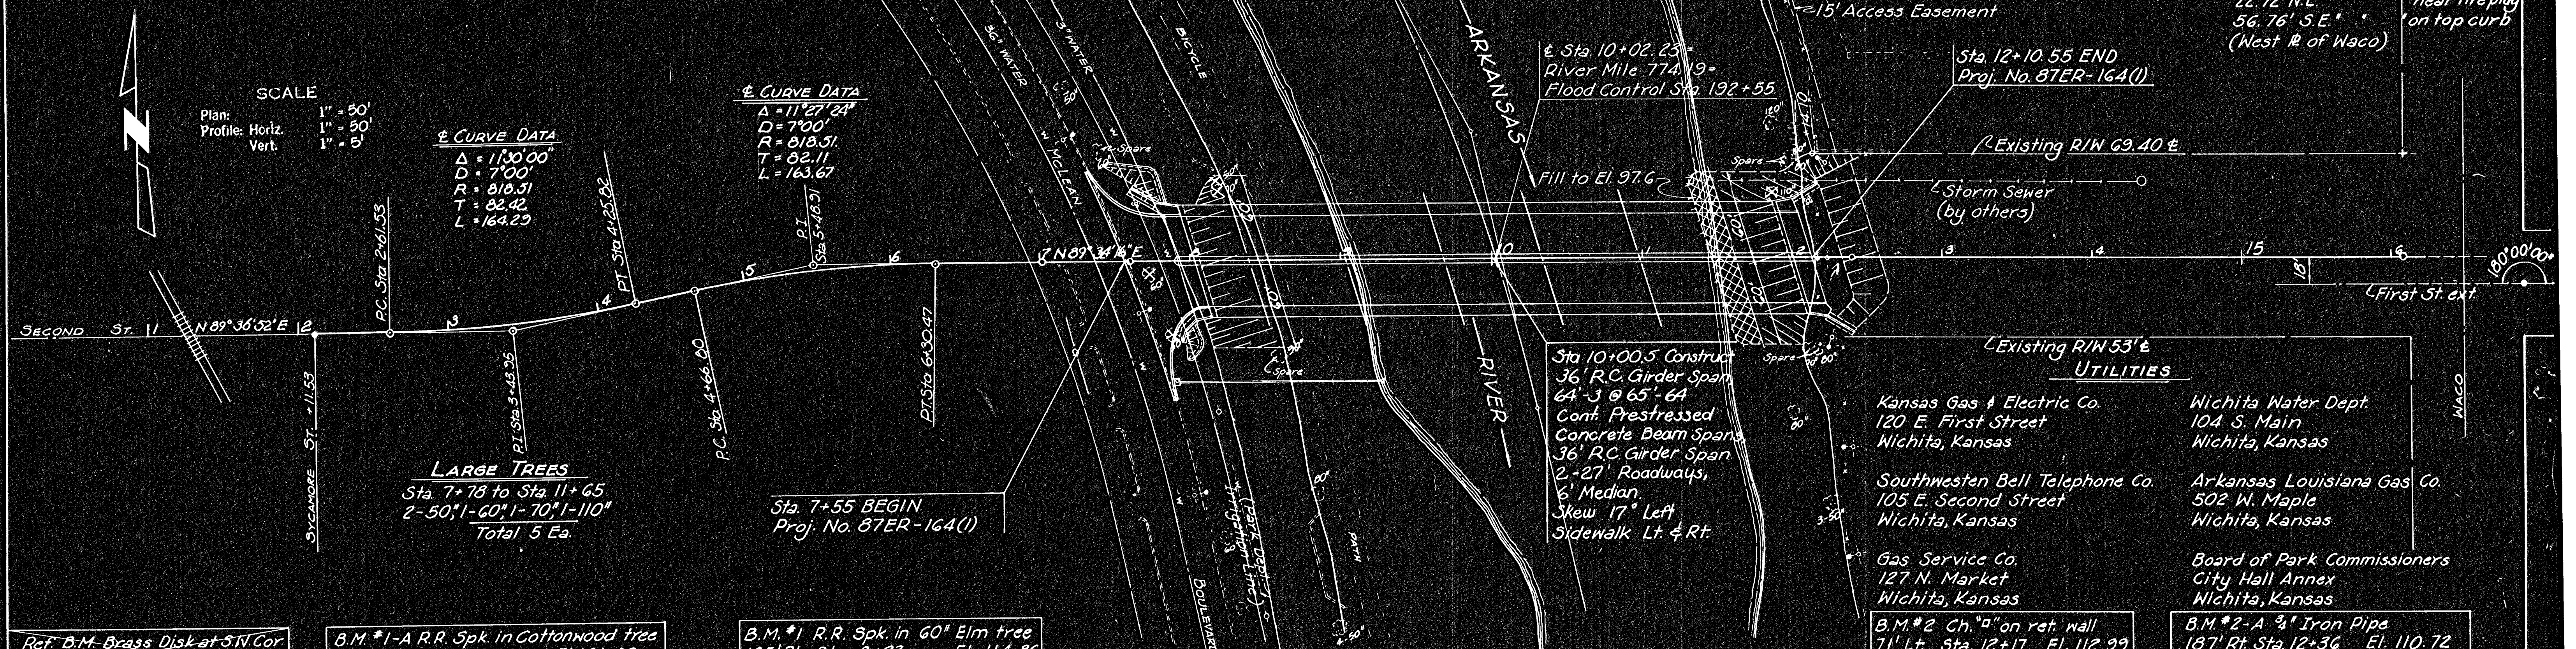

Ref. B.M. Brass Disk at S.W. Cor 2 nd St Bridge El. 44.48	B.M. #1-A R.R. Spk. in Cottonwood tree 193' Lt. Sta. 7+44 El. 101.28	B.M. #1 R.R. Spk. in 60" Elm tree 185' Rt. Sta. 8+23 El. 114.86	B.M. #2 Ch. " on ret. wall 71' Lt. Sta. 12+17 El. 112.99	B.M. #2-A 4" Iron Pipe 187' Rt. Sta. 12+36 El. 110.72
---	---	--	---	--

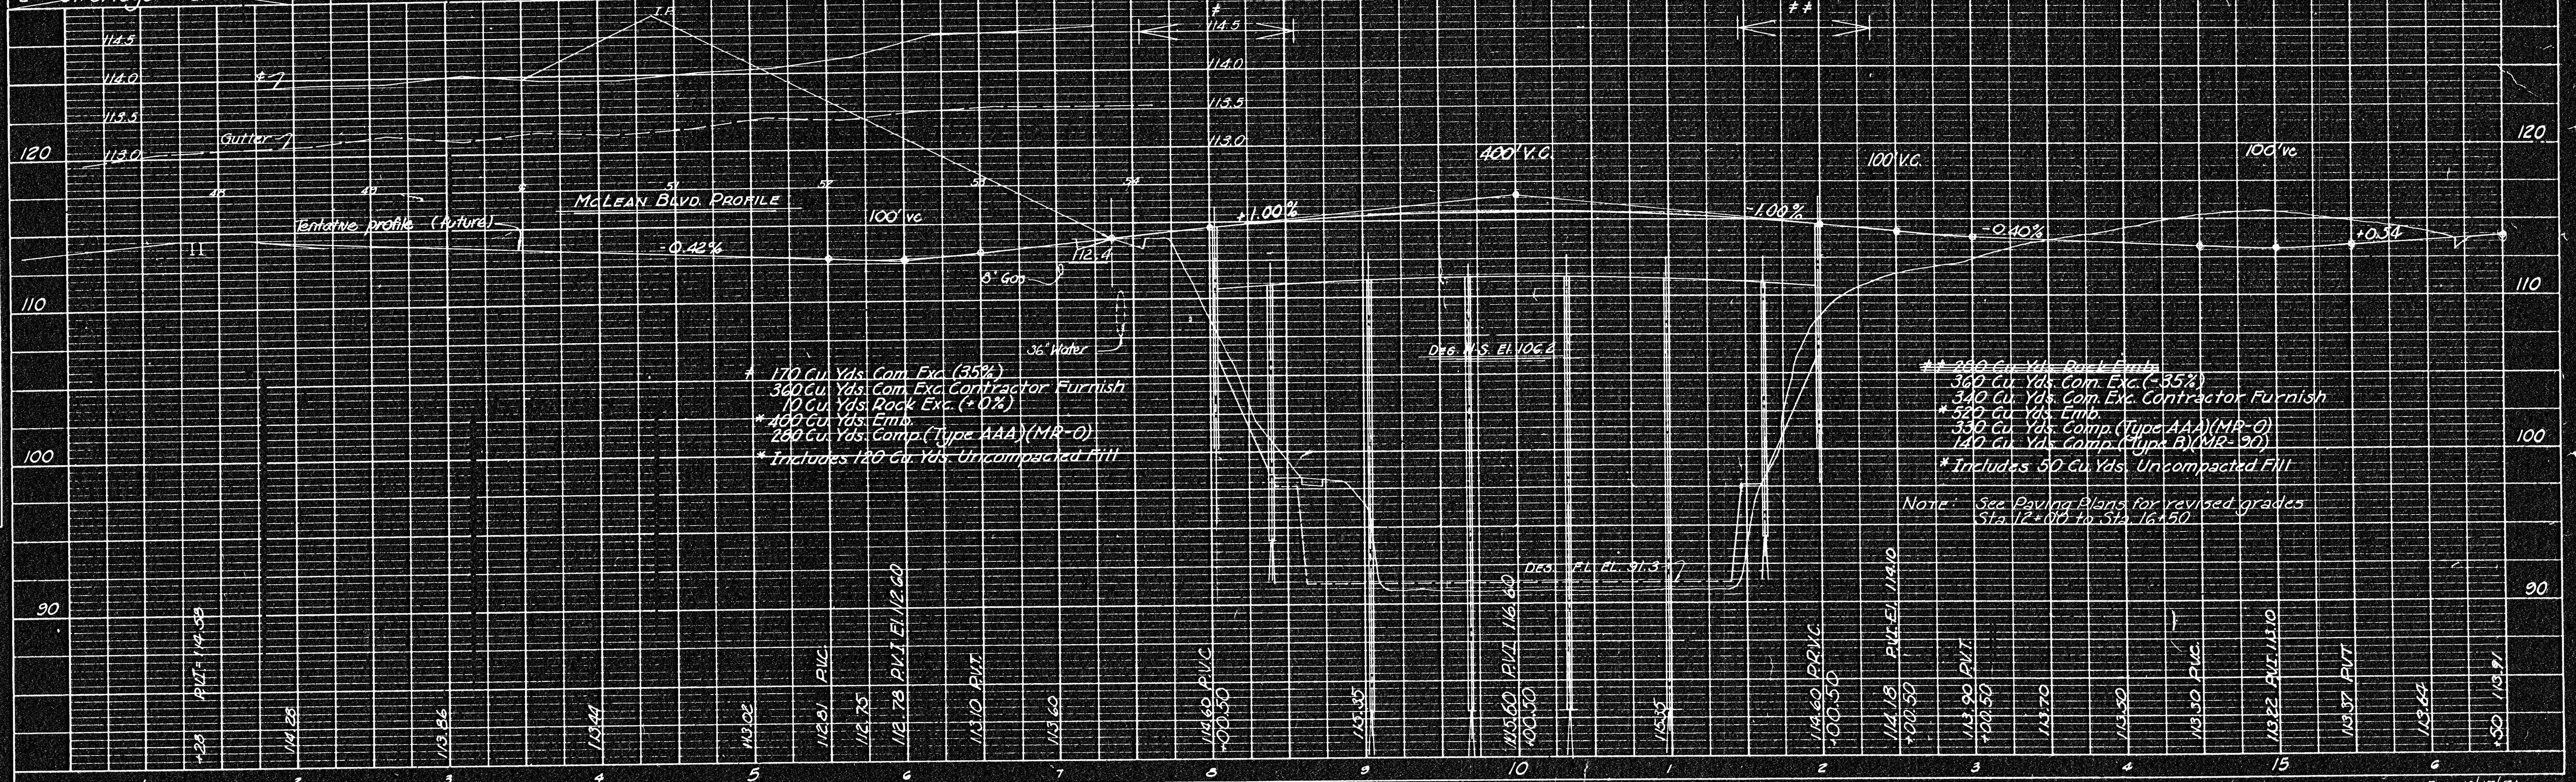

Rev. 12/17/74