


PLAN ROAD DIV. NO.	STATE	PROJECT NO.	FISCAL YEAR	SHEET NO.	TOTAL SHEETS
3	KANSAS	235-87-135 (1/51) 10th St.	1958	10	187

Revised 3/3/58

DATE	BY	CHKD.
12-22-57		

DATE	BY	CHKD.
12-22-57		

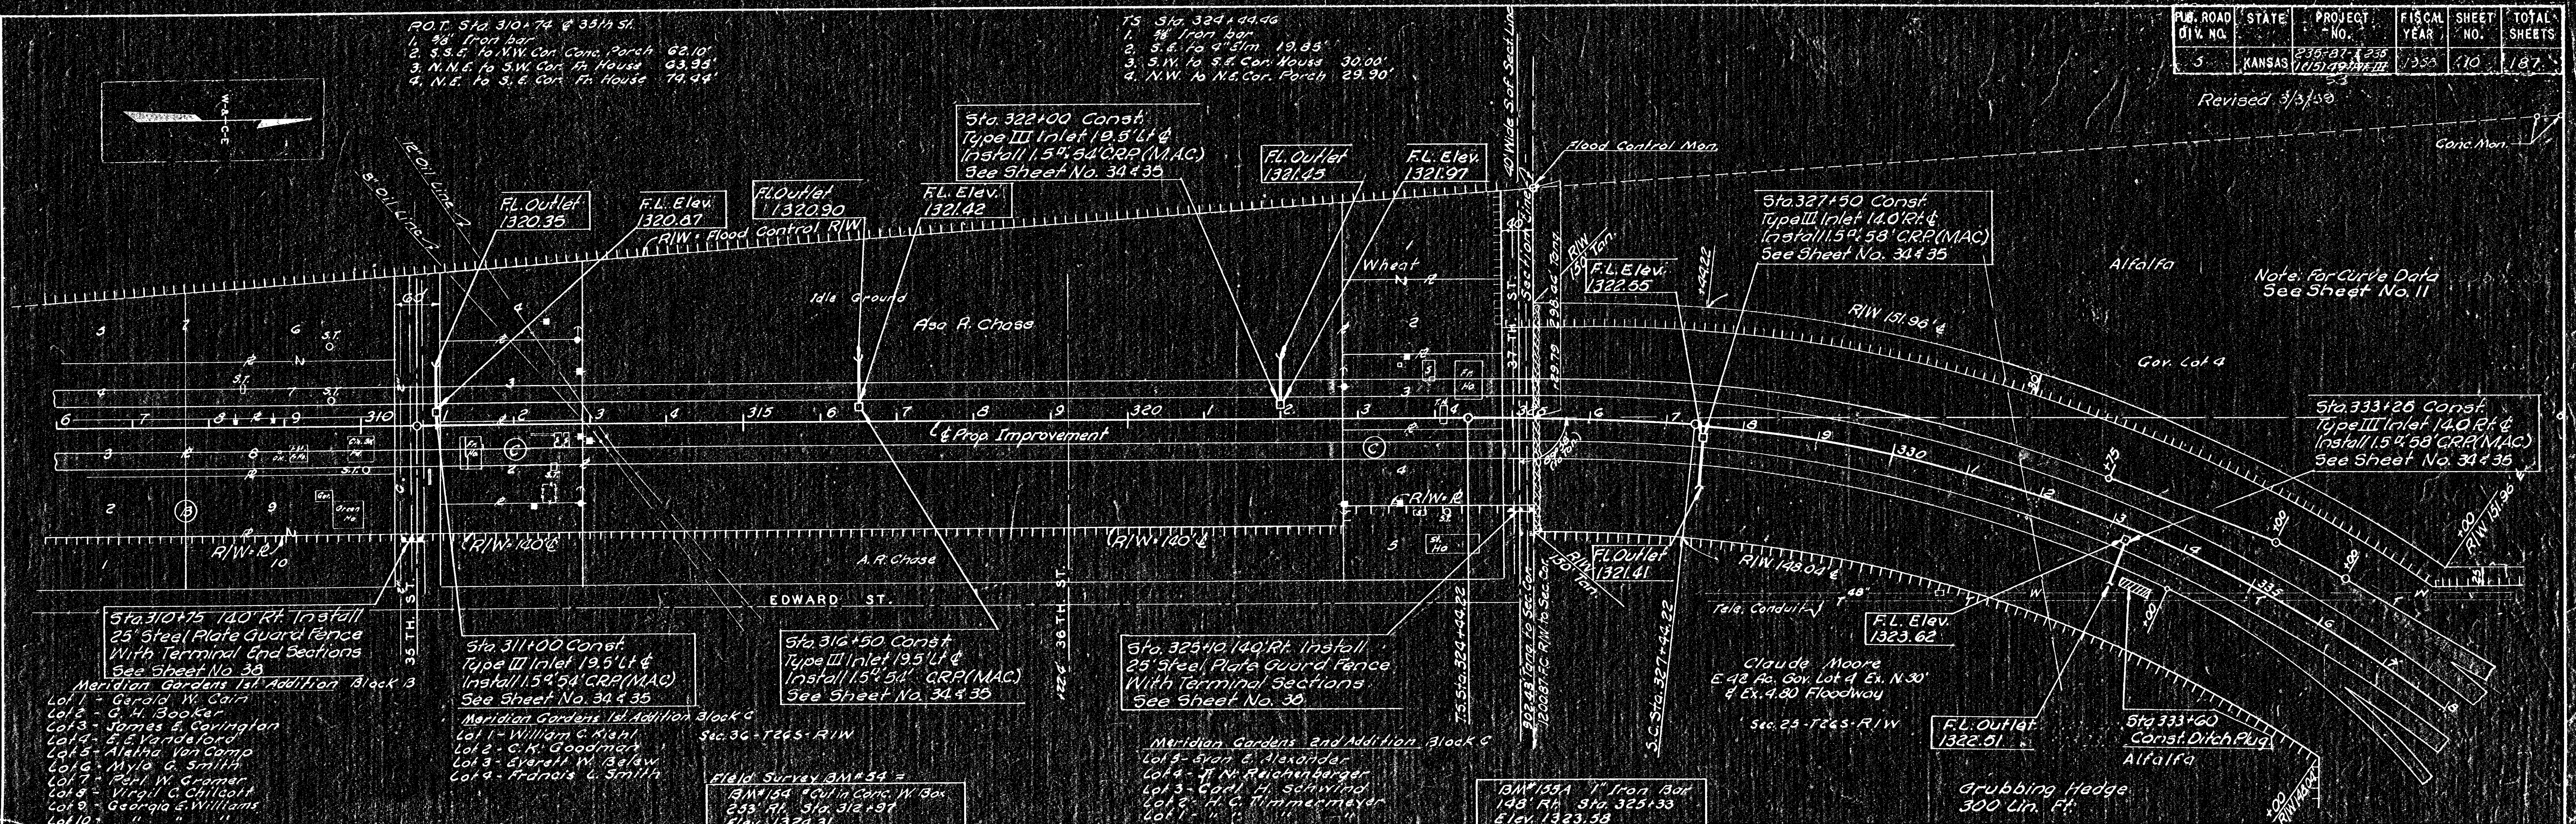

DATE	BY	CHKD.
12-22-57		

DATE	BY	CHKD.
12-22-57		

