


P. H. W. A. REGION NO.	STATE	PROJECT NO.	FISCAL YEAR	SHEET NO.	TOTAL SHEETS
7	KANSAS	# 35W-87 I 35W-1(3)46	1976	174	304

Construction Phase 3

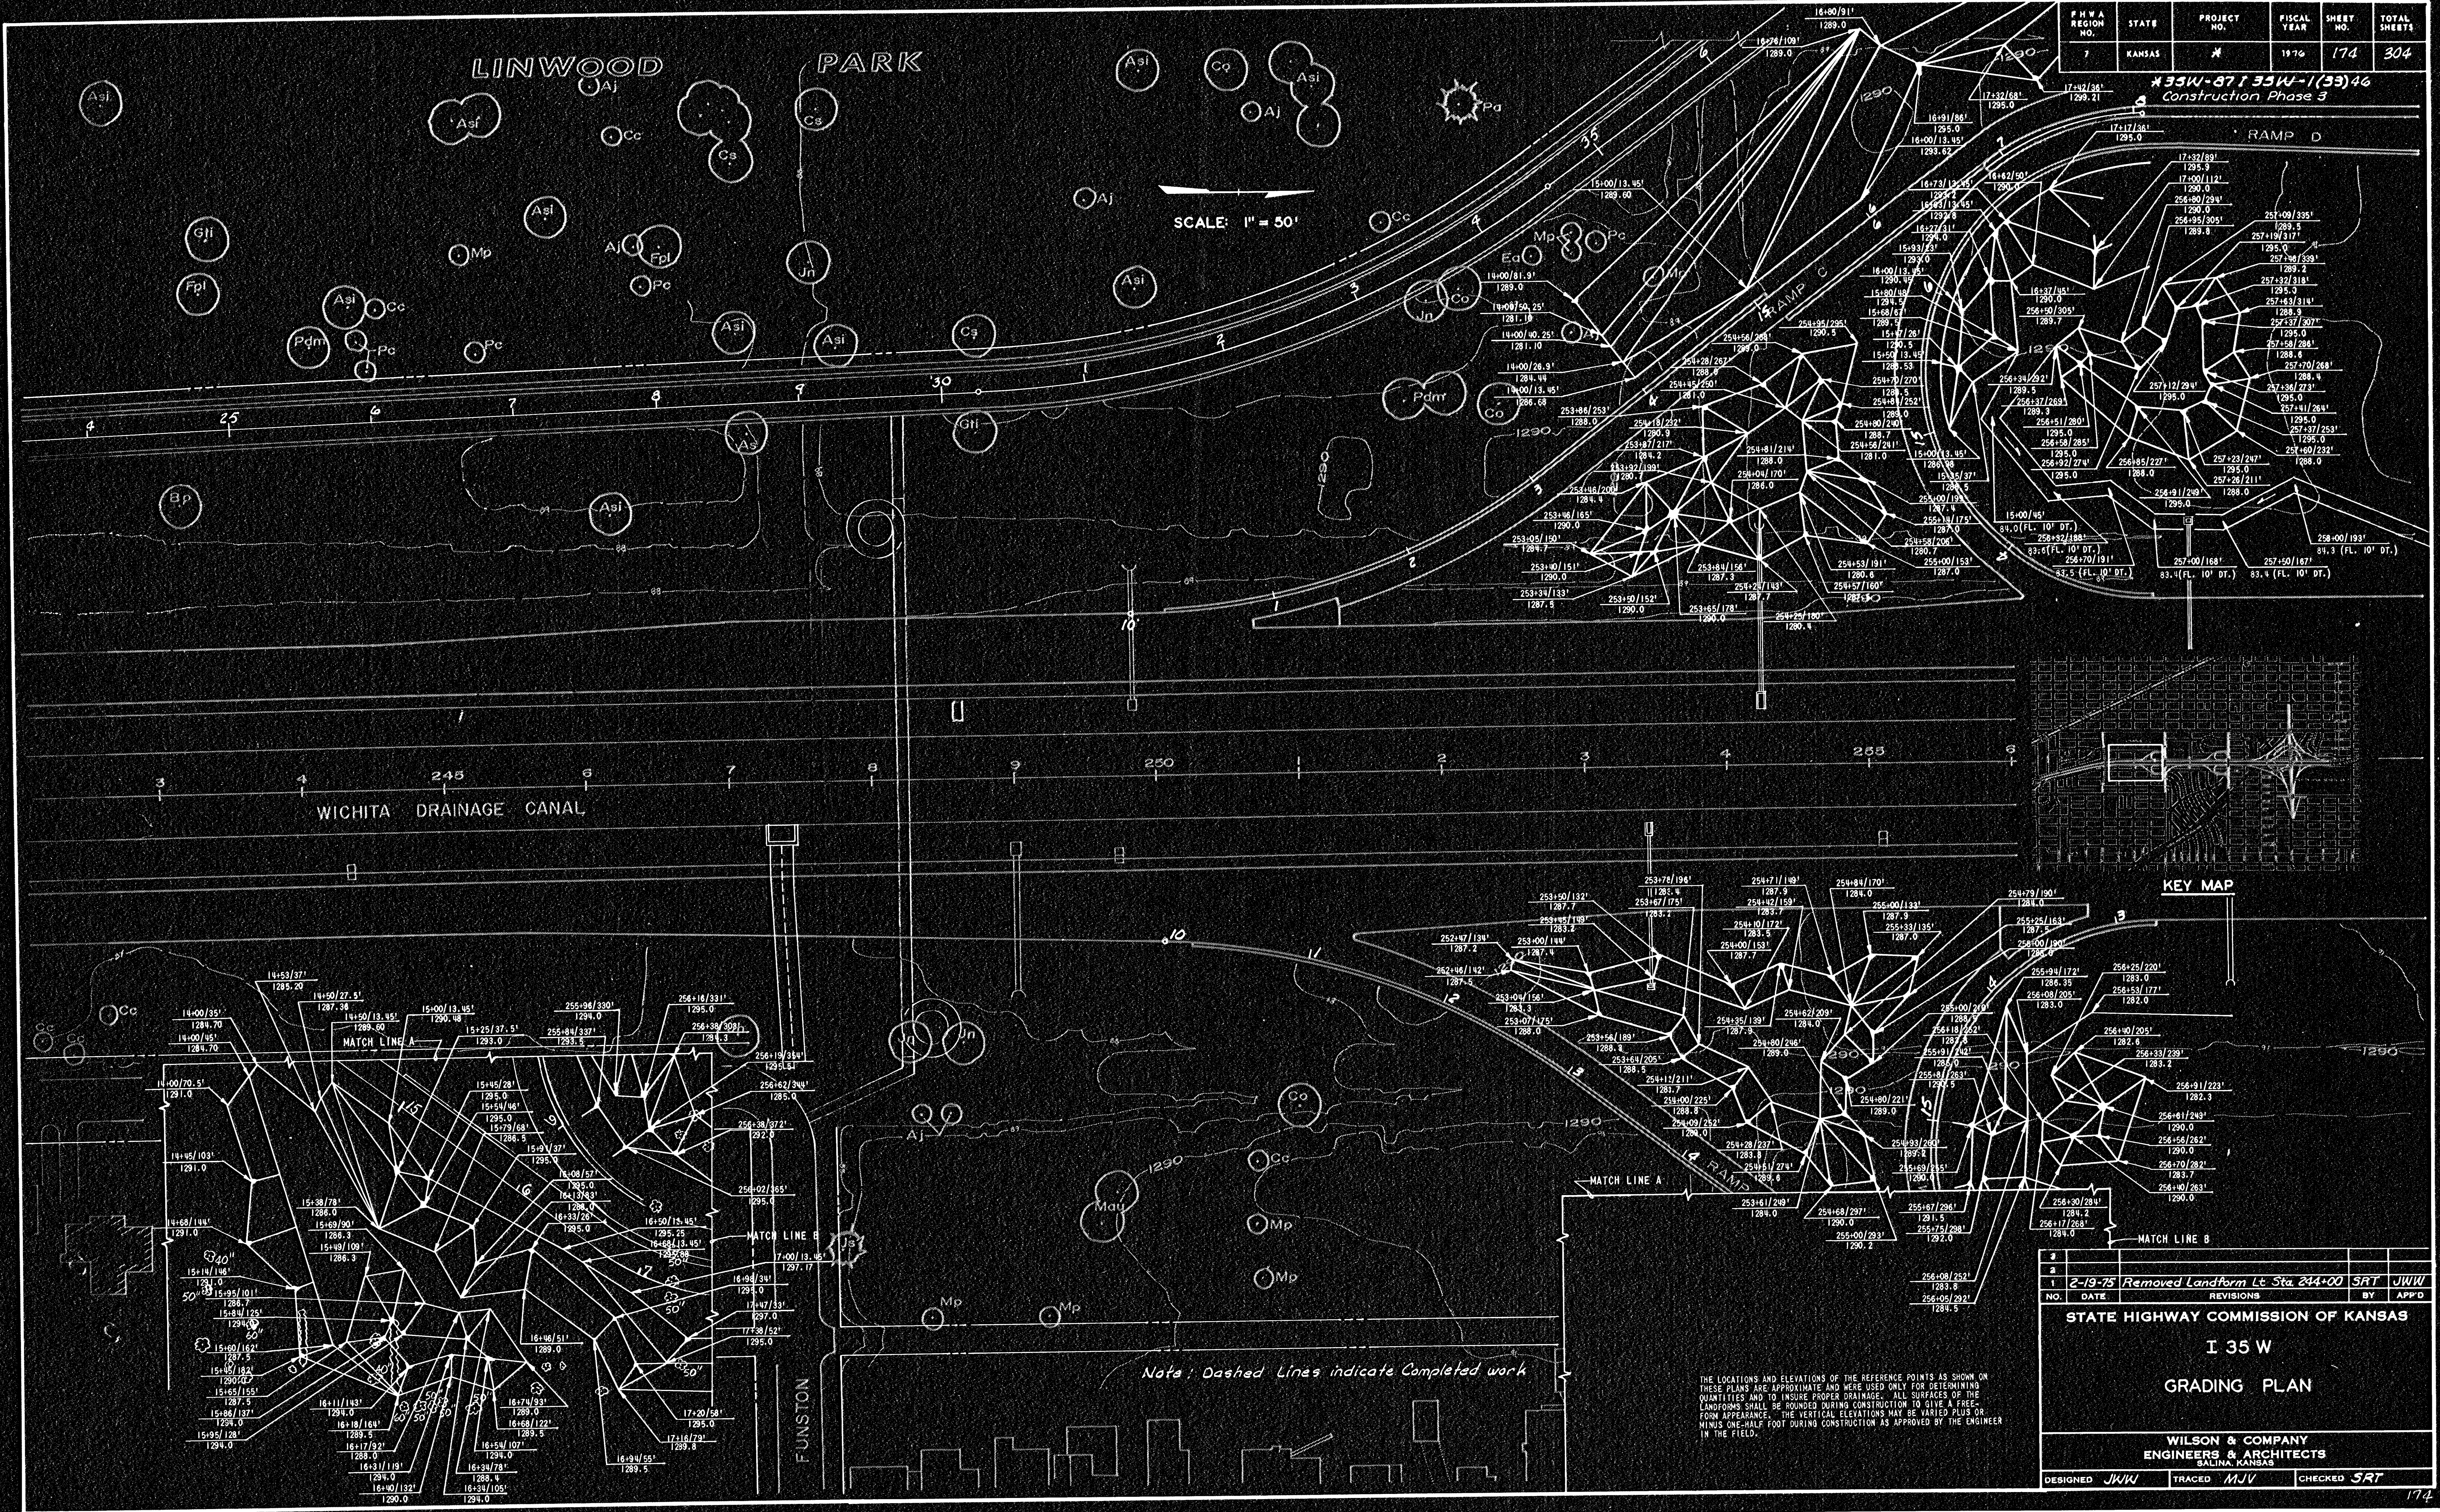

NO.	DATE	REVISIONS	BY	APP'D
1	2-19-75	Removed Landform Lt Sta 244+00 SRT	JWJ	

STATE HIGHWAY COMMISSION OF KANSAS

I 35 W
GRADING PLAN

WILSON & COMPANY
ENGINEERS & ARCHITECTS
SALINA, KANSAS

DESIGNED JWJ TRACED MJV CHECKED SRT

THE LOCATIONS AND ELEVATIONS OF THE REFERENCE POINTS AS SHOWN ON THESE PLANS ARE APPROXIMATE AND WERE USED ONLY FOR DETERMINING QUANTITIES AND TO INSURE PROPER DRAINAGE. ALL SURFACES OF THE LANDFORMS SHALL BE SOUNDED DURING CONSTRUCTION TO GIVE A FREE-FORM APPEARANCE. THE VERTICAL ELEVATIONS MAY BE EITHER PLUS OR MINUS ONE-HALF FOOT DURING CONSTRUCTION AS APPROVED BY THE ENGINEER IN THE FIELD.