
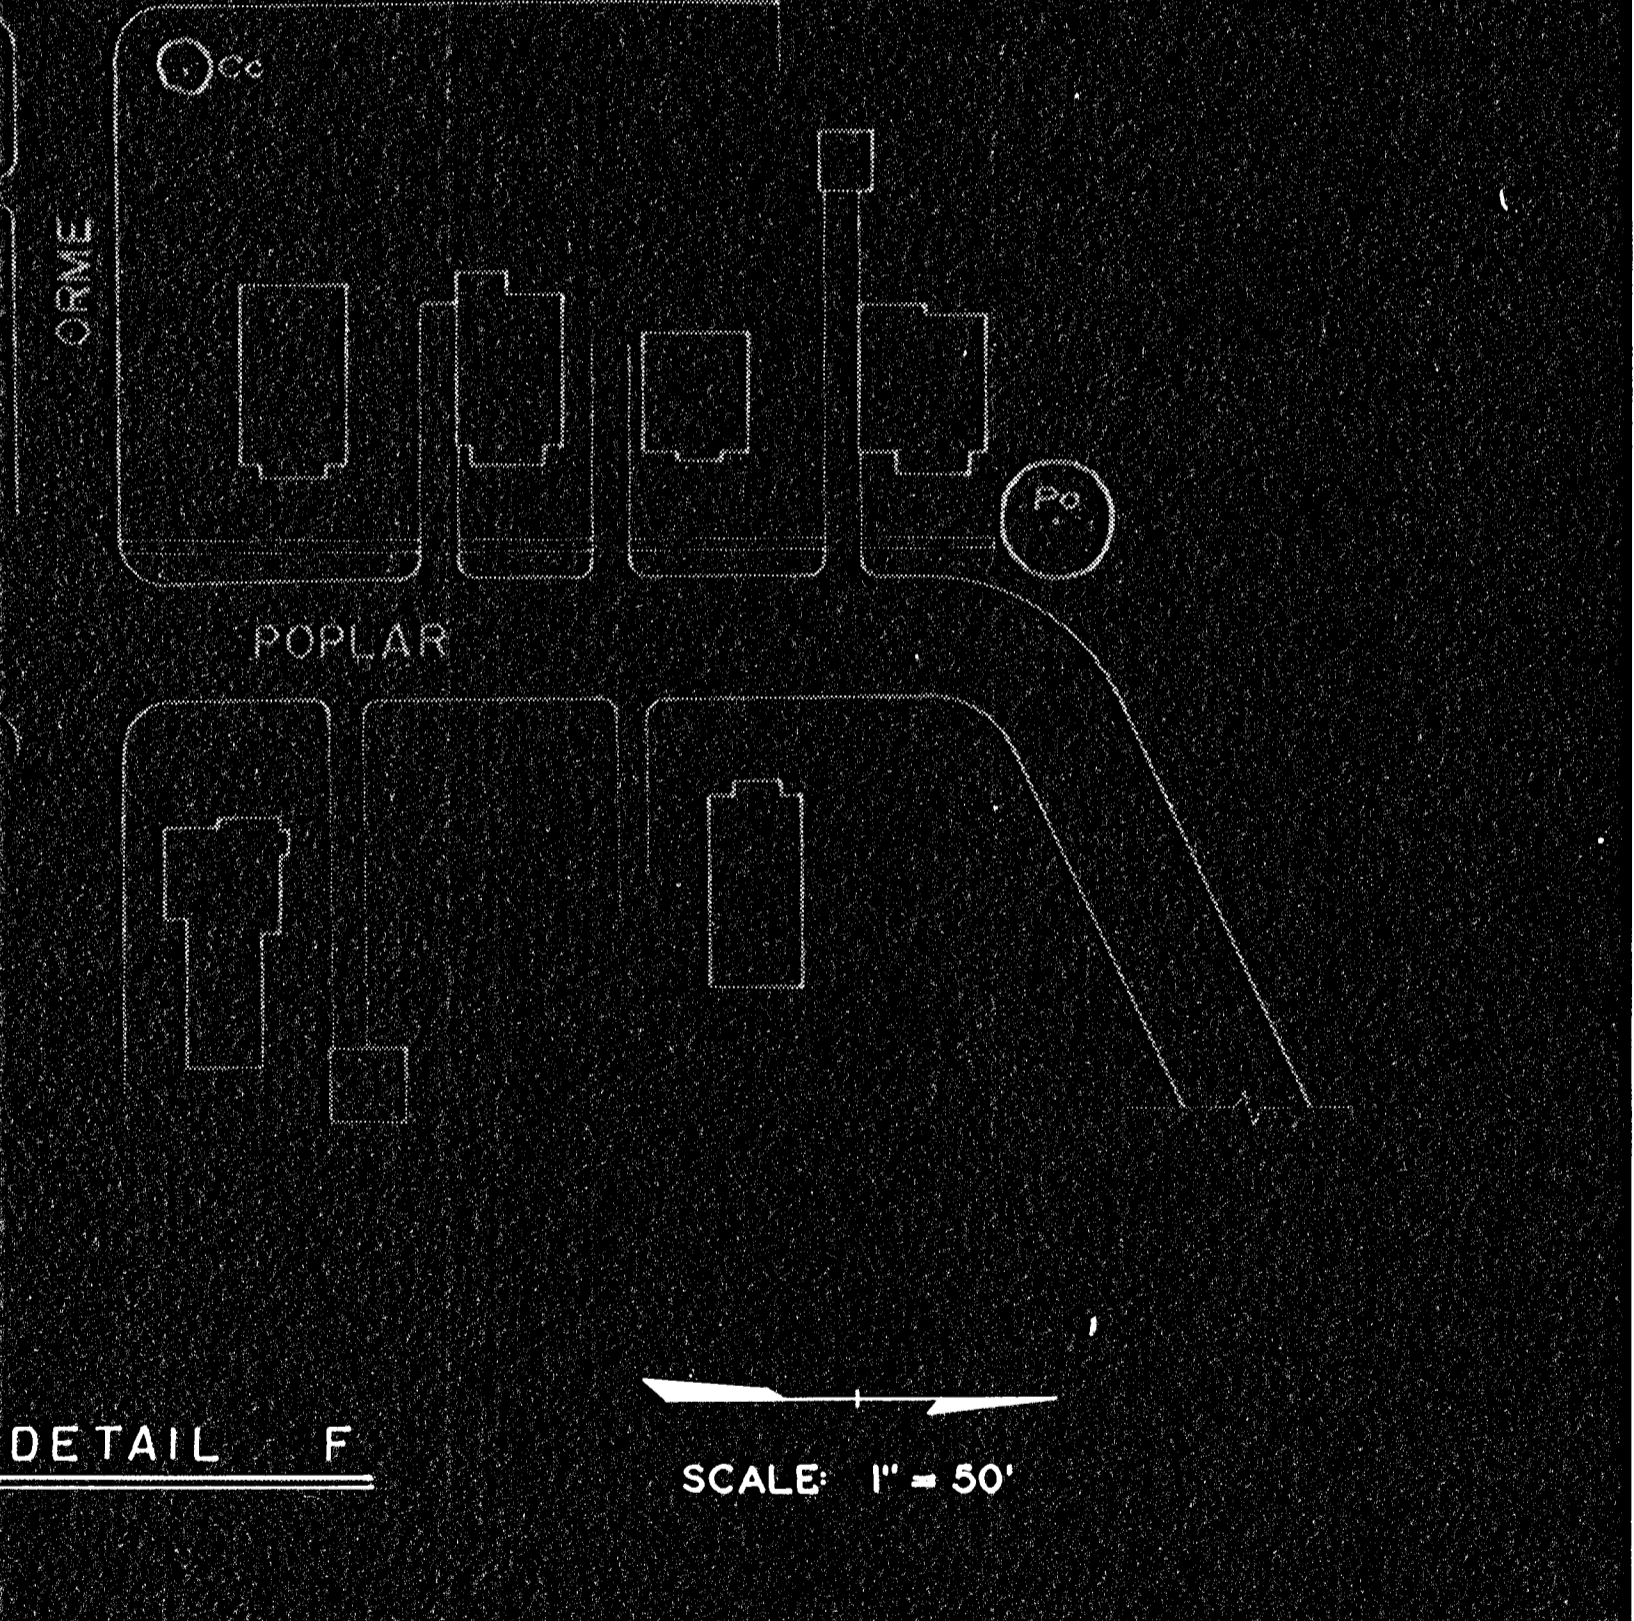
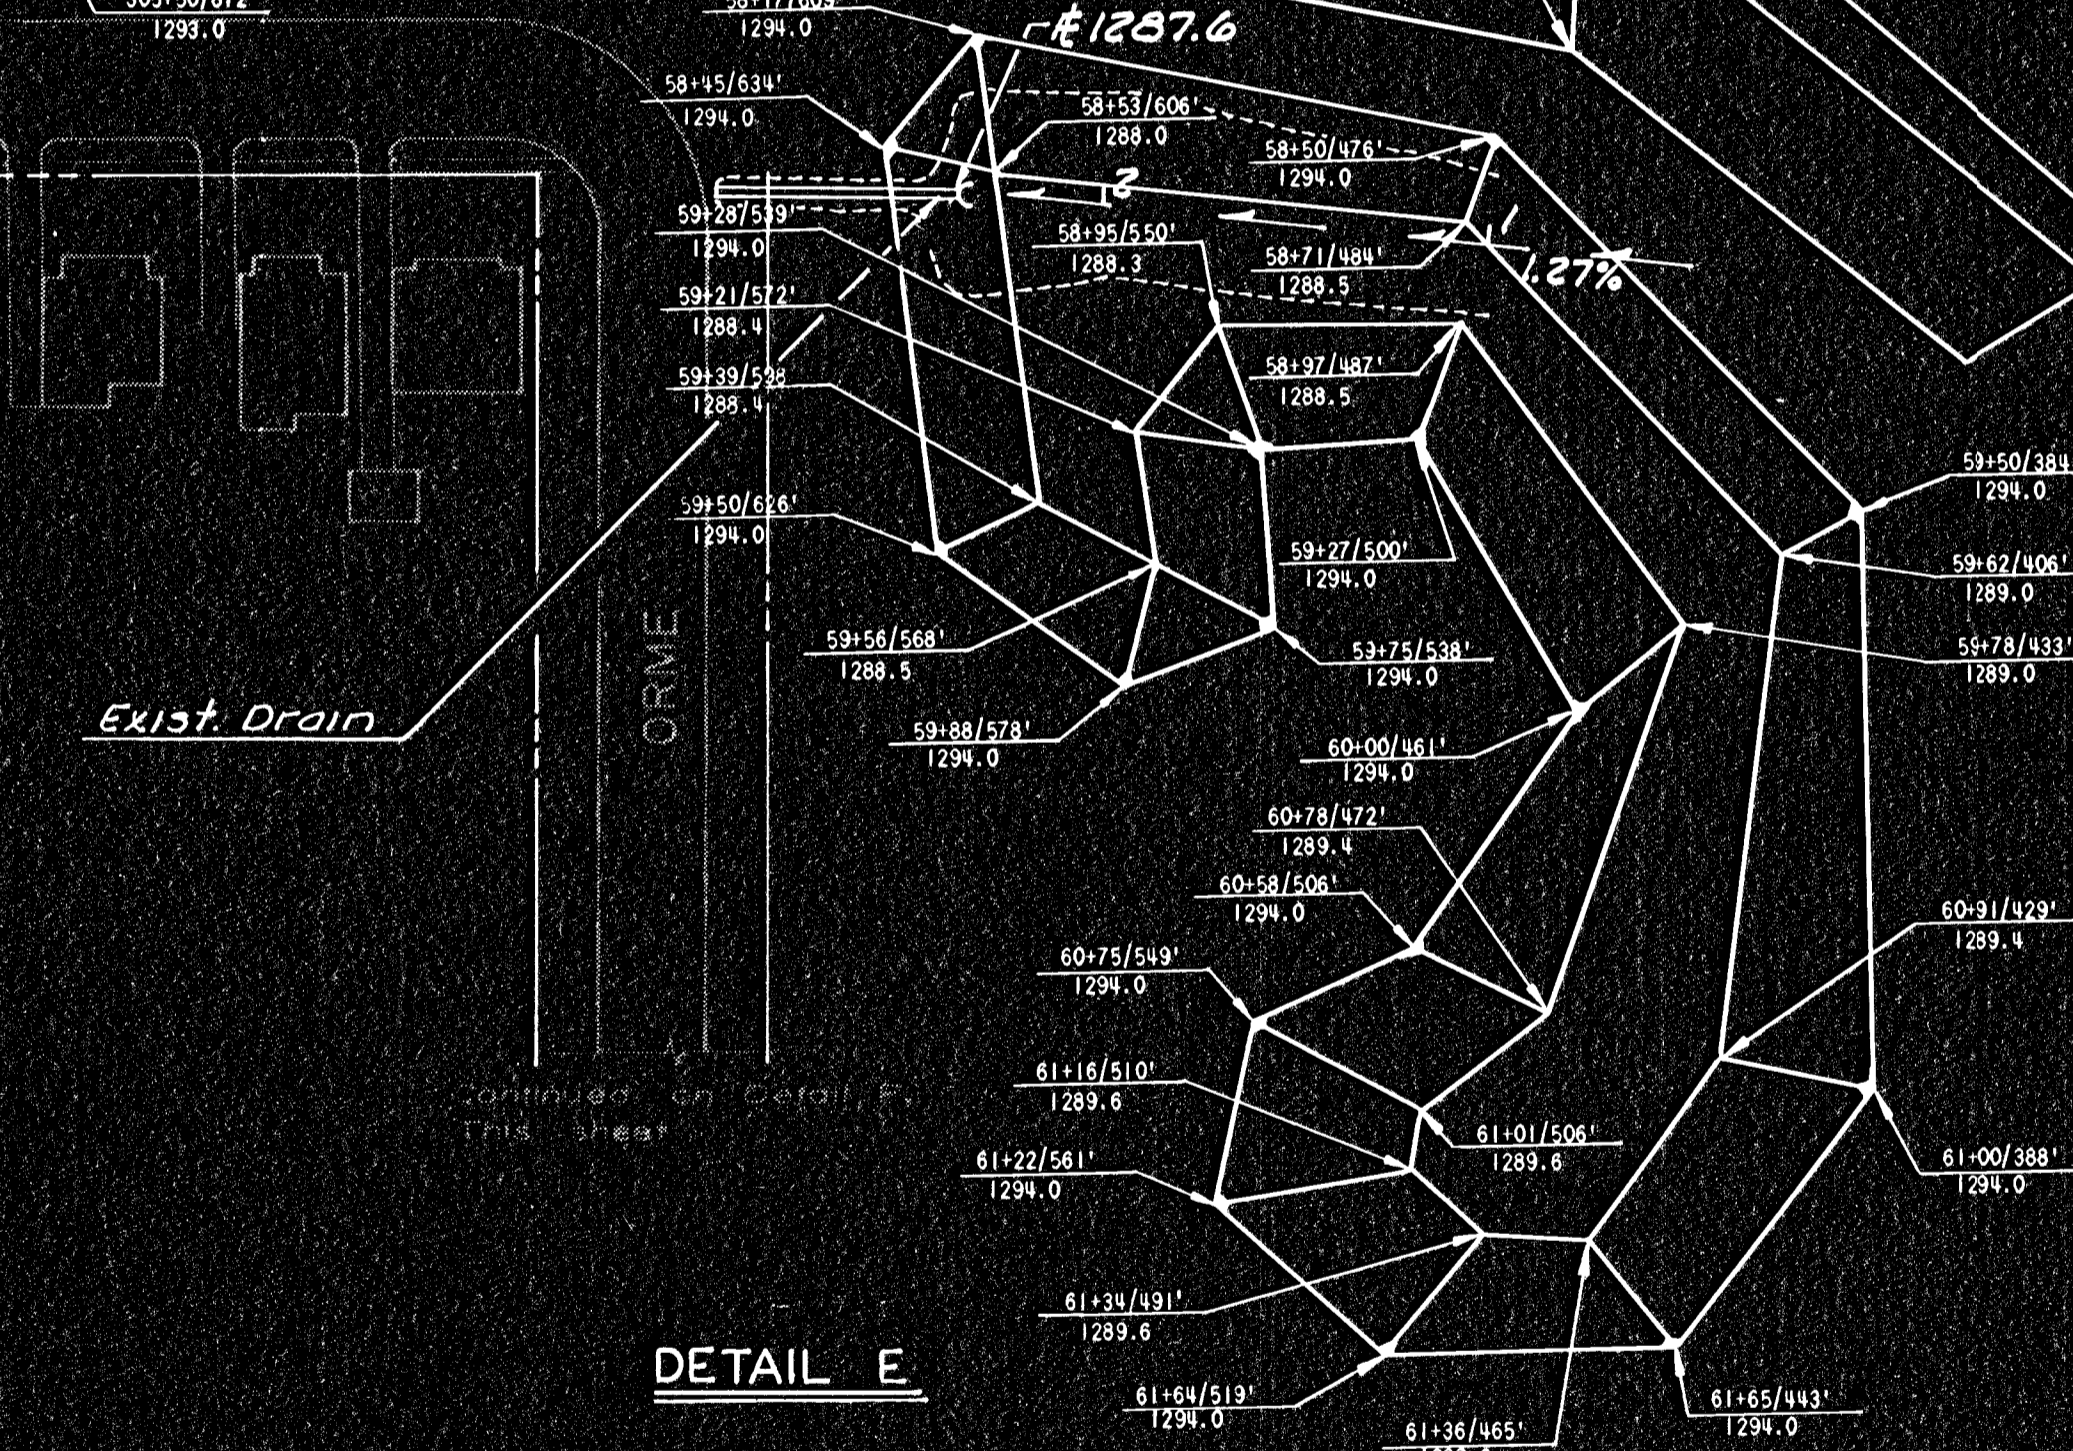
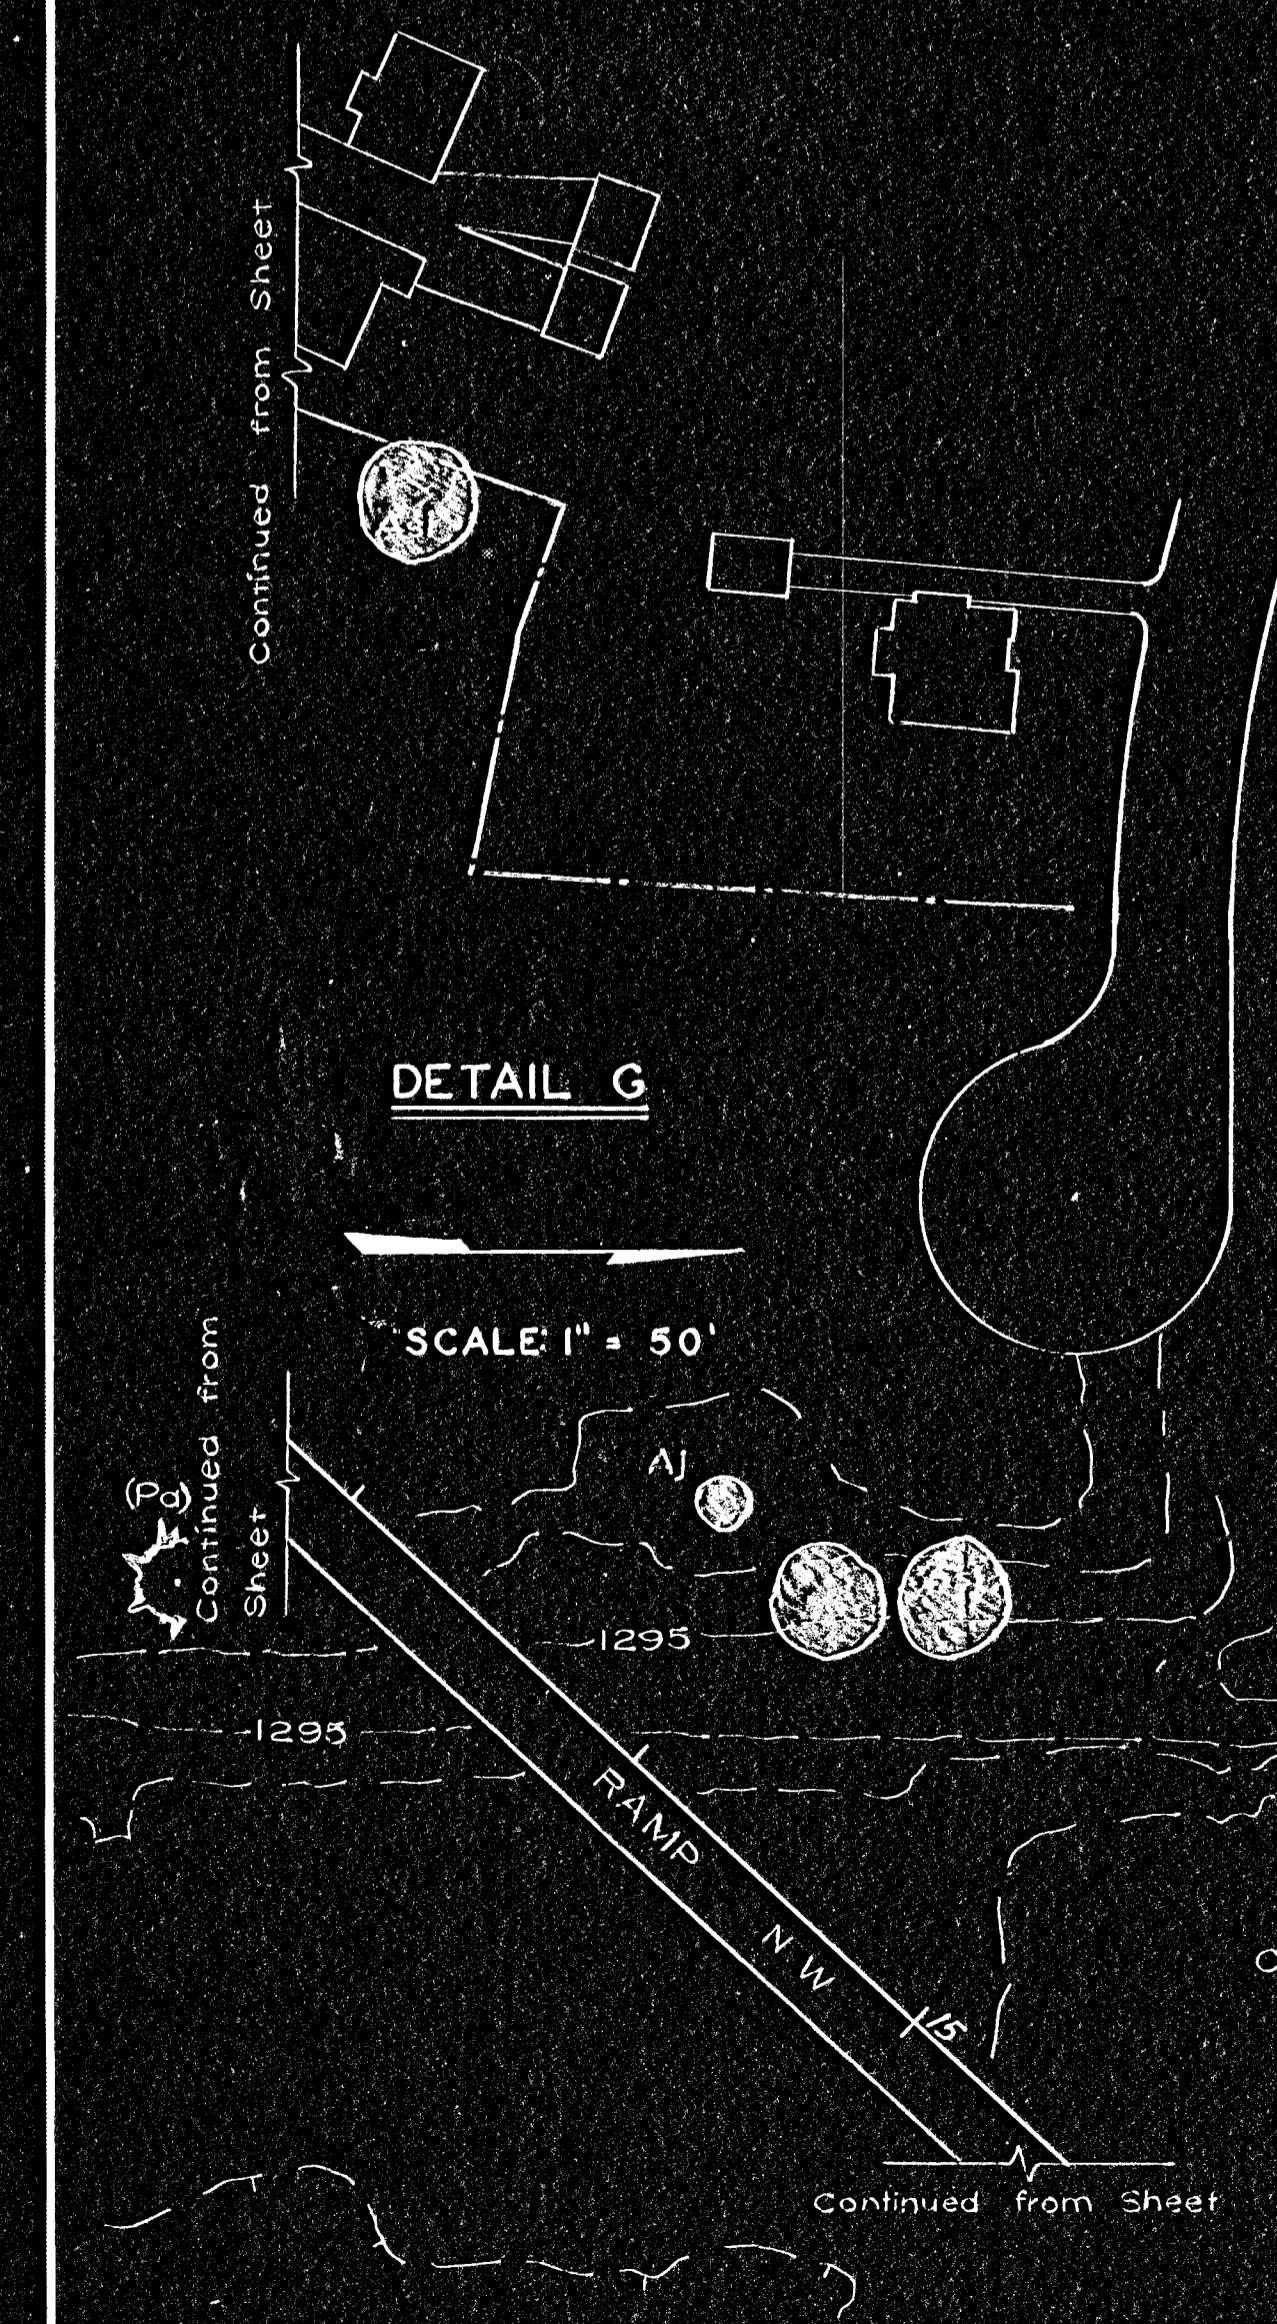
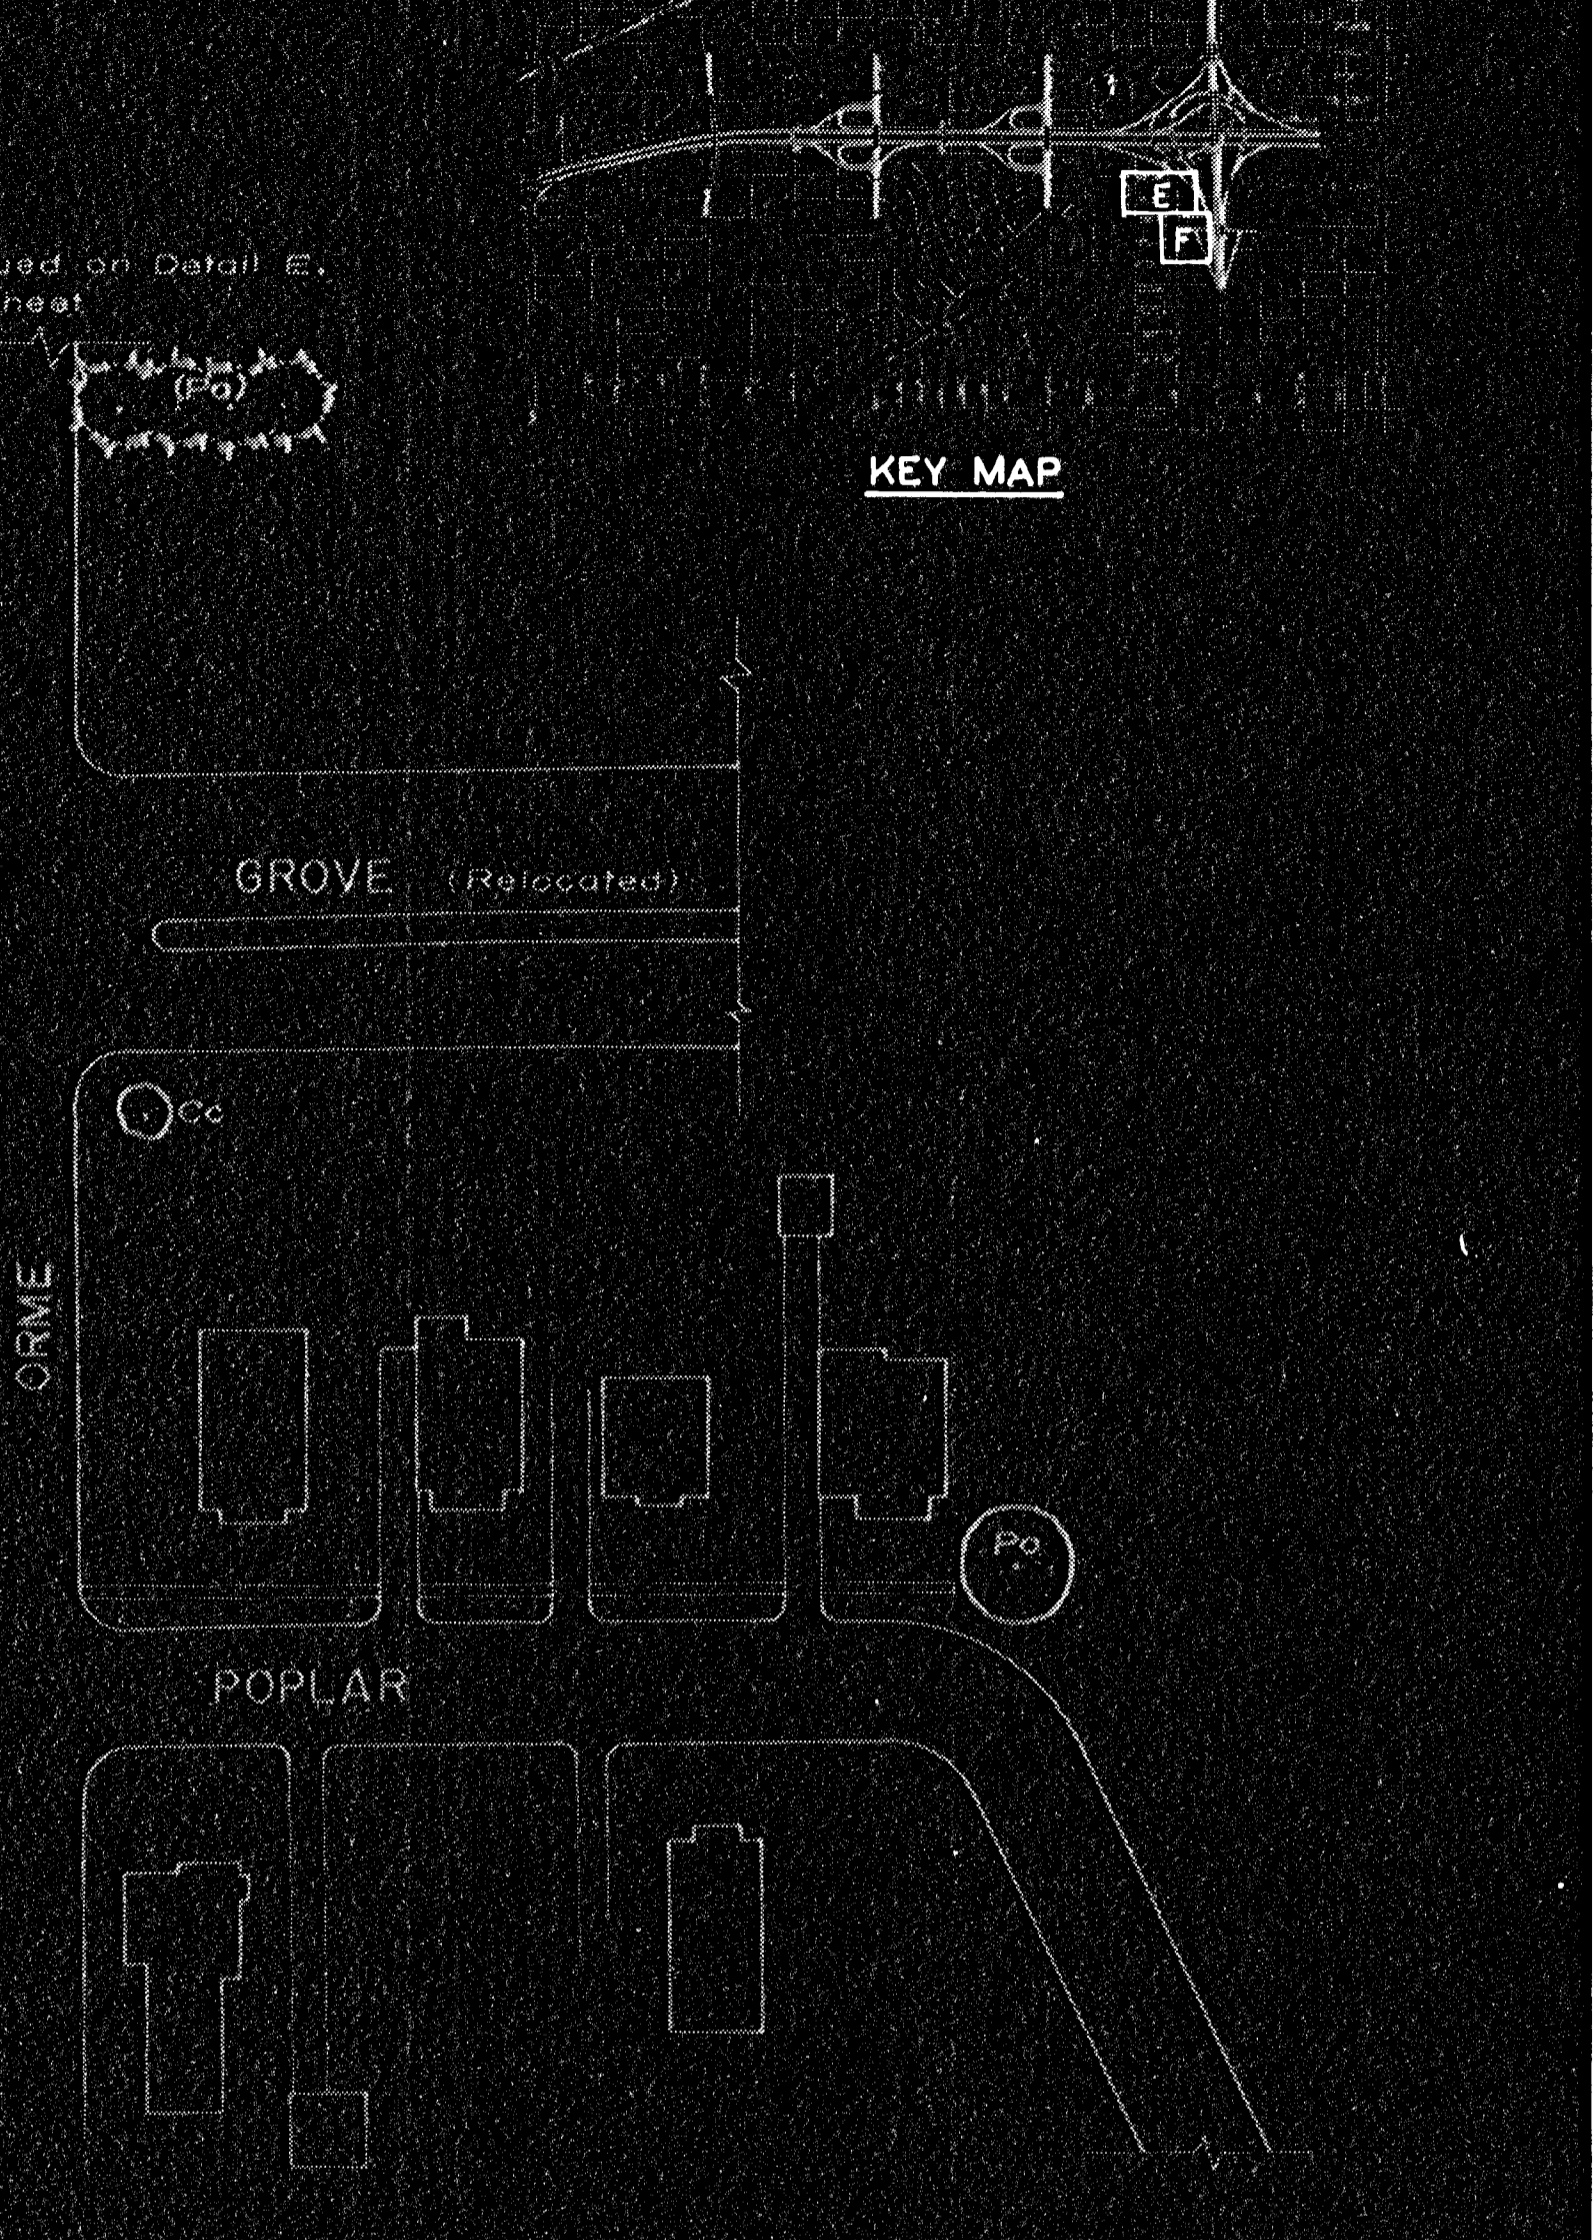


| F. H. W. A. REGION NO. | STATE | PROJECT NO. | FISCAL YEAR | SHEET NO. | TOTAL SHEETS |
|------------------------|--------|-------------|-------------|-----------|--------------|
| 7 | KANSAS | 35W-87 | 1976 | 187 | 304 |

* 35W-87 I 35W-1(33) 46 CONSTRUCTION PHASE 3

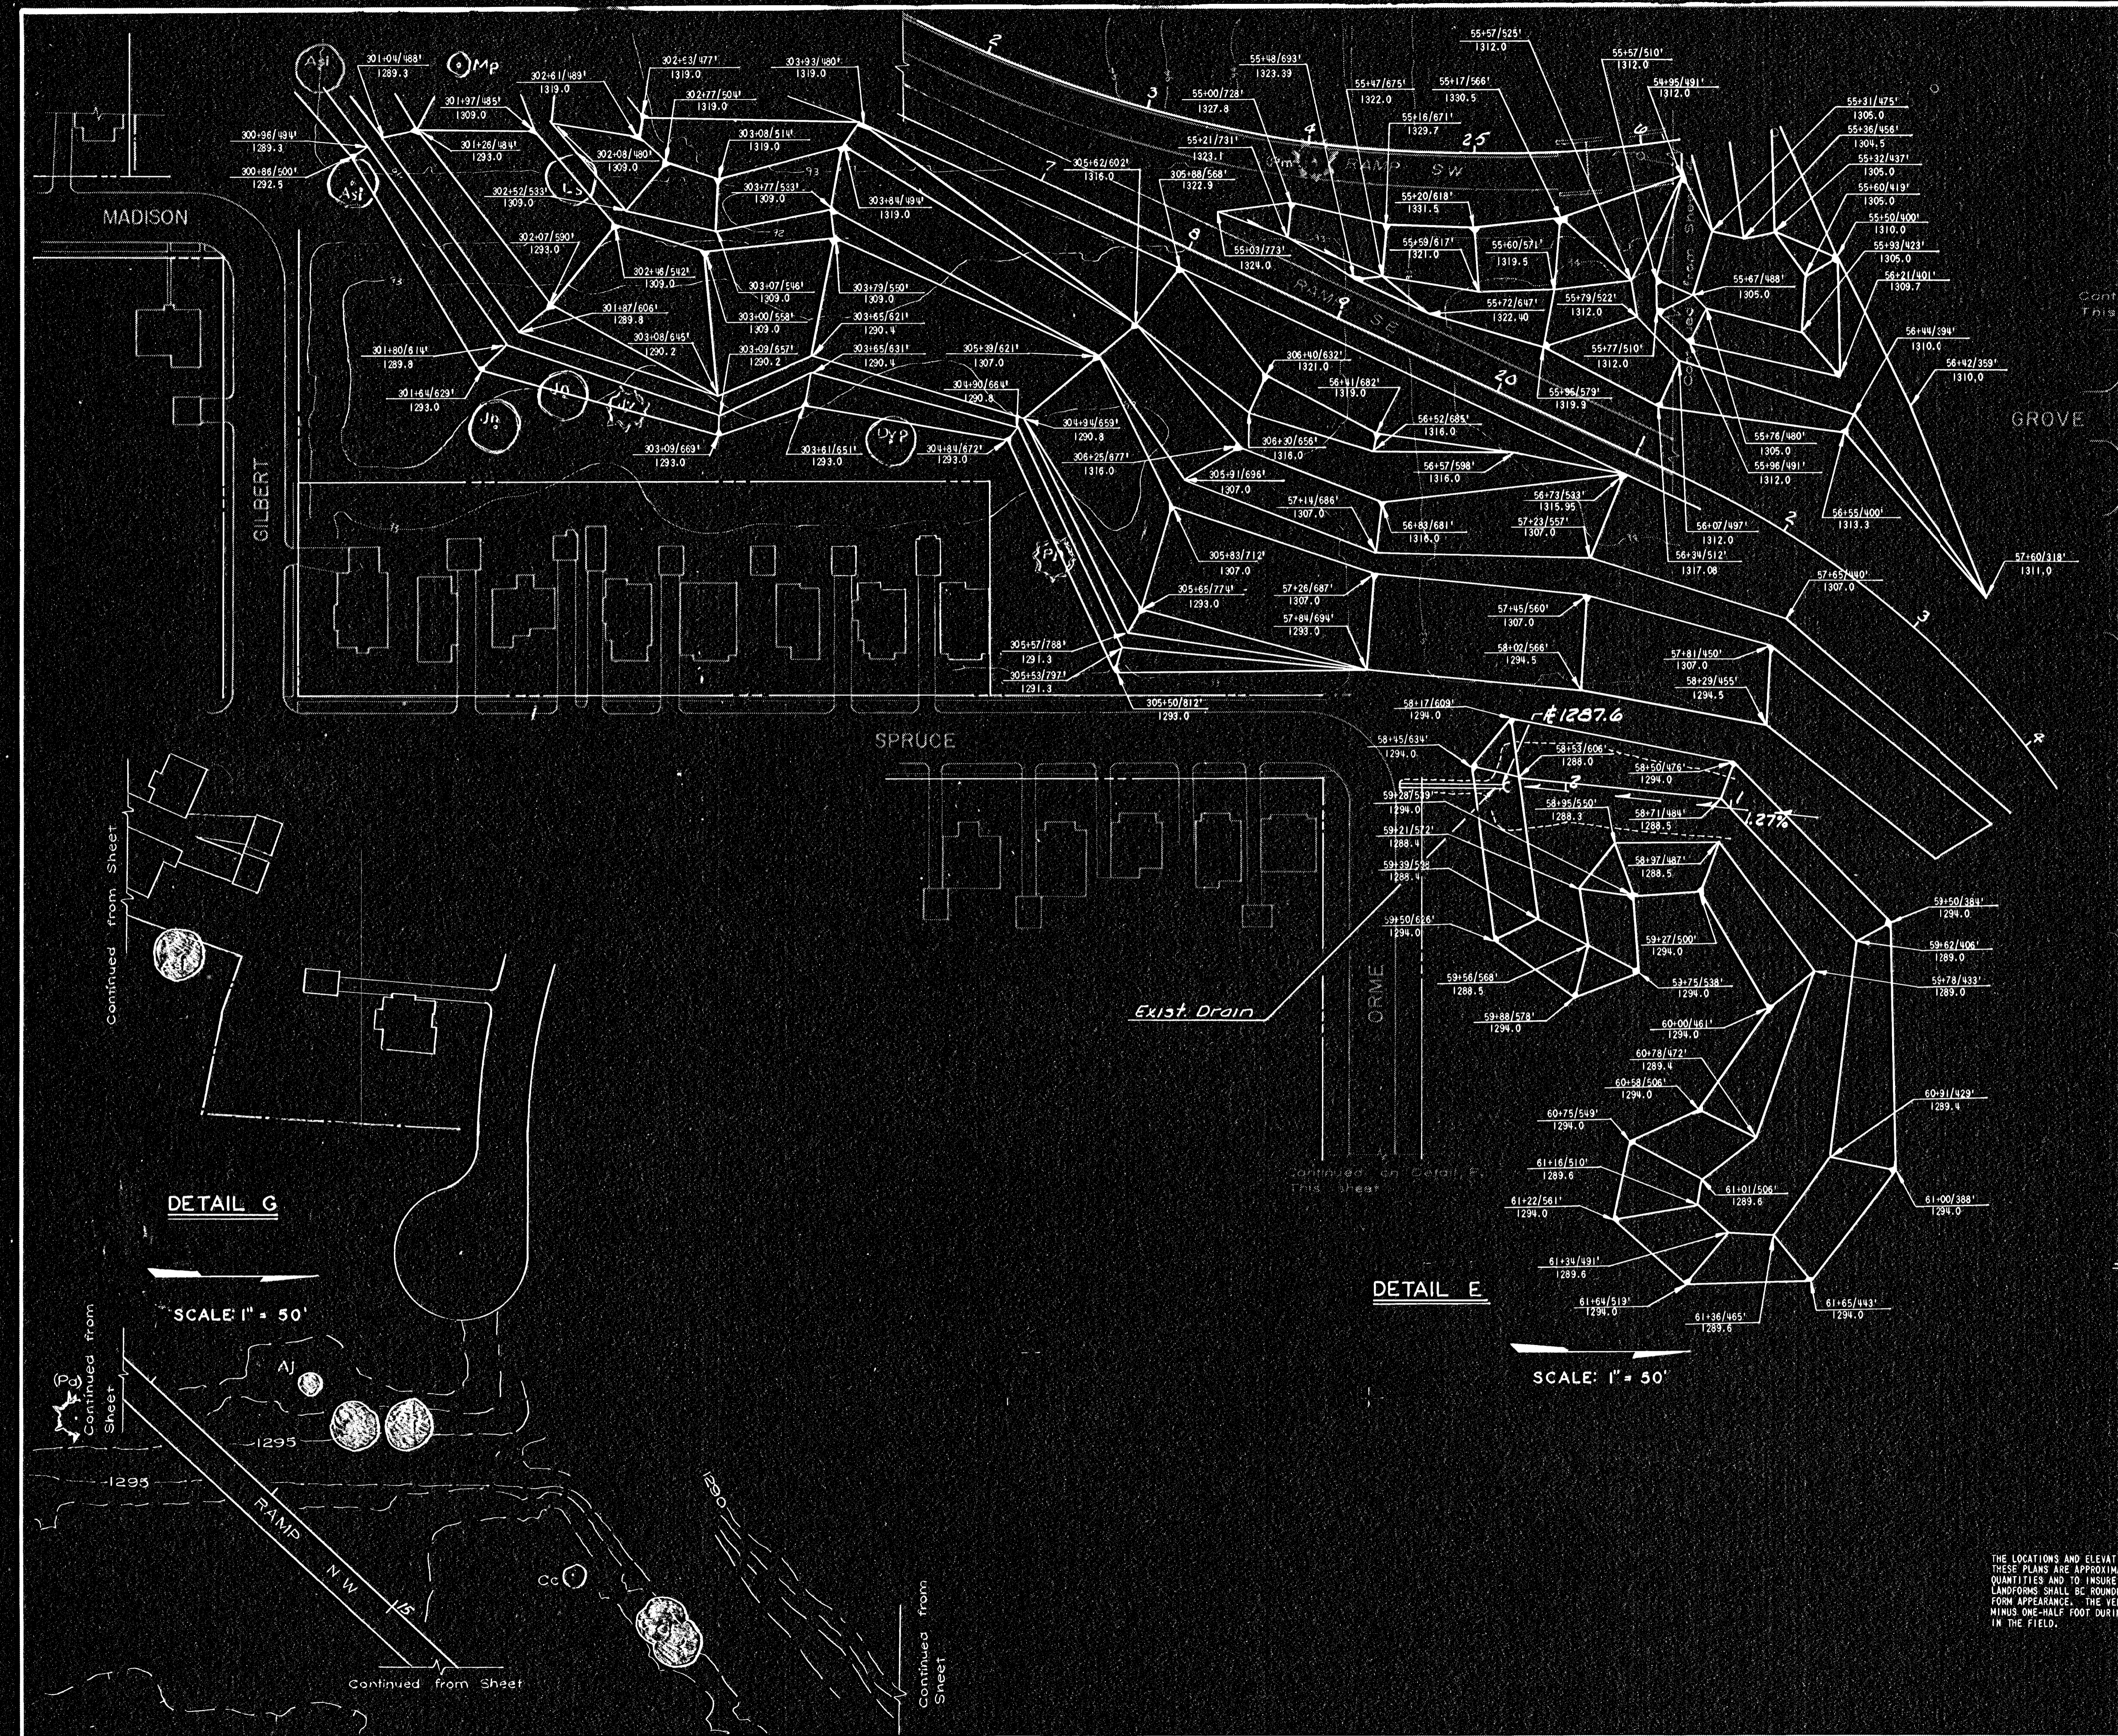

Note: Dashed Lines indicate Completed work.

| NO. | DATE | REVISIONS | BY | APP'D |
|-----|------|-----------|----|-------|
| 3 | | | | |
| 2 | | | | |
| 1 | | | | |

STATE HIGHWAY COMMISSION OF KANSAS

I 35 W

GRADING PLAN

DESIGNED JKW TRACED MJV CHECKED SRT

THE LOCATIONS AND ELEVATIONS OF THE REFERENCE POINTS AS SHOWN ON THESE PLANS ARE APPROXIMATE AND WERE USED ONLY FOR DETERMINING QUANTITIES AND TO INSURE PROPER DRAINAGE. ALL SURFACES OF THE LANDWORKS SHALL BE ROUNDED DURING CONSTRUCTION TO GIVE A PLEASANT APPEARANCE. THE VERTICAL ELEVATIONS MAY BE VARIED PLUS OR MINUS ONE-HALF FOOT DURING CONSTRUCTION AS APPROVED BY THE ENGINEER IN THE FIELD.