


FED. PROJ. NO.	STATE	FED. AID PROJ. NO.	FISCAL YEAR	SHEET NO.	TOTAL SHEETS
7	KANSAS	X	1976	206	304

435W-87E-30W-113N16  
110  
Construction Profile

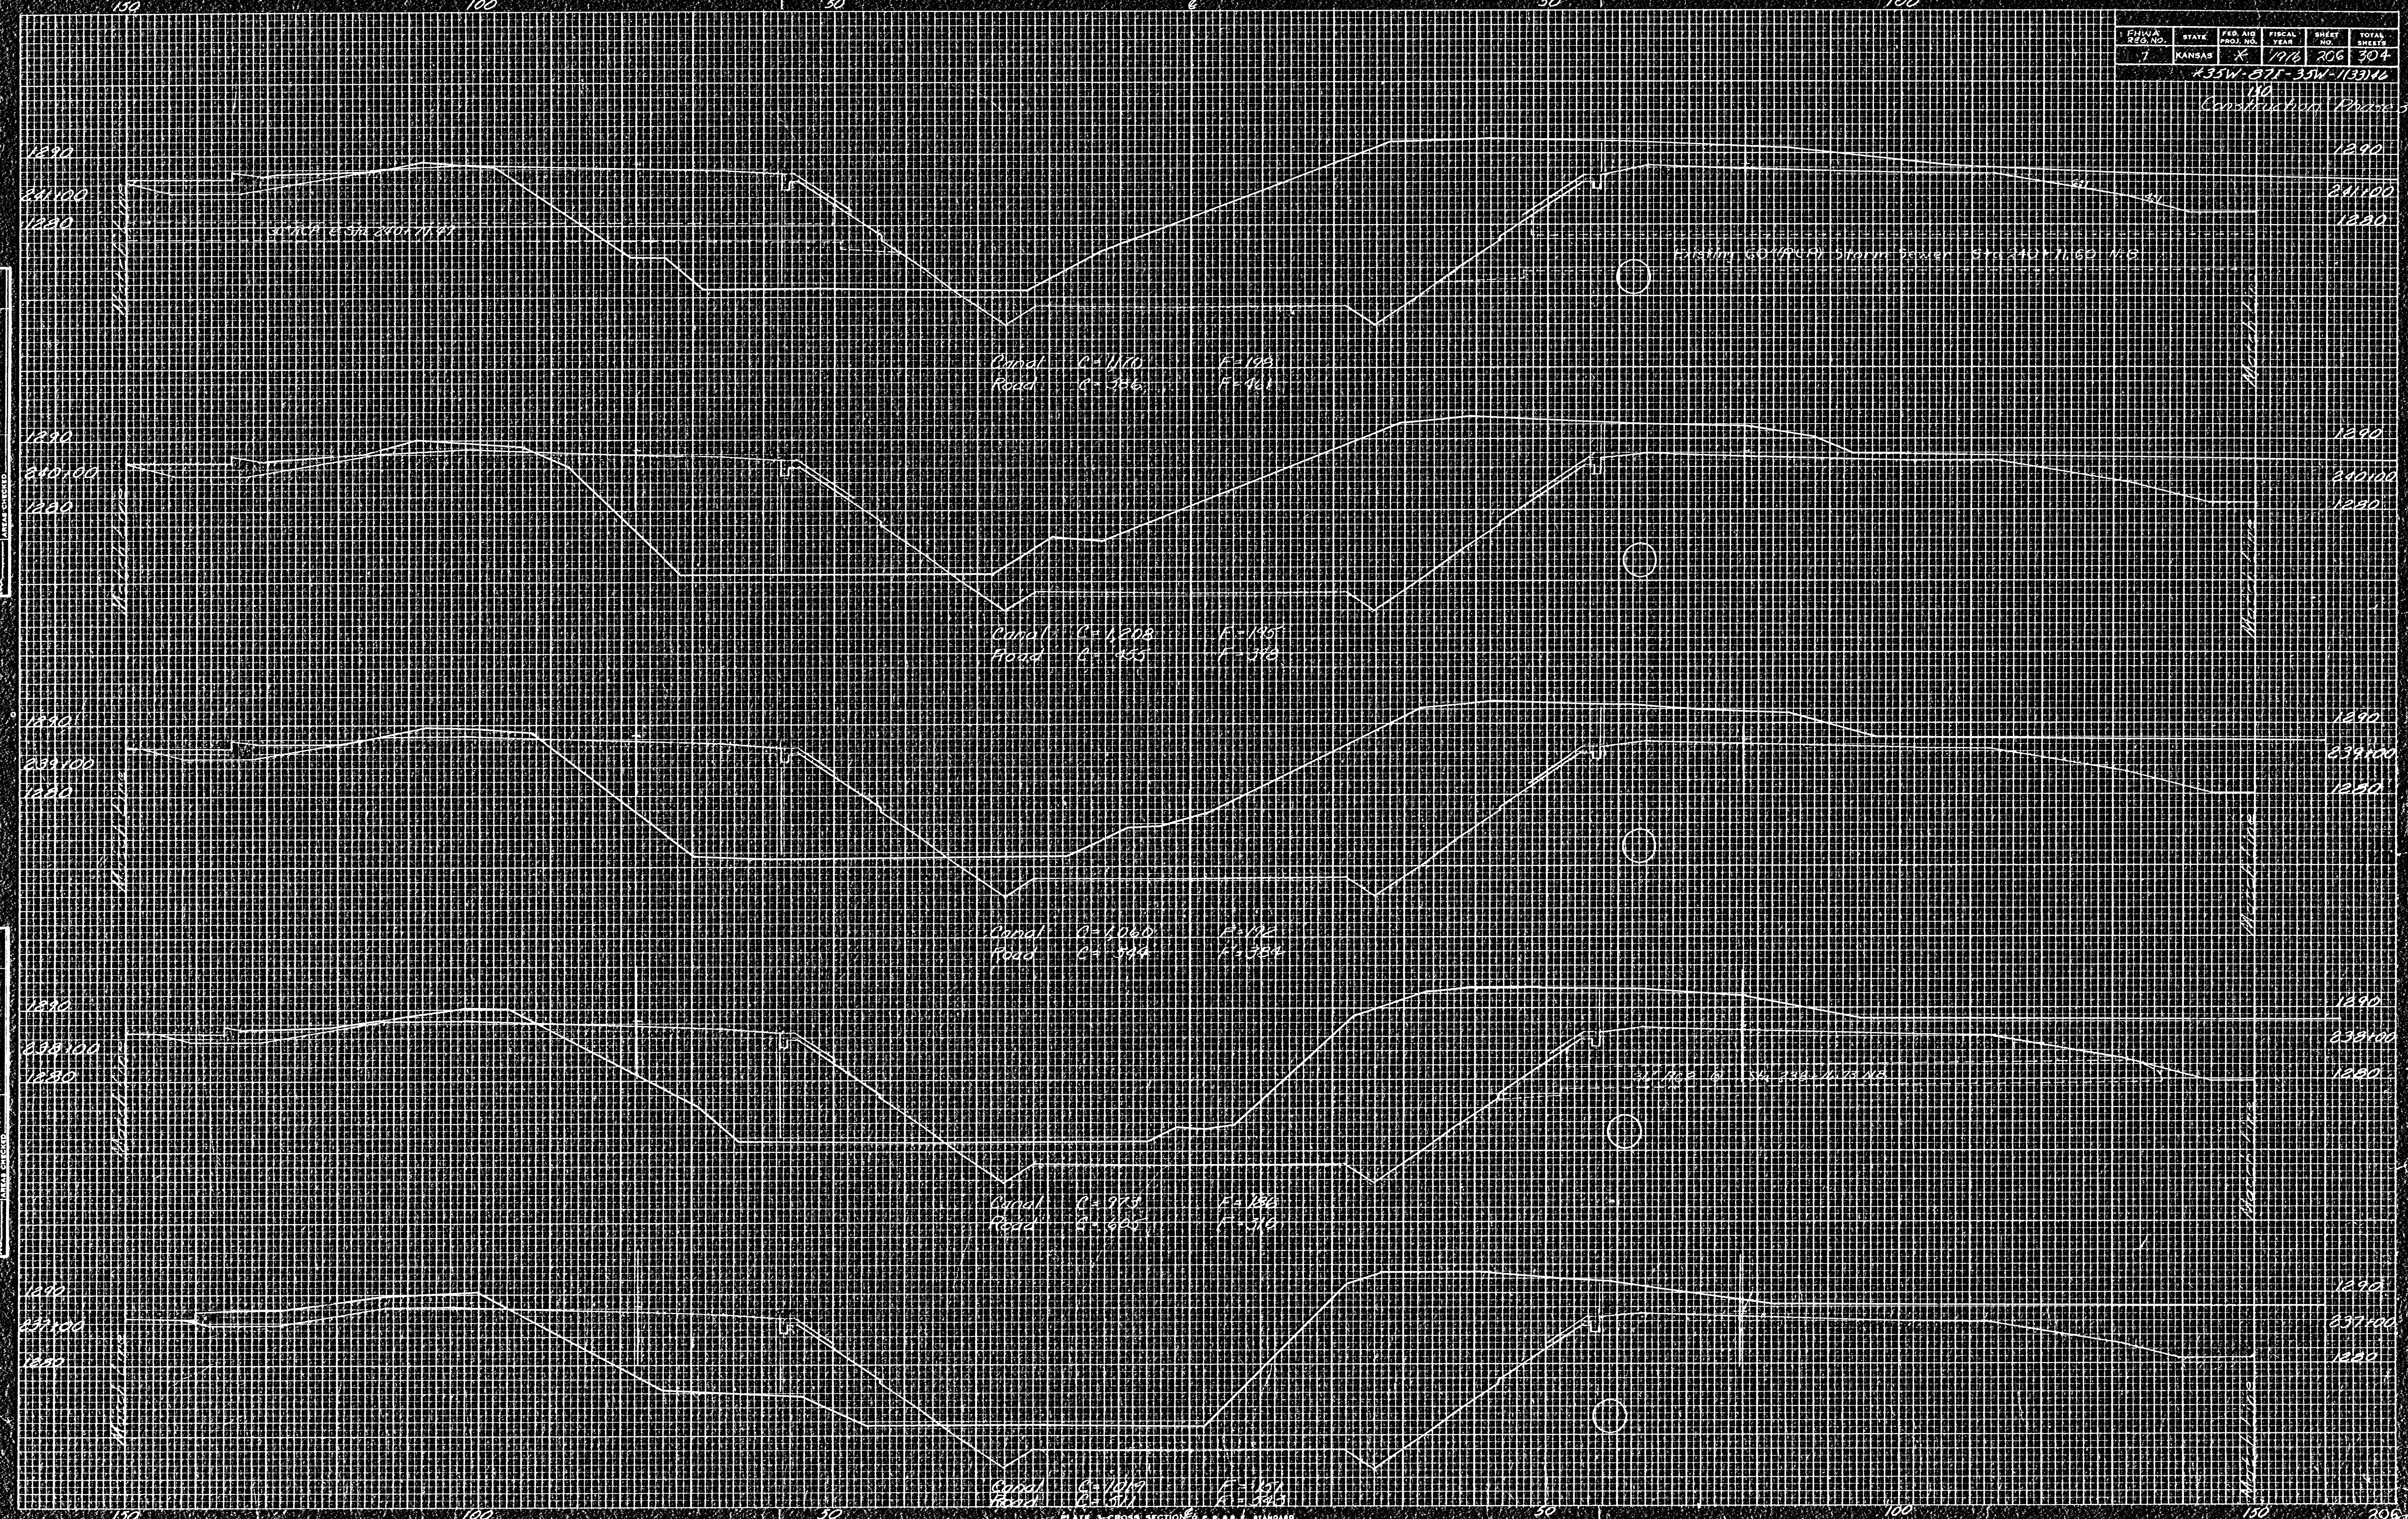

FINAL SURVEY DRAWING  
DATE: 11/1/76  
BY: [Signature]  
CHECKED: [Signature]  
APPROVED: [Signature]

ORIGINAL SURVEY DRAWING  
DATE: 11/1/76  
BY: [Signature]  
CHECKED: [Signature]  
APPROVED: [Signature]