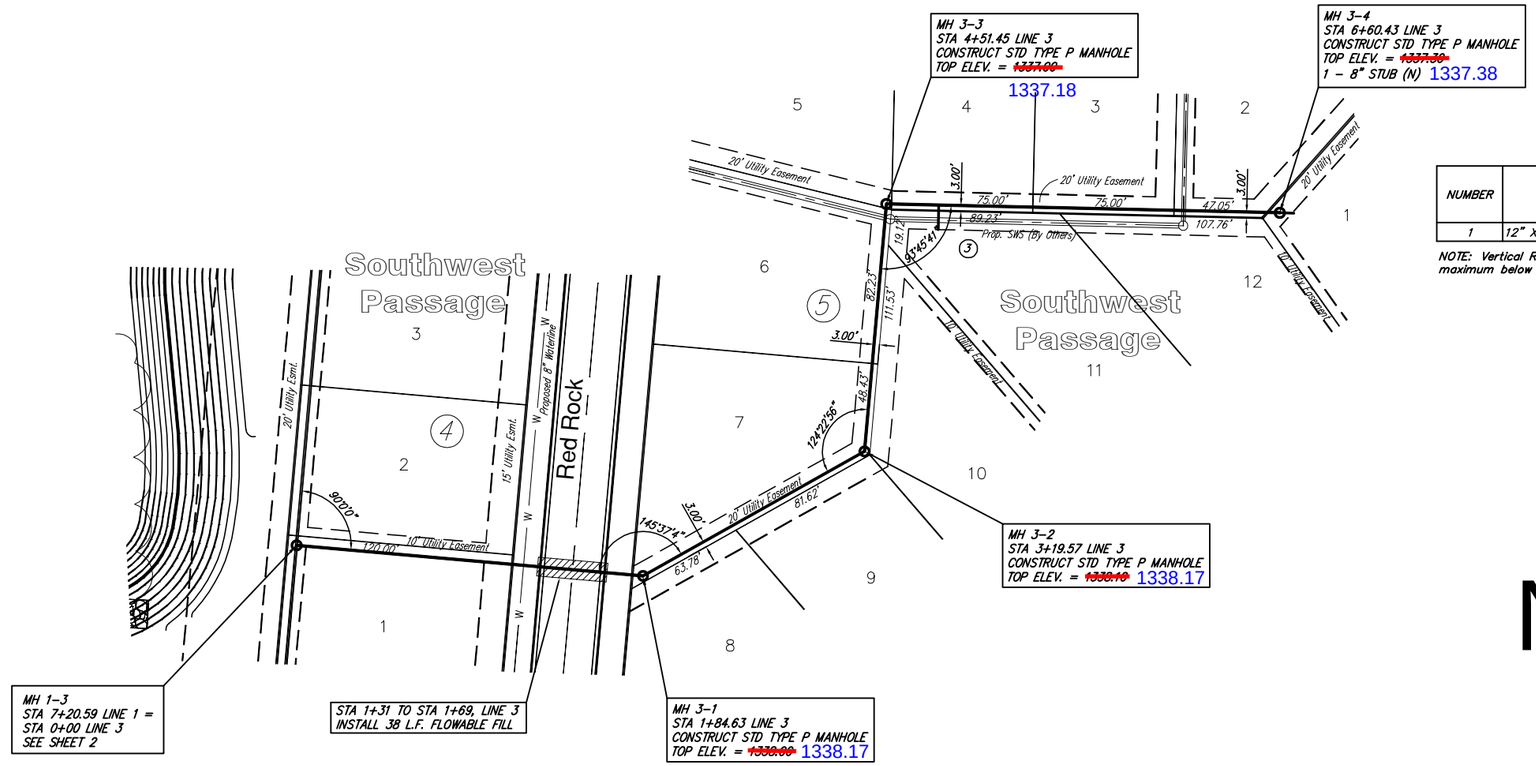

SEWER SERVICE TABLE

NUMBER	TYPE	LOCATION				FOR INFORMATION ONLY	
		LOT NO.	BLOCK NO.	LINE NO.	STATION\ DIRECTION	APPROXIMATE LENGTH 4" PIPE VERTICAL	HORIZONTAL
1	12" X 4" Tee Saddle	11	5	3	4+~~79~~/R	78.45 5'	~~13~~ 14.8

NOTE: Vertical Riser Pipe shall be extended to 2' minimum above ground water elevation and 4' maximum below proposed ground elevation.

N

SCALE 1" = 40' HORIZ.
1" = 5' VERT.
IRON = •

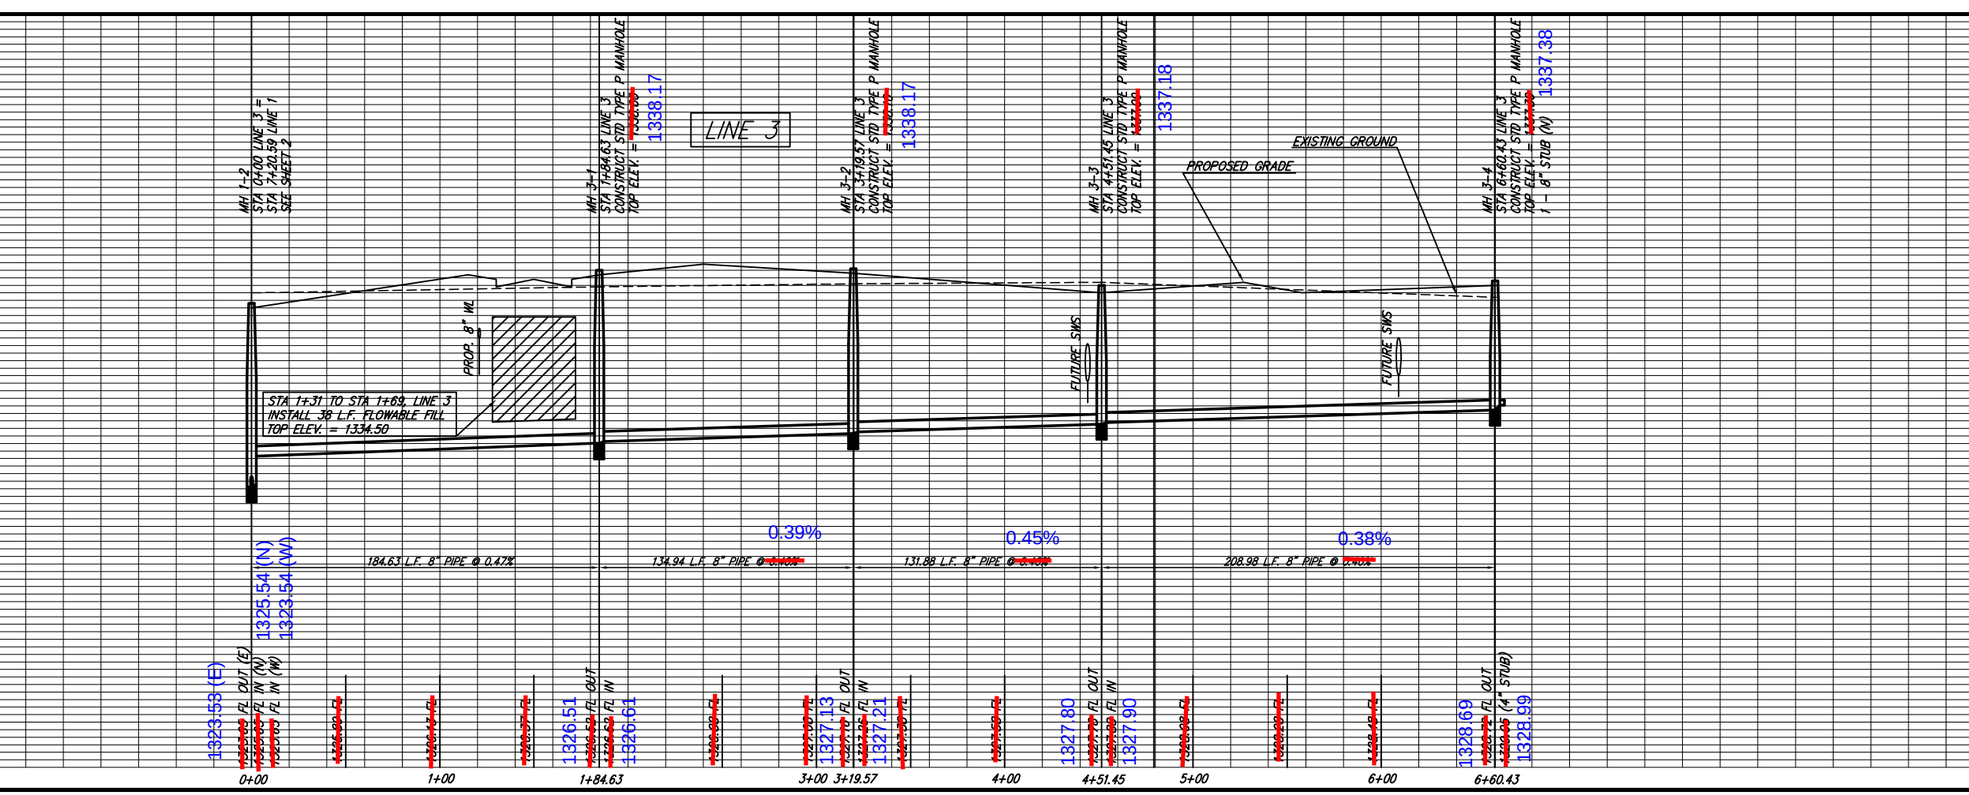

Ruggles & Bohm, P.A.
Engineering, Surveying, Land Planning
(316) 264-6203
(316) 264-6211 fax
904 North Main
Wichita, Kansas 67203
www.ruggleslaw.com

DESIGN	DRAWN	REVISED
KWL	JDM	
UTILITY	DATE	REVIEW
	Oct. 18, 2006	

PROJECT NUMBER 468-84228
DRAWING FILE Sanitary Sewer (LINE 1A)

SOUTHWEST PASSAGE PHASE 1
Sanitary Sewer
WICHITA, KANSAS

R&B JOB 2927E

SHEET 16 of 25