


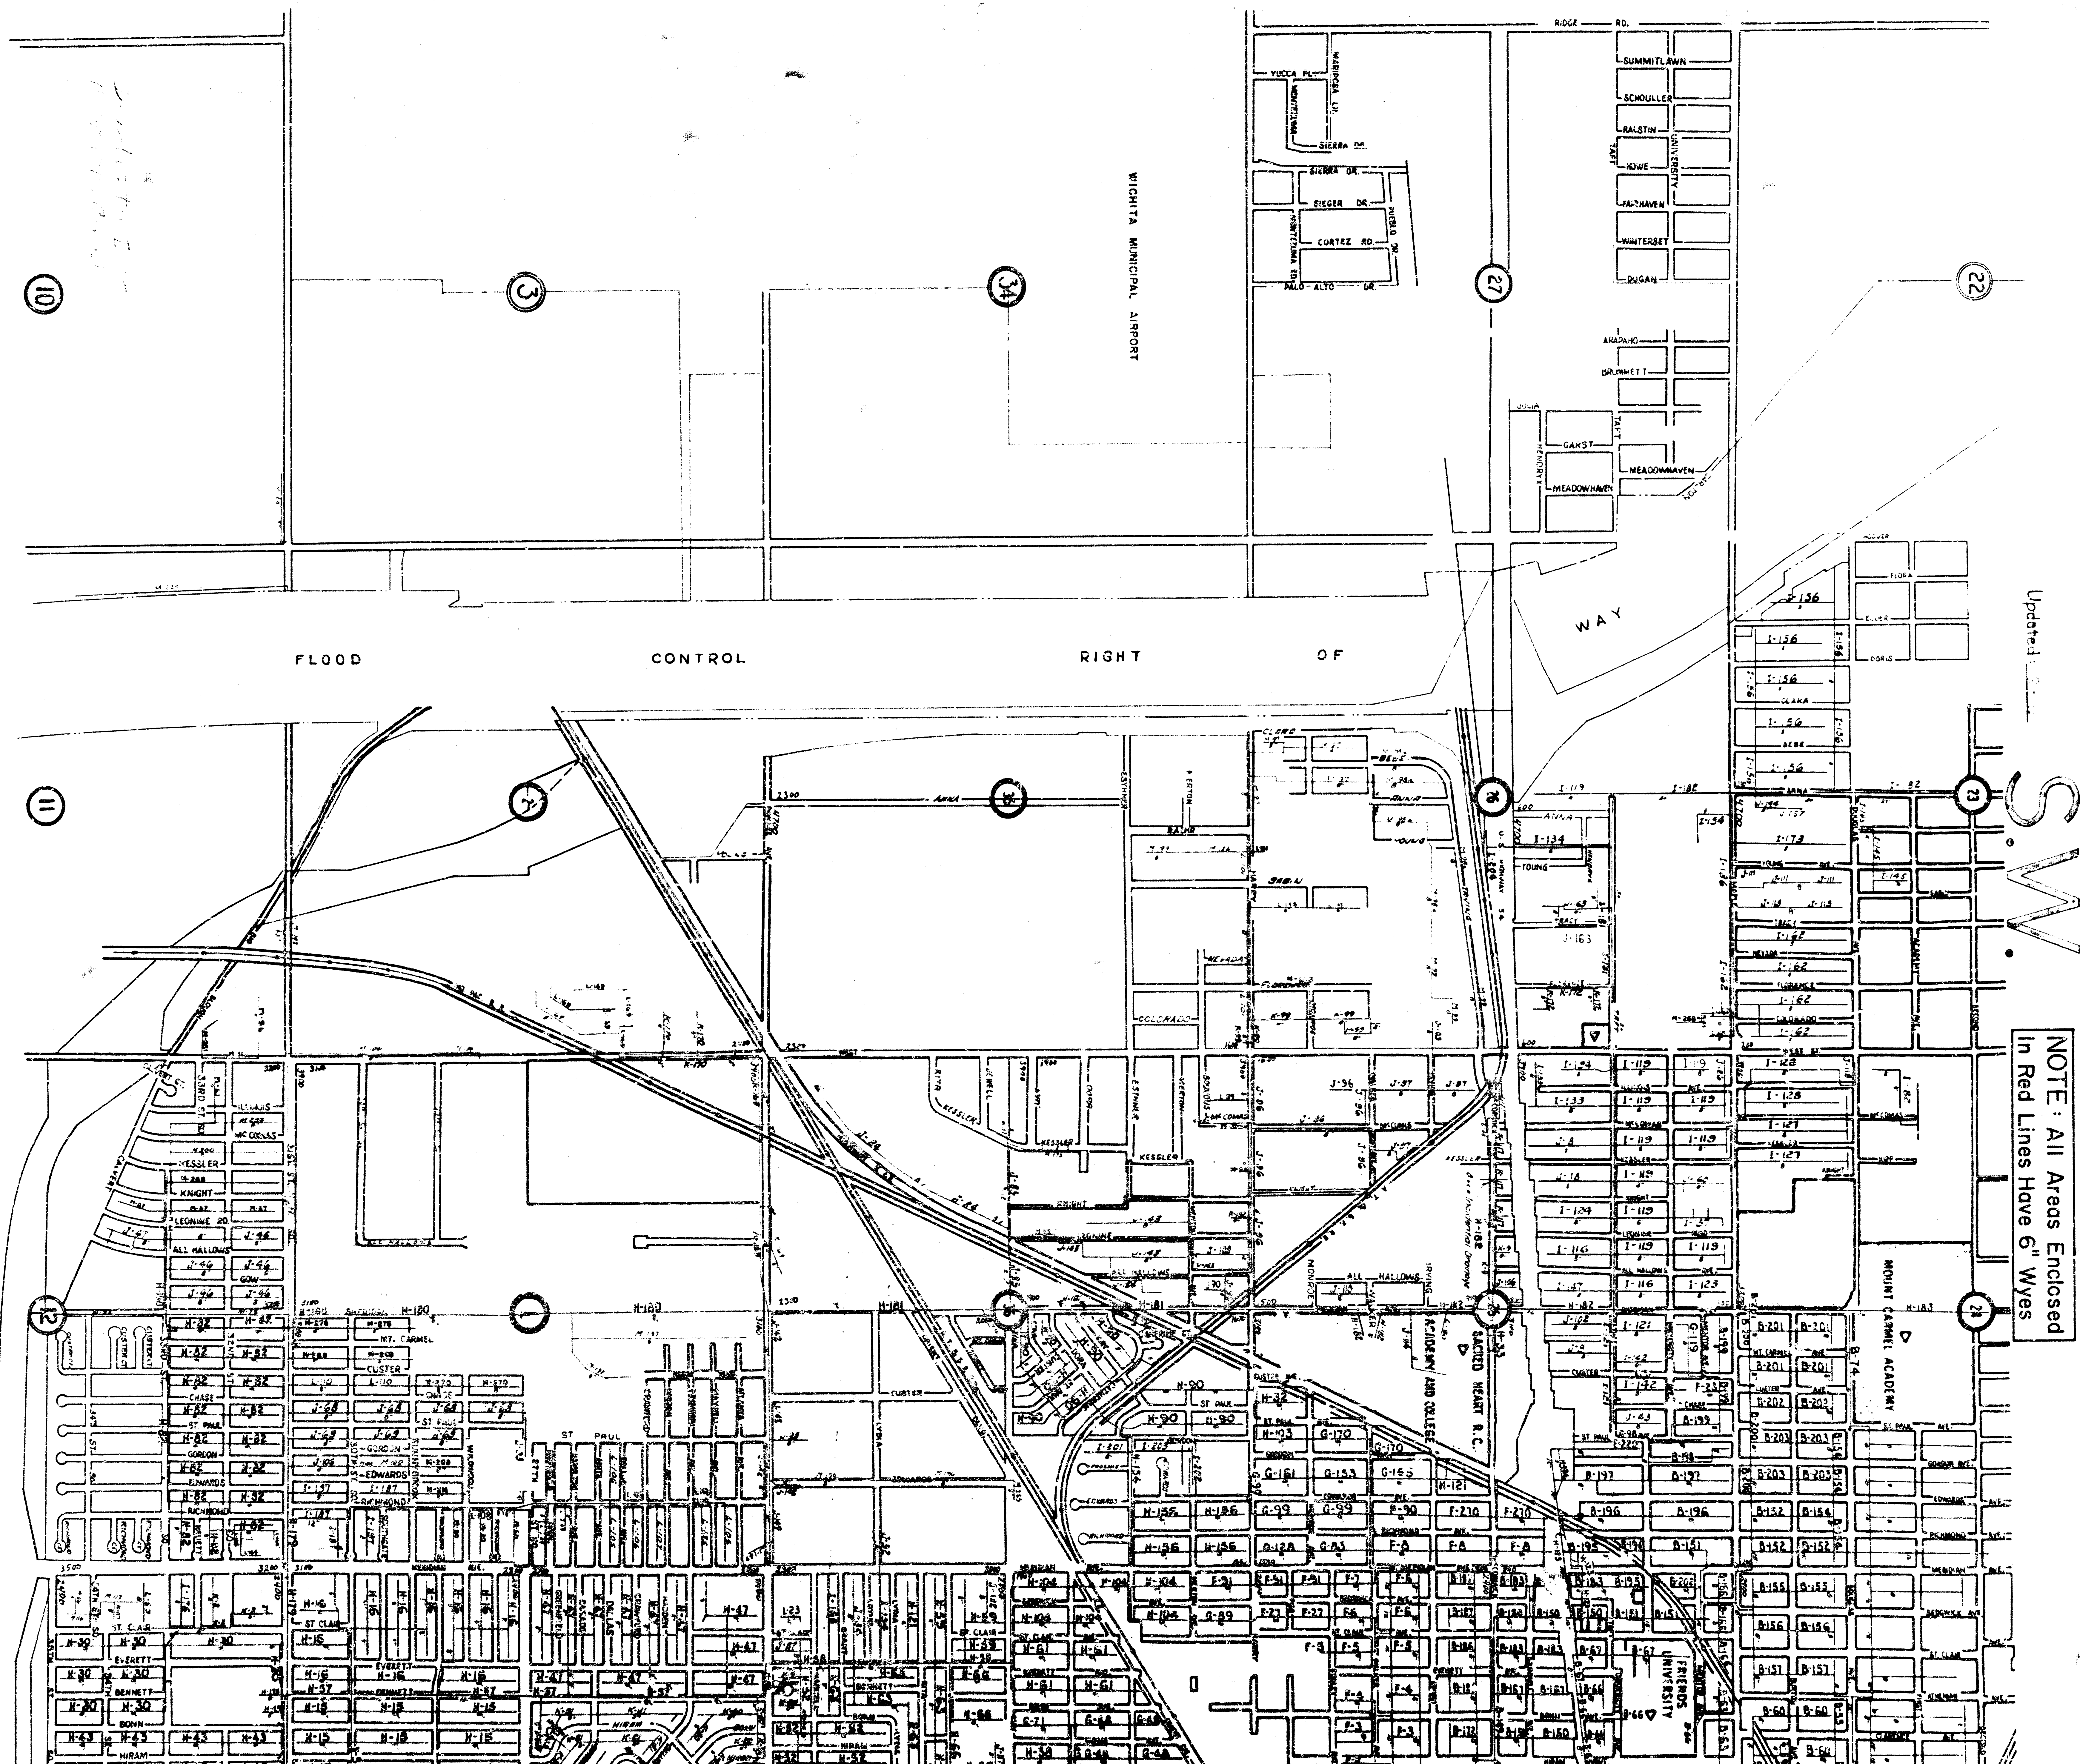

NOTE: All Areas Enclosed
in Red Lines Have 6" Wyes

Updated

DEED

