


1947

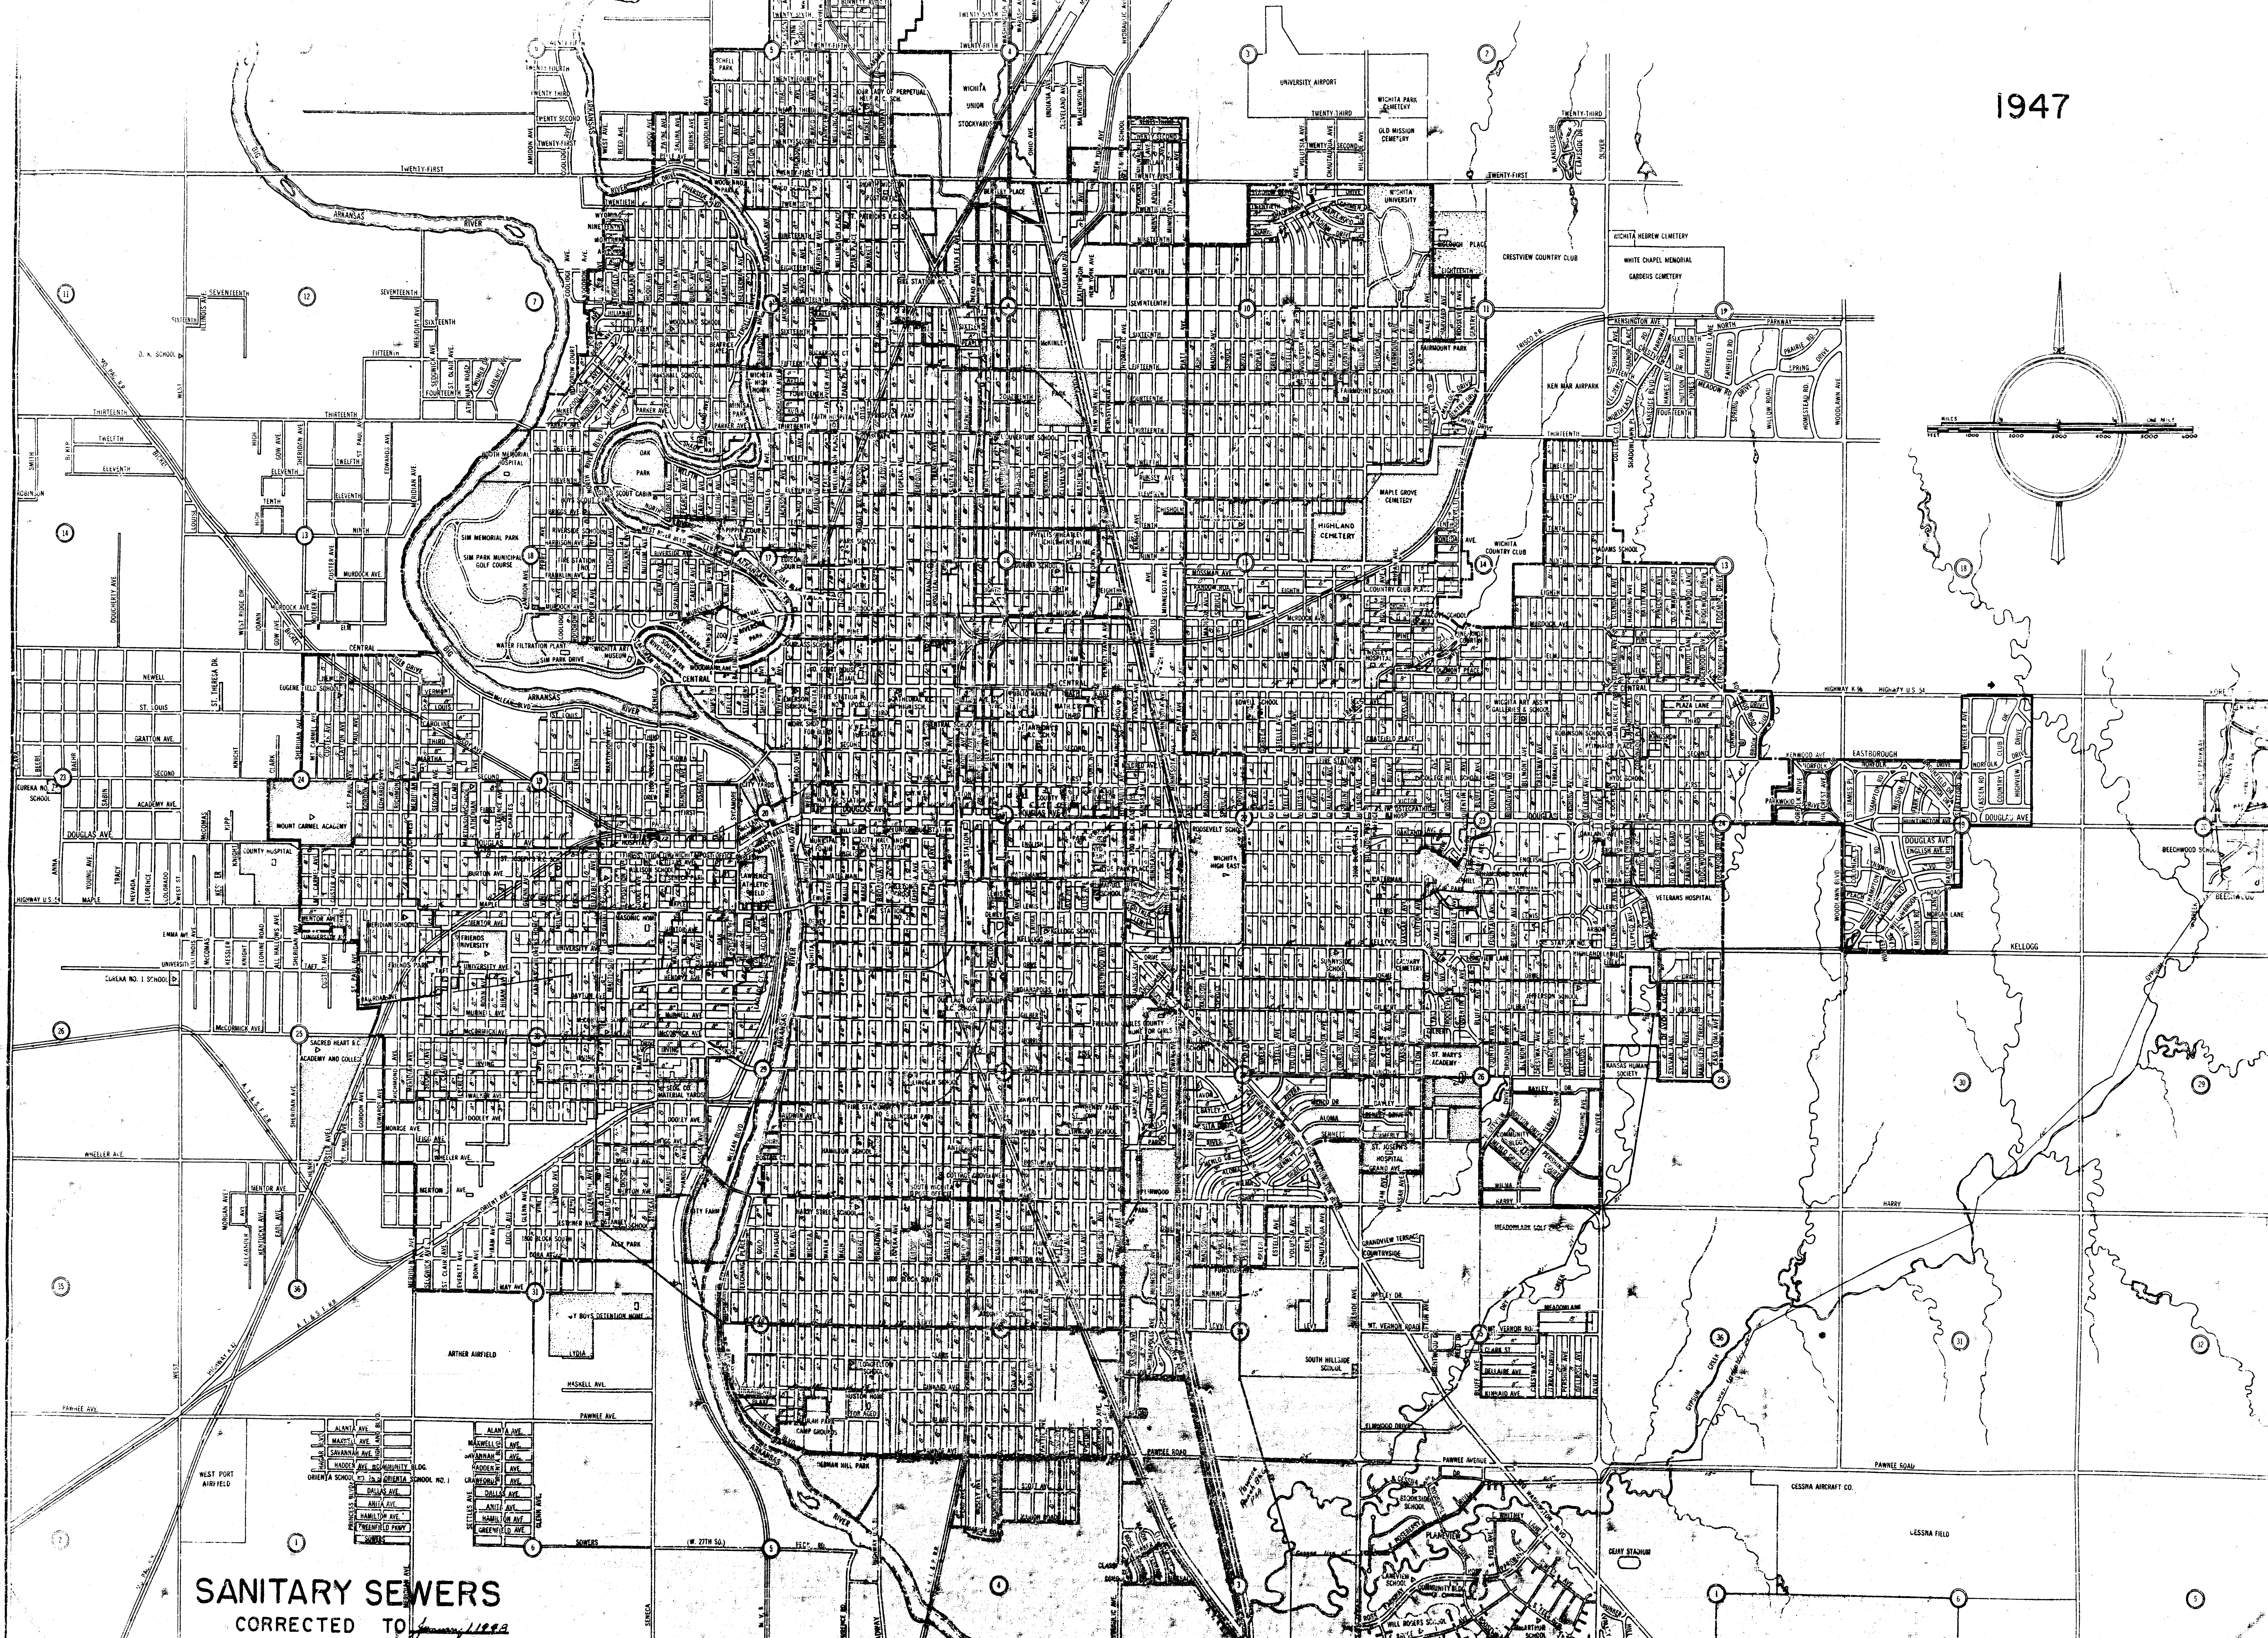

SANITARY SEWERS

CORRECTED TO JANUARY 1, 1947