



SCALE: PLAN 1" = 40'
 PROFILE 1" = 40' HORIZ.
 1" = 5' VERT.

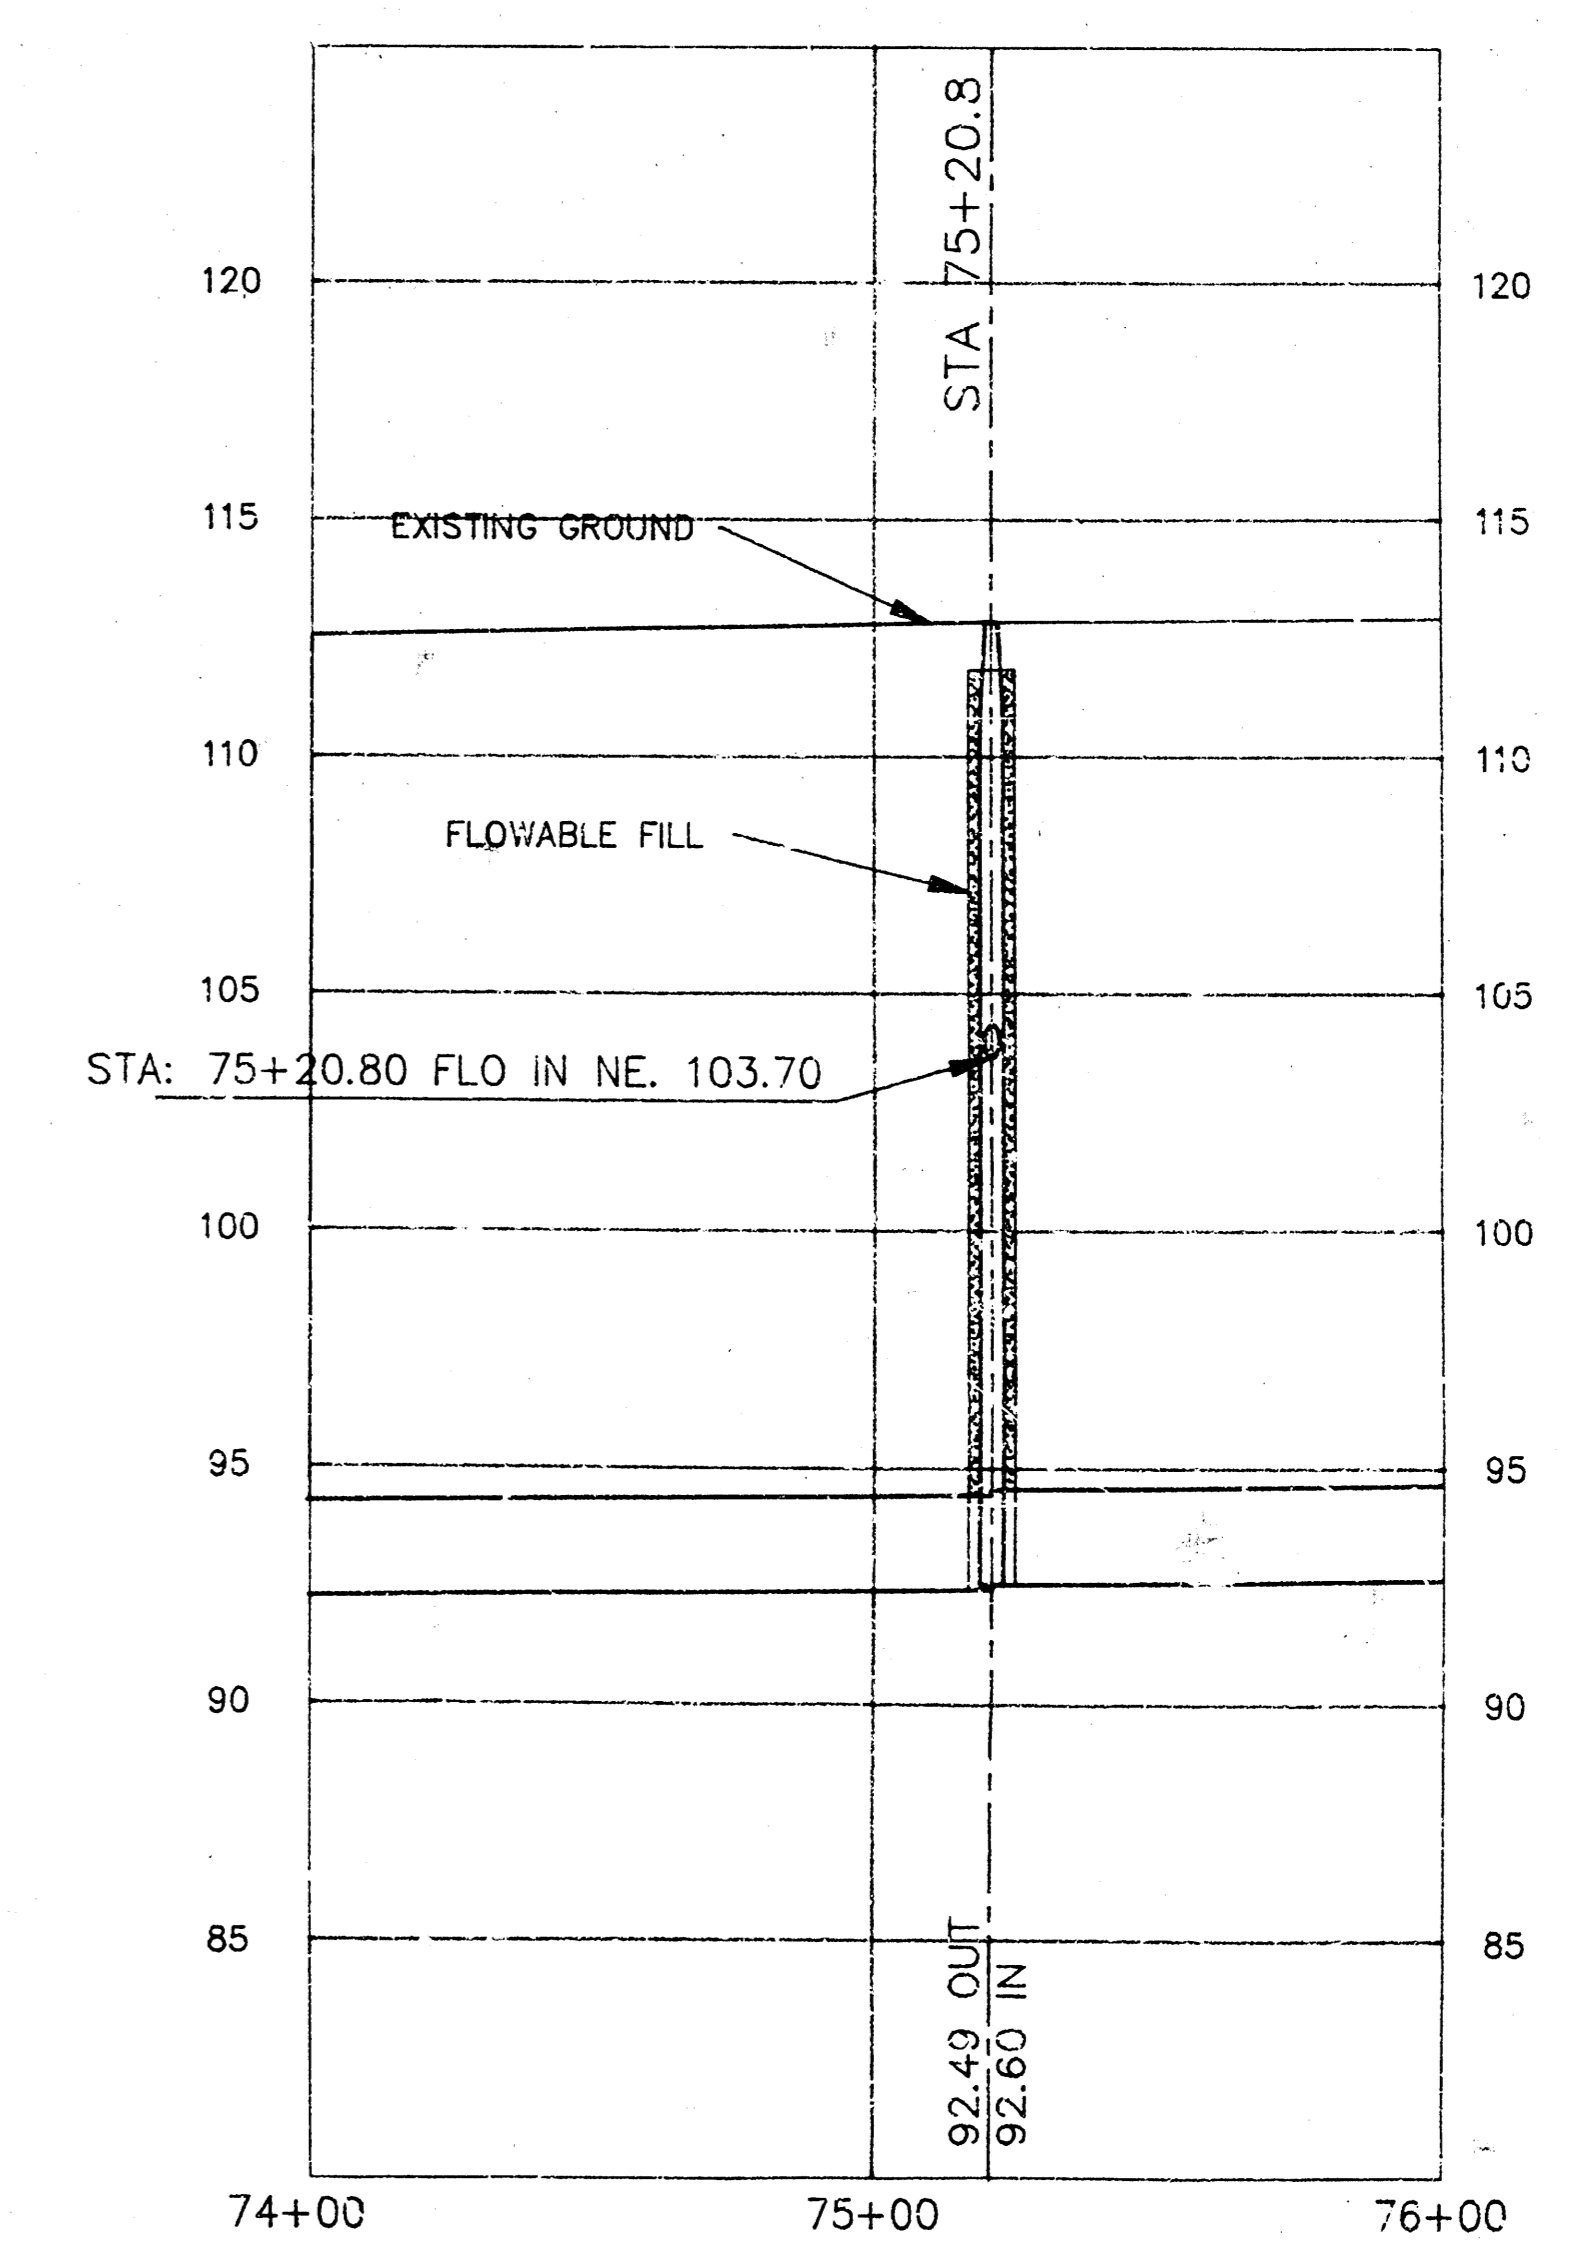

Booked 10-17-94
 As Per Plan

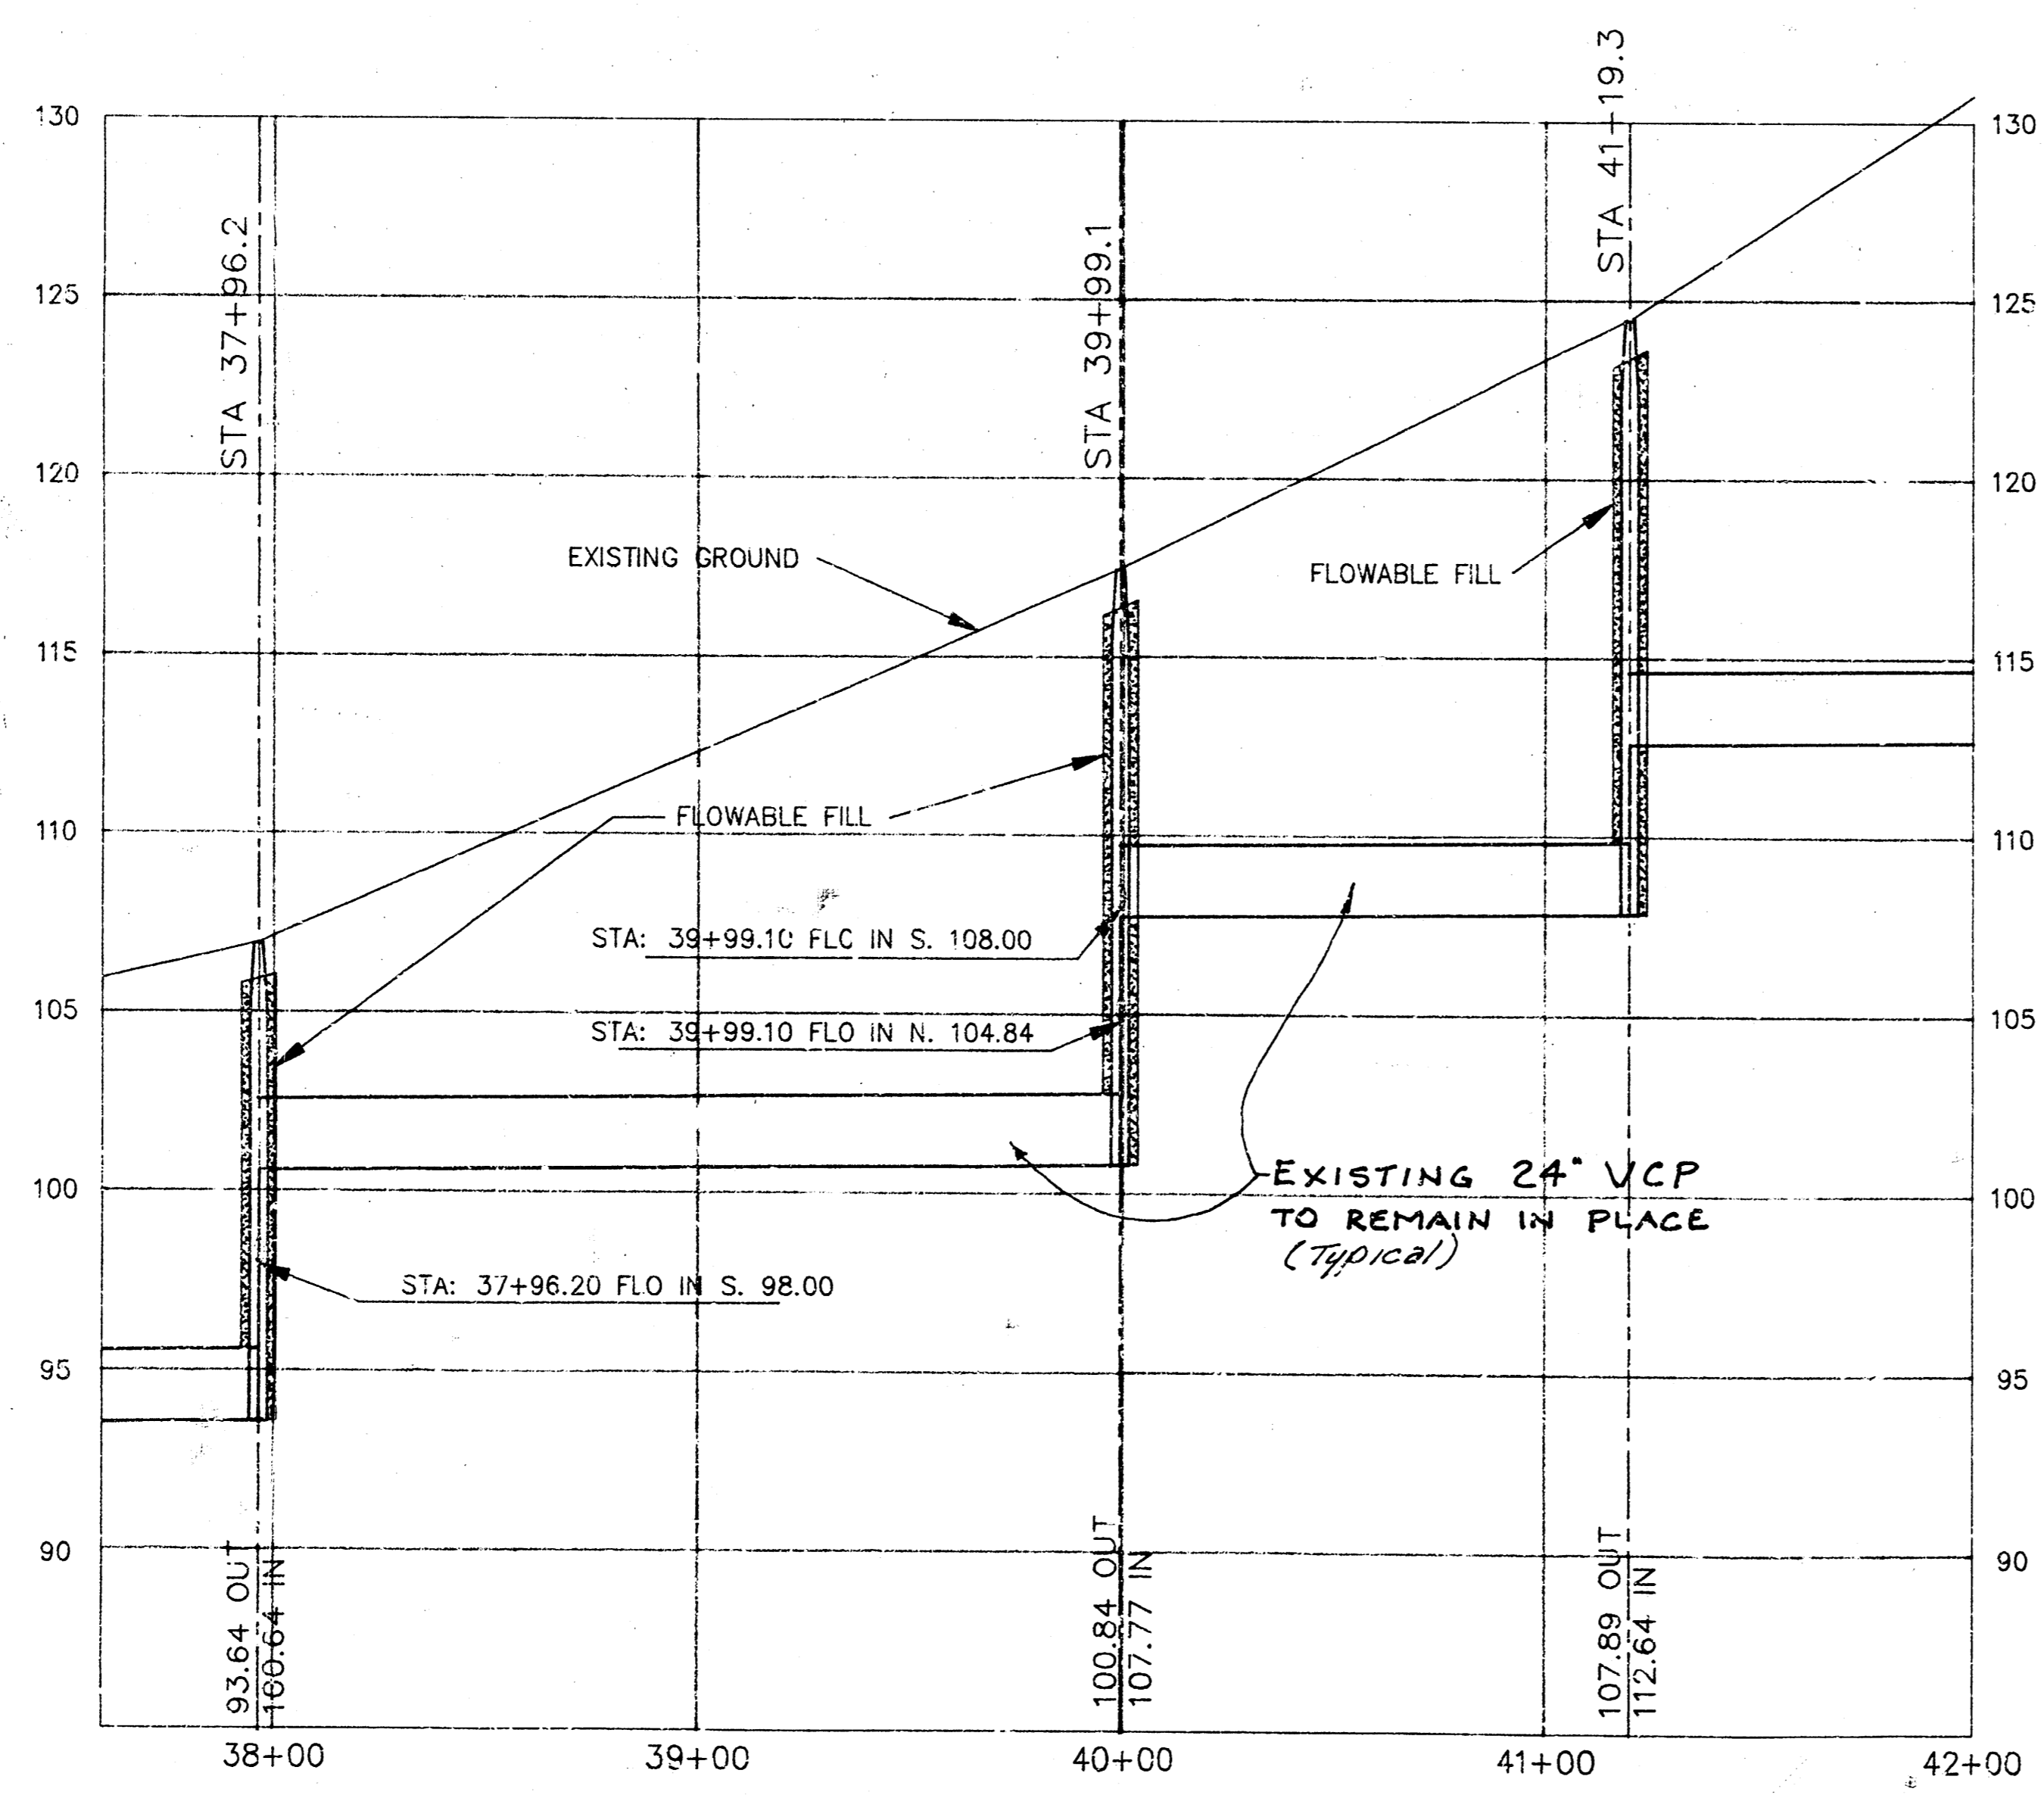