



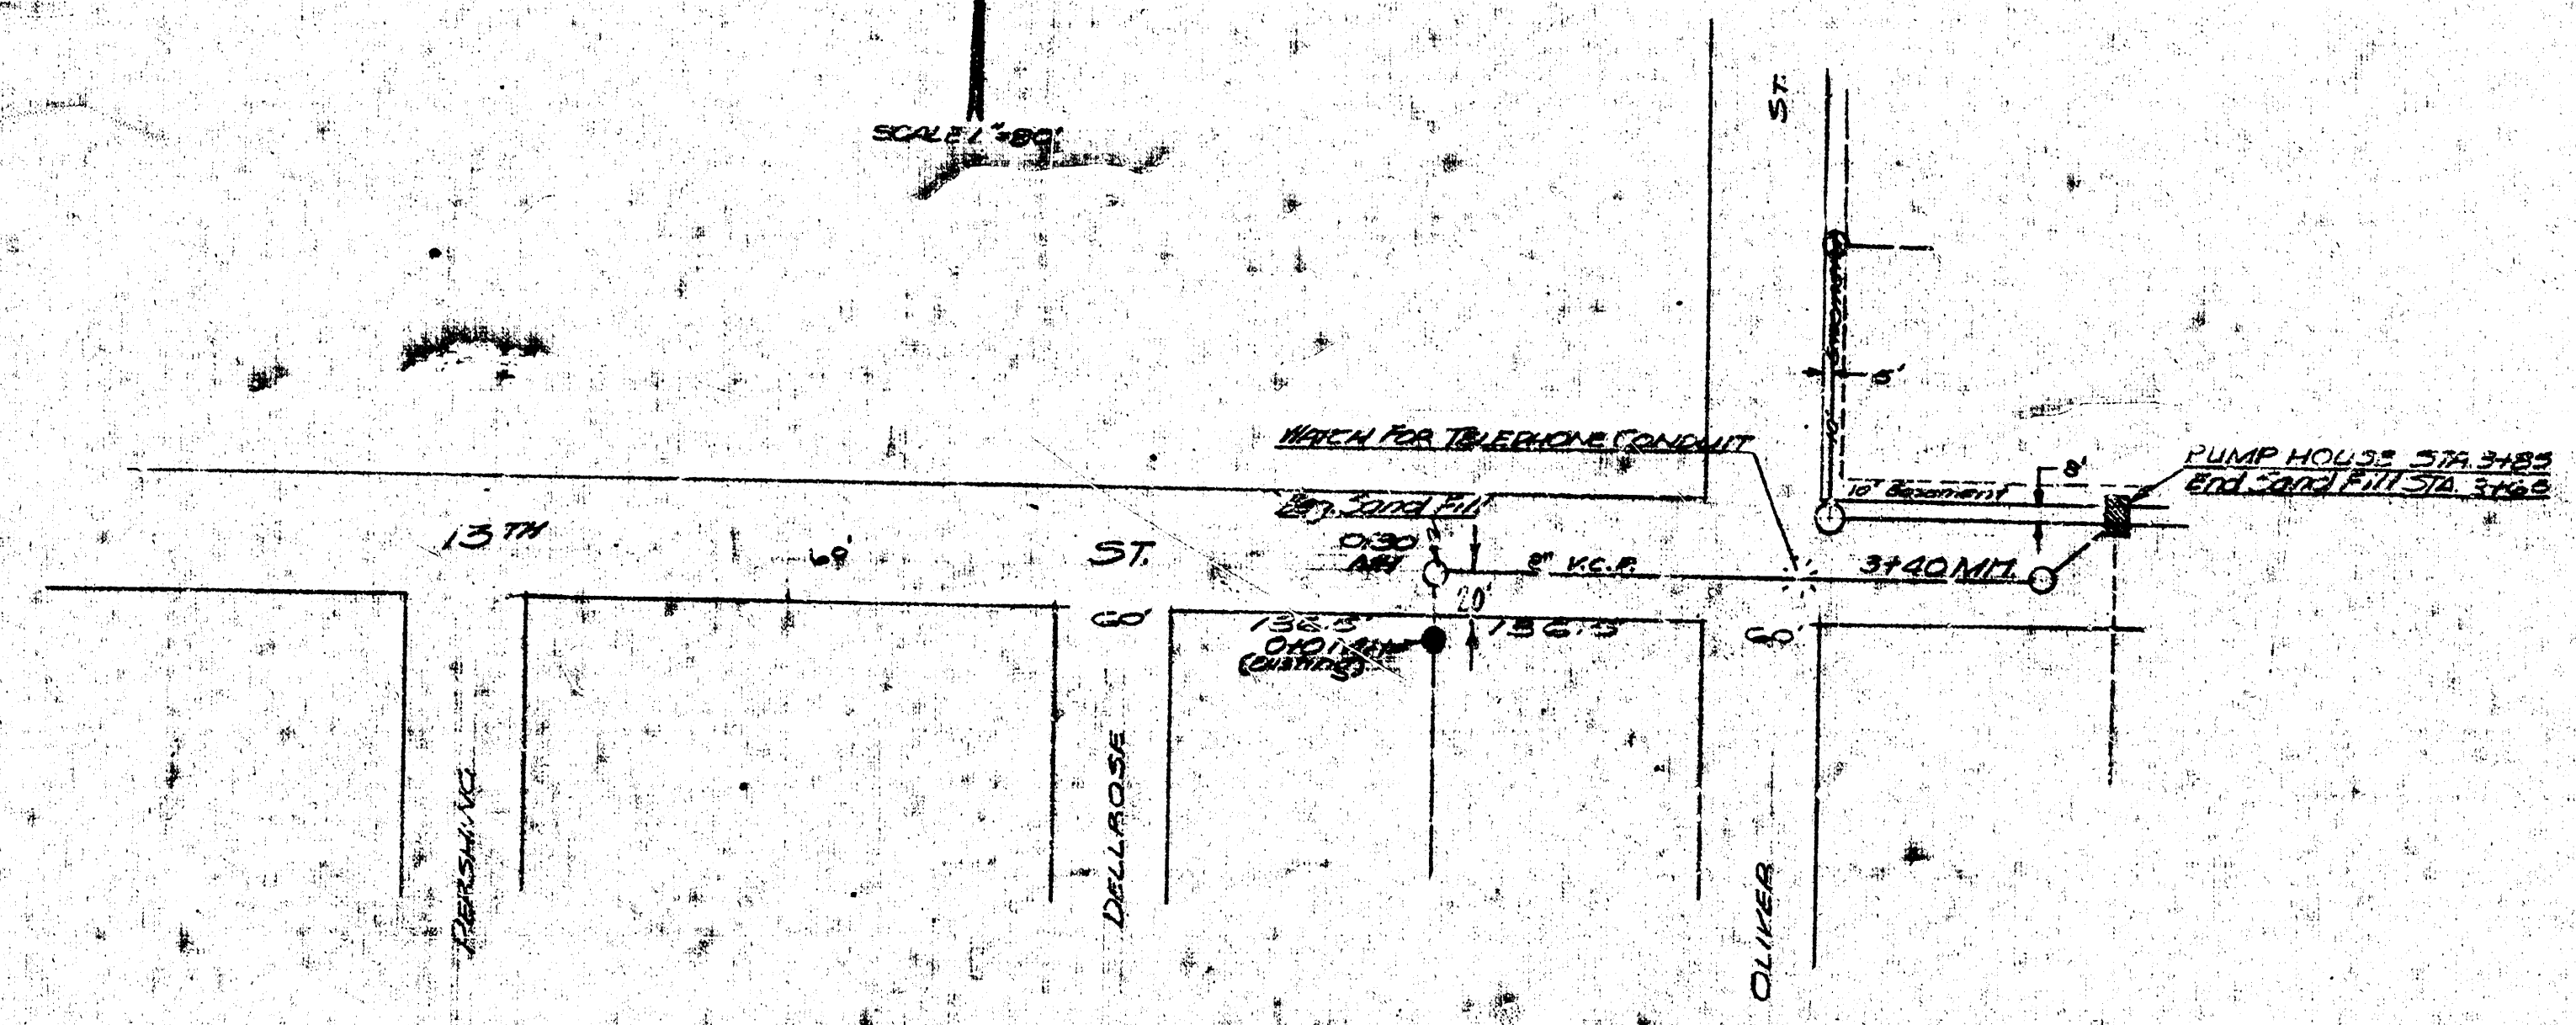

Force Main Line & Pump House @
13th & Oliver. Presently Abandoned.

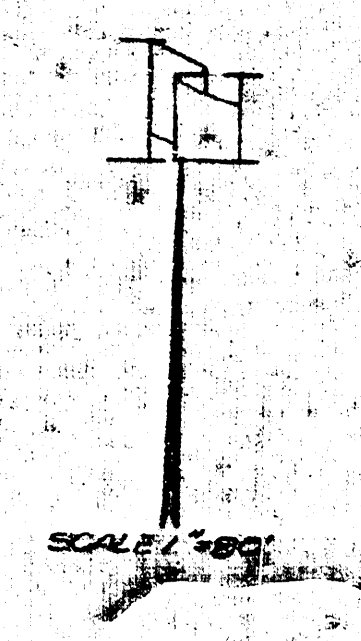