




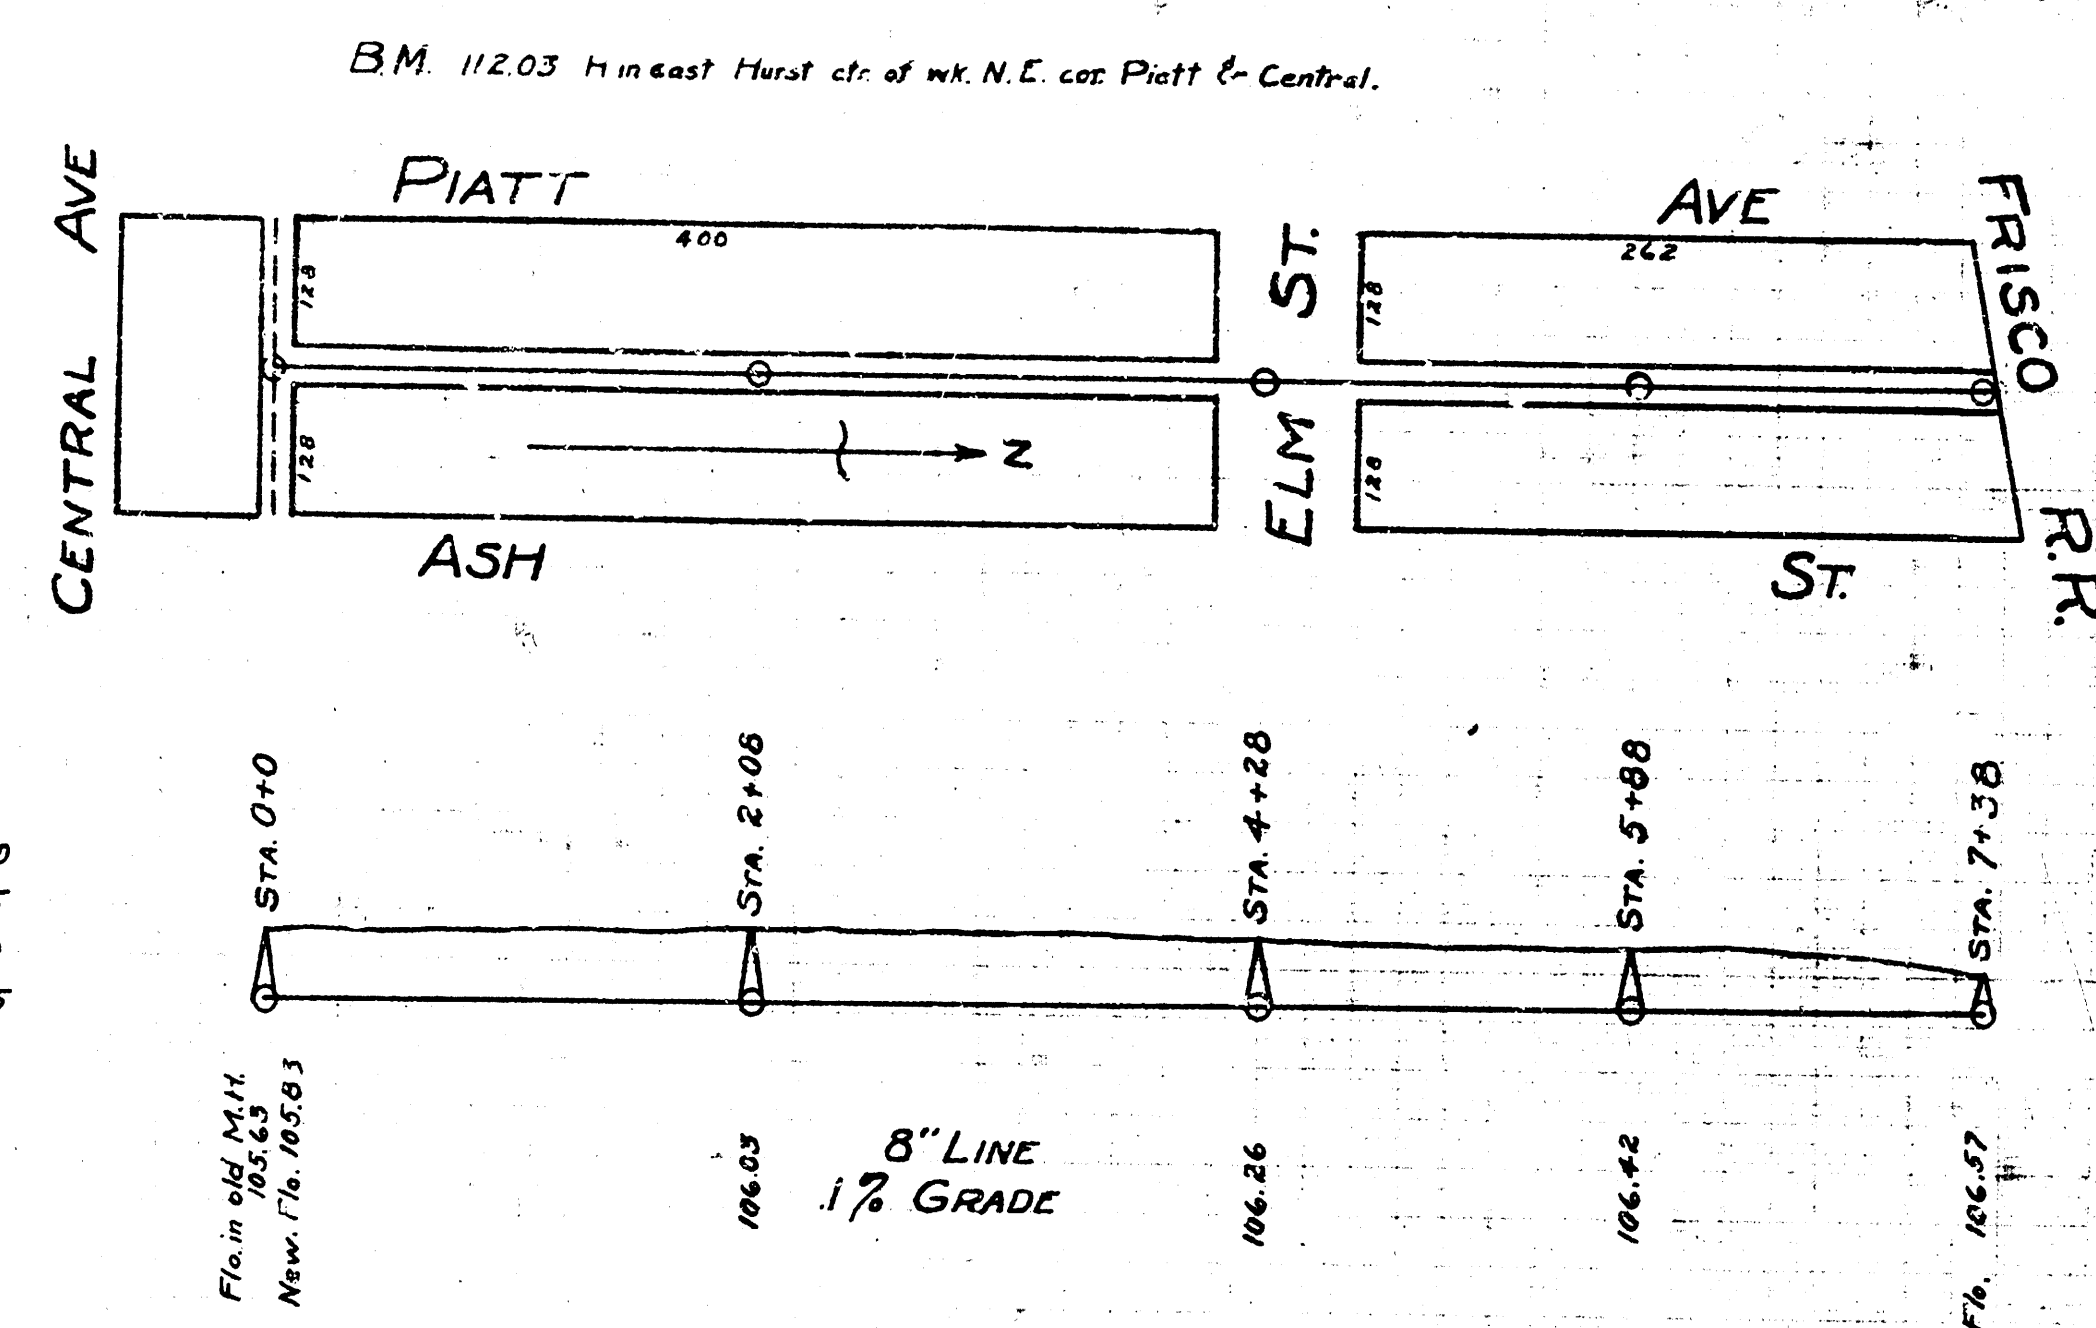

LAT 0 ~ DIST D
S.S. No. 12

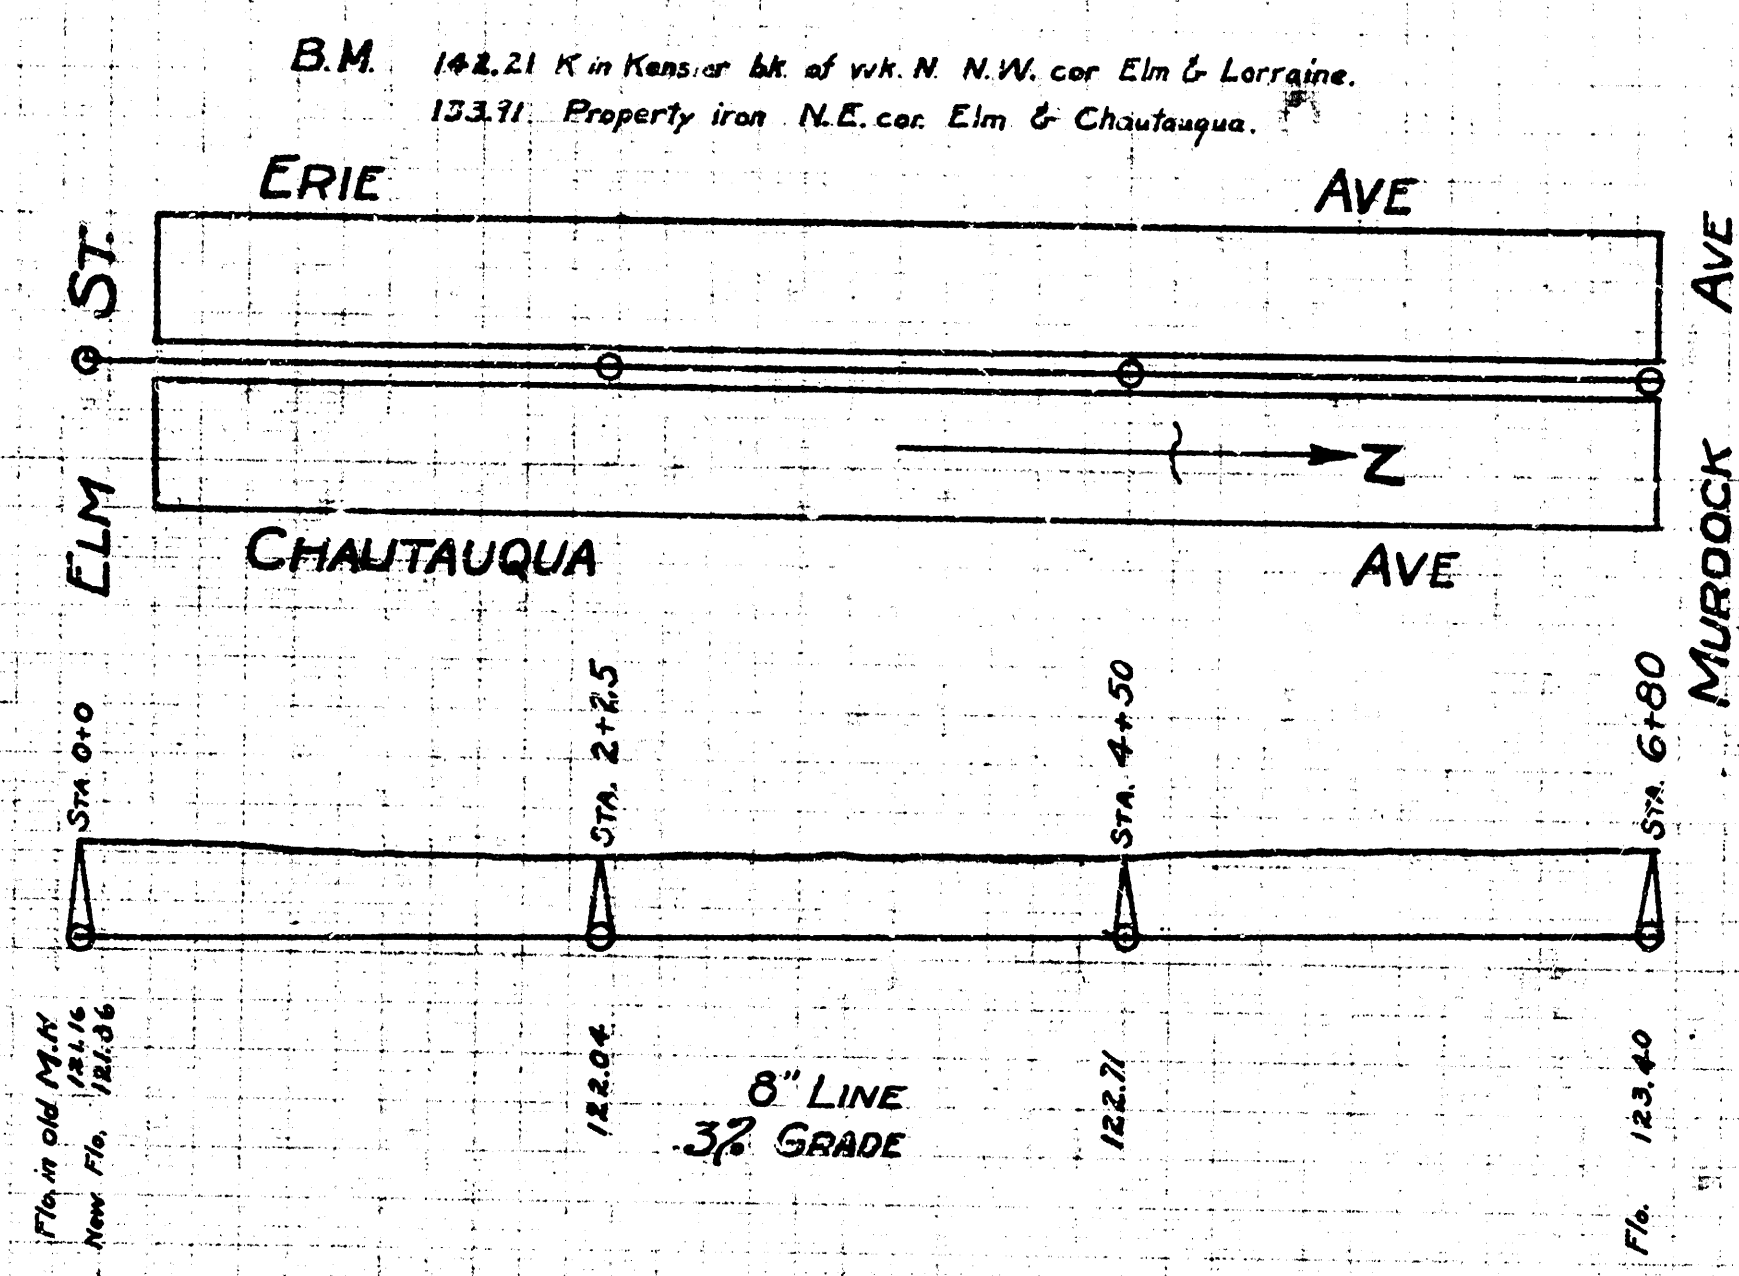

LAT. P ~ DIST D
S.S. No. 12

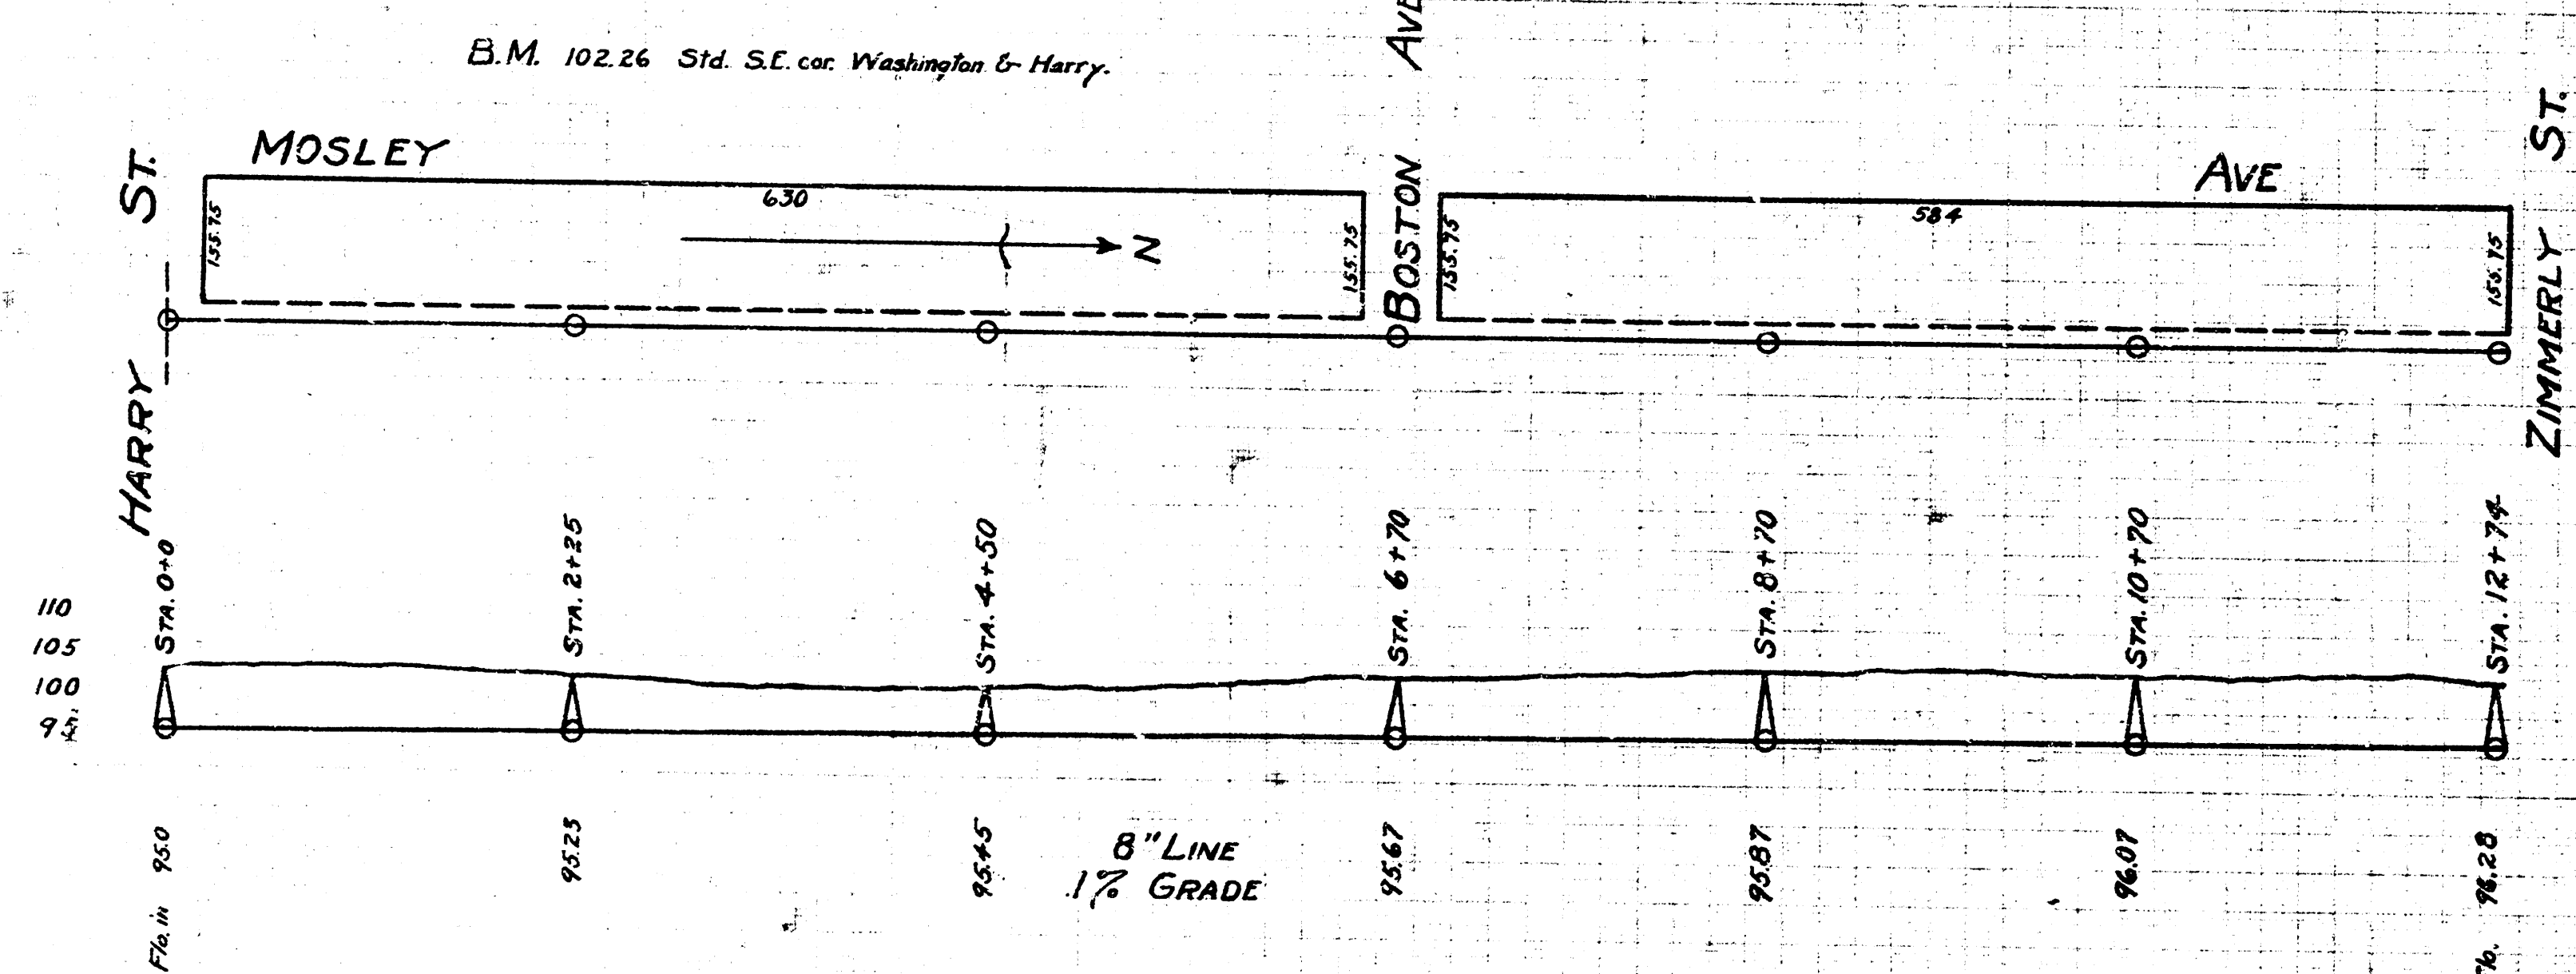

LAT 5 ~ S.S. No. 1