

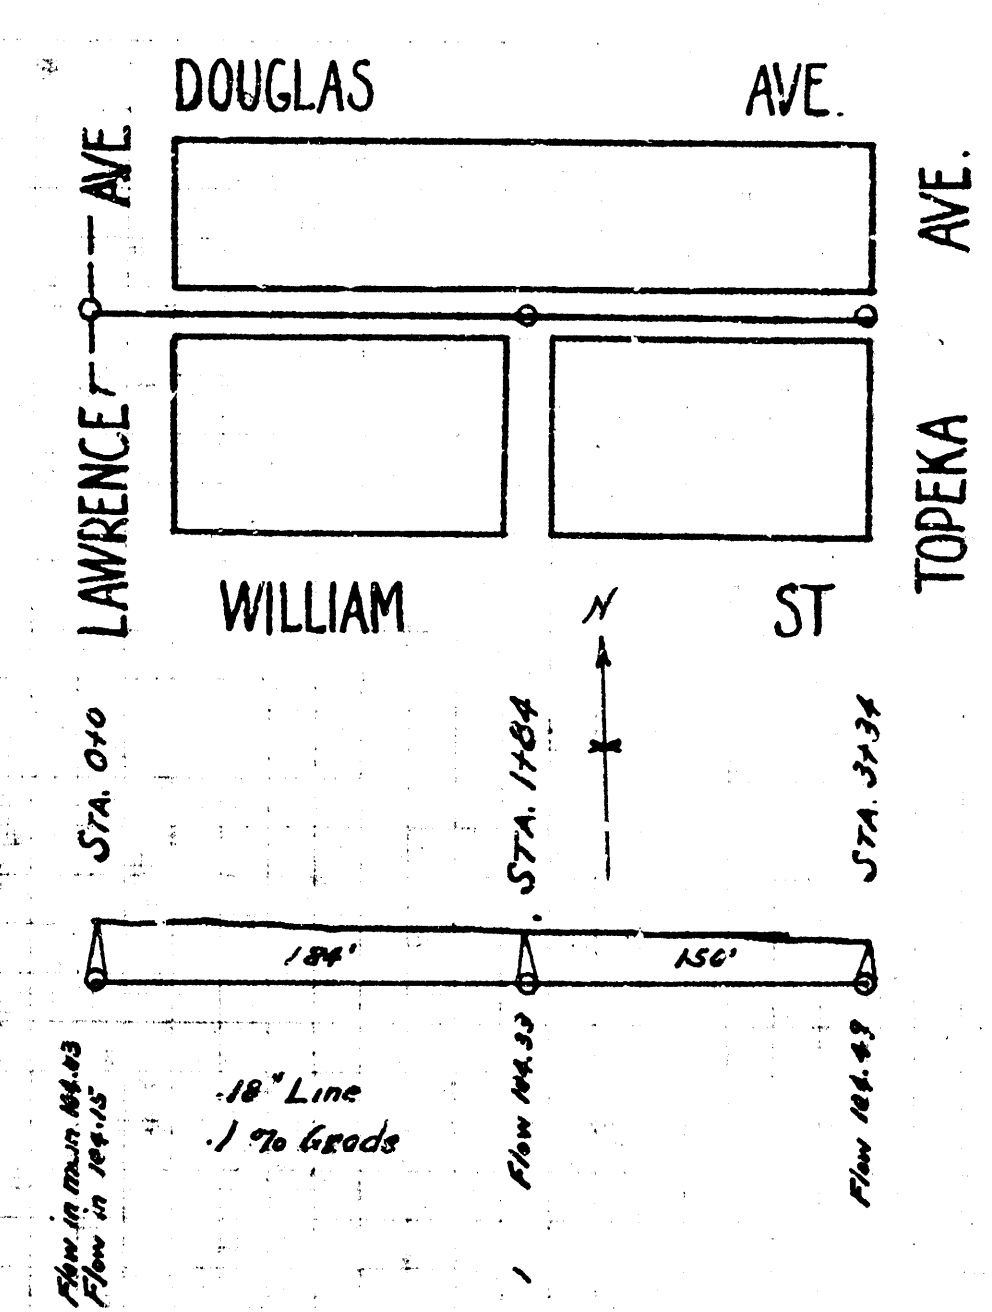
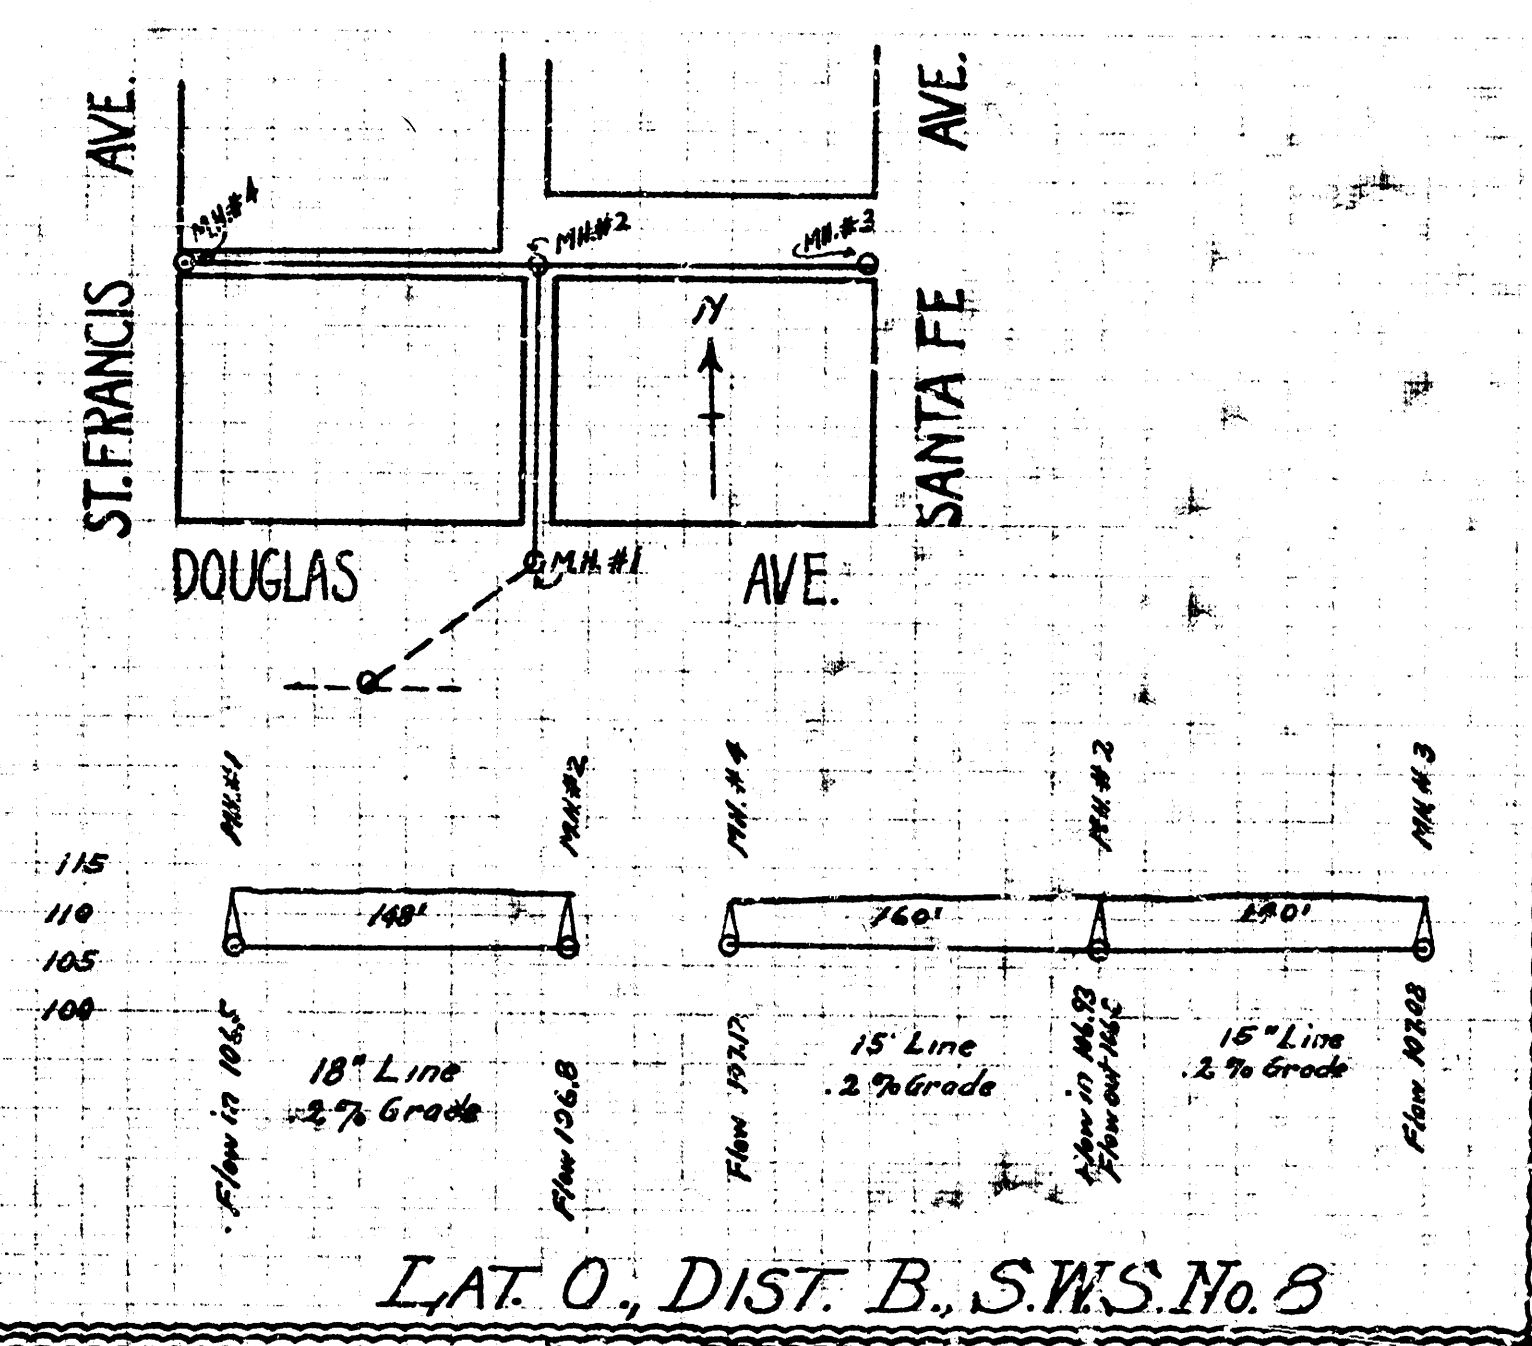


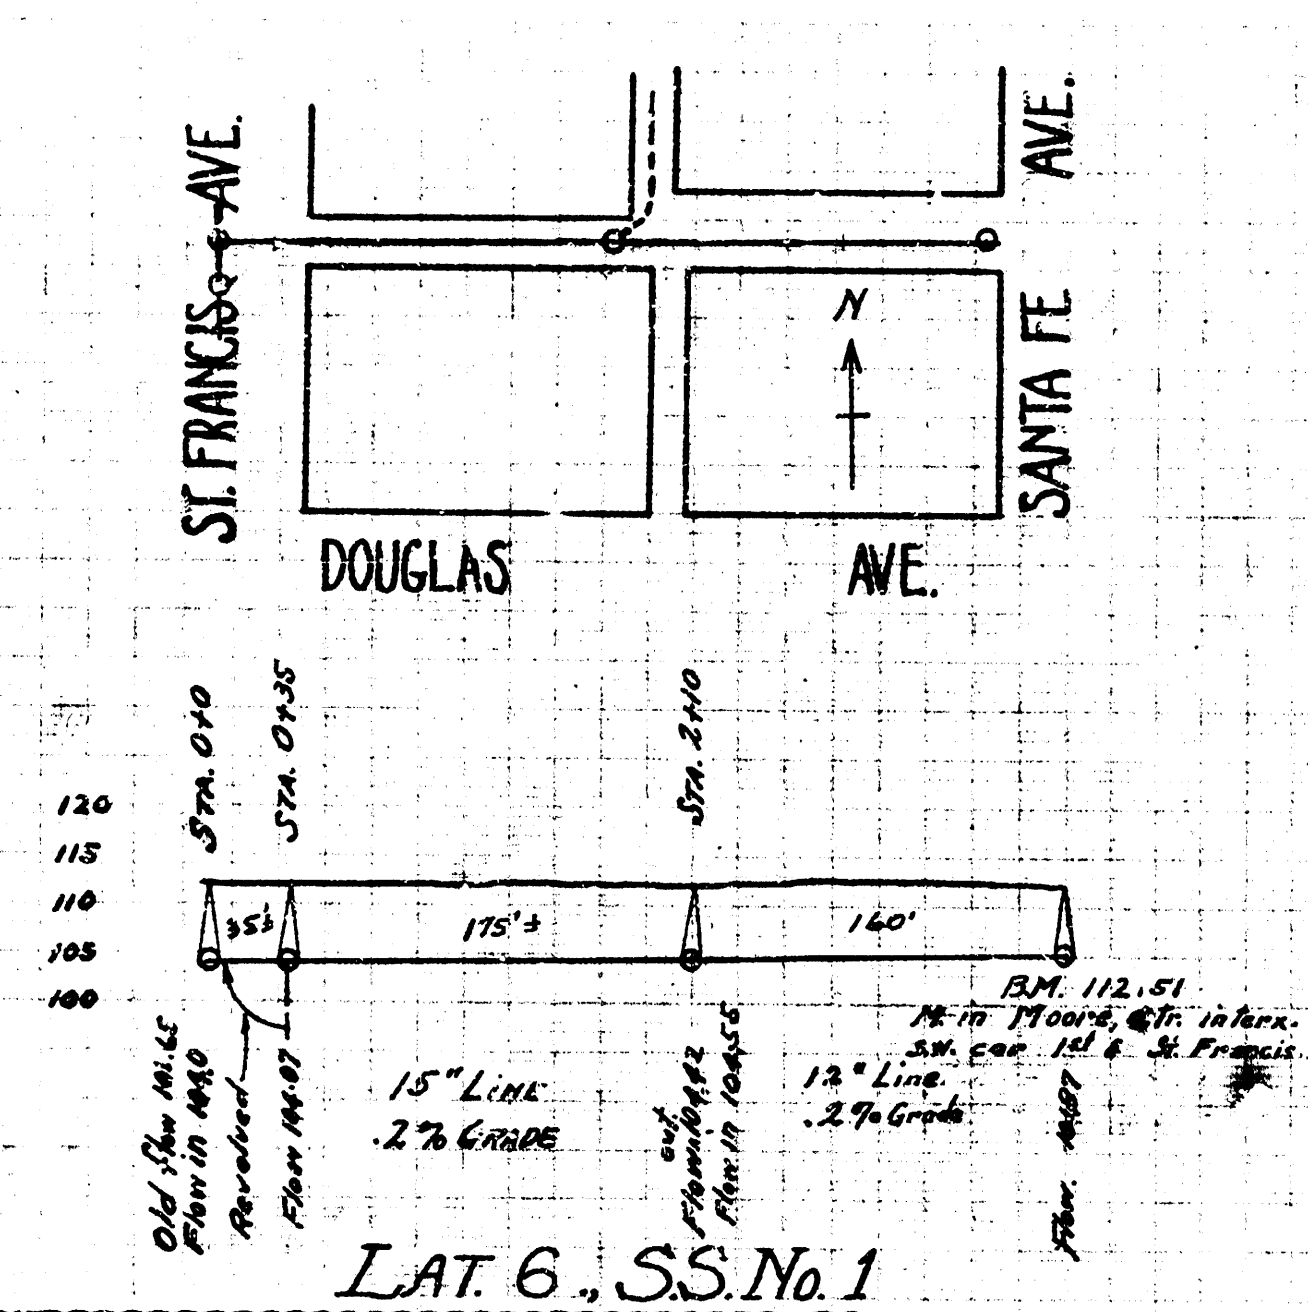

B.M. 110.33 - On south end iron water table under south window E. side Manhattan Hotel. NW cor Topeka & Douglas.

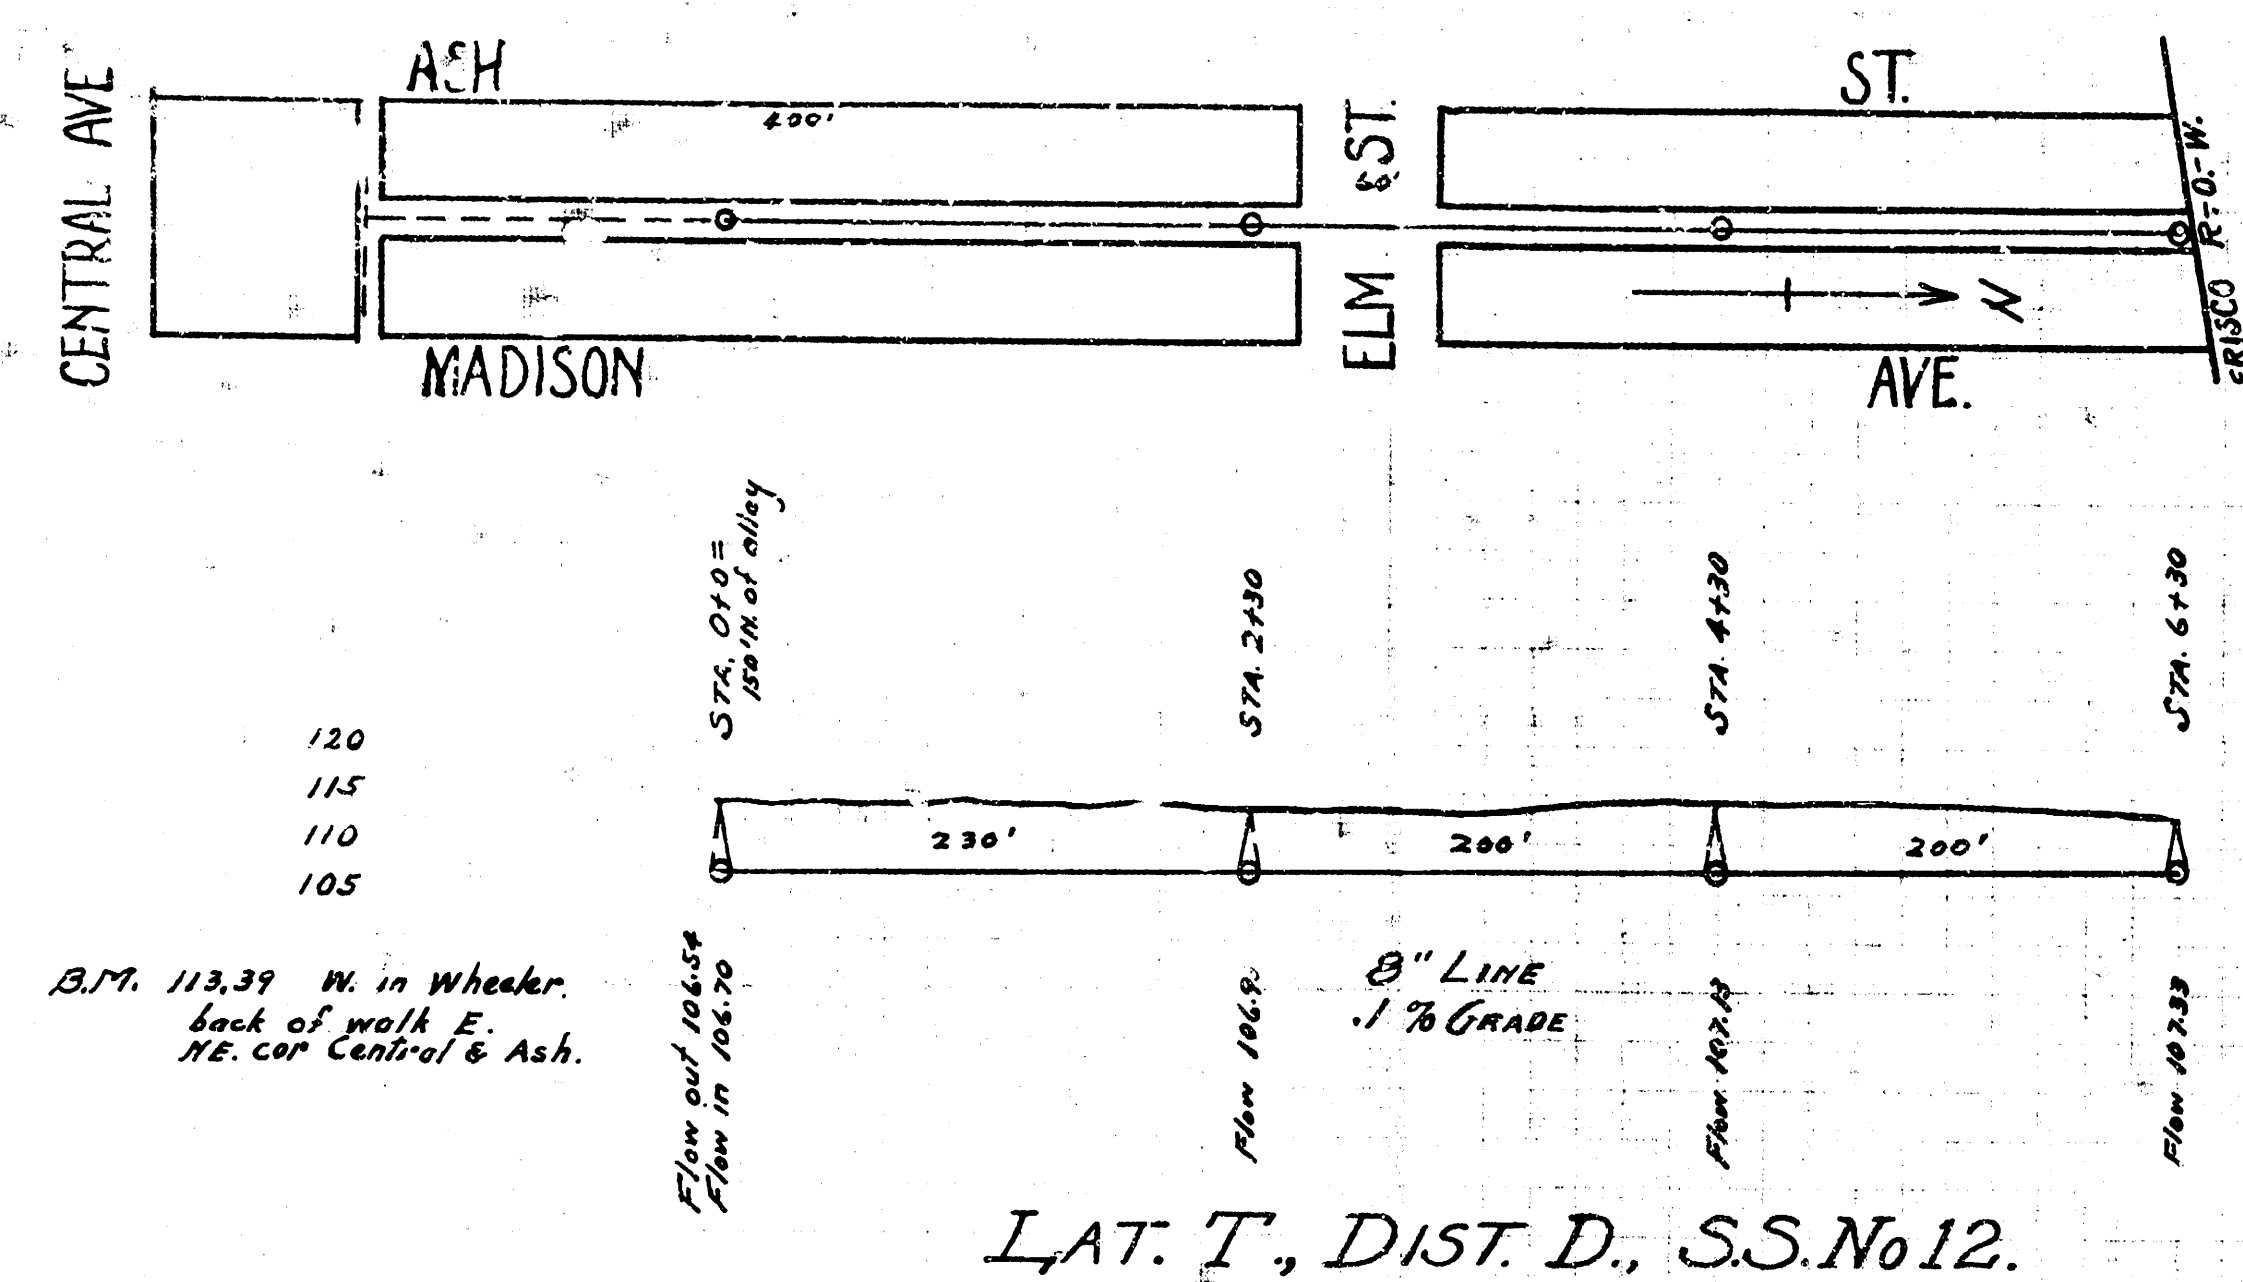