

Front of Wk.W. N.W. Waco Co. Pine

9455 Large Mulberry 31 L

WGLS Fence

N

ST

PINE

2

NOT

2943 MH

67 69 71 73 75 77

NOT IN'S DISTRICT

19 21 23

30

32

000 Bog Bar/Cut Asph.
00428 End Tr/Cut Dog Cb/Str
0158 End Cb/Str
0167 Str Light Guy Rle 10' L
0175 2x2 CB 10' R
0303 3 & 4 App. Wk.
0366 6 Free Hyd. 13' L
0537 10' Hackery Tree 23' L
0843 Water Meter 18' L
0890 & 53' Appr. Wk.
1450 & 55' Appr. Wk.
1486 & 90' Dr.

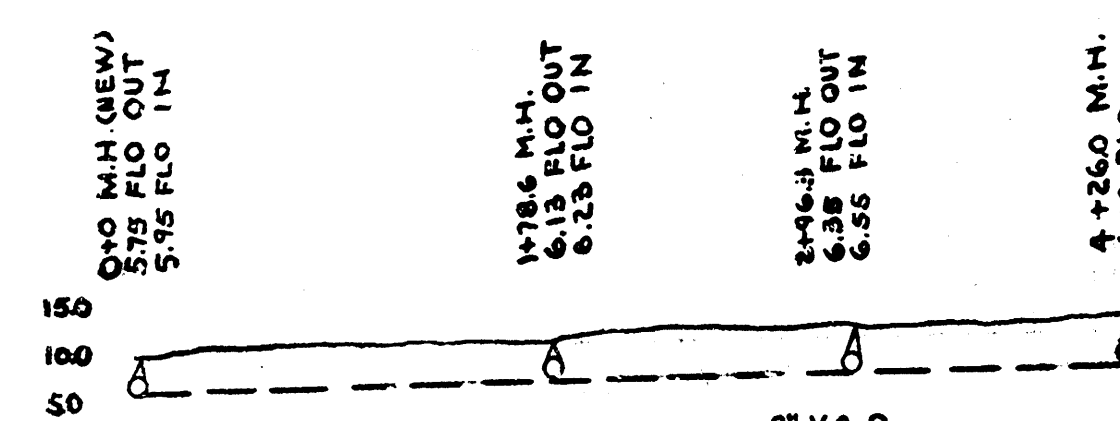


LAT 10 S.S. I
DEPT. of SERVICE
CITY of WICHITA, KANS.
Engineering Division
L.K. WHITE City Engineer
Sanitary Sewer
Scale 1" = 80'

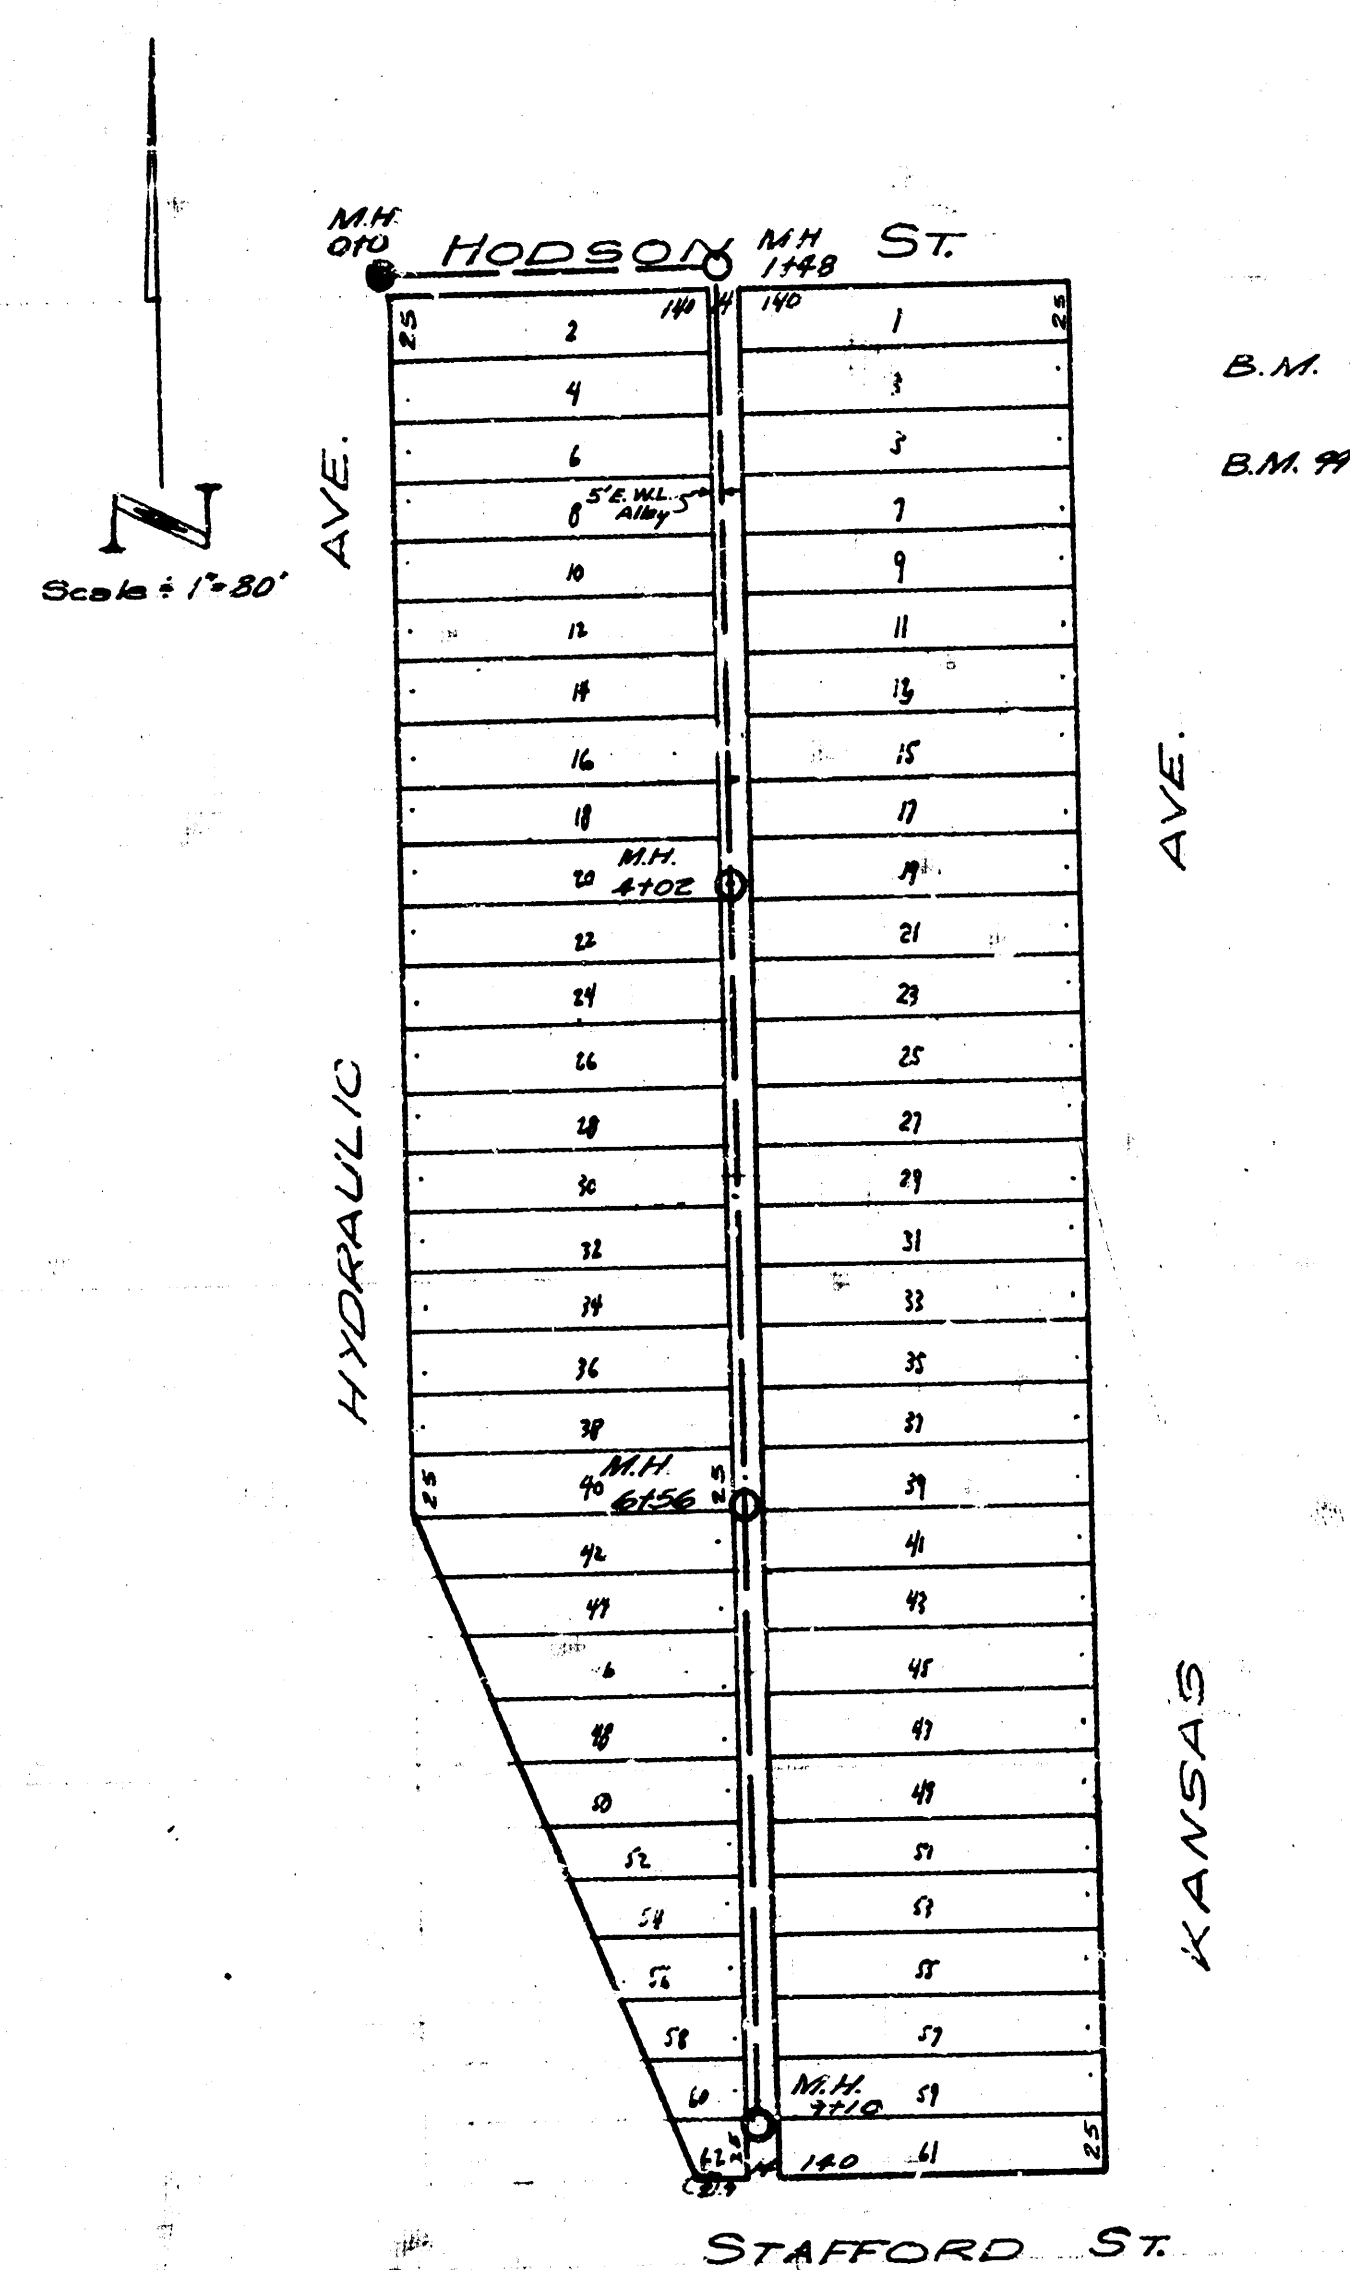

B.M. 97.10 "P" IN RITCHIE E.C. RET. ALLEY S.S. HODSON
BETWEEN KANSAS & HYDRAULIC

B.M. 97.13 N.W. COR. CONC. PORCH 1ST. HOS. WEST
KANSAS S.S. STAFFORD.

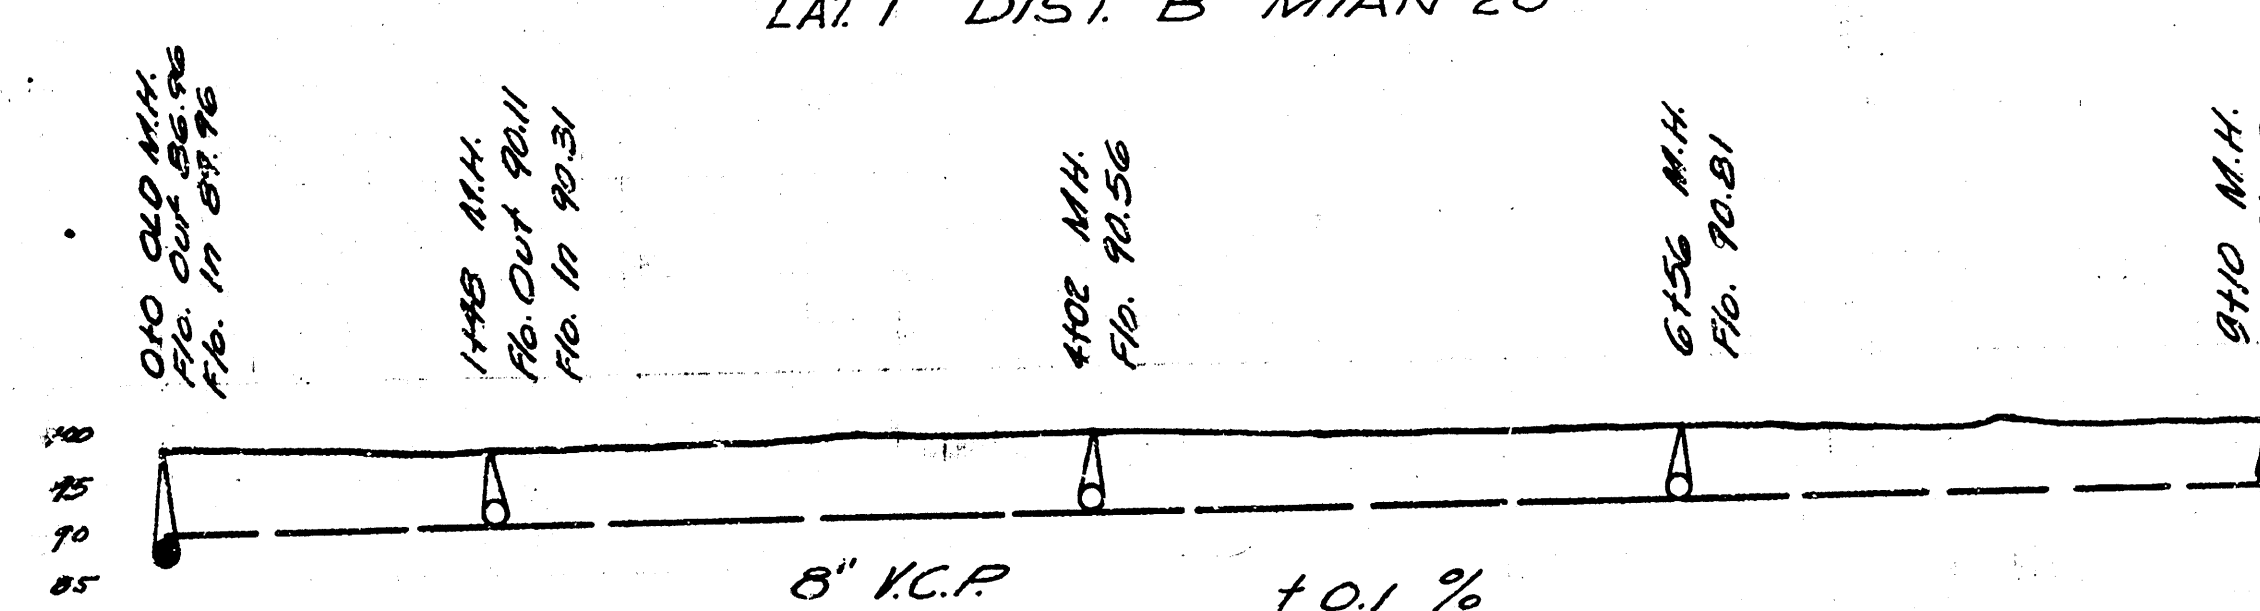

DEPARTMENT OF SERVICE
WICHITA CITY OF KANSAS
Engineering Division
L. K. WHITE City Engineer
Sanitary Sewer Scale 1"=80'