


Plan of
Sewer District of 3.

SCALE 100' TO ONE INCH

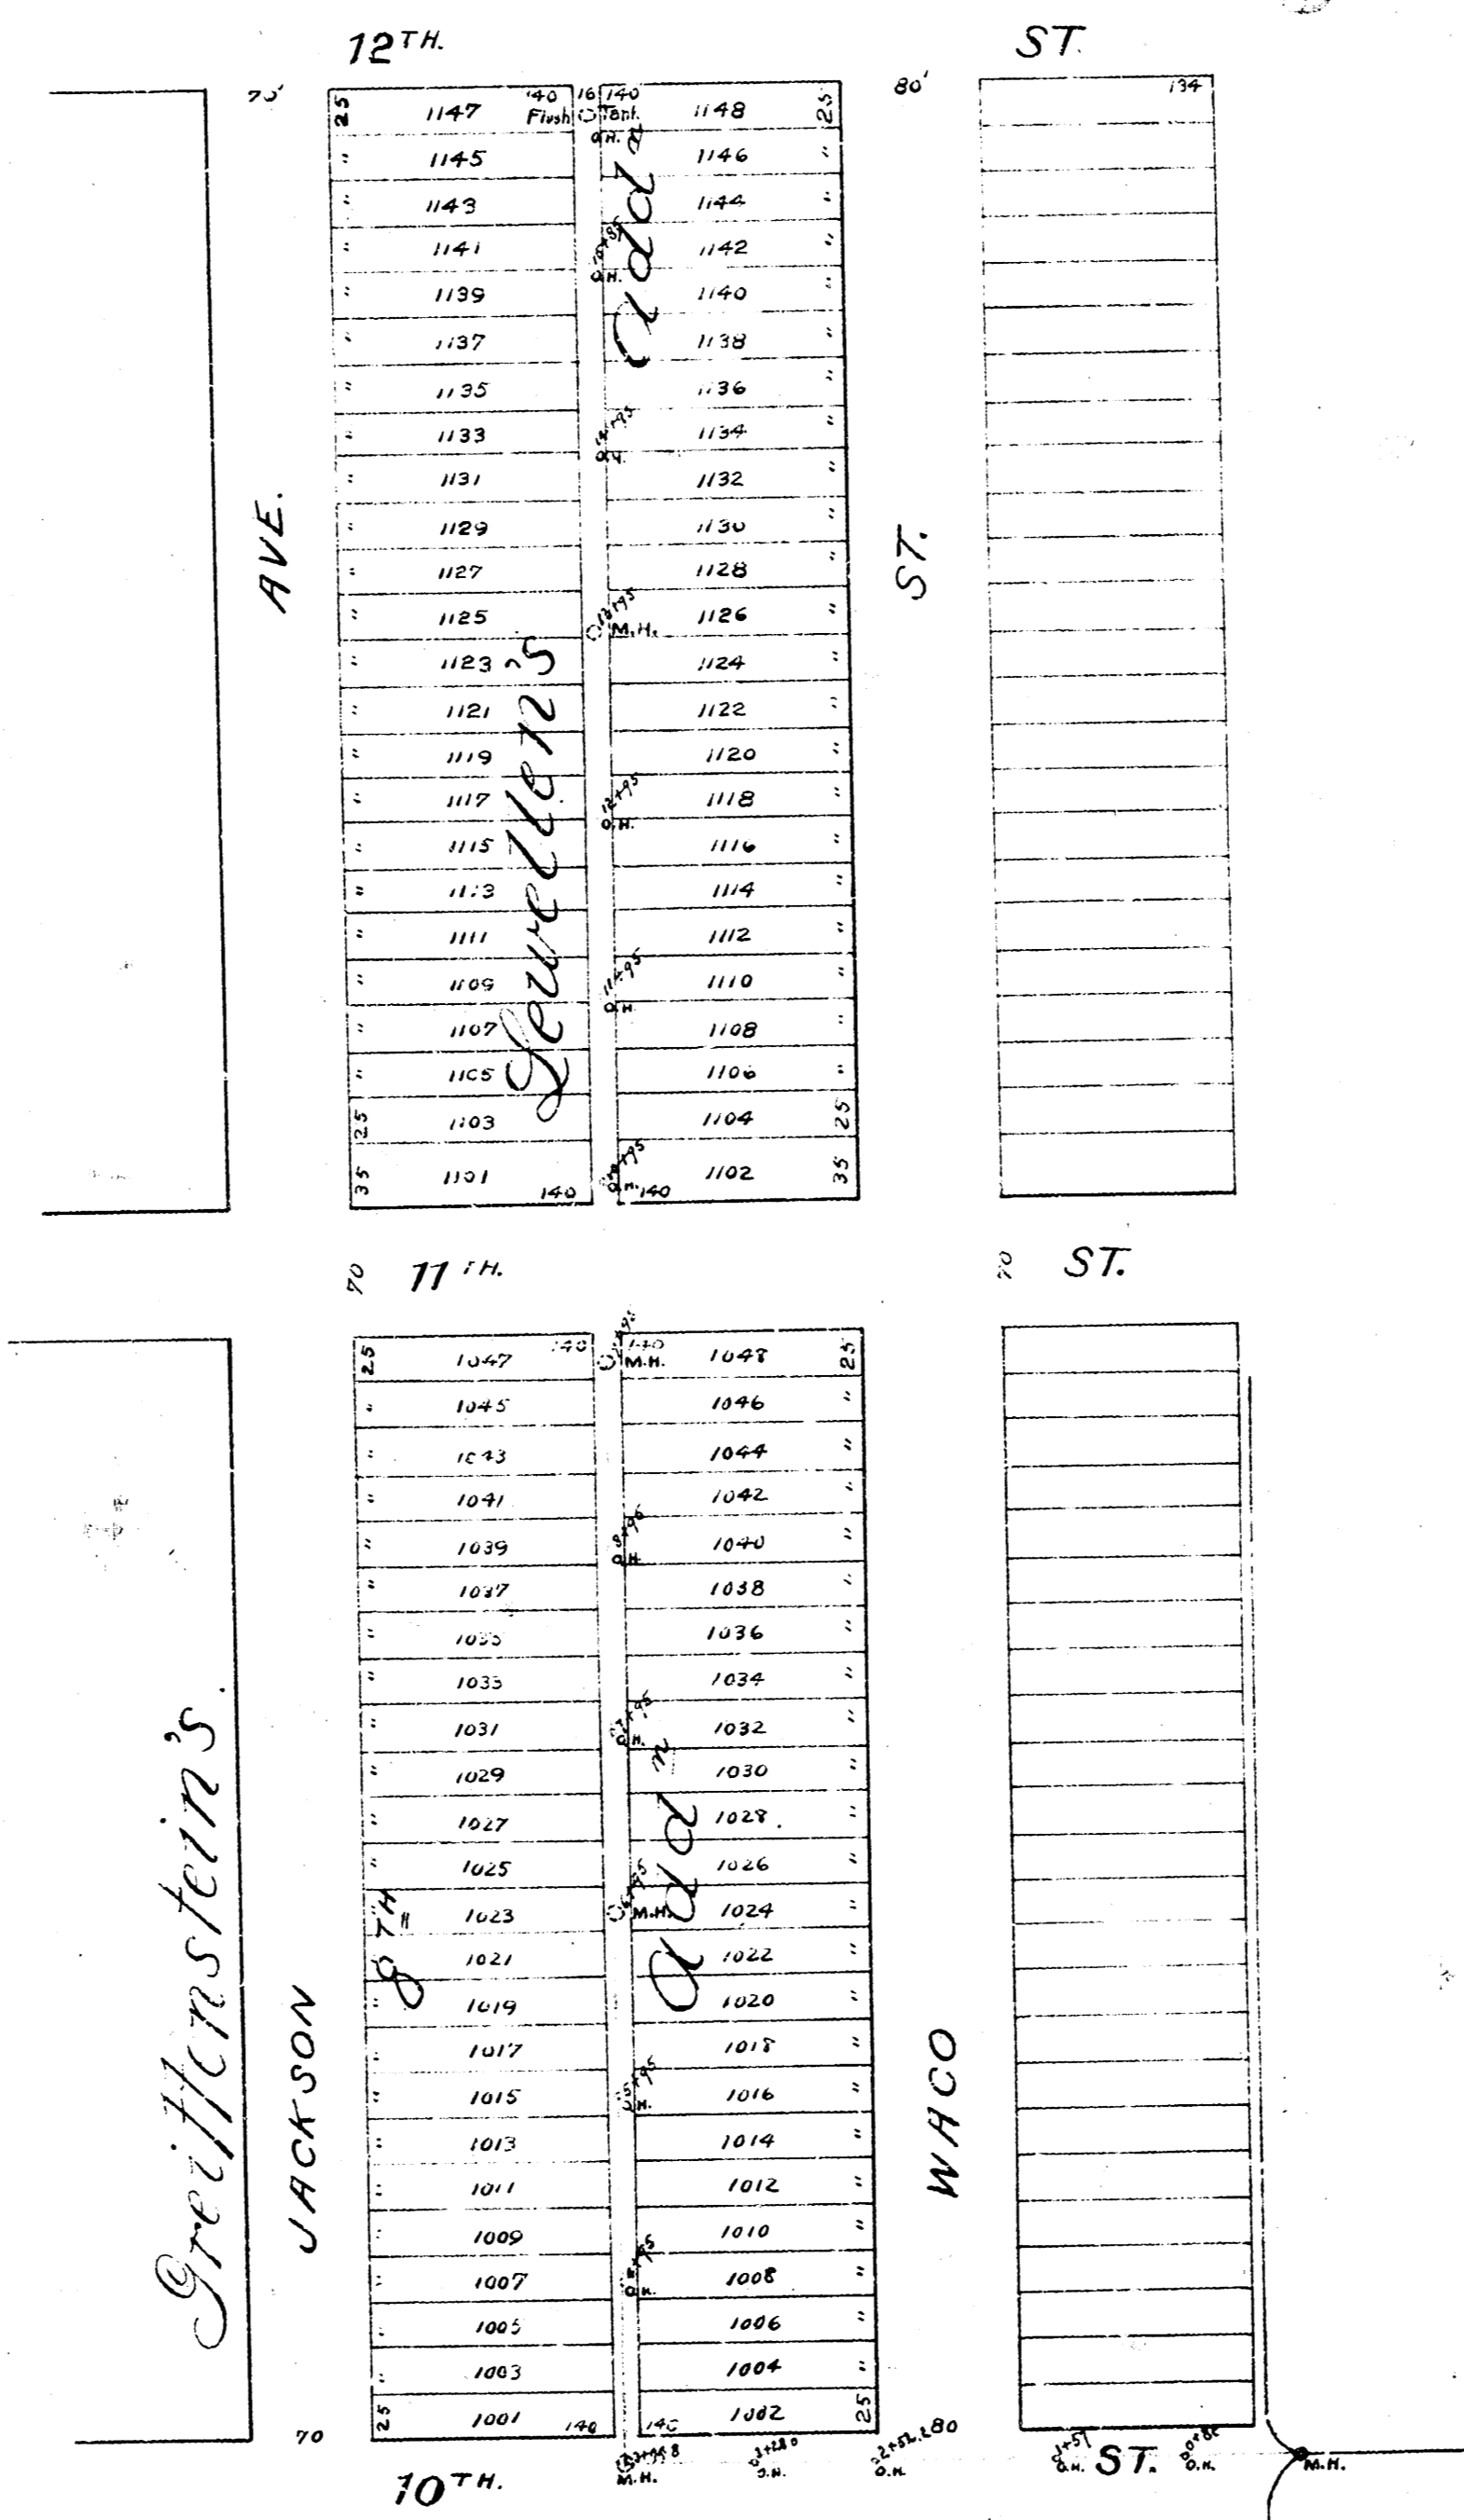

Jan. 1893
No. 3