



Date June 1951  
 Drawn by J.L.A.  
 Checked by Mark Bean, Jr.  
 H-2 & H-3


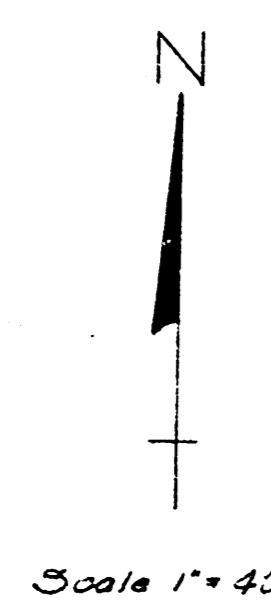


NOTE: Reference Property Line Stakes Prior to Construction.

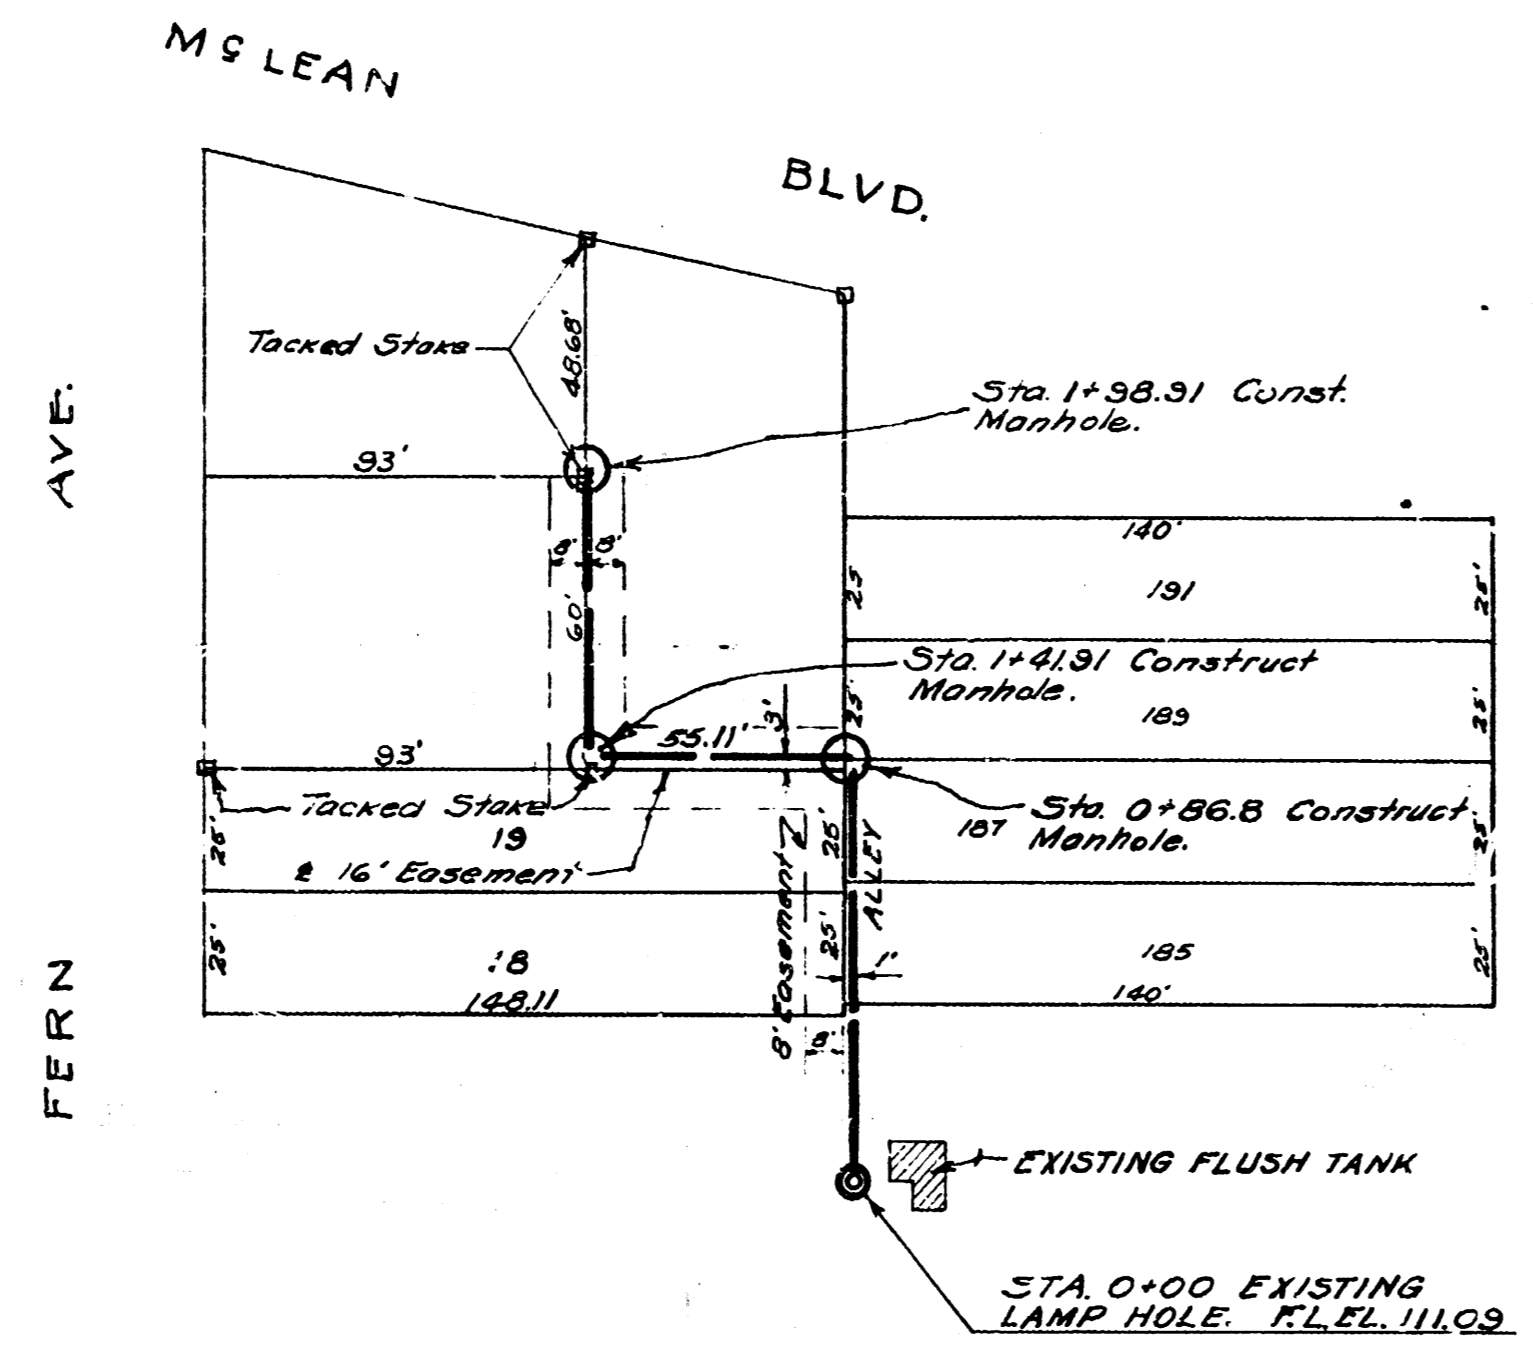


B.M. W. Rim of Manhole NW  
 Corner Vine & St. Louis El. 115.37


NOTE BOOK NO. H2  
 Scale: 1" = 40' Horiz.  
 1" = 4' Vert.

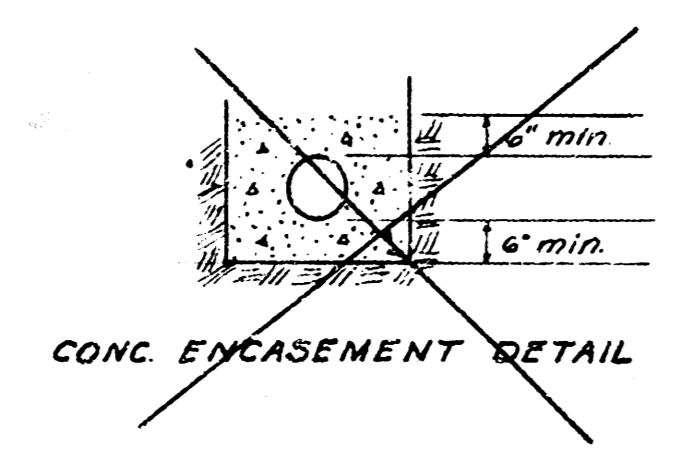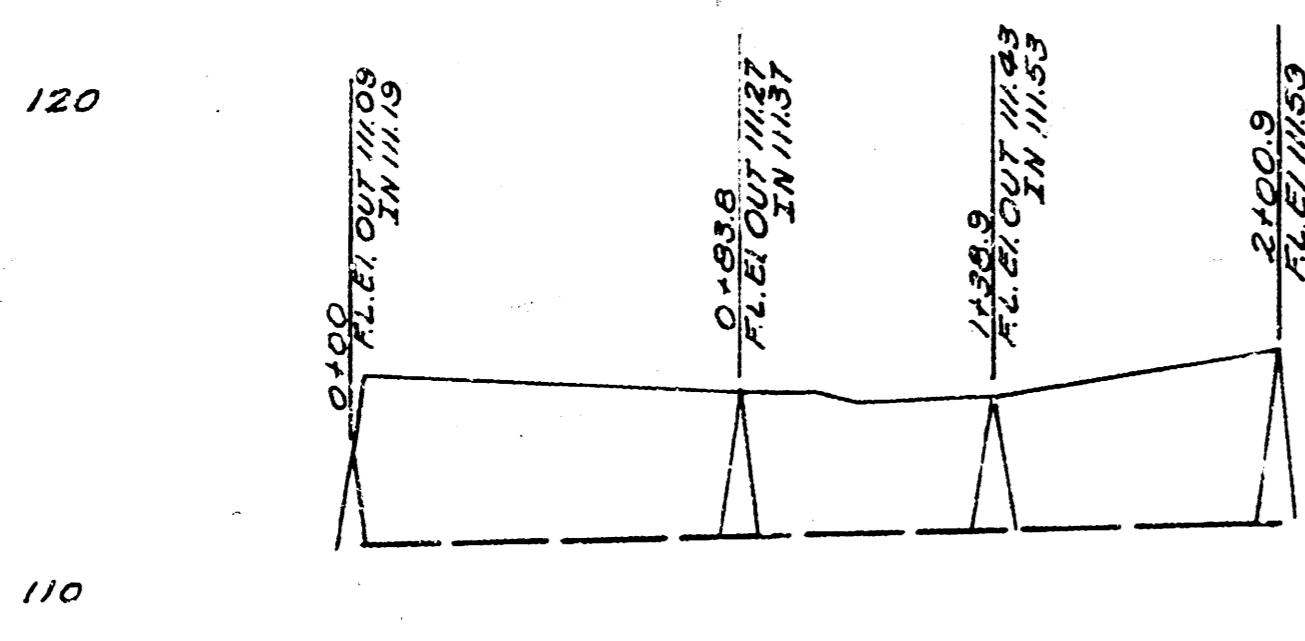

LAT P DIST. S.S. MAIN B  
 CITY OF WICHITA KANSAS  
 L.K. WHITE, CITY ENGINEER  
 Proj. No. C21-33

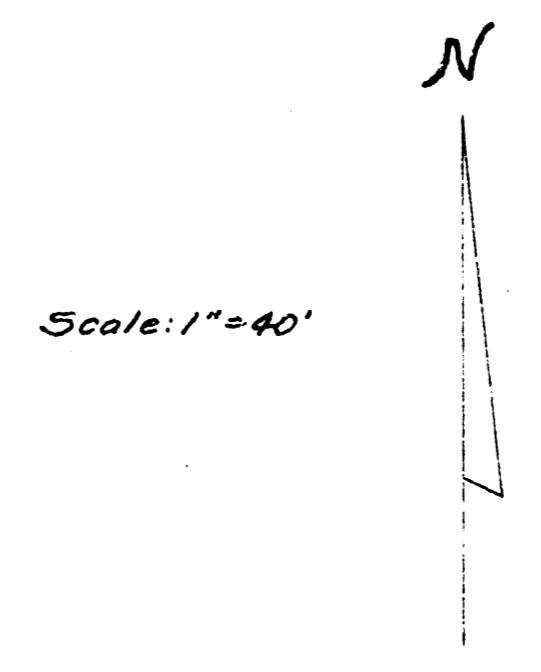


Sand backfill trench Sta 1+06.5 to Sta 1+42.5

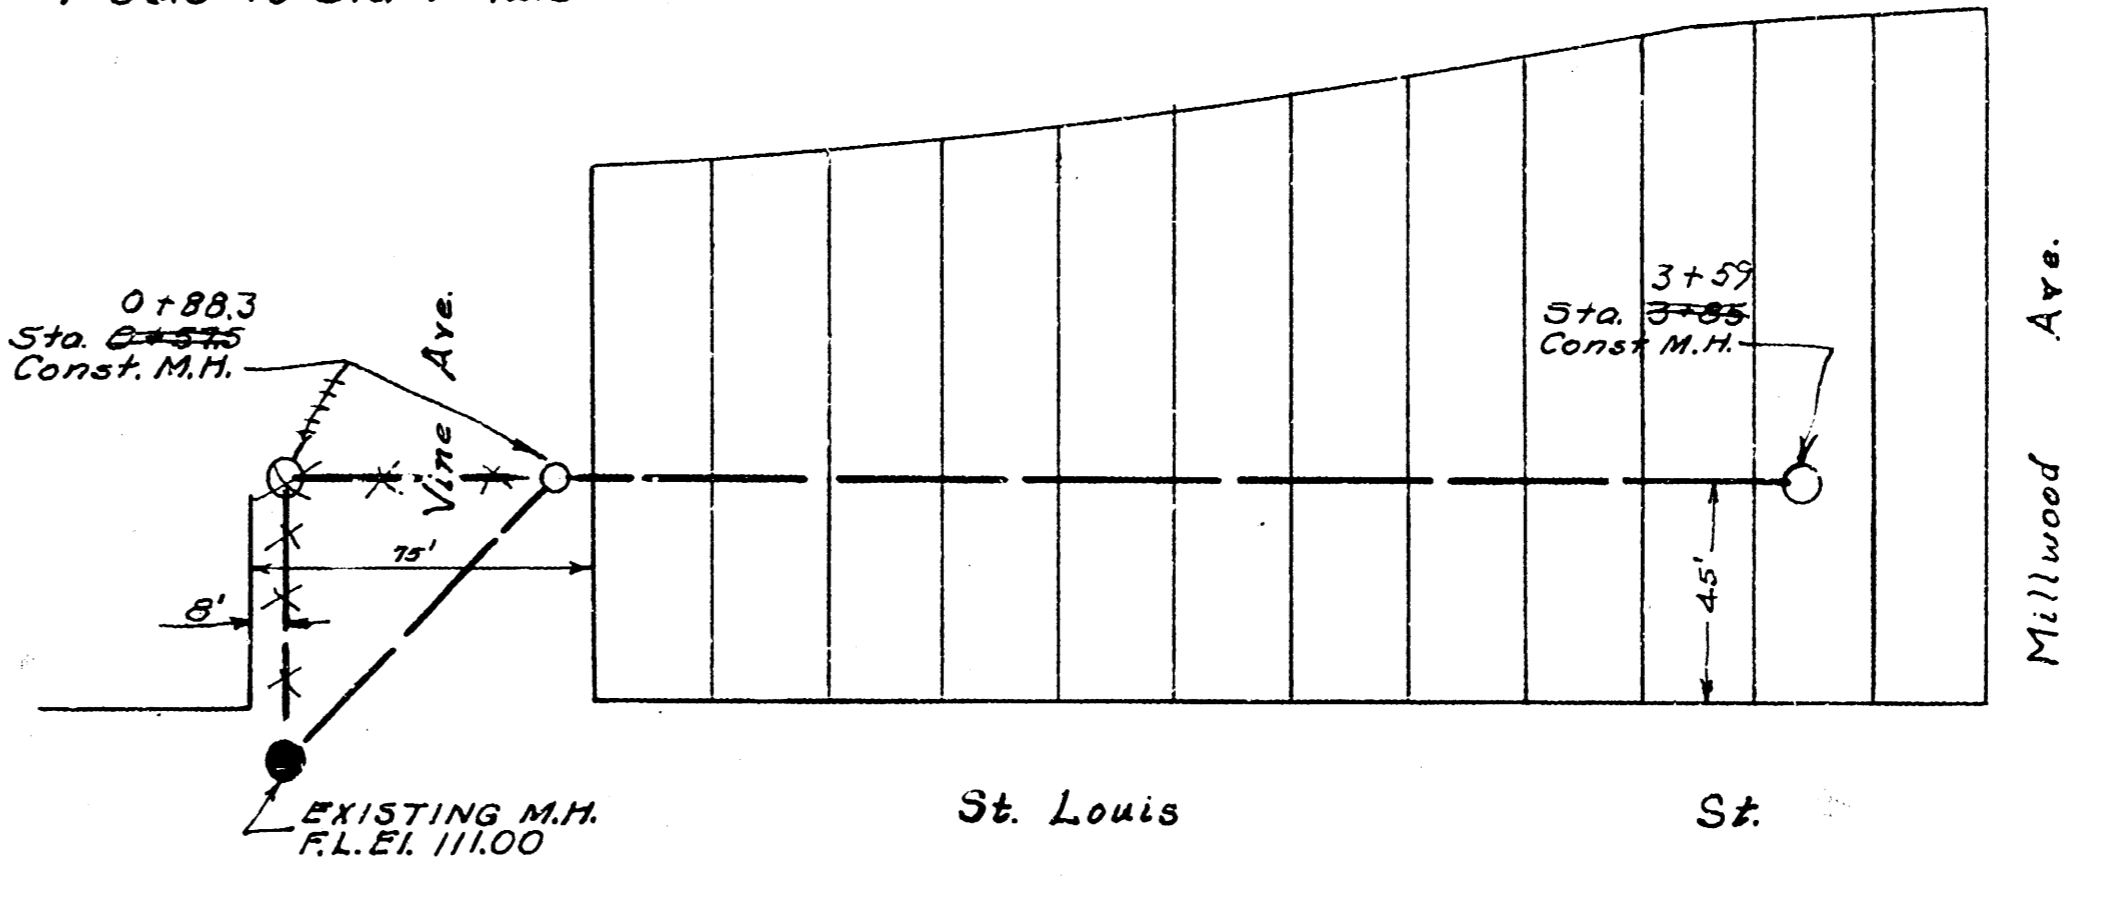


Scale: 1"=40'  
 Book H-3

B.M. 115.37 W. rim of M.H. @ Sta. 0+00

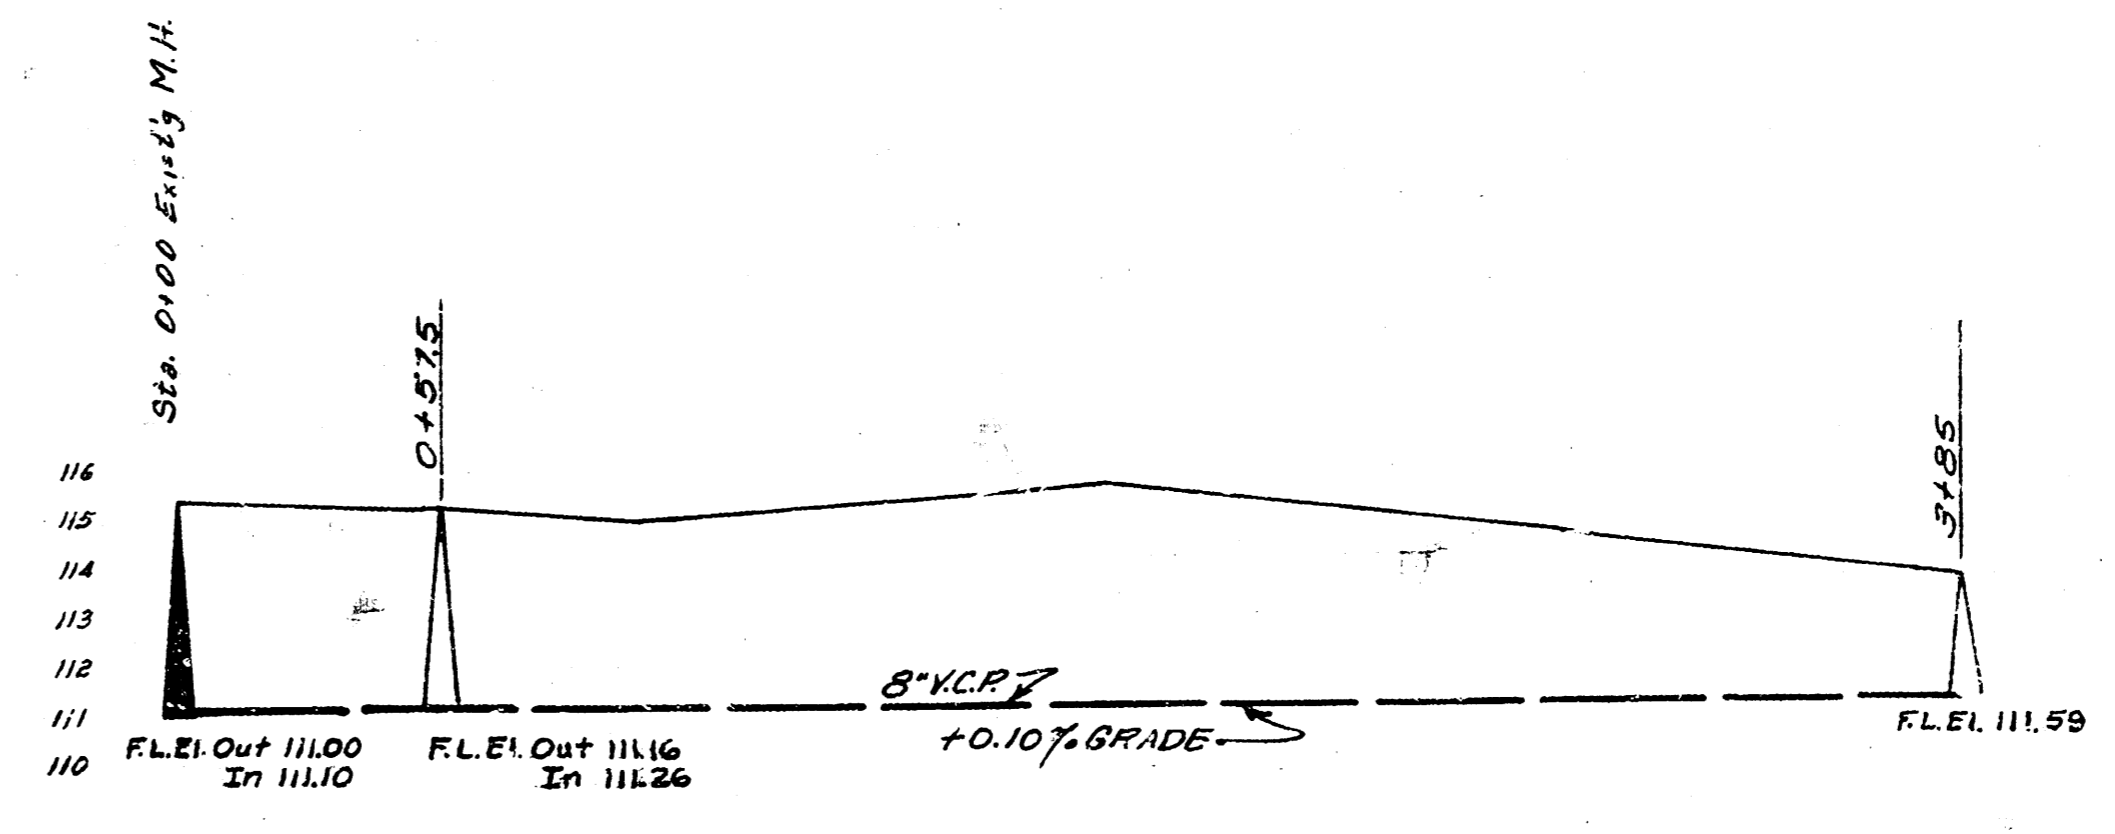

Scale:  
 Vertical - 1"=4'  
 Horizontal - 1"=40'

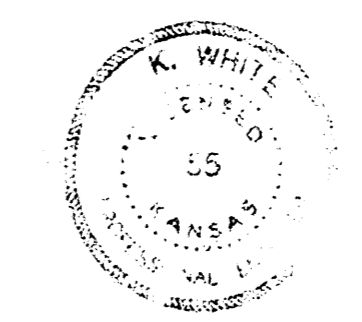

LATERAL Q, S.S.#8  
 City of Wichita, Kansas  
 L.K. White, City Engineer  
 March 1951, Private Contract

0+00 1+00 2+00 3+00 4+00