

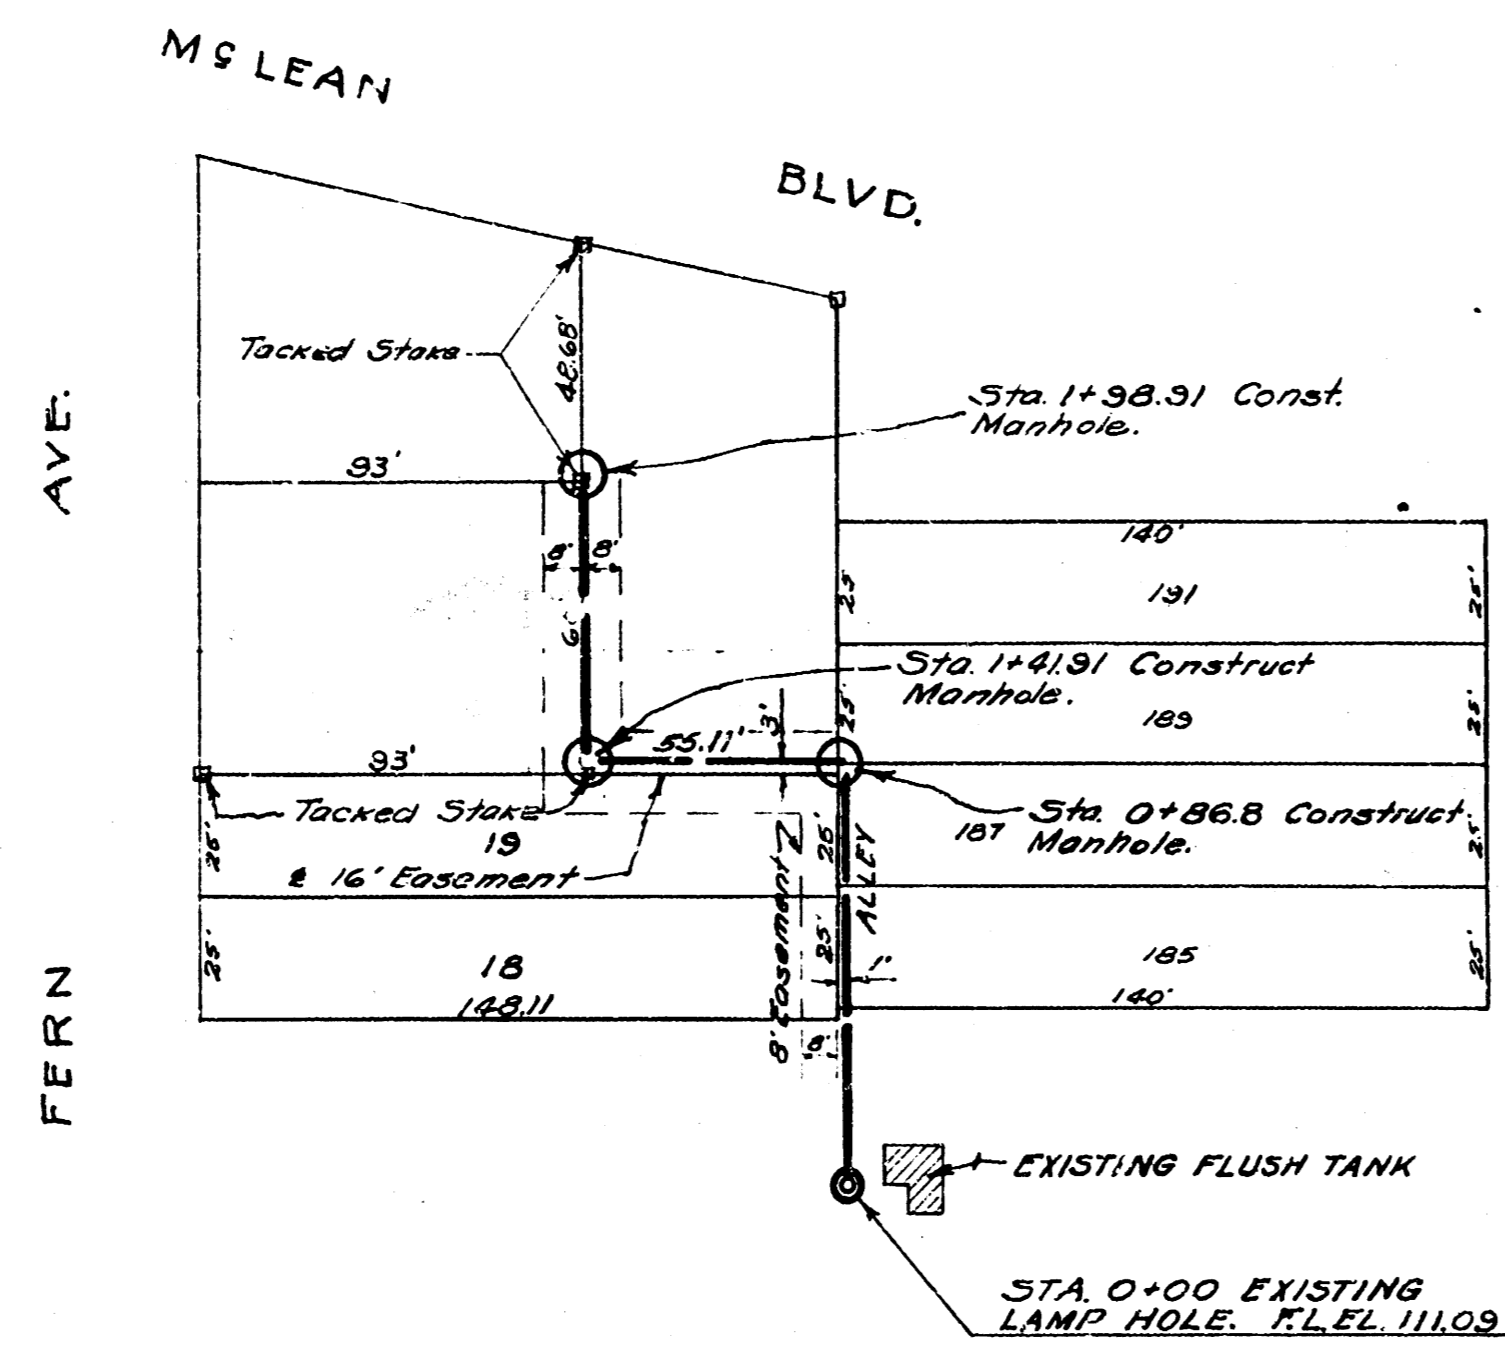


NOTE: Reference Property Line Stakes Prior to Construction.

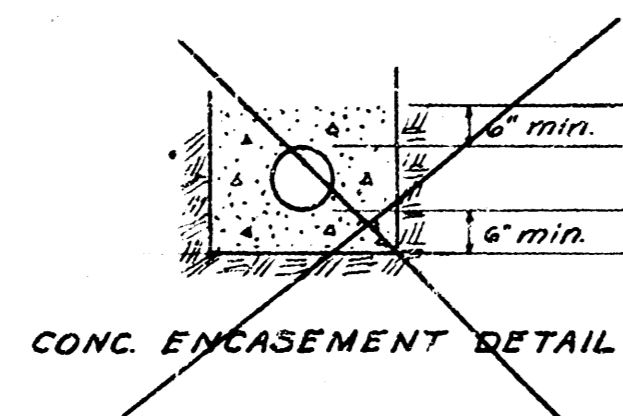


B.M. W. Rim of Manhole N.W. Corner Vine & St. Louis E.I. 11537


NOTE BOOK NO. 112  
Scale: 1"=40' Horiz.  
1"=8' Vert.

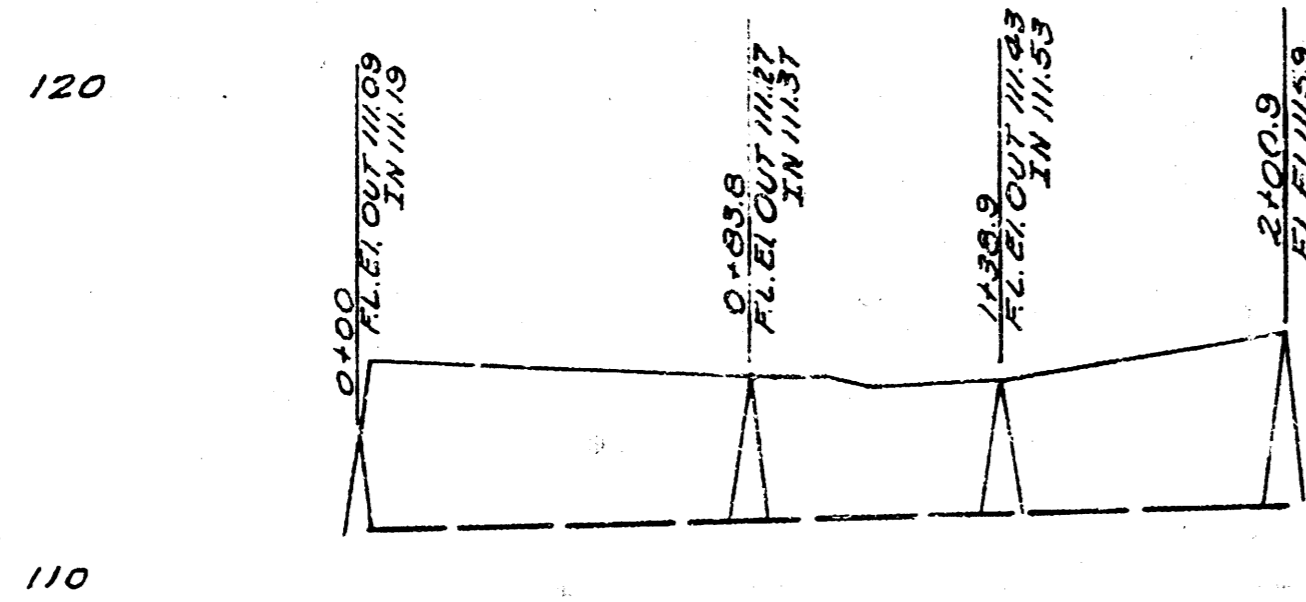

LAT. P. DIST. SS. MAIN 8  
CITY OF WICHITA KANSAS  
L.K. WHITE CITY ENGINEER  
Proj. No. C21-33

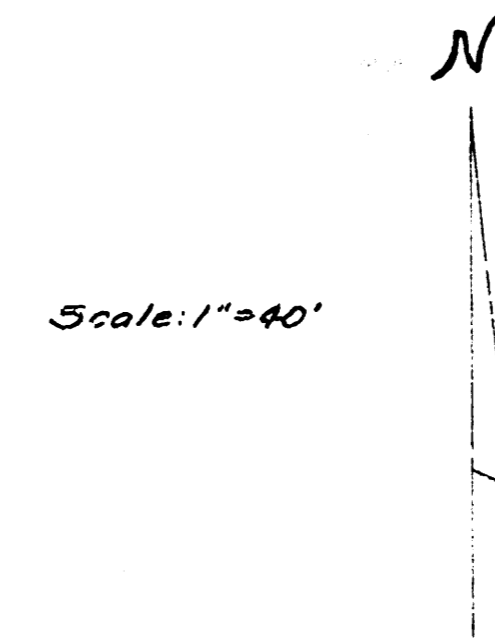


Sand backfill trench Sta. 1+06.5 to Sta. 1+42.5

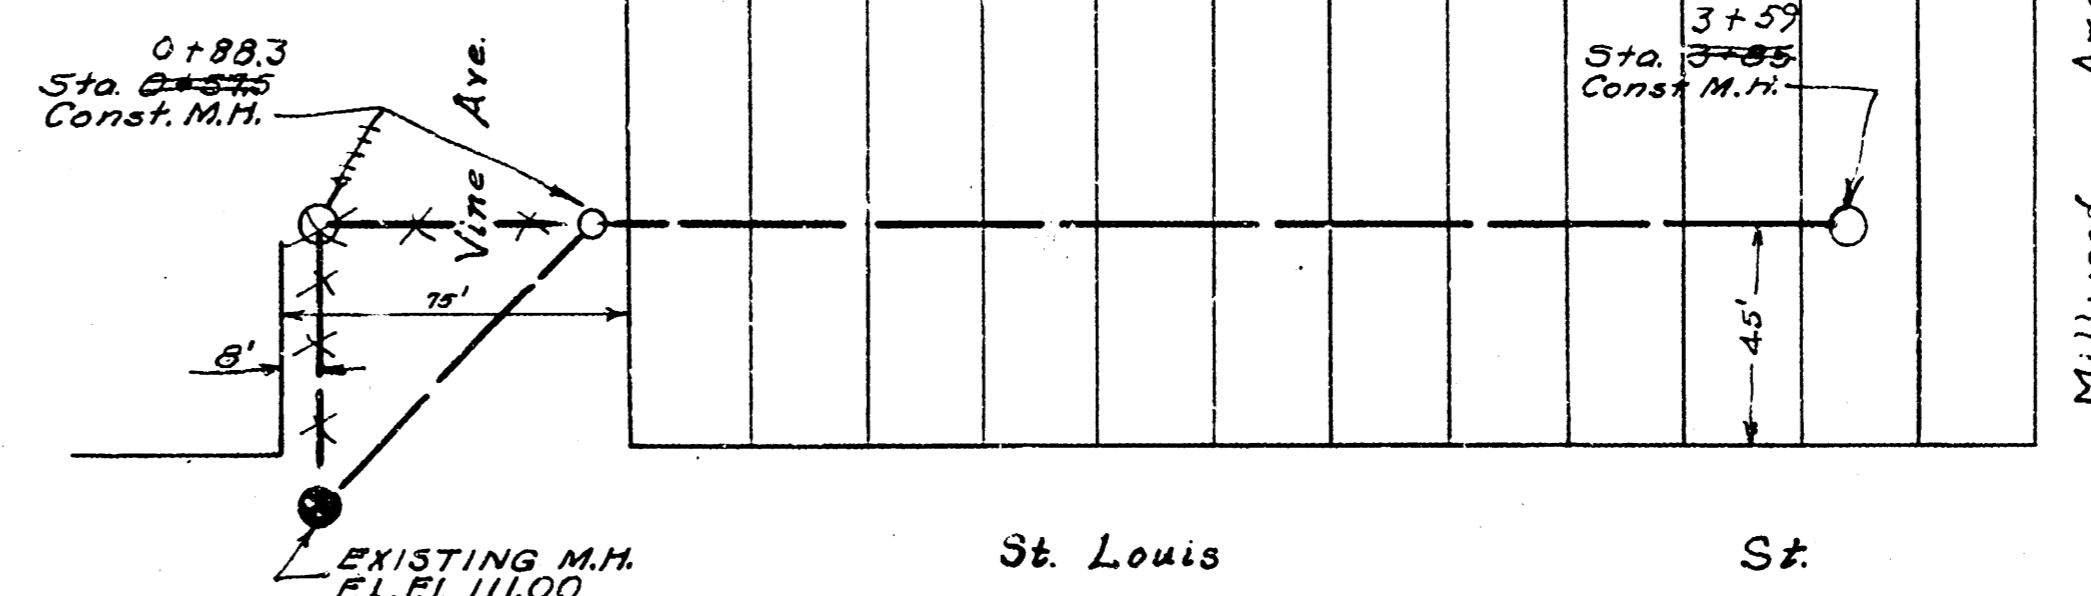

Scale: 1"=40'  
Book H-3

B.M. 115.37 W. Rim of M.H. @ Sta. 0+00

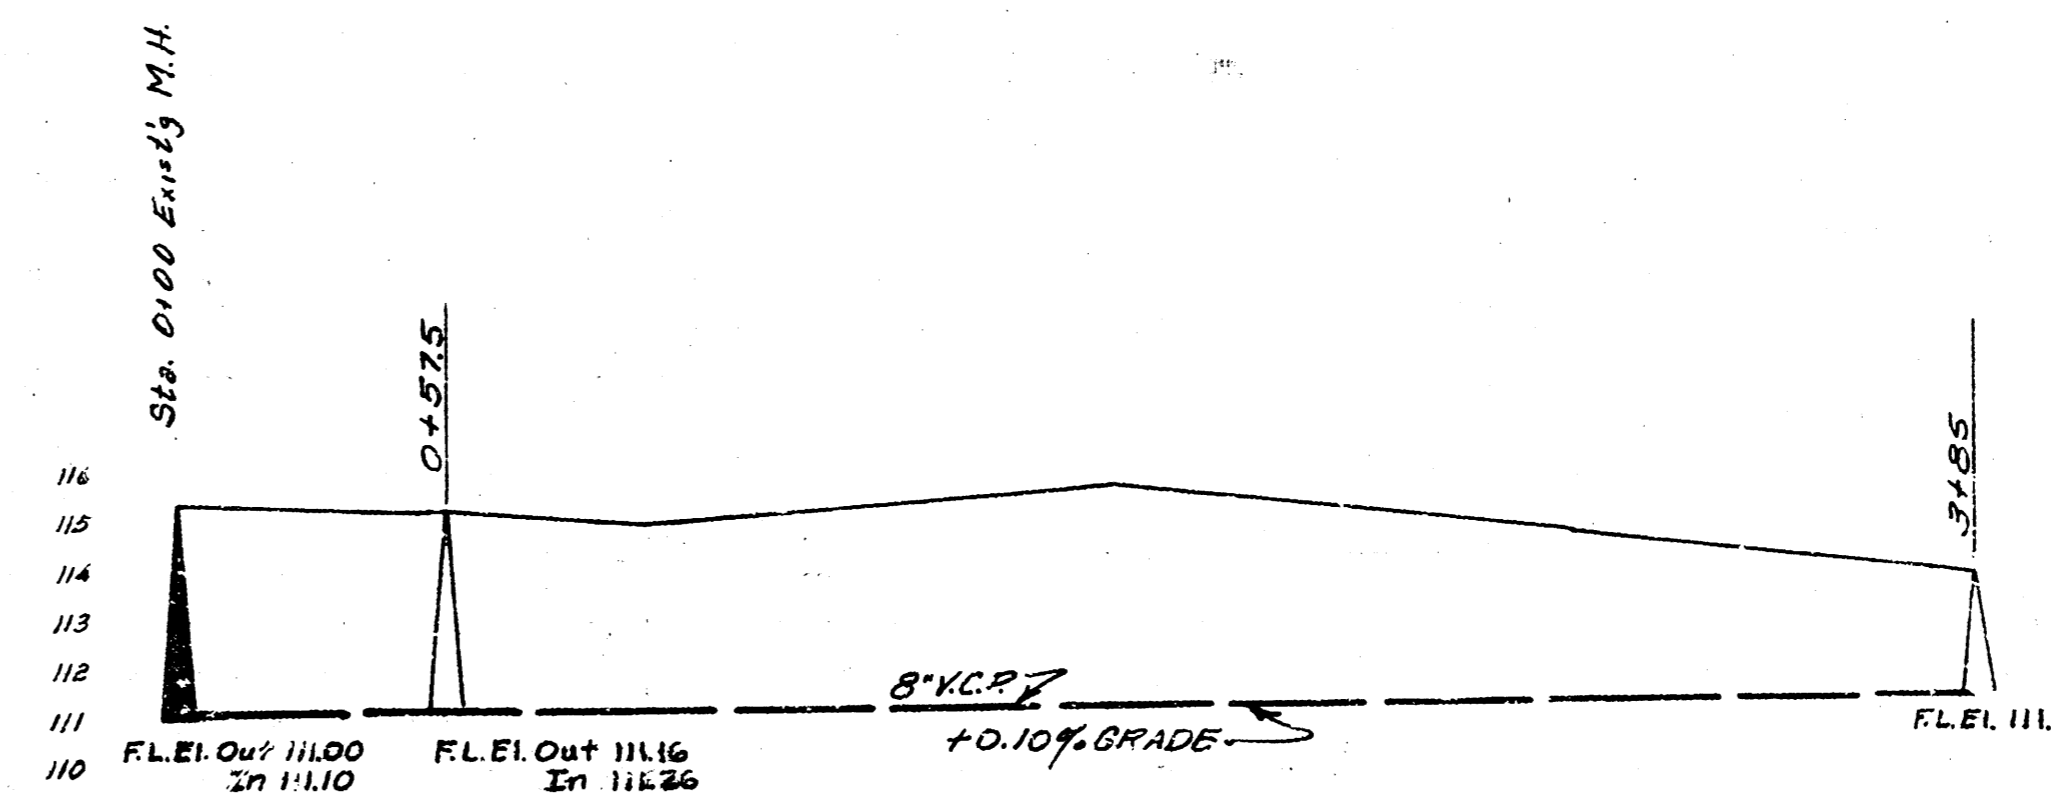

Scale:  
Vertical - 1"=4'  
Horizontal - 1"=40'

Date June 1951  
Drawn by J.L.A.  
Checked by Nick Brown, M. H. B. & H. S.



LATERAL 0, SS.#8  
City of Wichita, Kansas  
L.K. White City Engineer  
March 1951 Private Contract

0+00 1+00 2+00 3+00 4+00