



SANTA FE ORIENT INDUSTRIAL DISTRICT
3rd. ADDITION

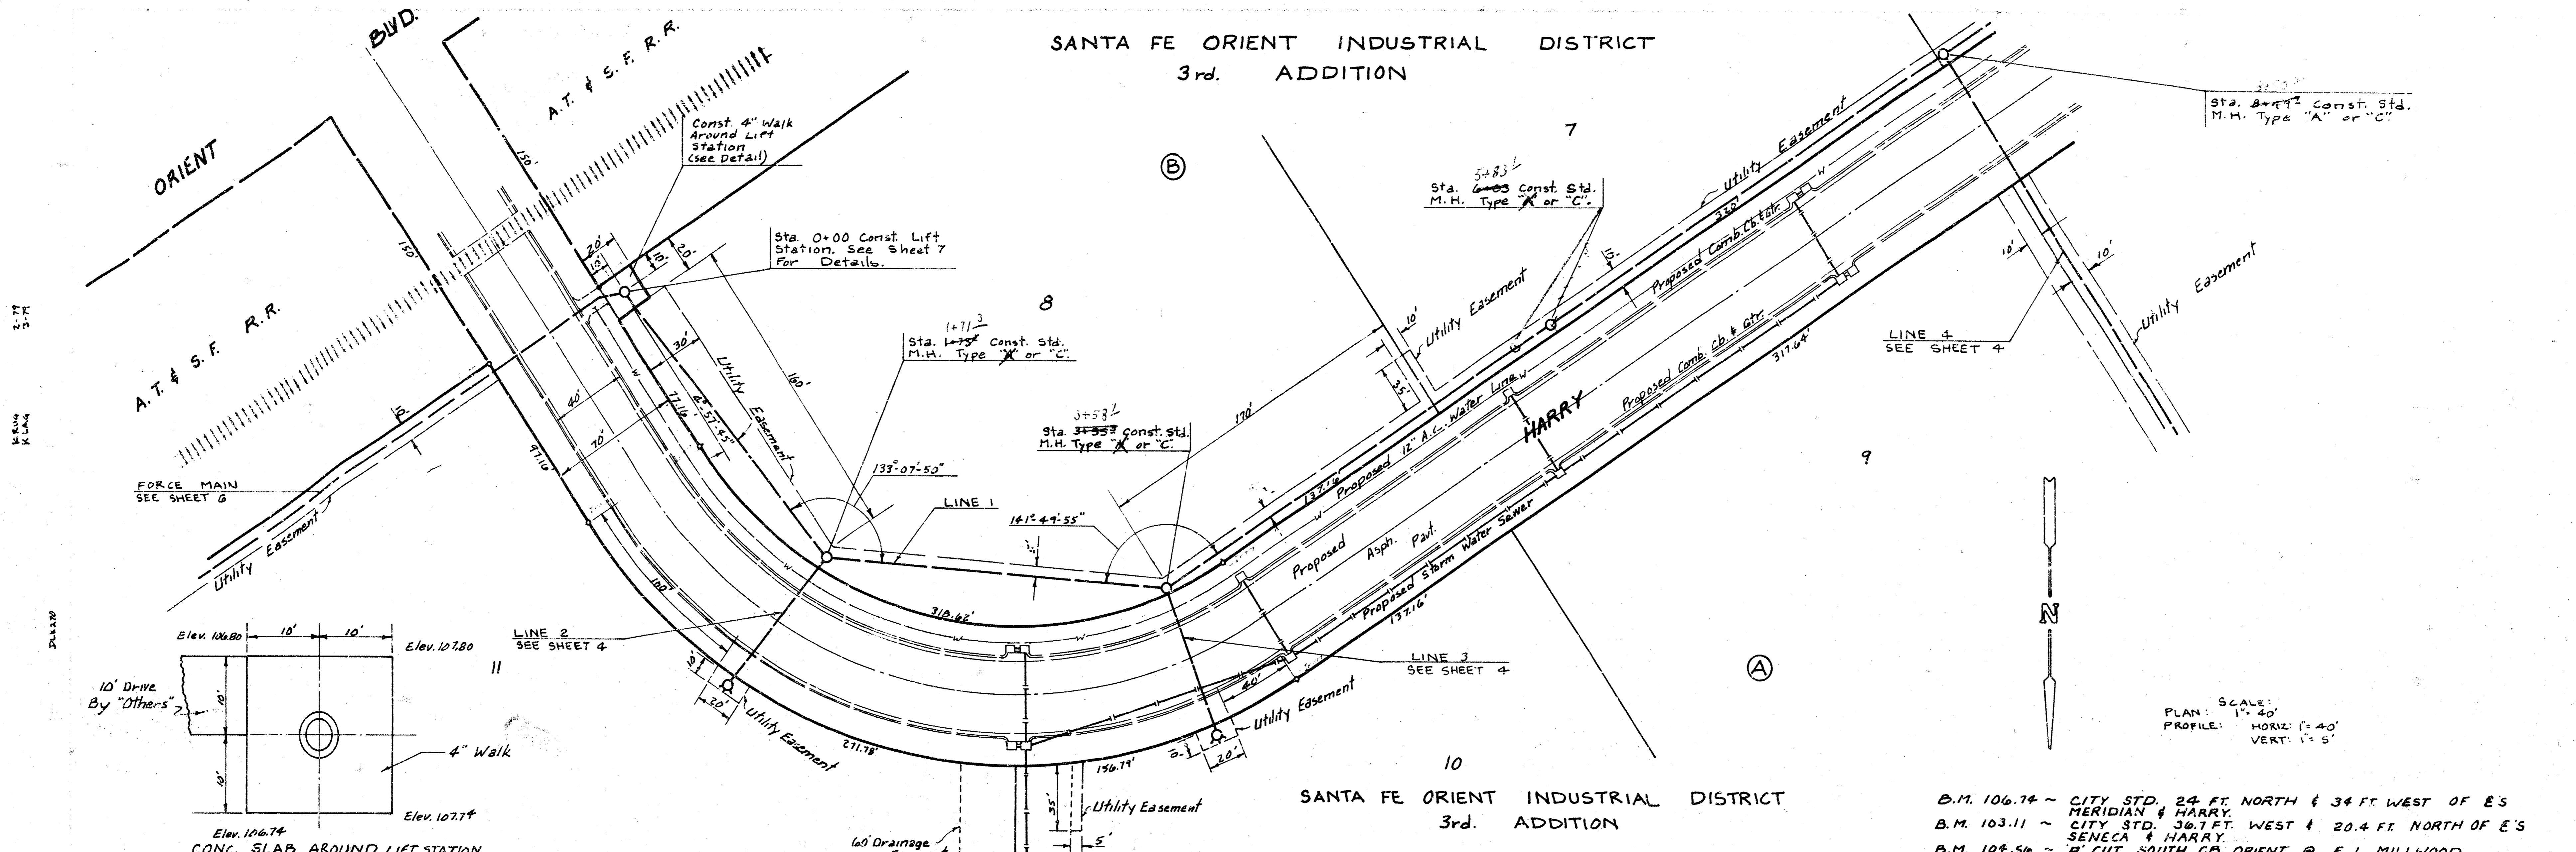


PLAN: SCALE: 1" = 40'
 PROFILE: HORIZ: 1" = 40'
 VERT: 1" = 5'

B.M. 106.74 ~ CITY STD. 24 FT. NORTH & 34 FT. WEST OF E'S MERIDIAN & HARRY.
 B.M. 103.11 ~ CITY STD. 30.7 FT. WEST & 20.4 FT. NORTH OF E'S SENECA & HARRY.
 B.M. 104.50 ~ 'D' CUT SOUTH CB. ORIENT @ E.L. MILLWOOD.

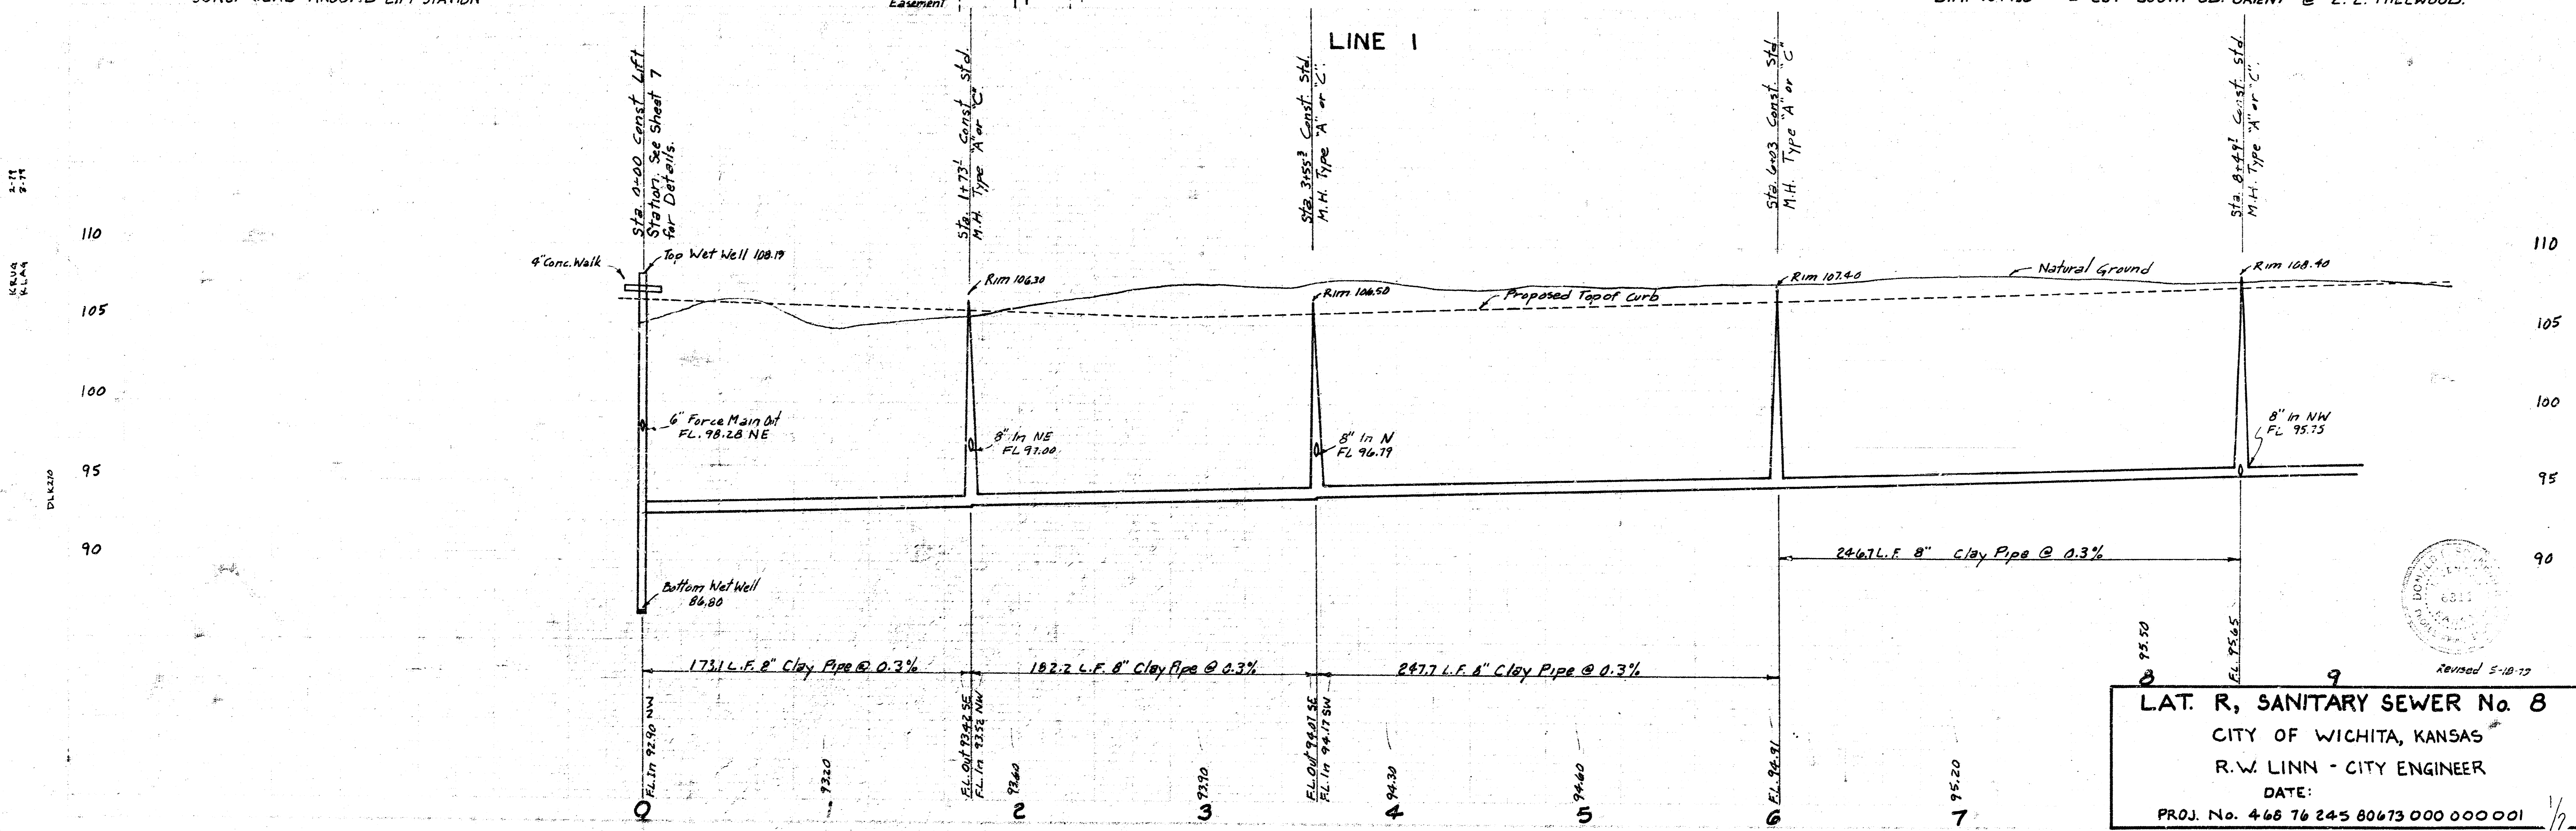


Revised 5-10-75

L.A.T. R, SANITARY SEWER No. 8
 CITY OF WICHITA, KANSAS
 R.W. LINN - CITY ENGINEER
 DATE:
 PROJ. No. 468 76 245 80673 000 000 001

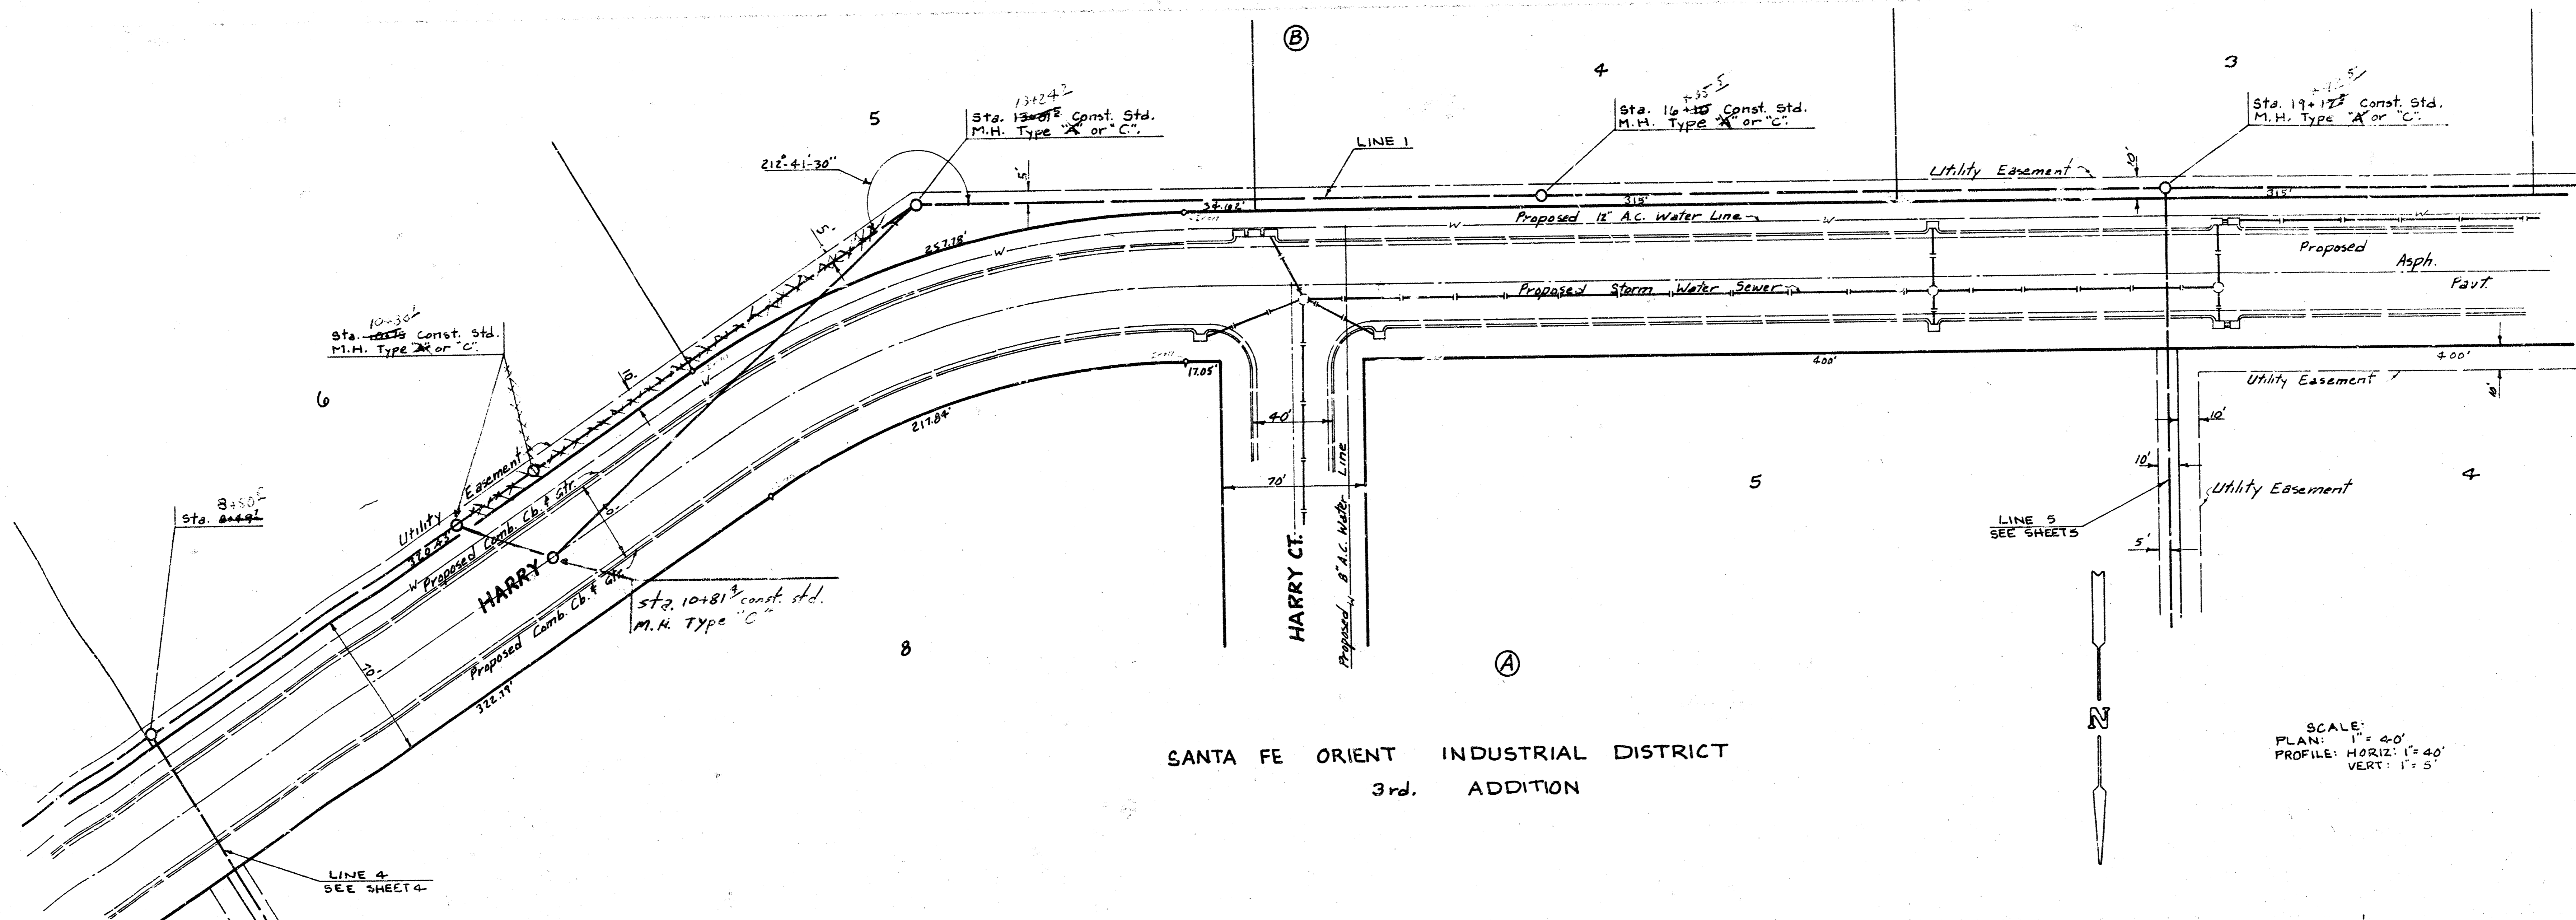



SANTA FE ORIENT INDUSTRIAL DISTRICT
3rd. ADDITION

SCALE:
PROFILE: HORIZ. 1" = 40'
VERT. 1" = 5'

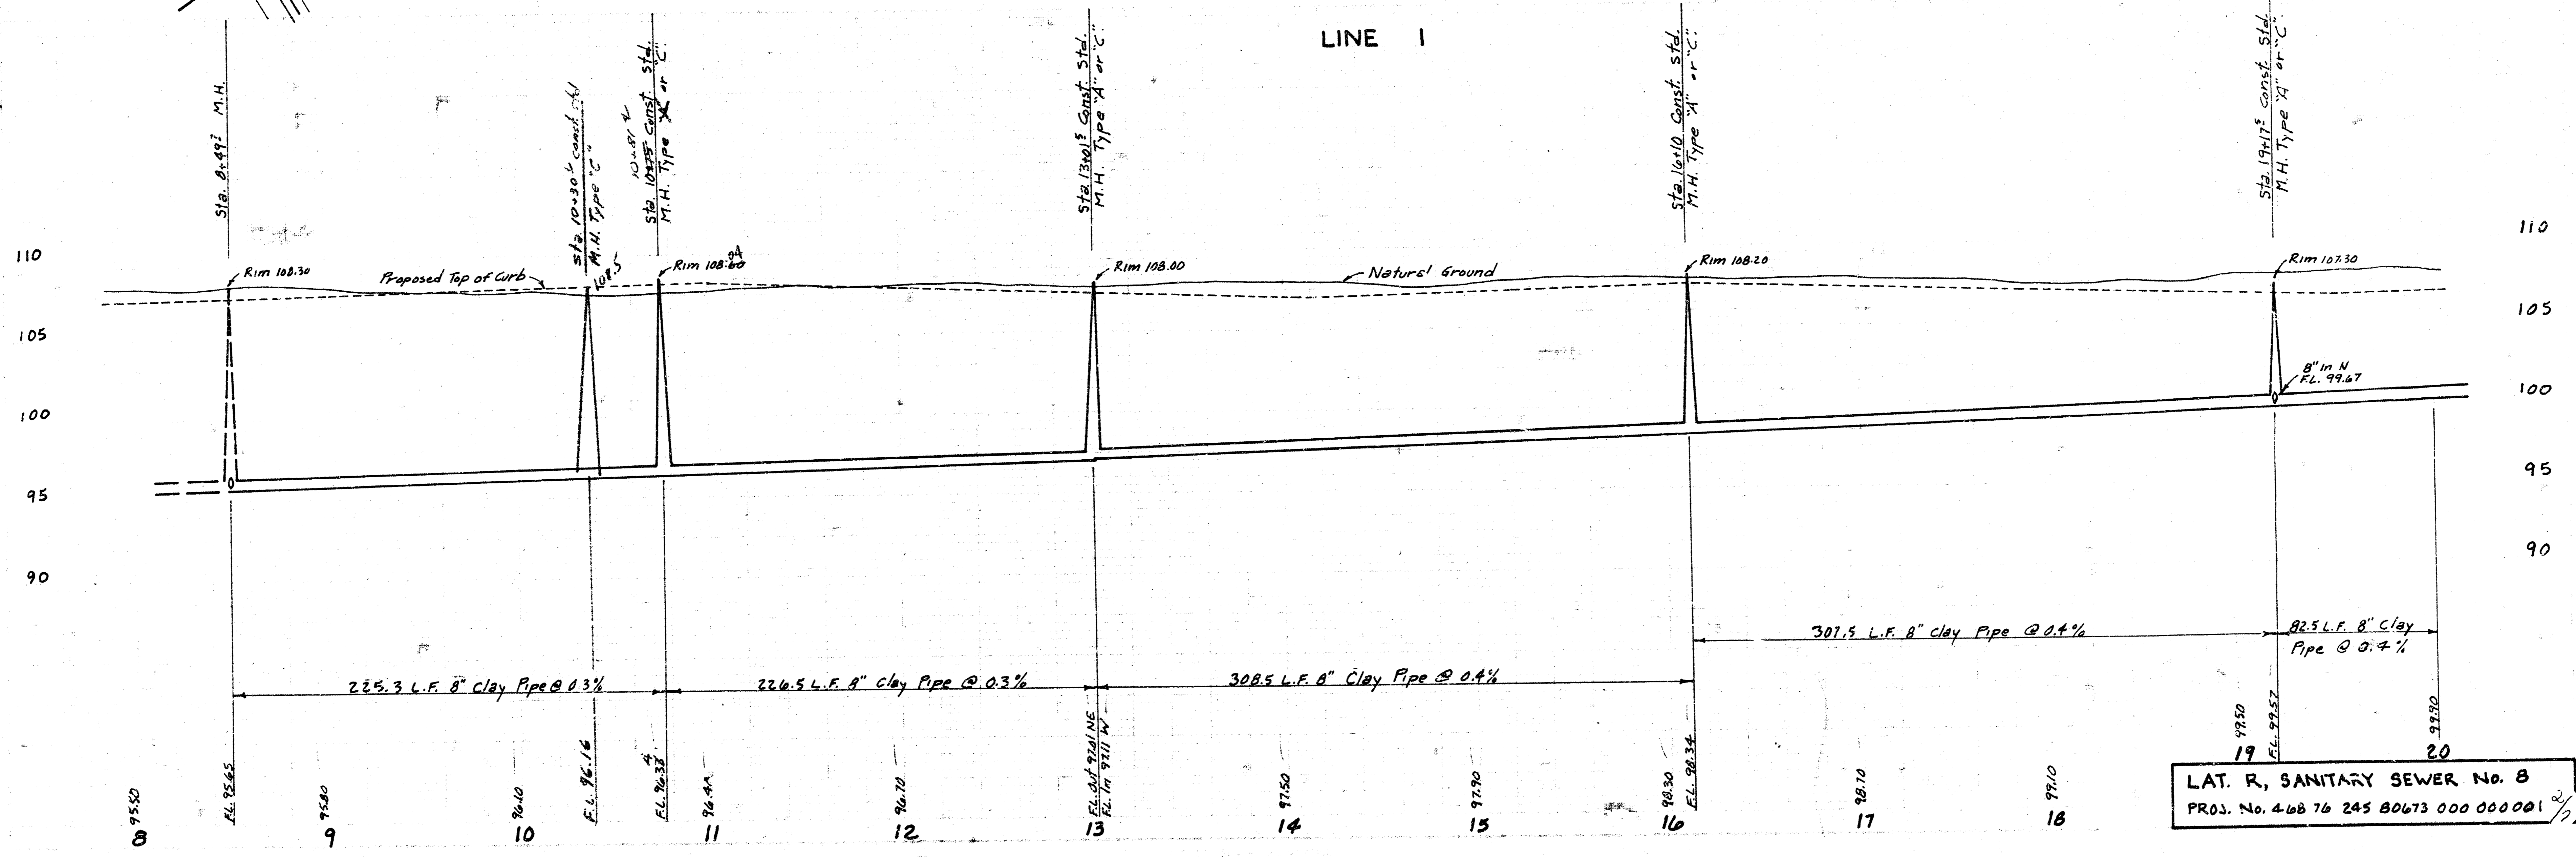


LAT. R. SANITARY SEWER No. 8
PROJ. No. 4-68 76 245 B0673 000 000001

SANTA FE ORIENT INDUSTRIAL DISTRICT
3rd ADDITION

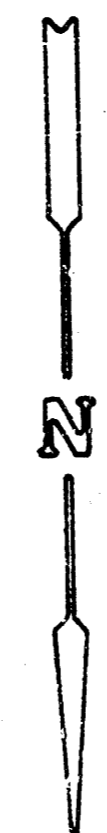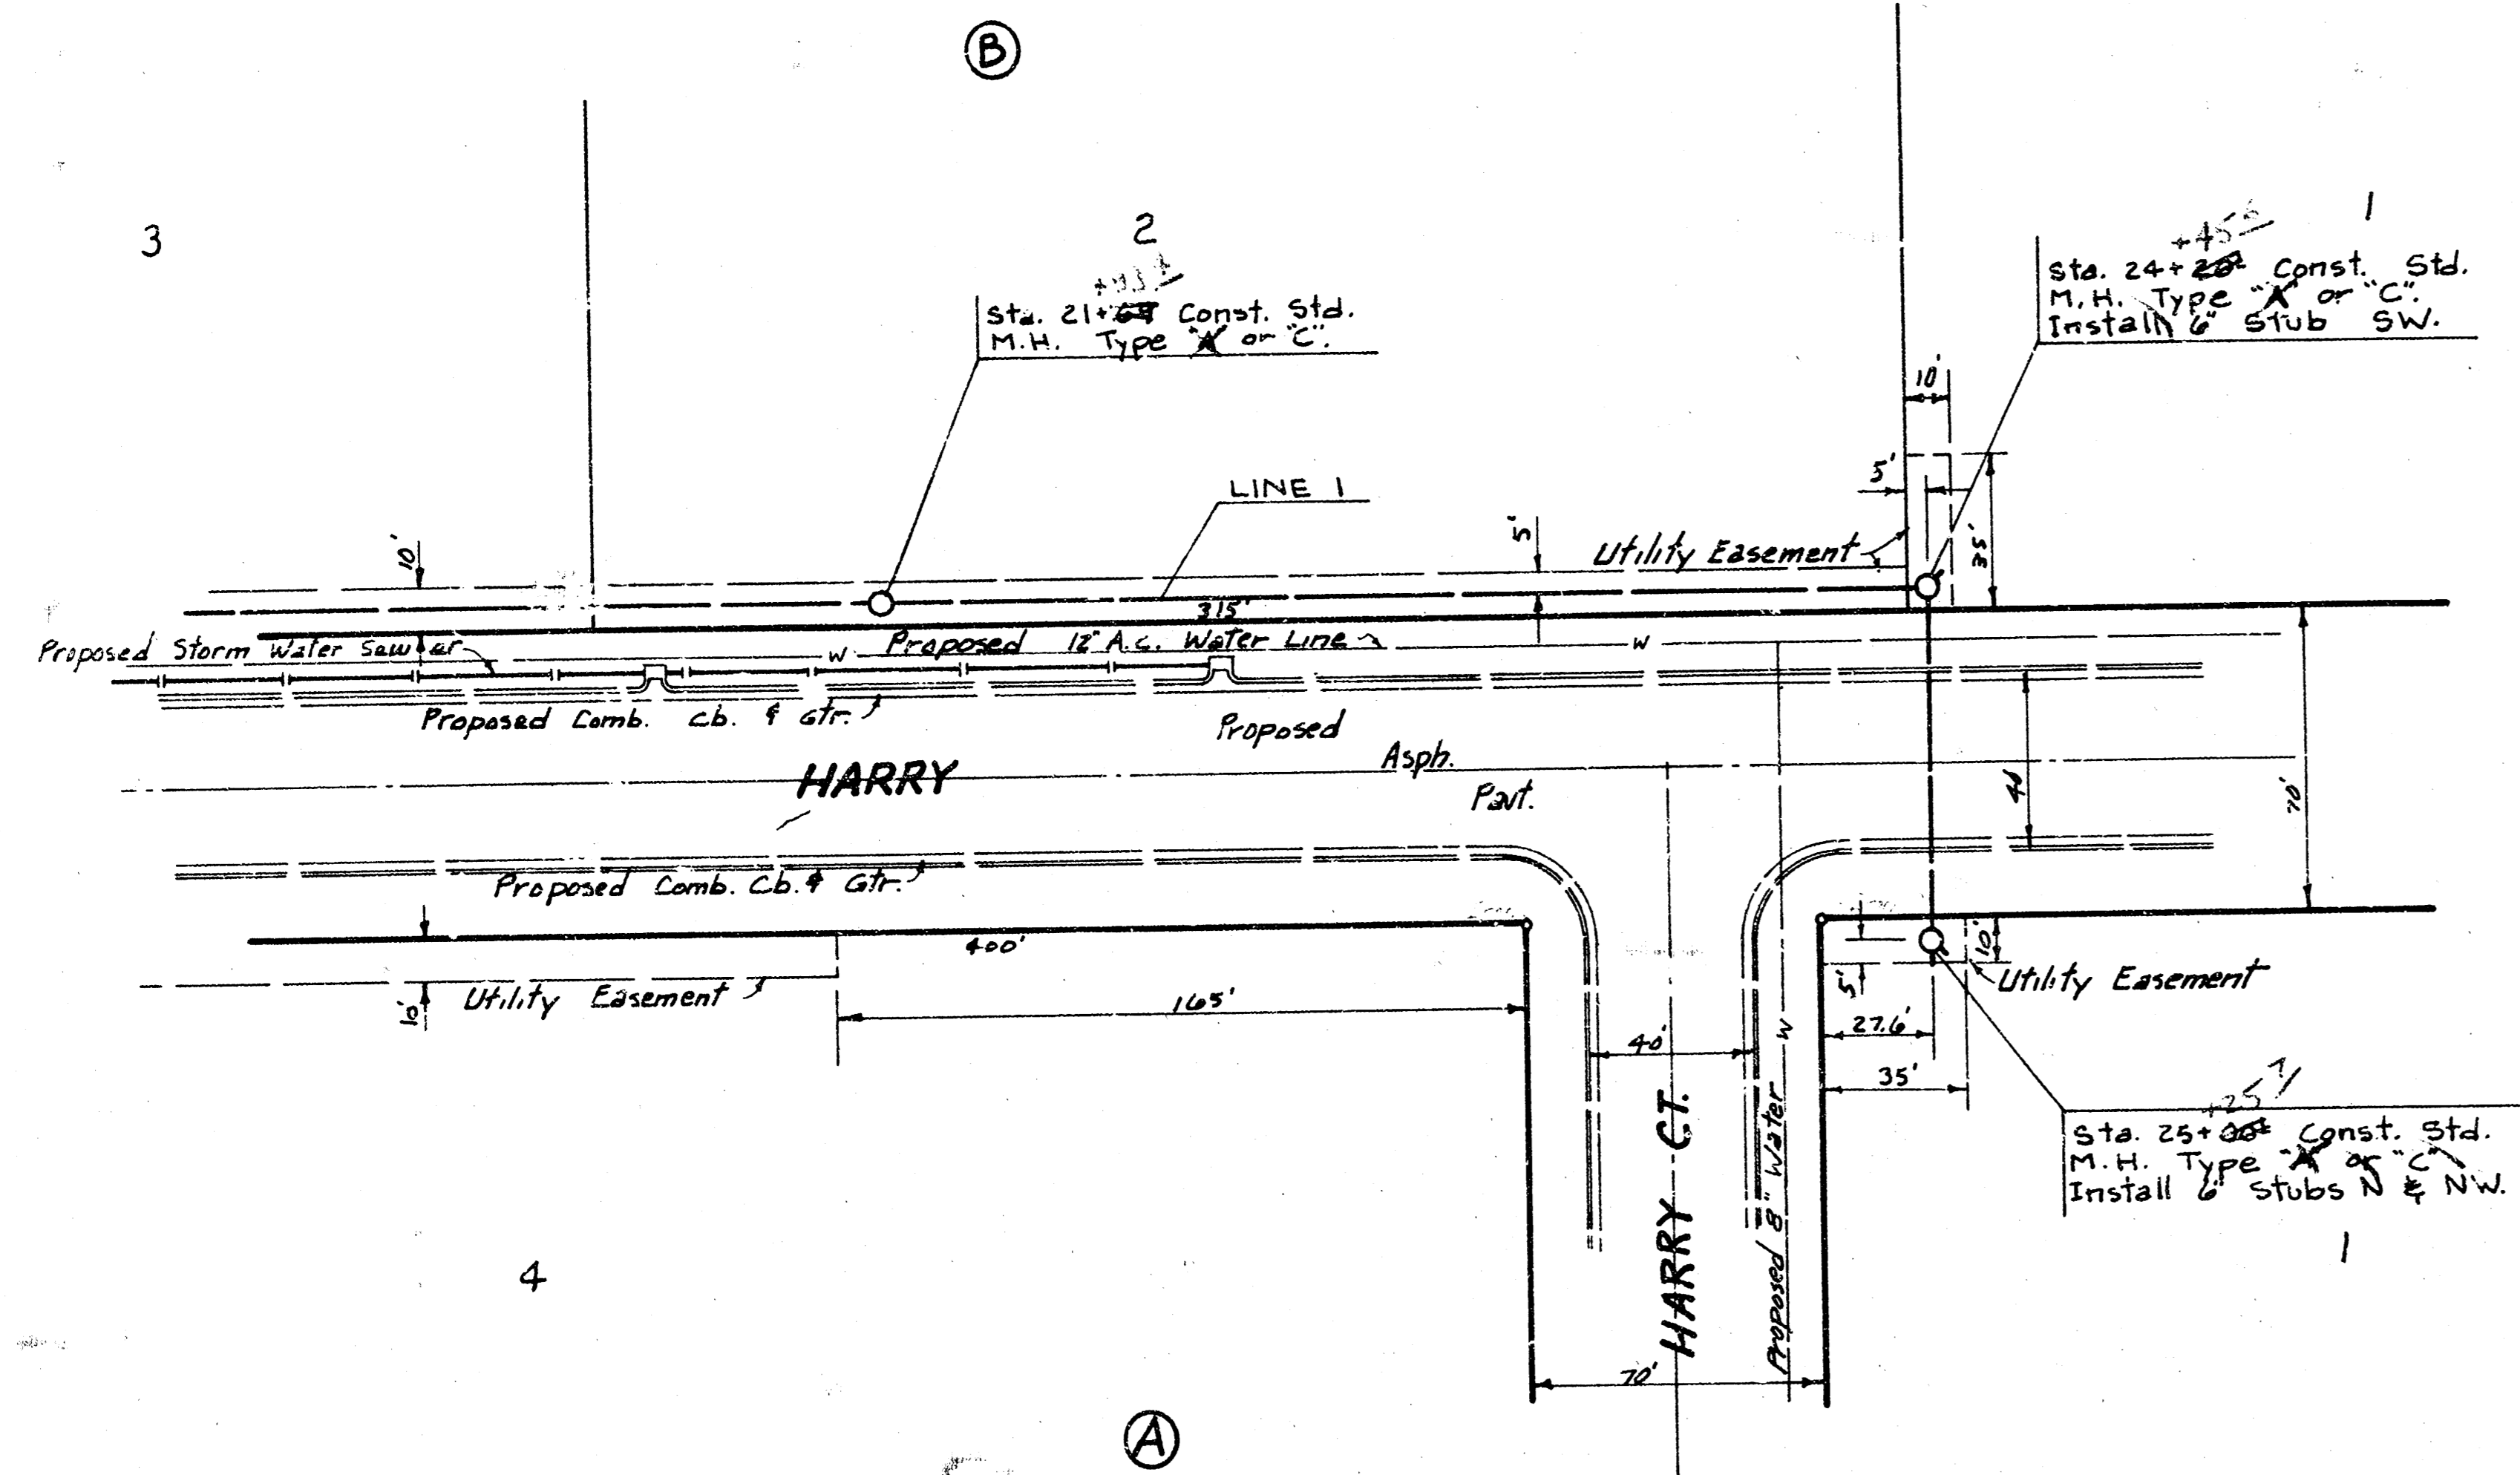


SCALE:
PLANS: 1" = 40'
PROFILE: HORIZ: 1" = 40'
VERT: 1" = 5'

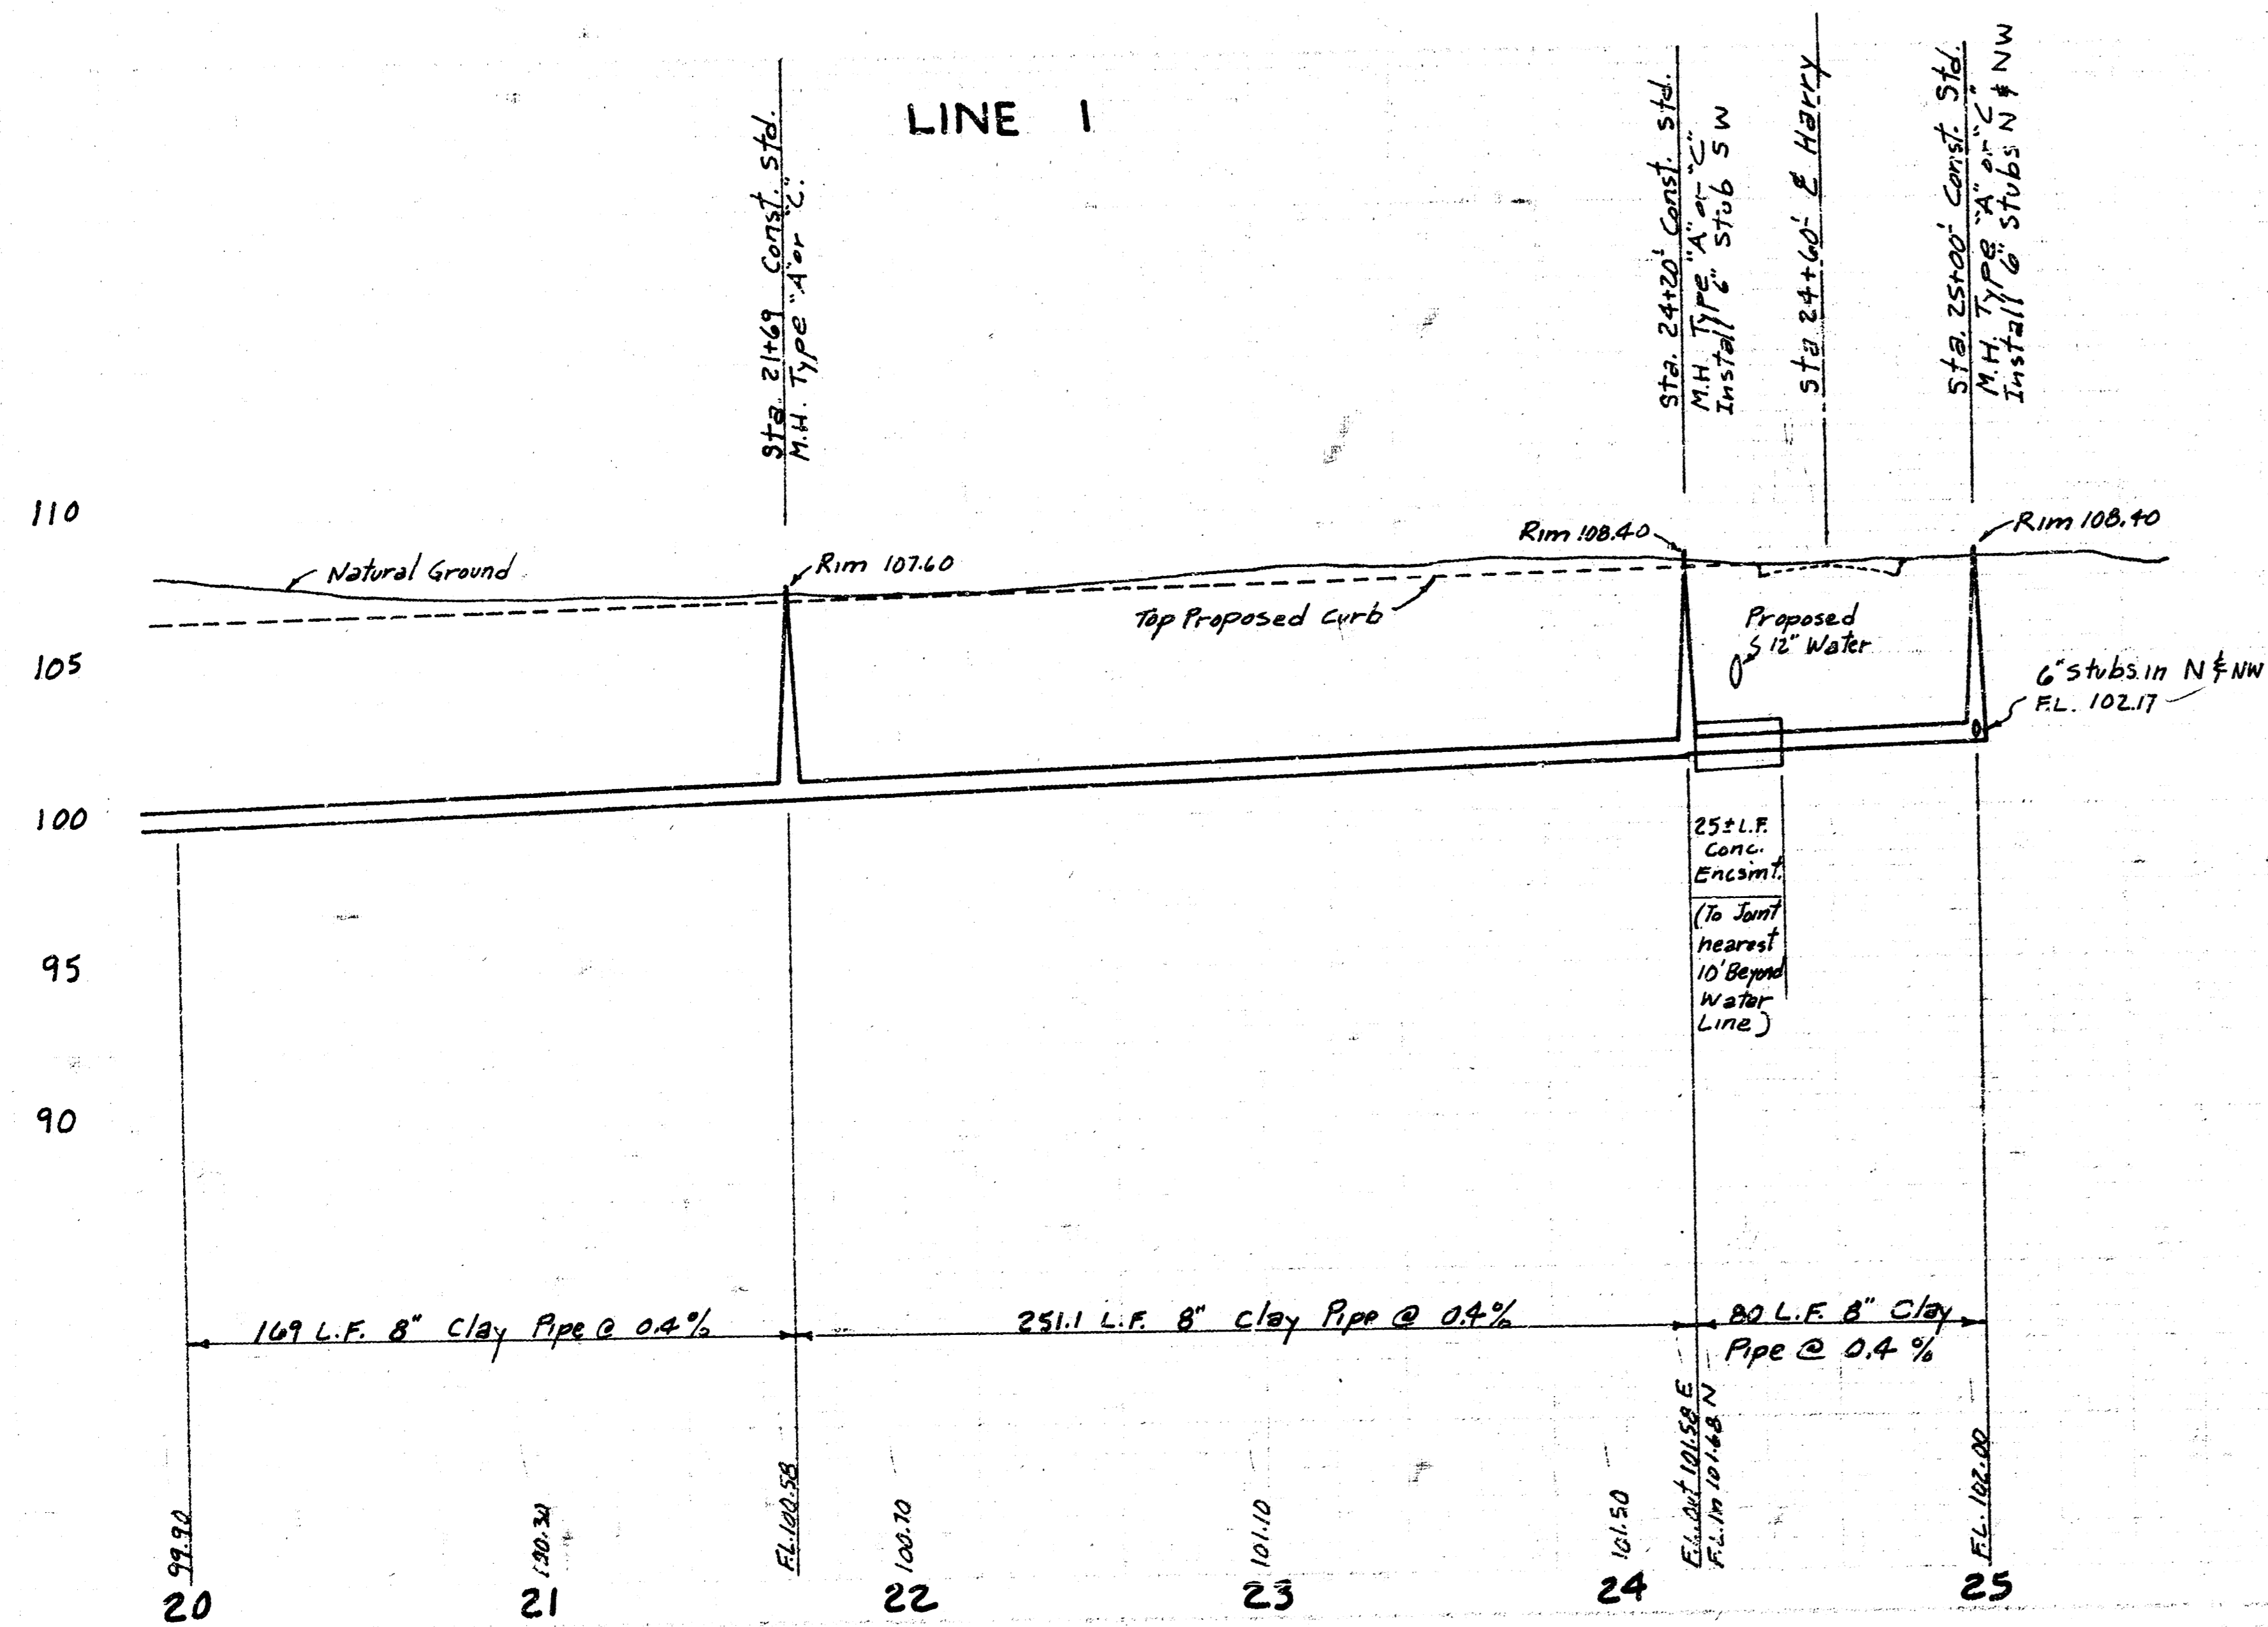


LAT. R, SANITARY SEWER No. 8
PROJ. No 468 76 245 80673 000 000 001 3/1

SANTA FE ORIENT INDUSTRIAL DISTRICT 3rd ADDITION


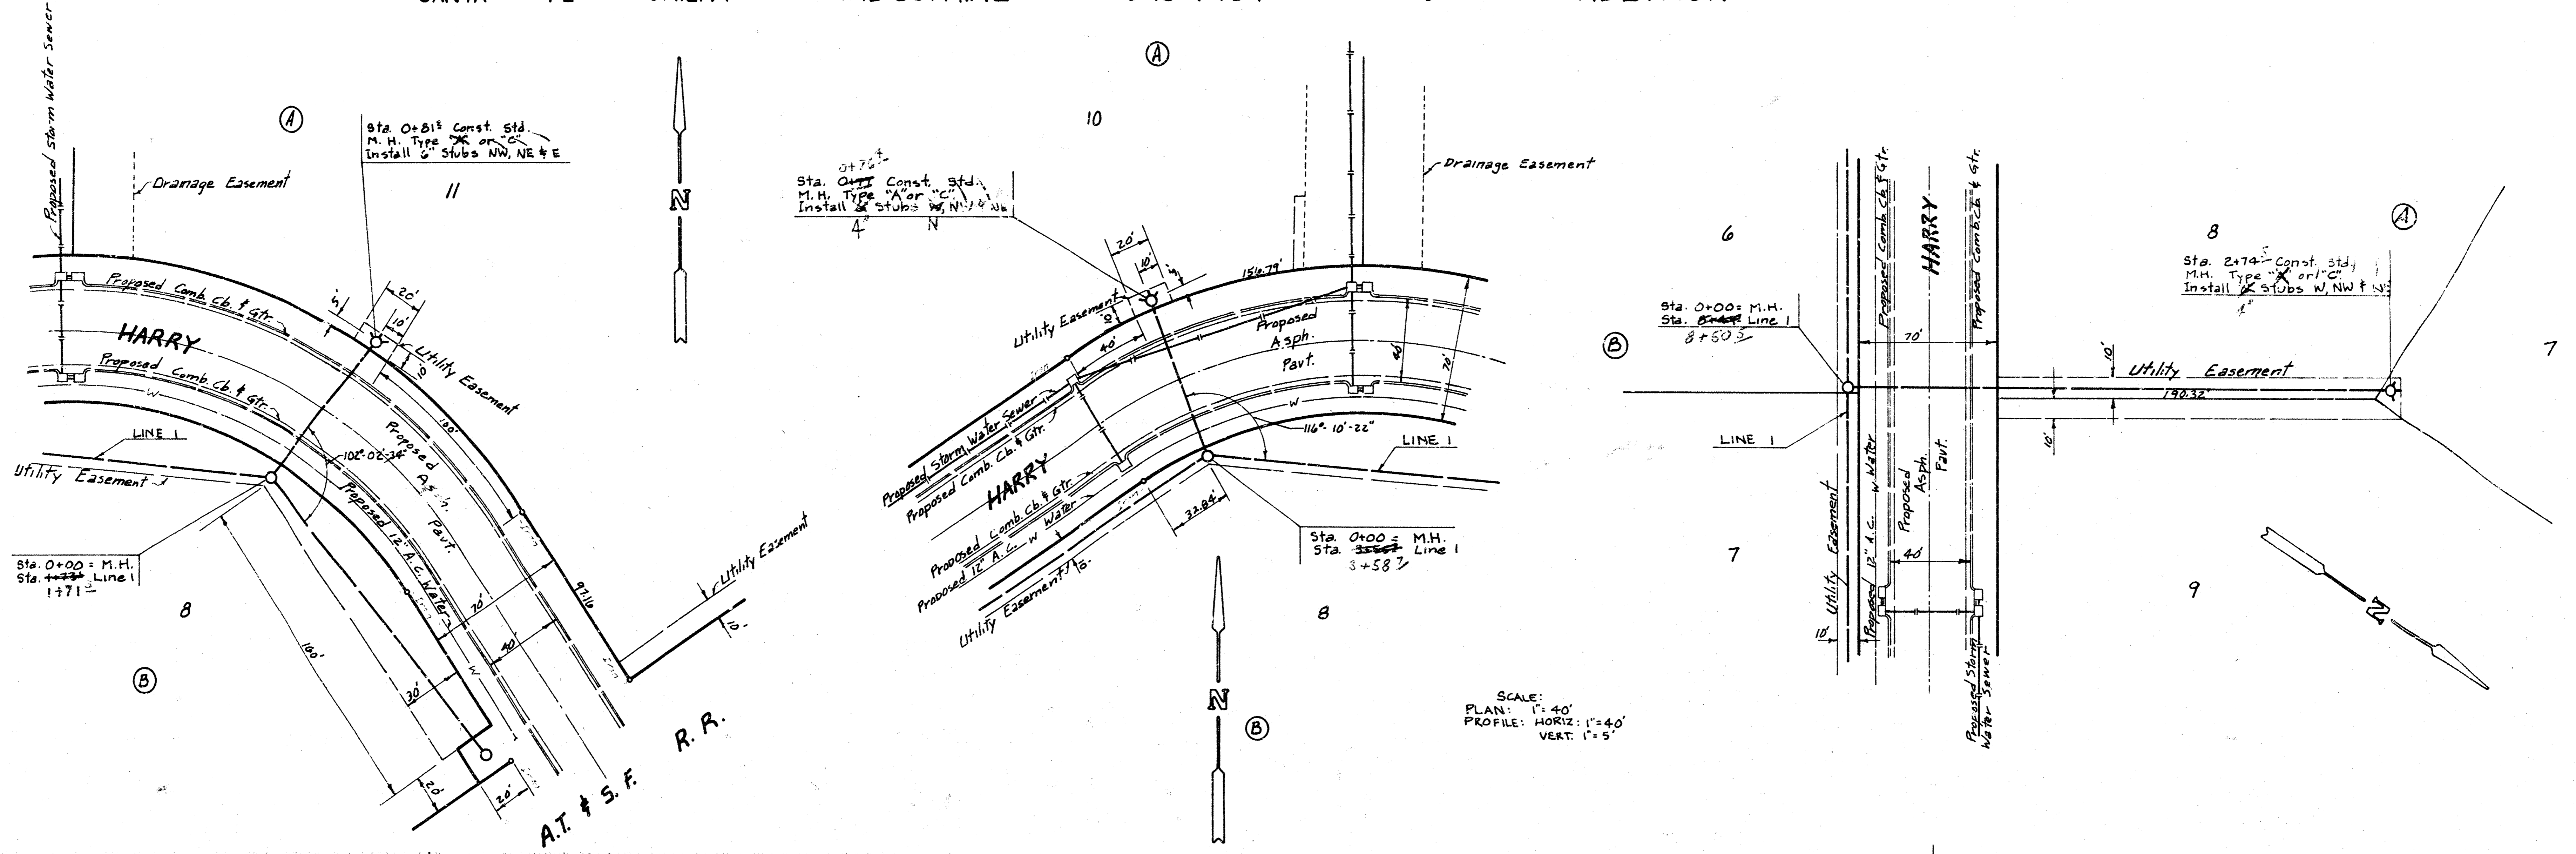


SCALE:
PLAN: 1"=40'
PROFILE: HORIZ: 1"=40'
VERT: 1"=5'


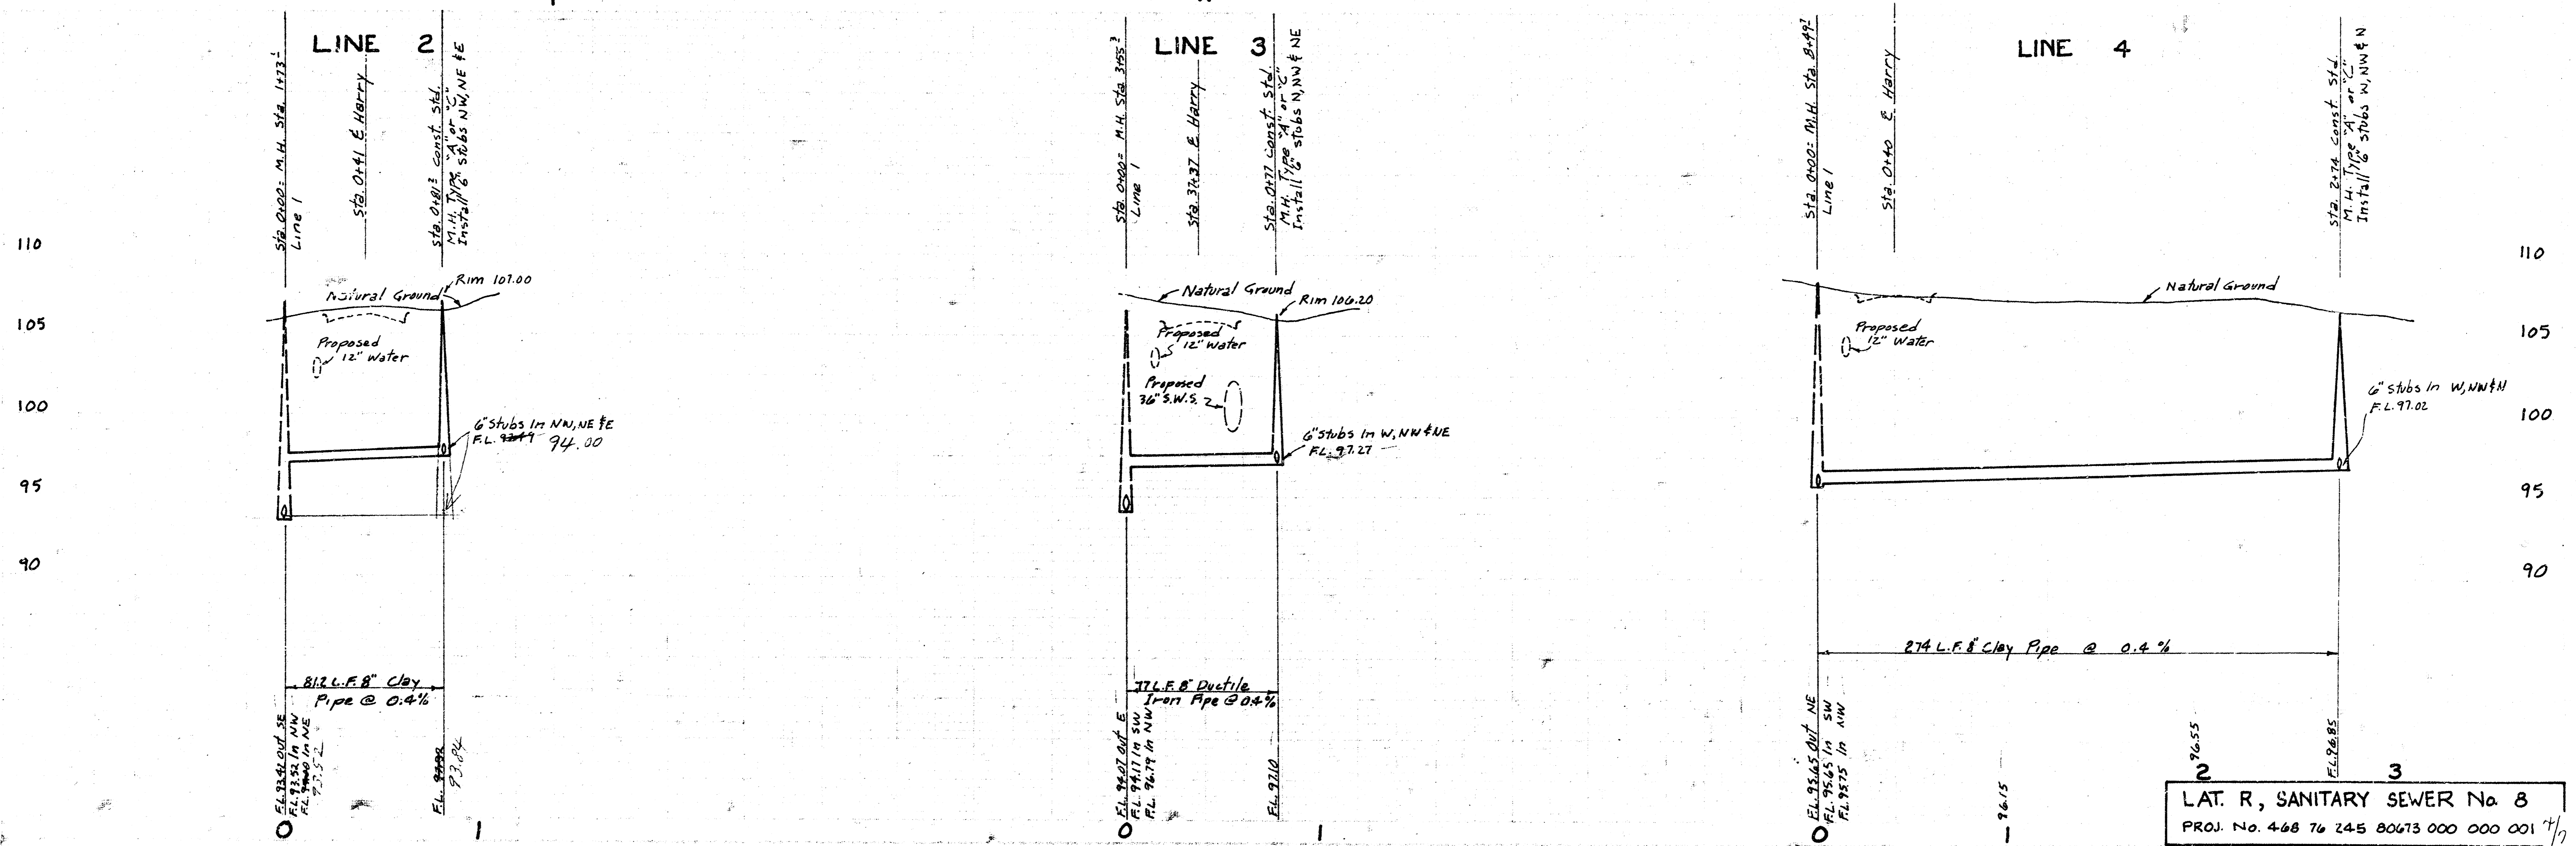


LAT. R, SANITARY SEWER No 8
PROJ. No. 468 76 245 80673 000 000 001 4/7

SANTA FE ORIENT INDUSTRIAL DISTRICT 3rd ADDITION

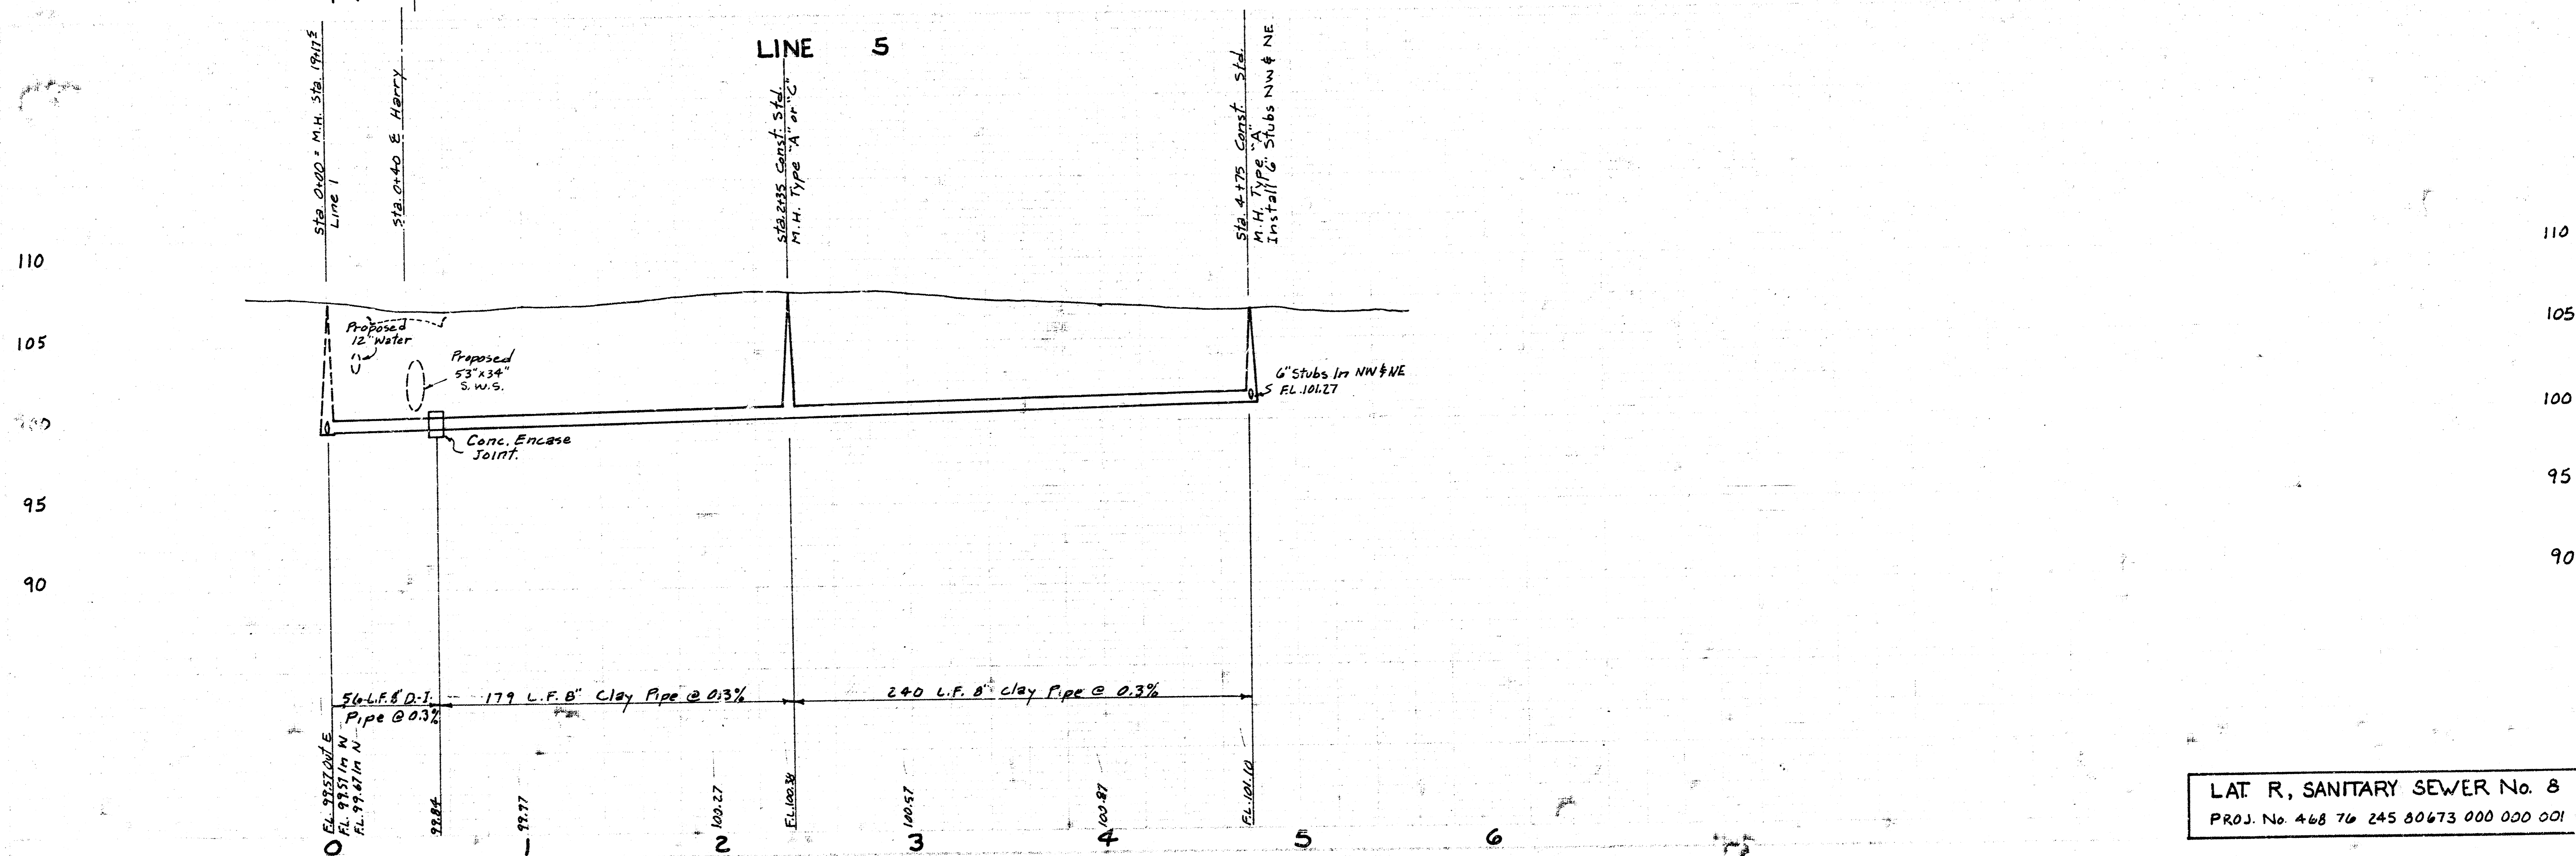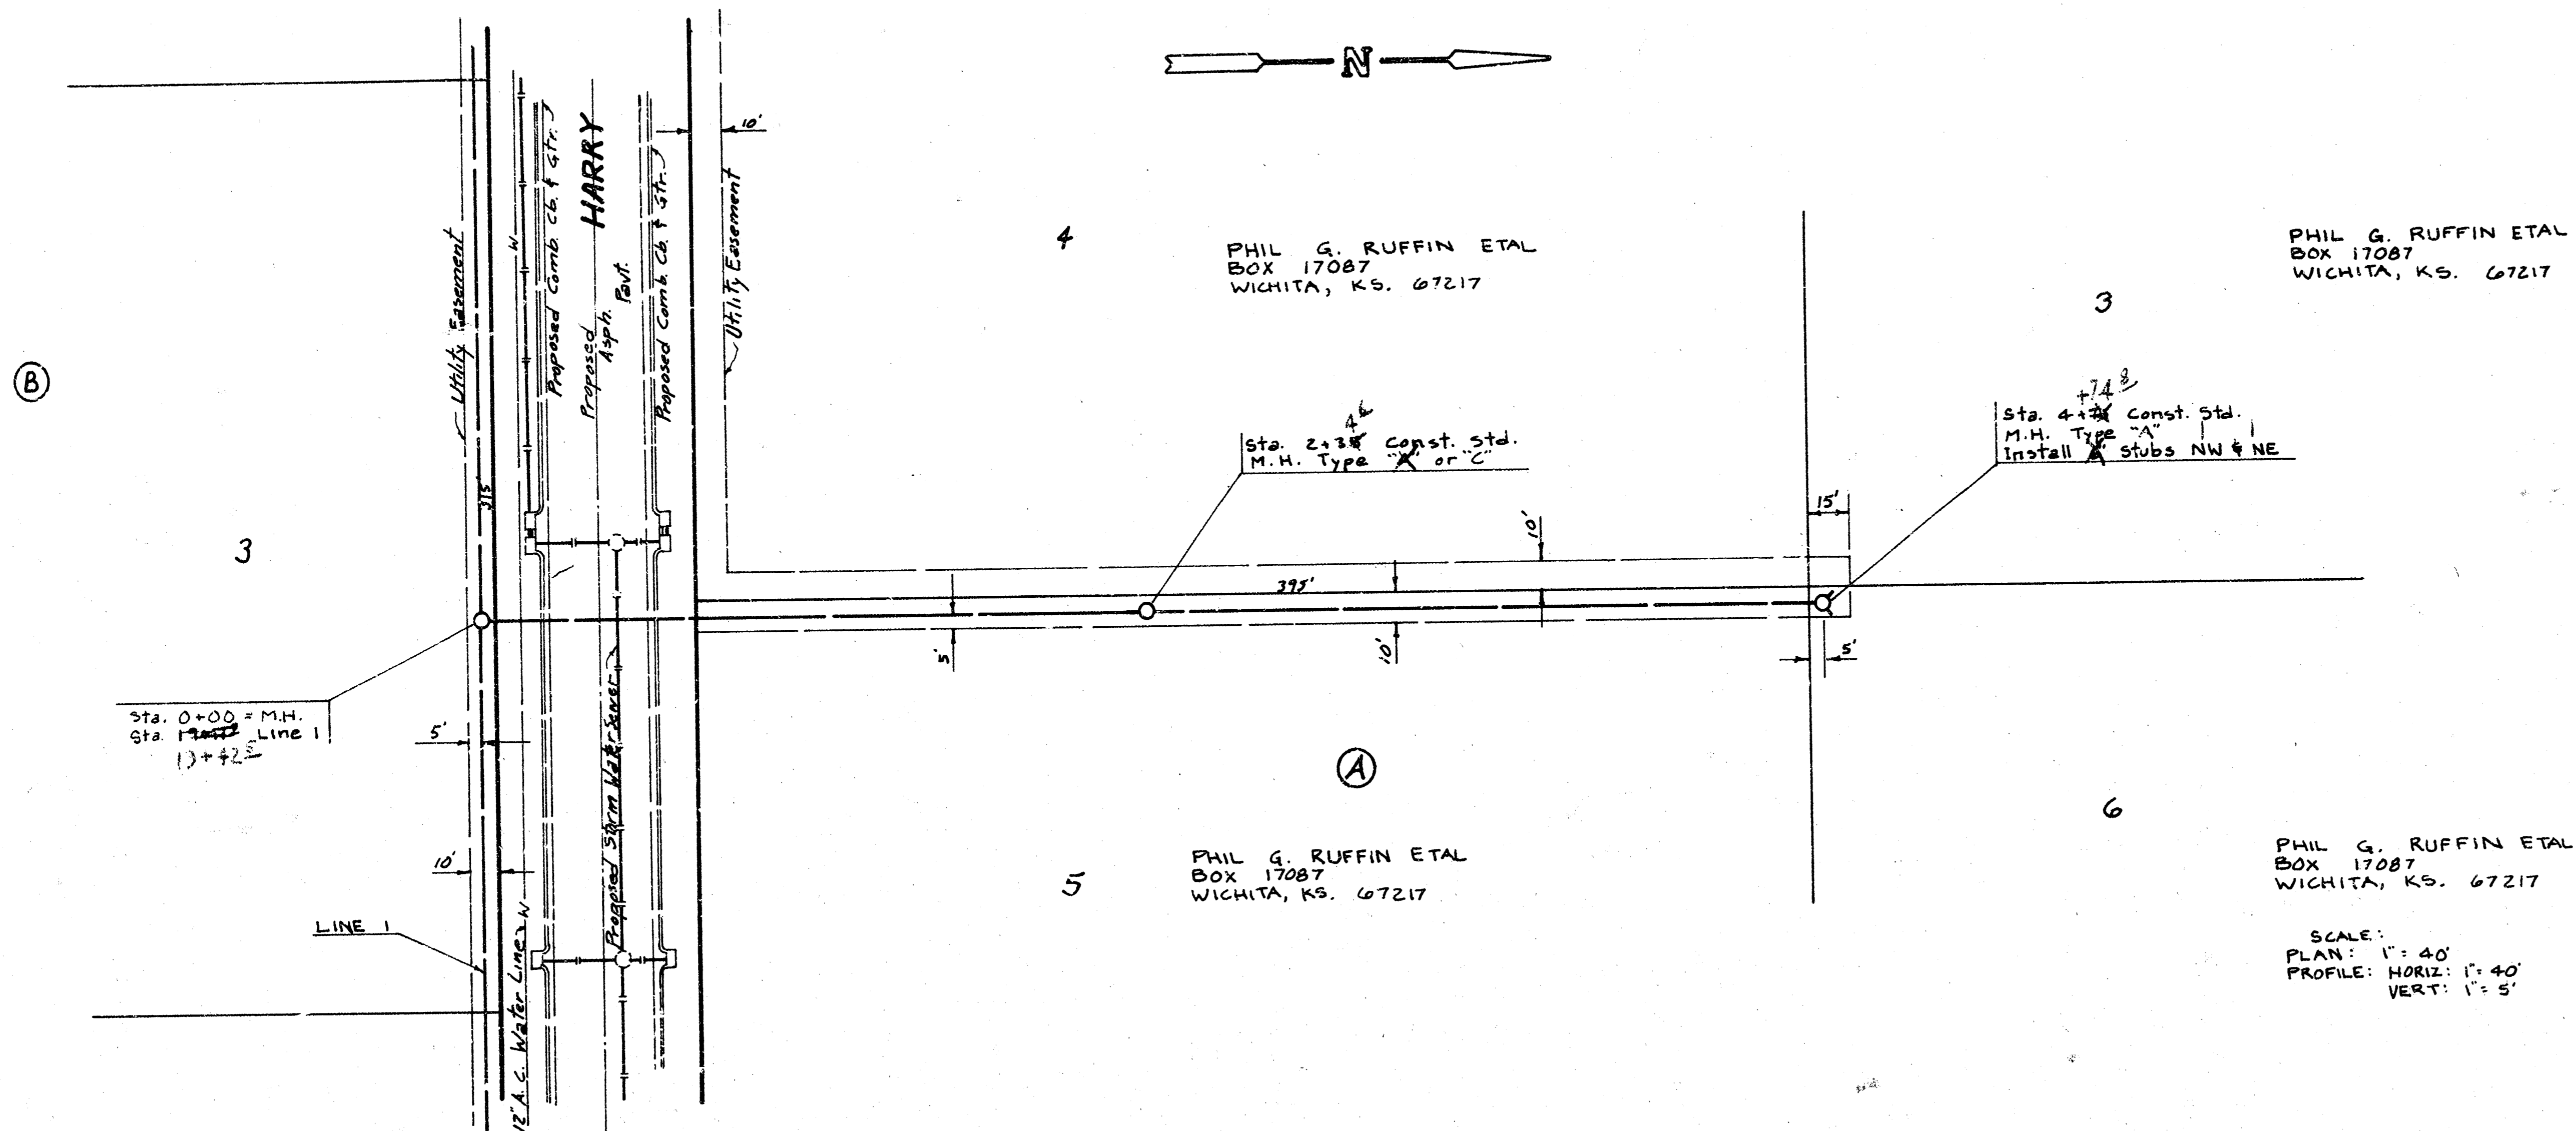

SANTA FE ORIENT INDUSTRIAL DISTRICT 3RD ADDITION

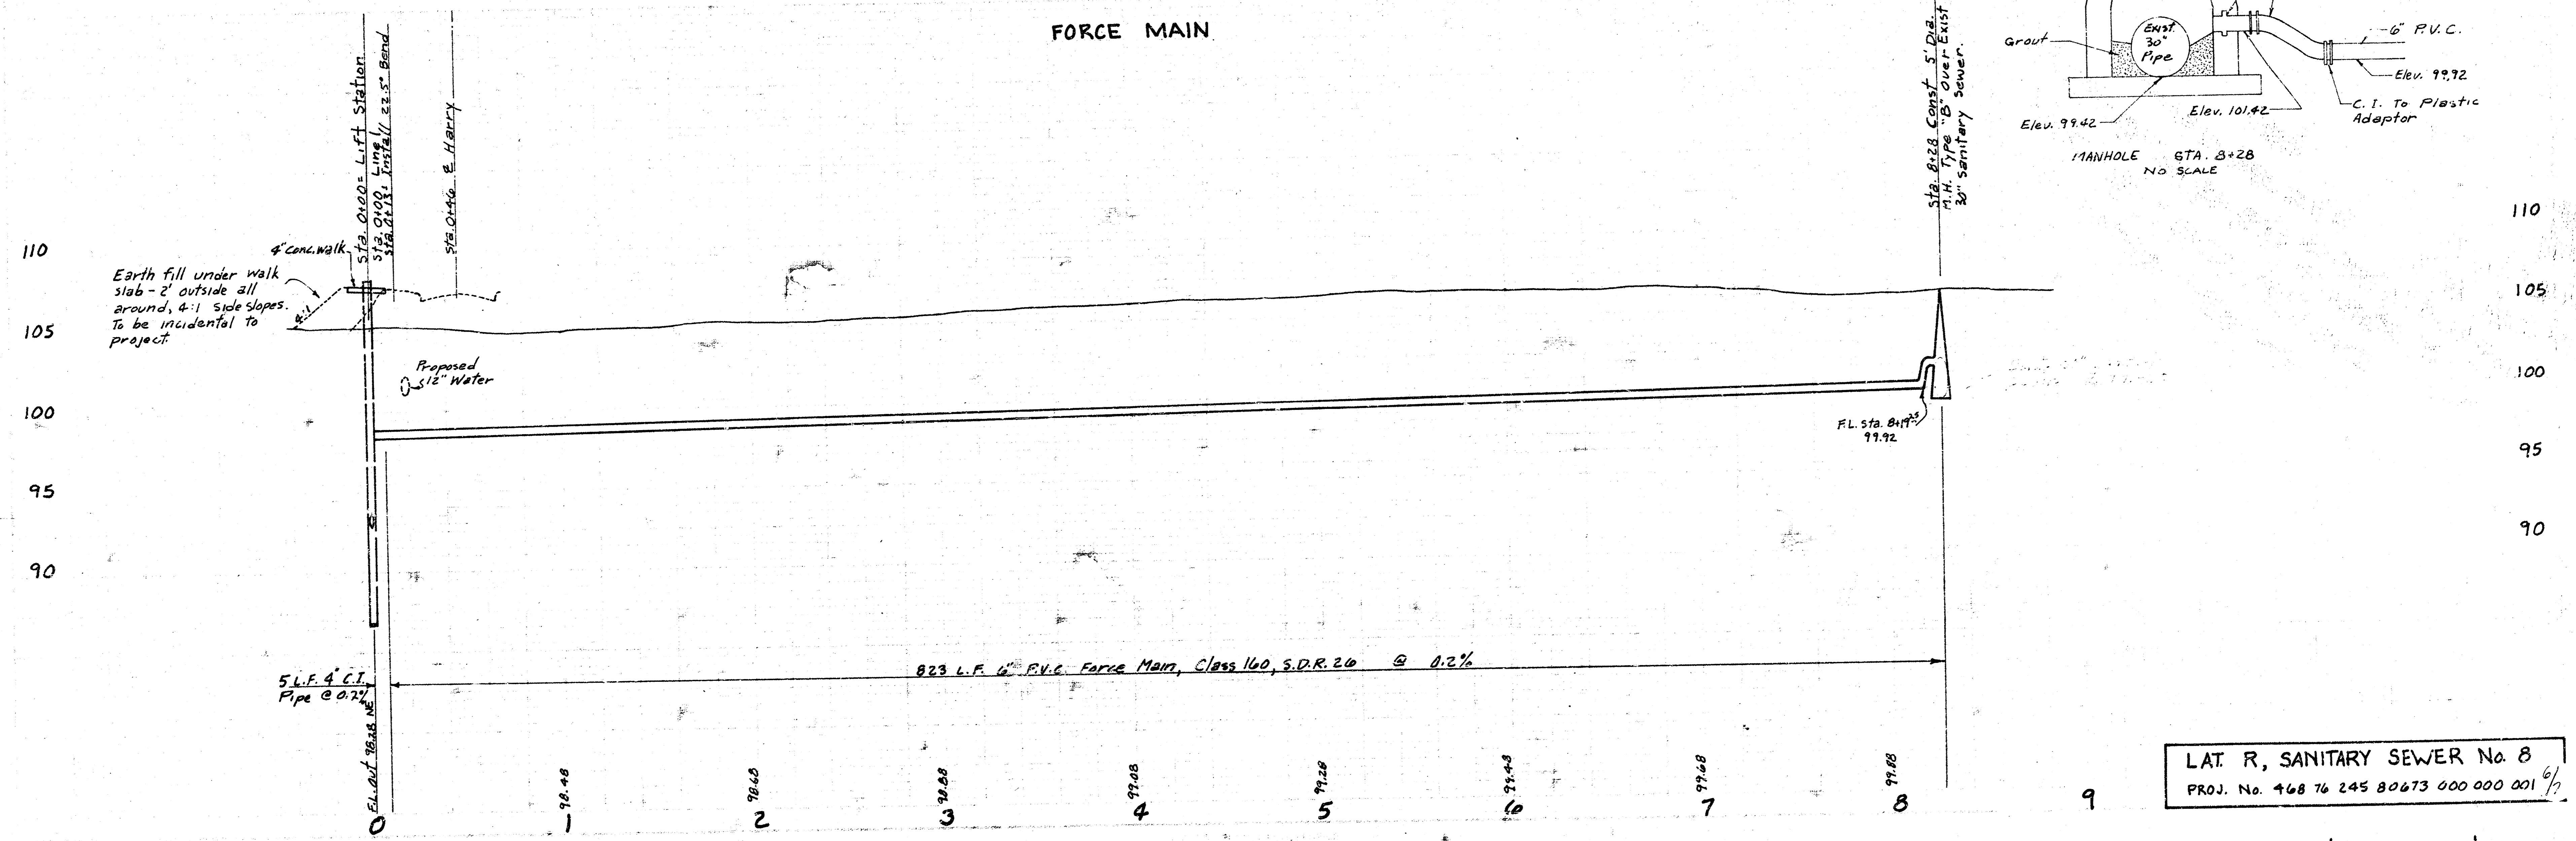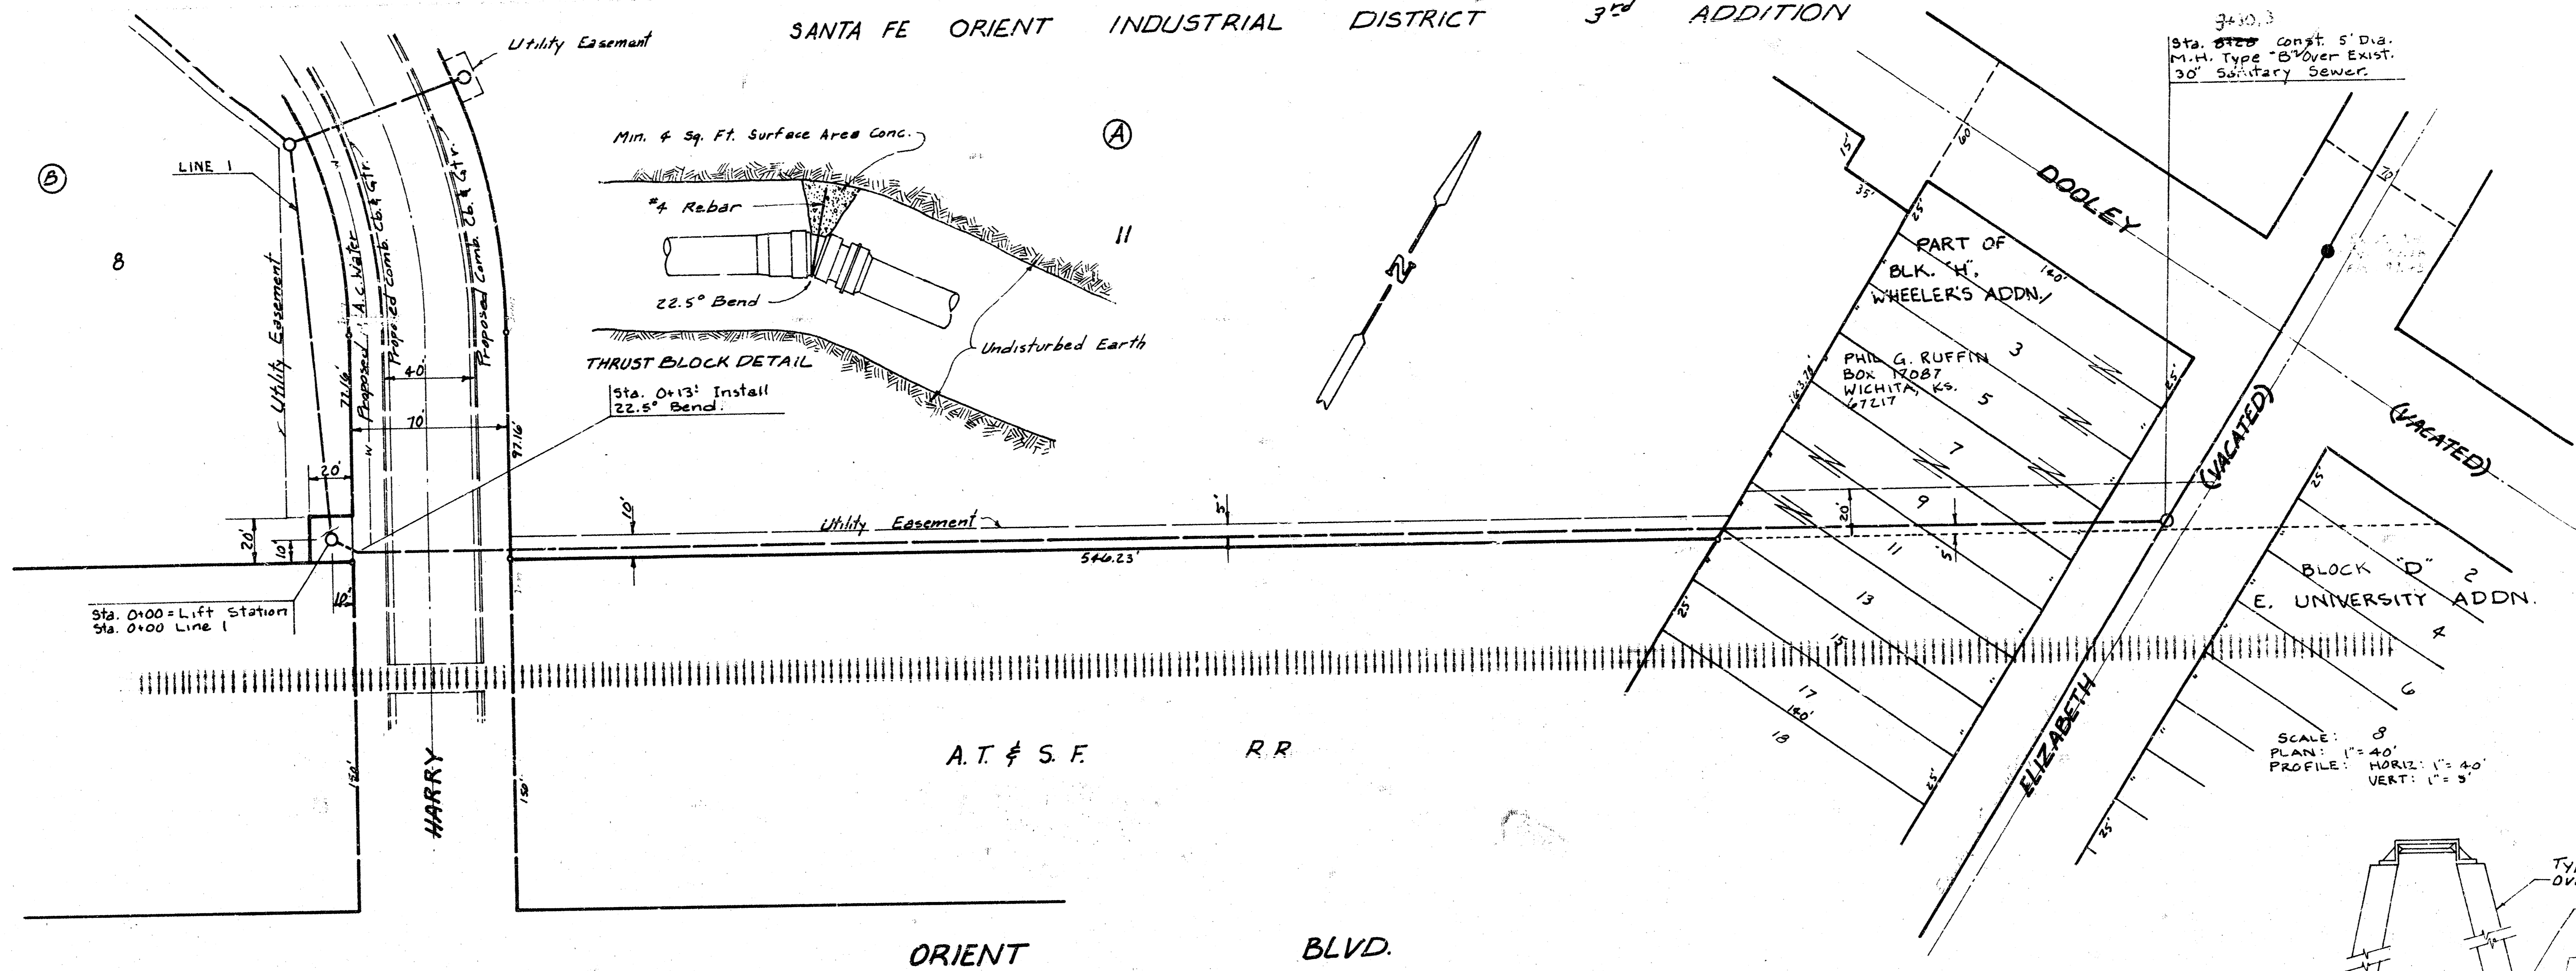

LAT R, SANITARY SEWER No 8
 PROJ. No. 468 76 245 80673 000 000 001 6/7

