


DOUGLAS

Scale Plan 1" = 40'  
Profile 1" = 40' Horz.  
1" = 5' Vert.

B.M. 114.077 EXPOSITION & MISSOURI PACIFIC R.R. TRACK,  
USCGE STANDARD DISC, STAMPED B210 1934, 30.7' N.  
OF CENTERLINE OF MAIN TRACK AND 10' W. OF MILE  
POST #86.

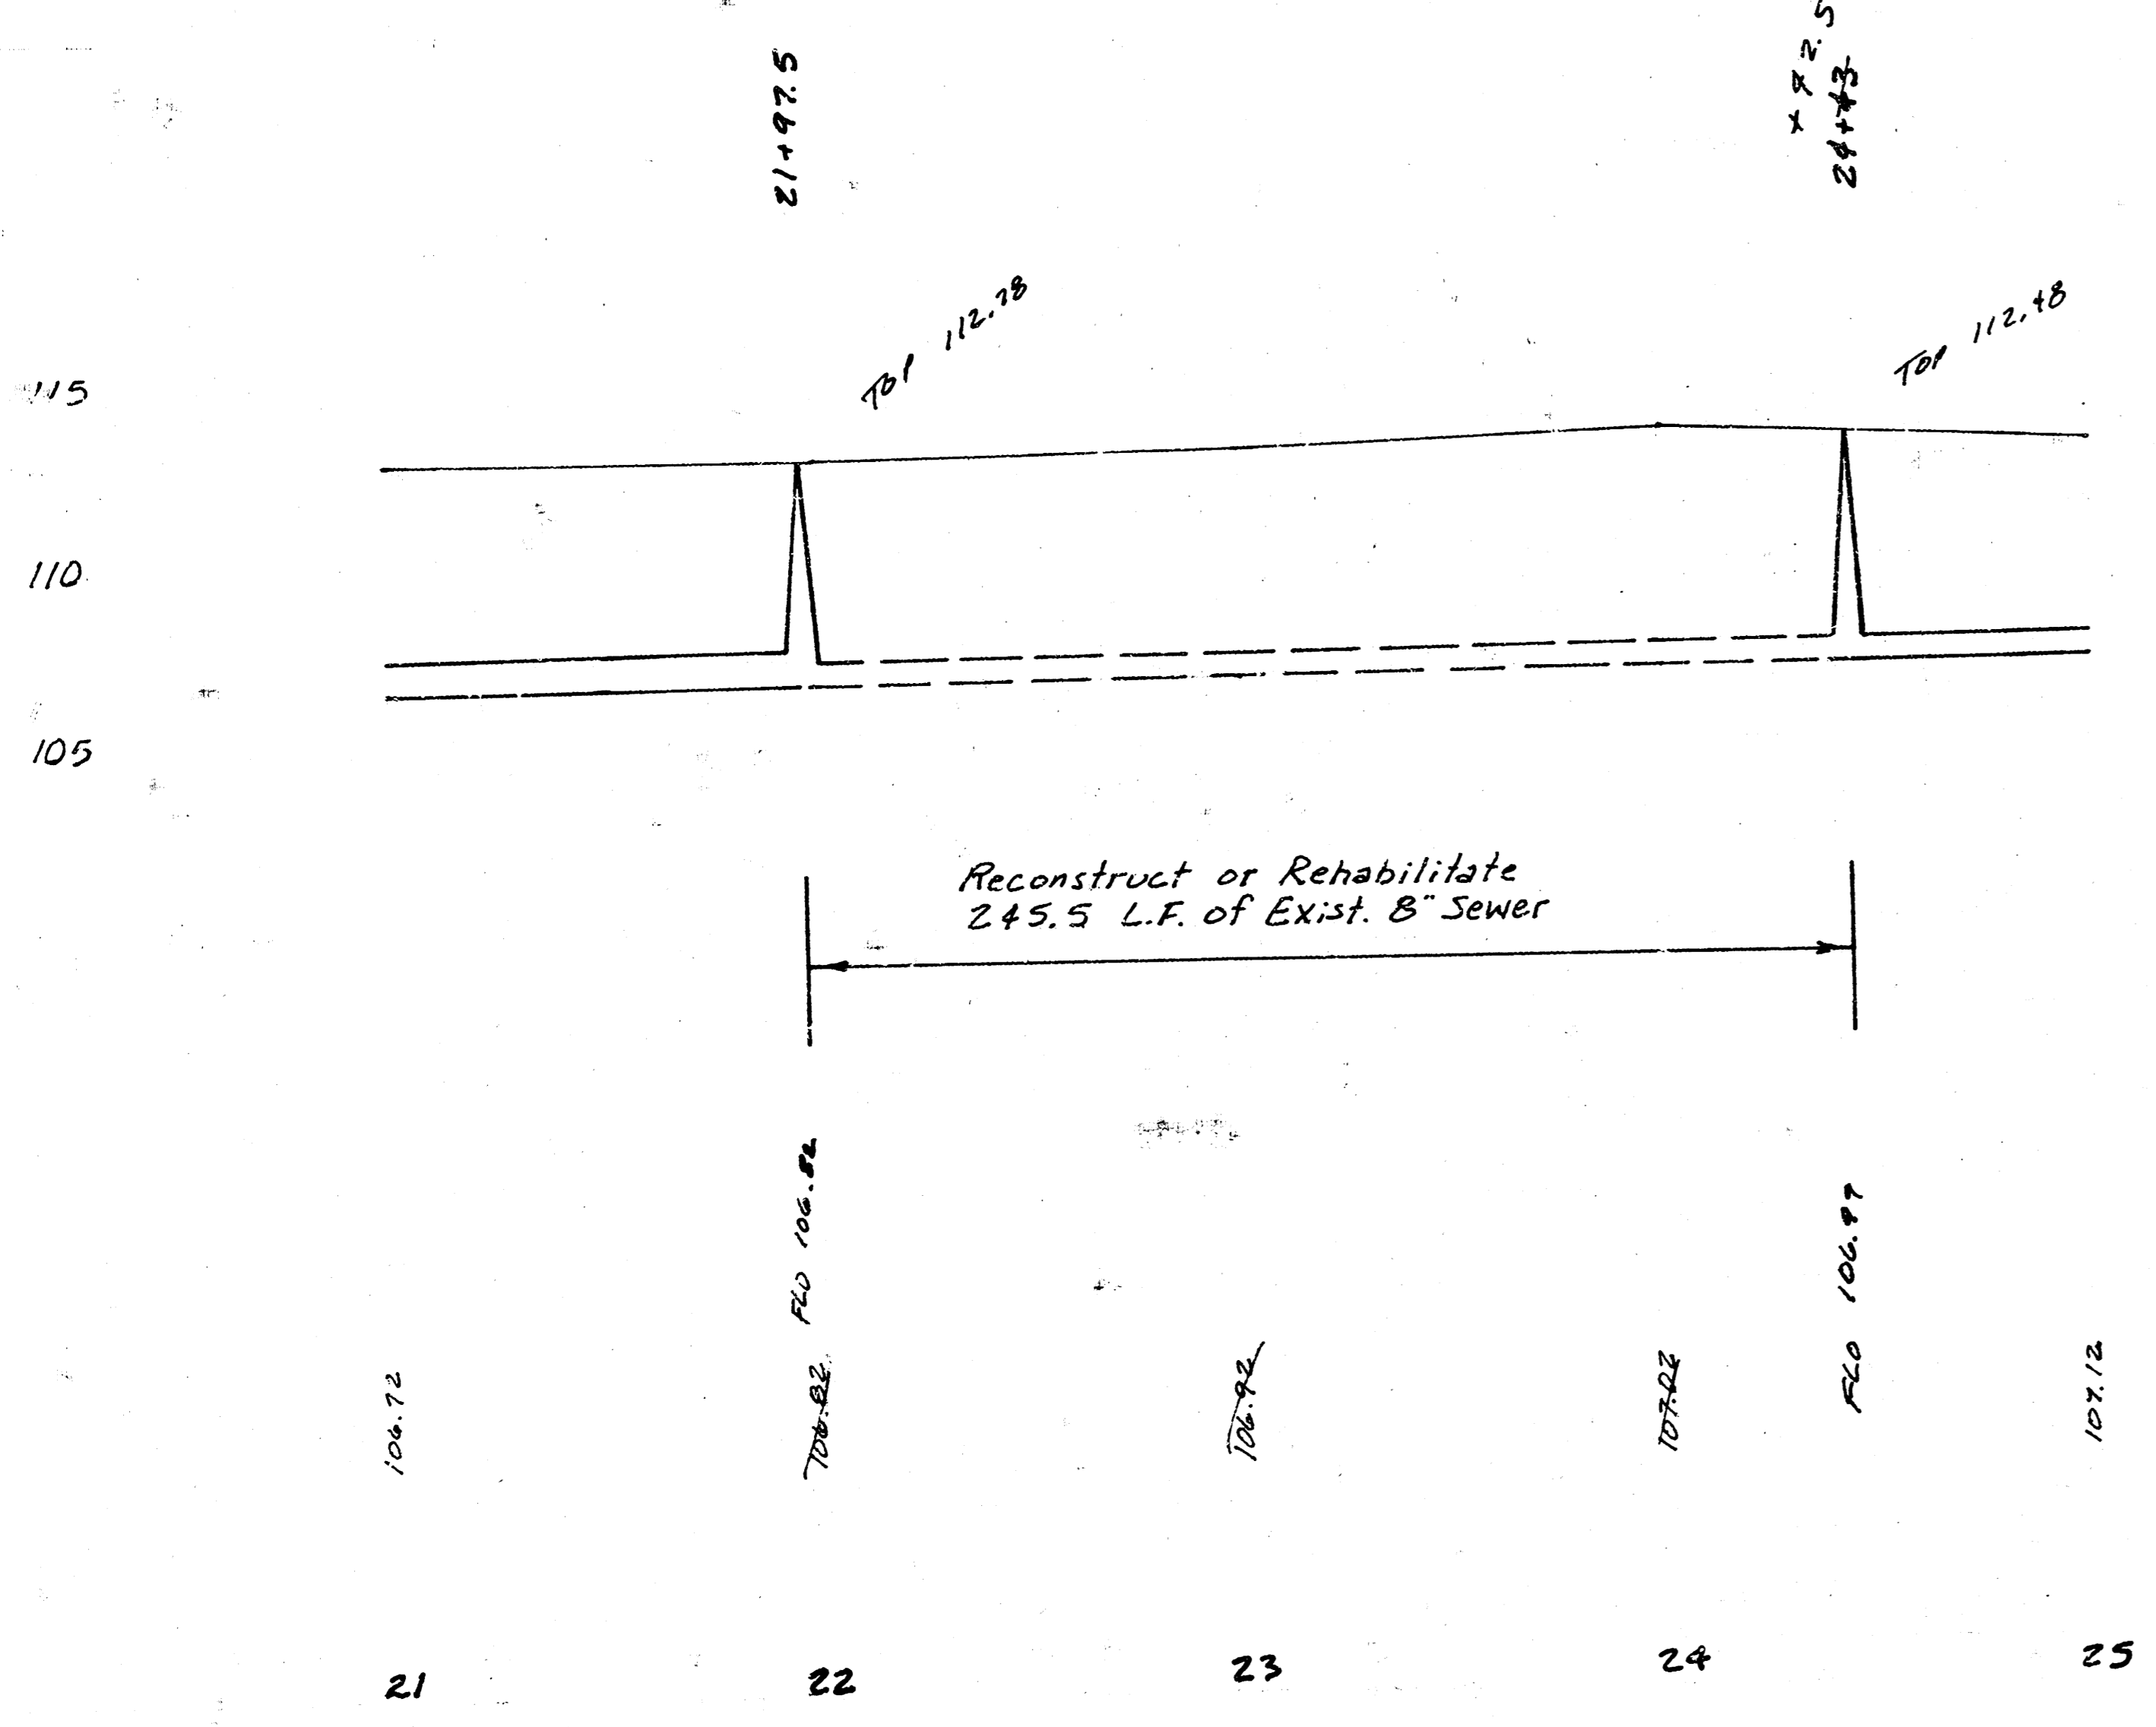

As per  
RAL  
6-86

M. E. LINDEBAK — CITY ENGINEER  
WICHITA, KANSAS  
ALTER, REPAIR, RECONSTRUCT OR CONSTRUCT A  
PORTION OF SANITARY SEWER NO. 8 IN THE ALLEY  
NORTH OF DOUGLAS, FROM EAST OF OSAGE TO  
WEST OF OSAGE  
PROJECT NUMBER  
468-76-245-81559-000-001

FILMED FROM THE BEST  
AVAILABLE COPY.....