



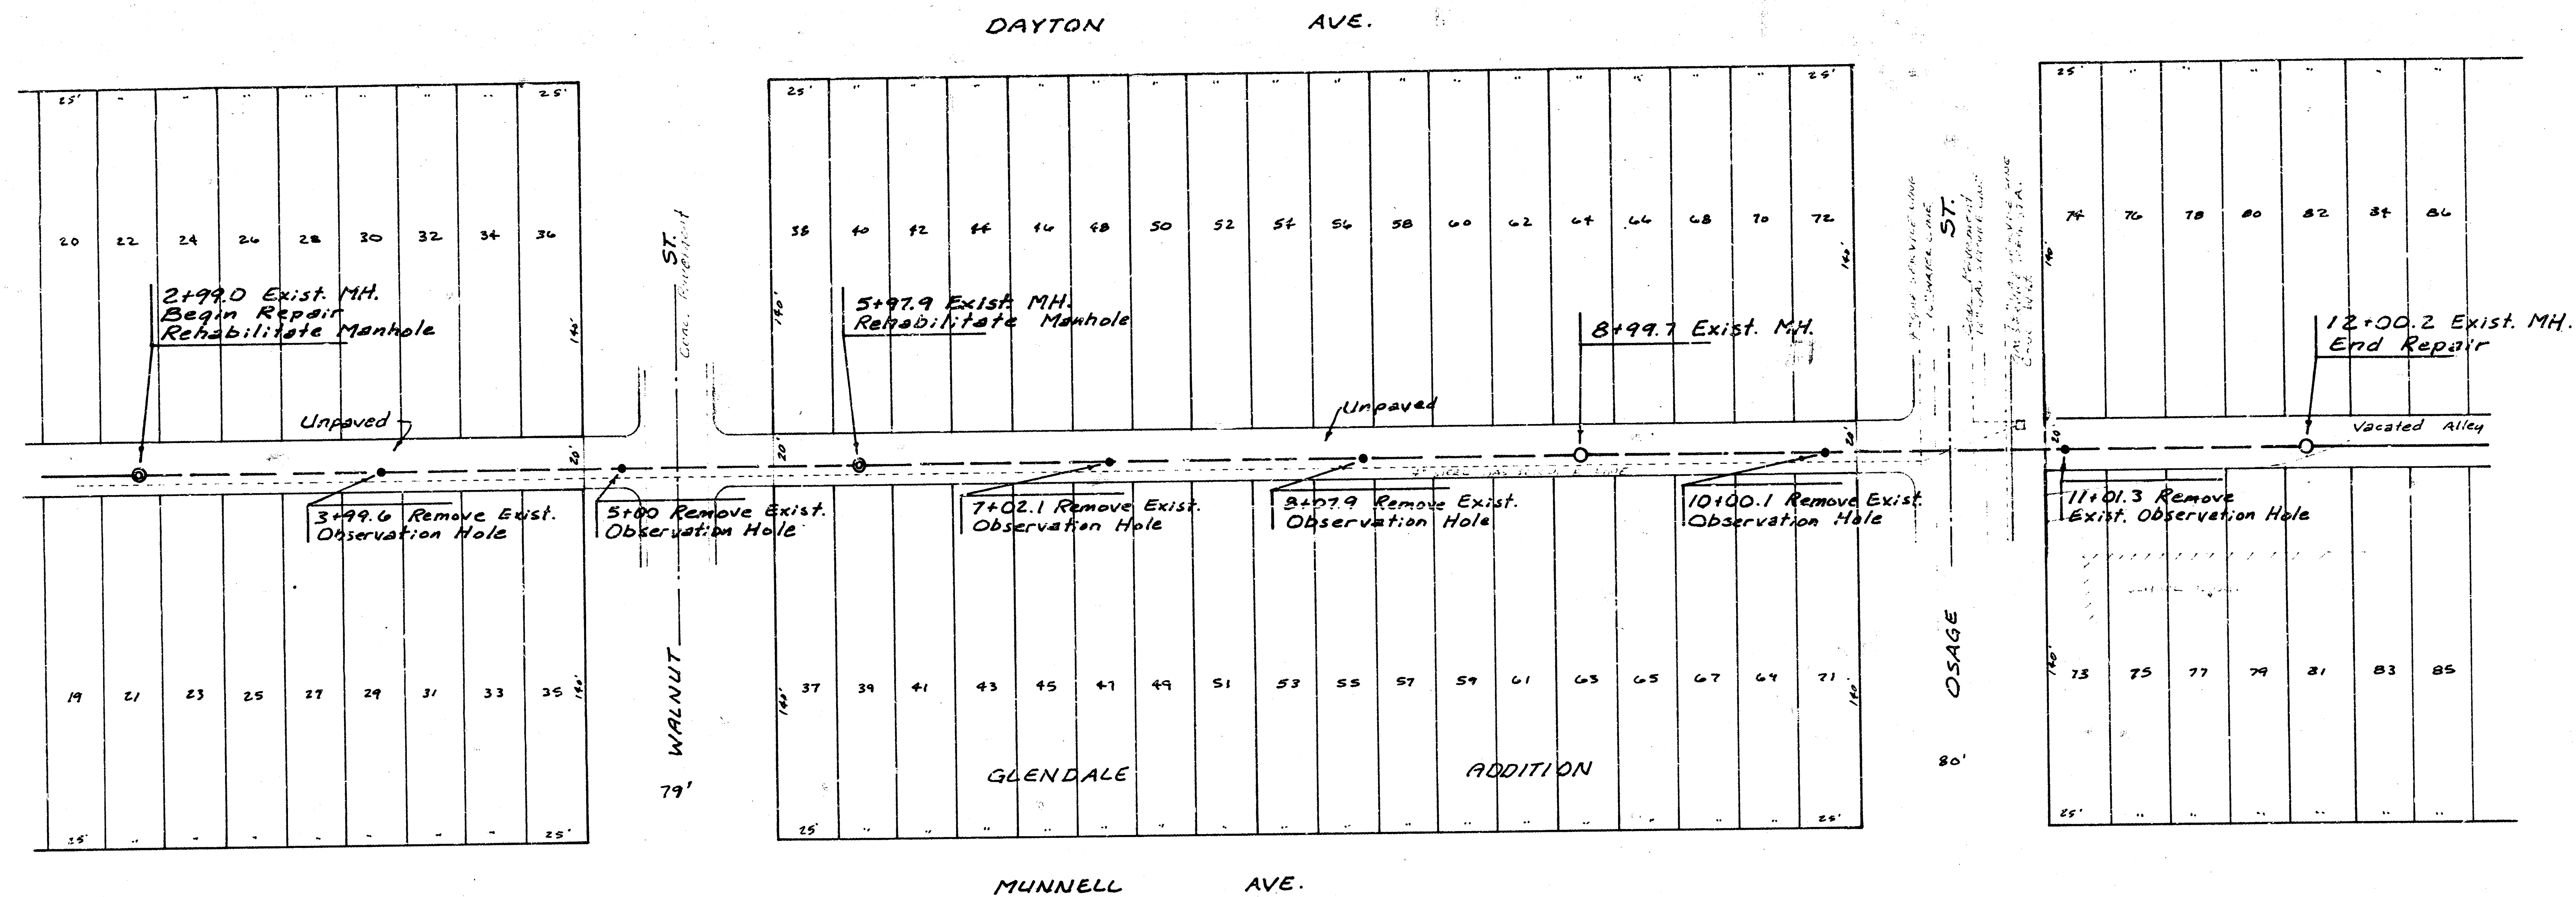

Scale Plan 1" = 40'
 Profile 1" = 40' Horiz.
 1" = 5' Vert.

B.M. 107.22 BRASS ROD IN CONCRETE POST.
 NW CORNER 32' N & 27.3' W OF CENTERLINE
 BOTH SENECA & MCCORMICK.

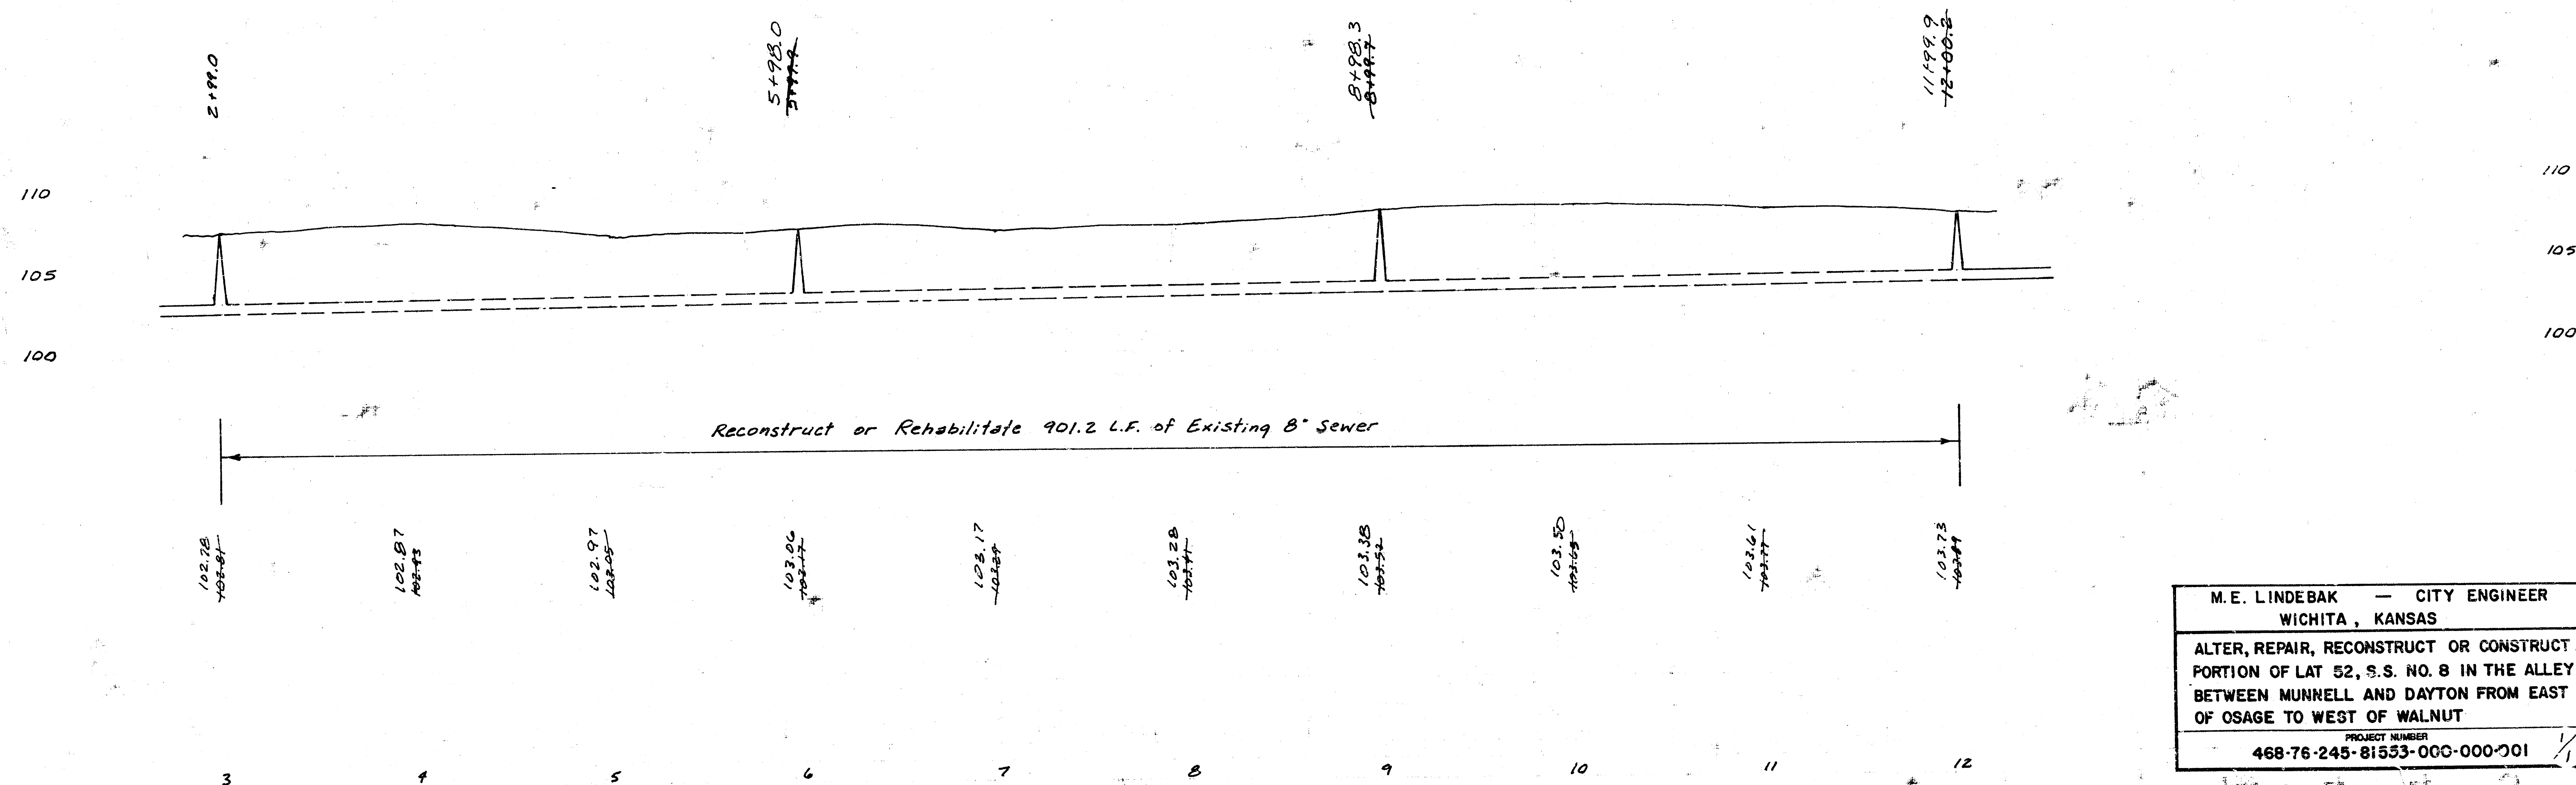

M.E. LINDEBAK — CITY ENGINEER
 WICHITA, KANSAS

ALTER, REPAIR, RECONSTRUCT OR CONSTRUCT A
 PORTION OF LAT 52, S.S. NO. 8 IN THE ALLEY
 BETWEEN MUNNELL AND DAYTON FROM EAST
 OF OSAGE TO WEST OF WALNUT

PROJECT NUMBER
 468-76-245-81553-000-000-001

FILMED FROM THE BEST
 AVAILABLE COPY