


SUB-DISTRICT No 3  
 DISTRICT No A  
 DISTRICT No 13

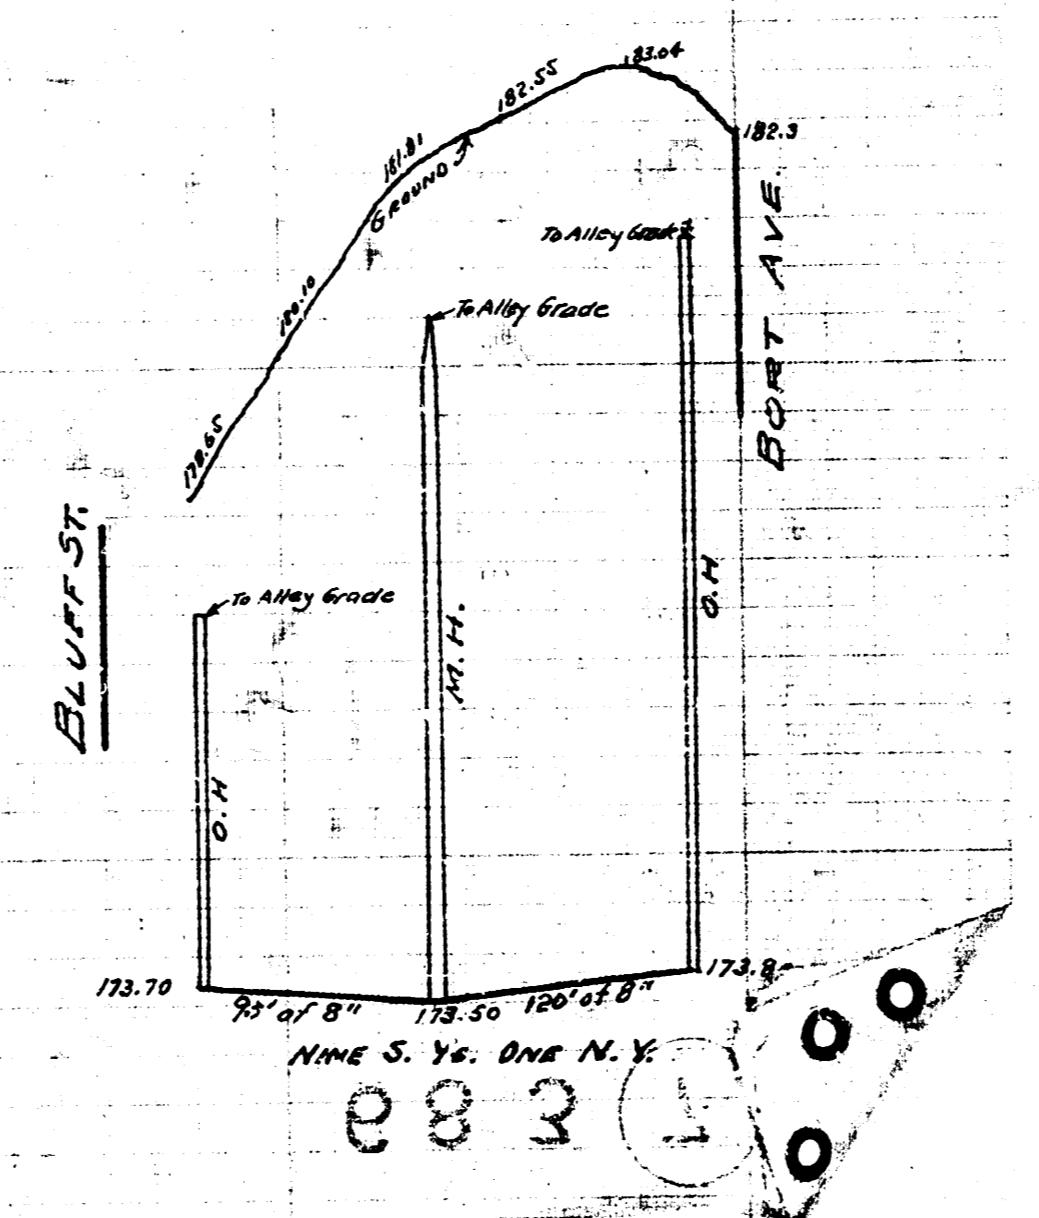

000  
 000  
 000