




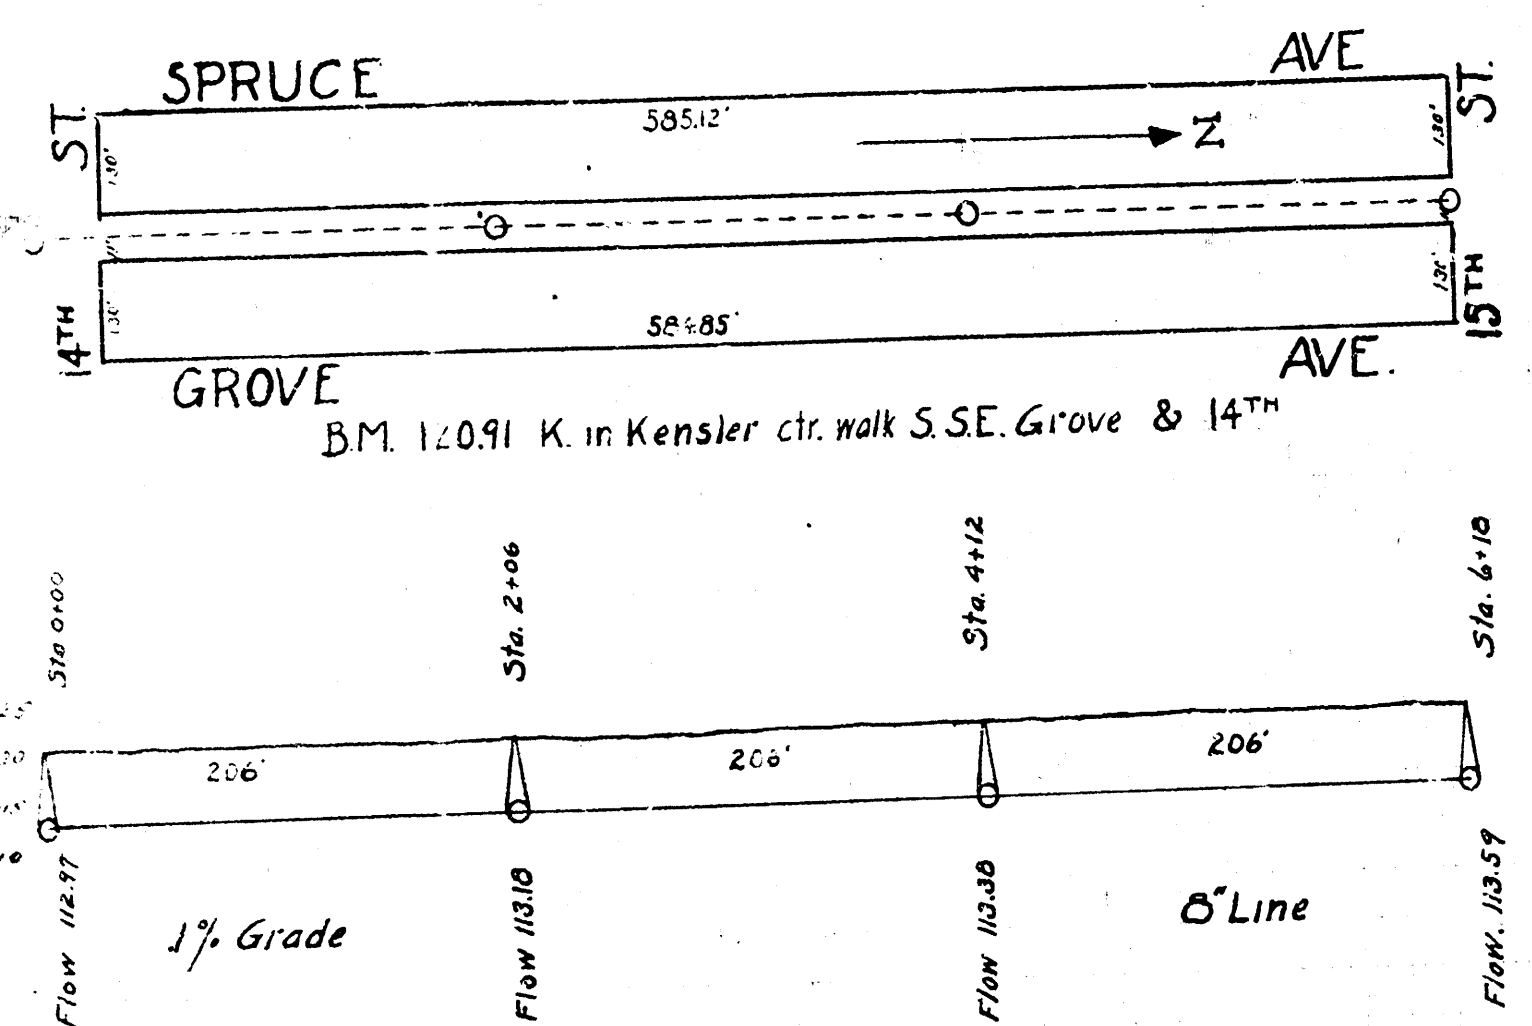



LAT J DIST O S.S. 12

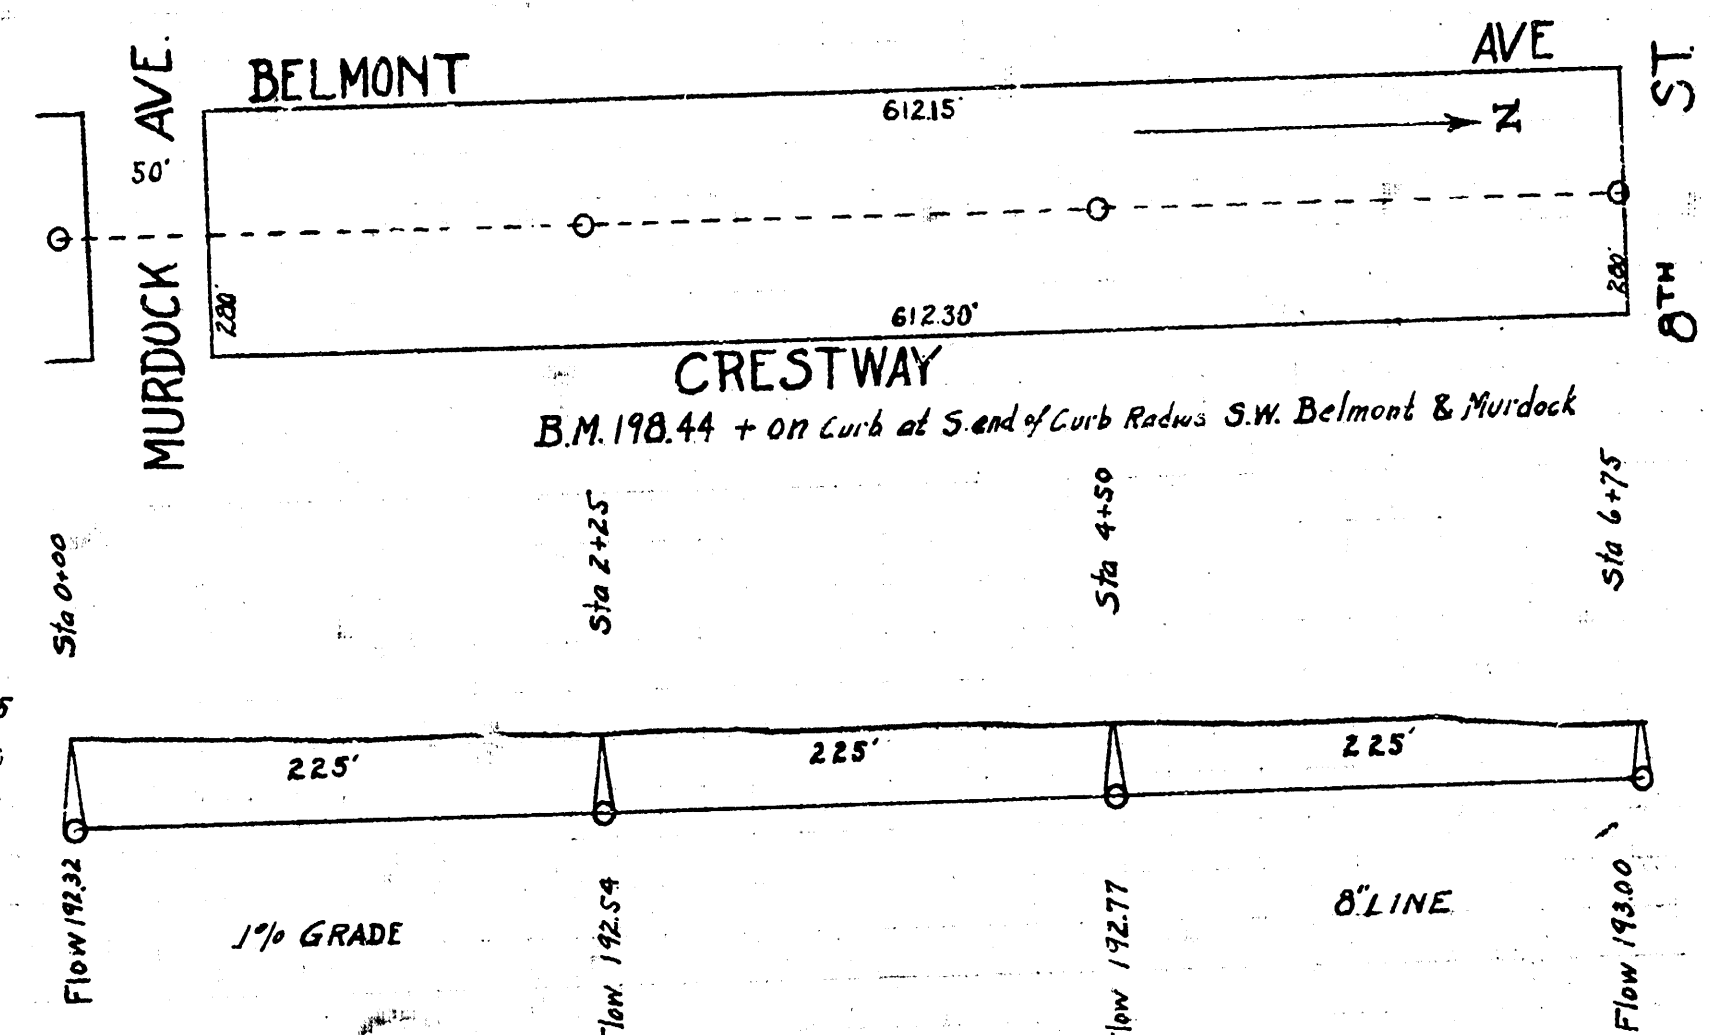


LAT 26 DIST A S.S. 12

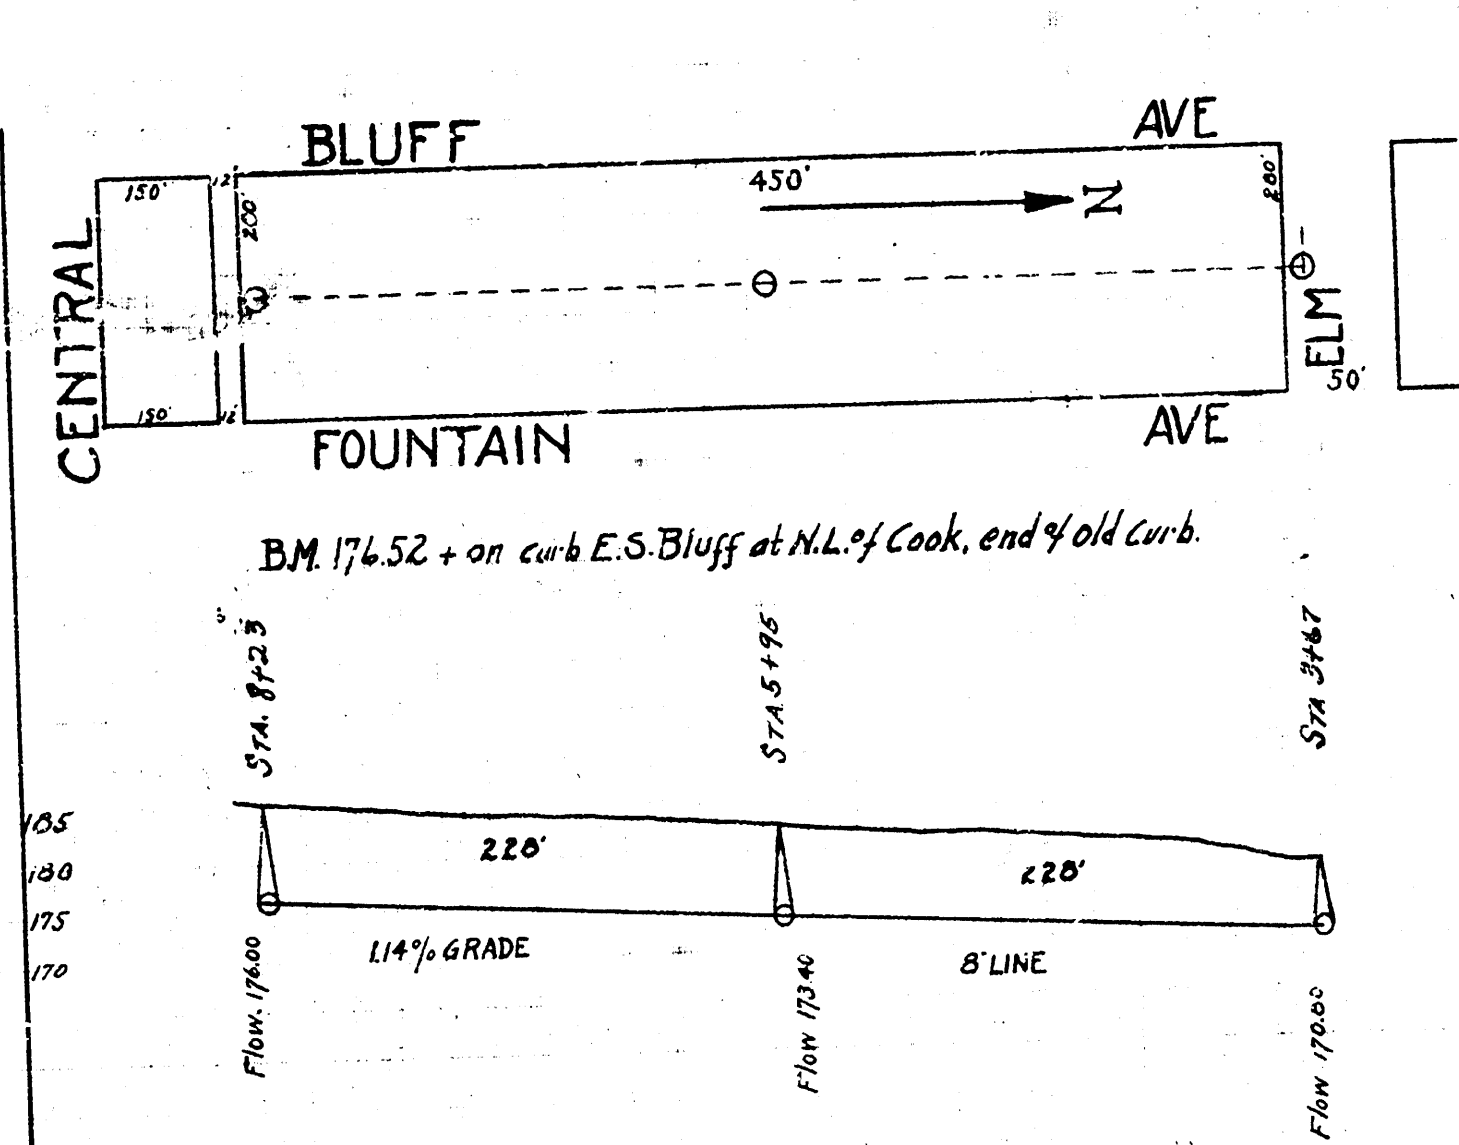

LAT X DIST D S.S. 12

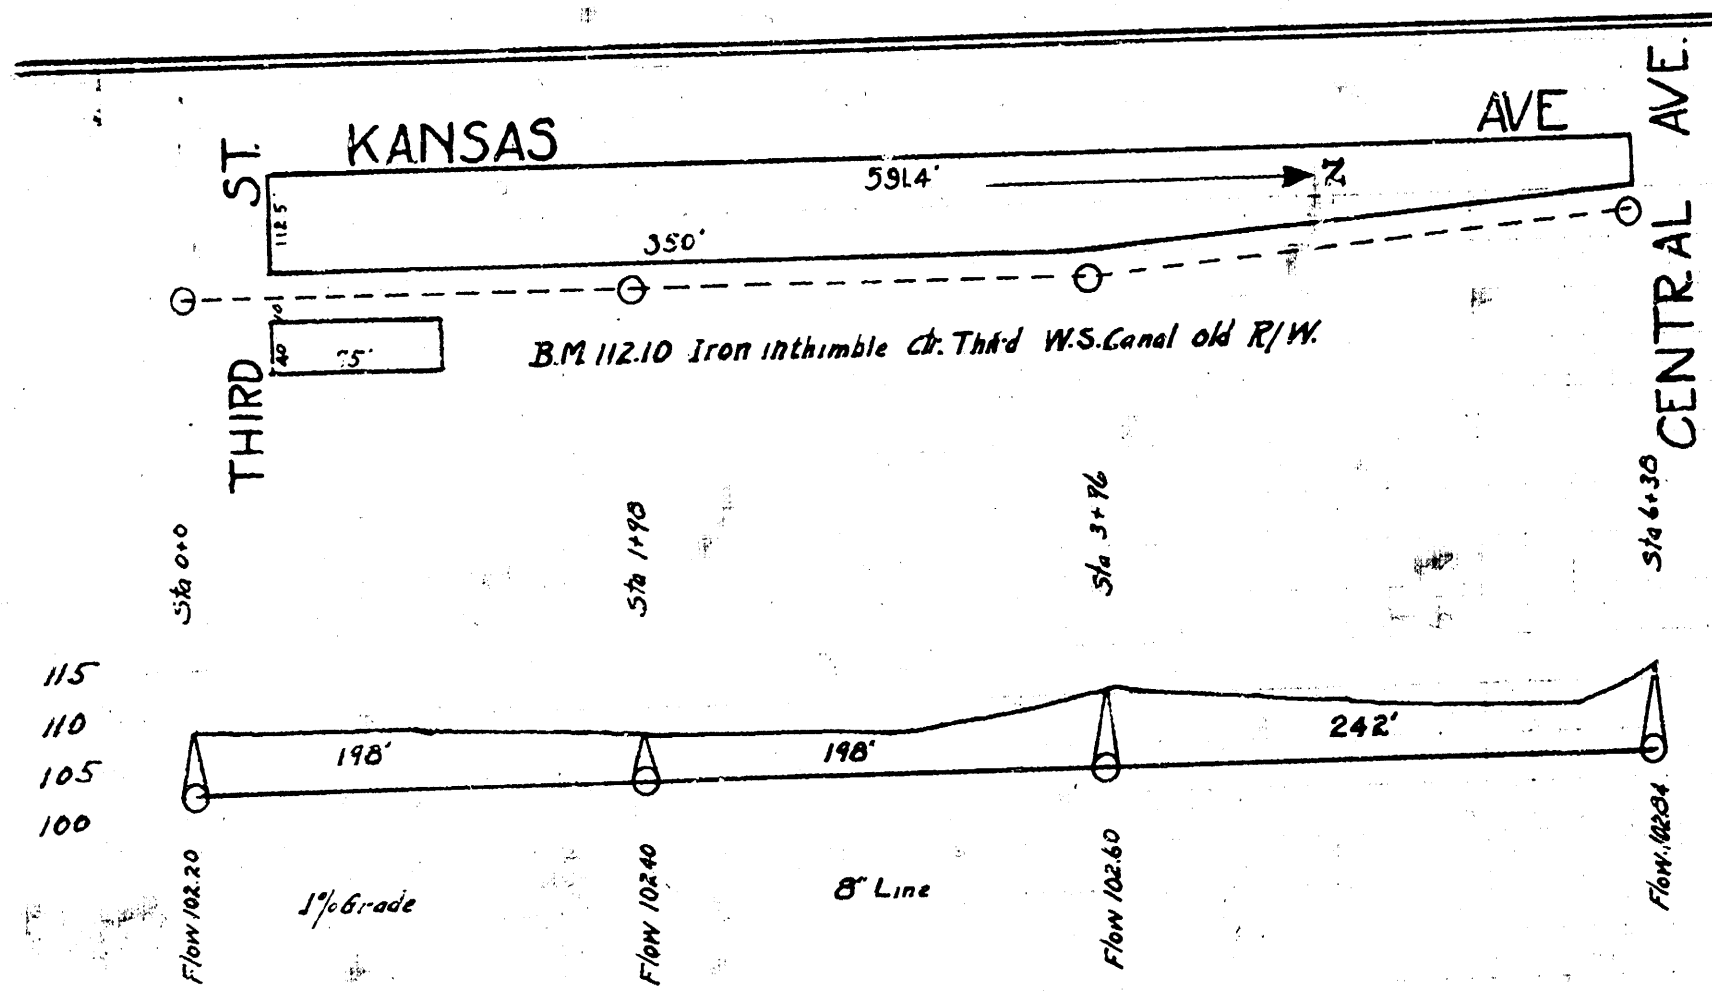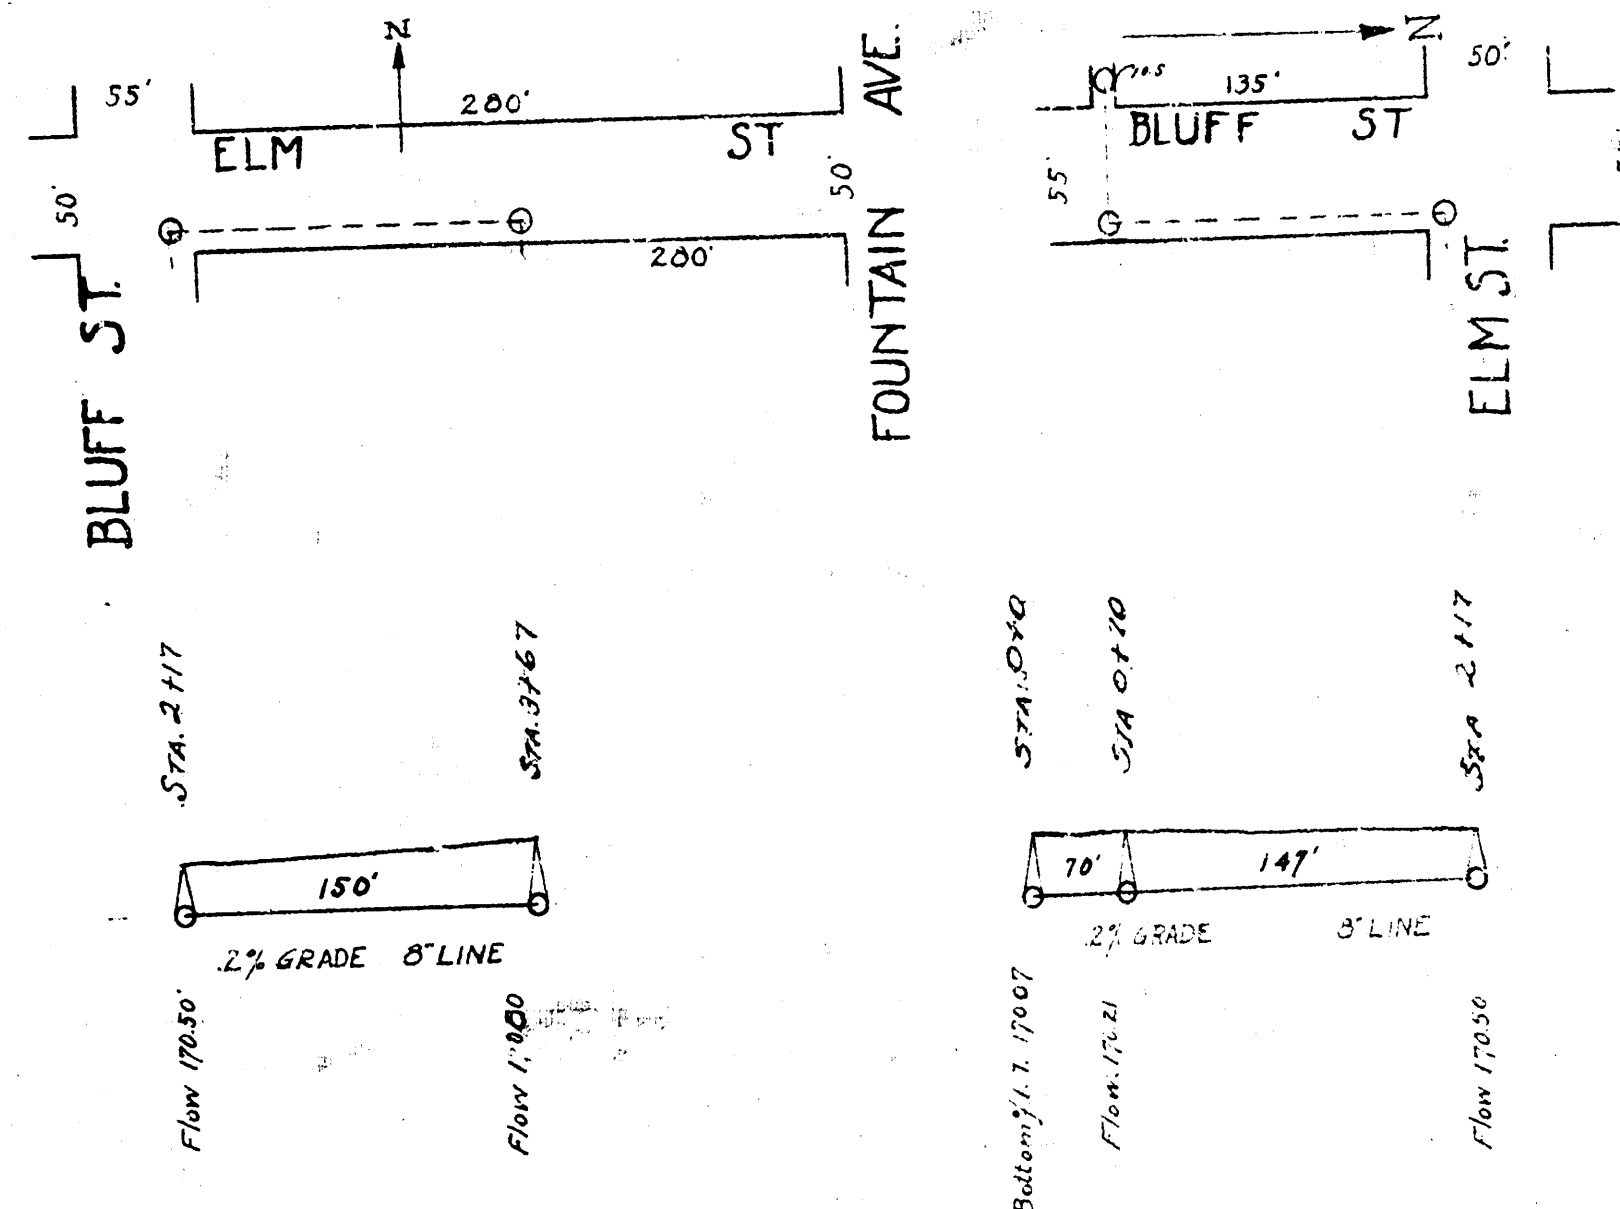

LAT 3 DIST N-O S.S. 20

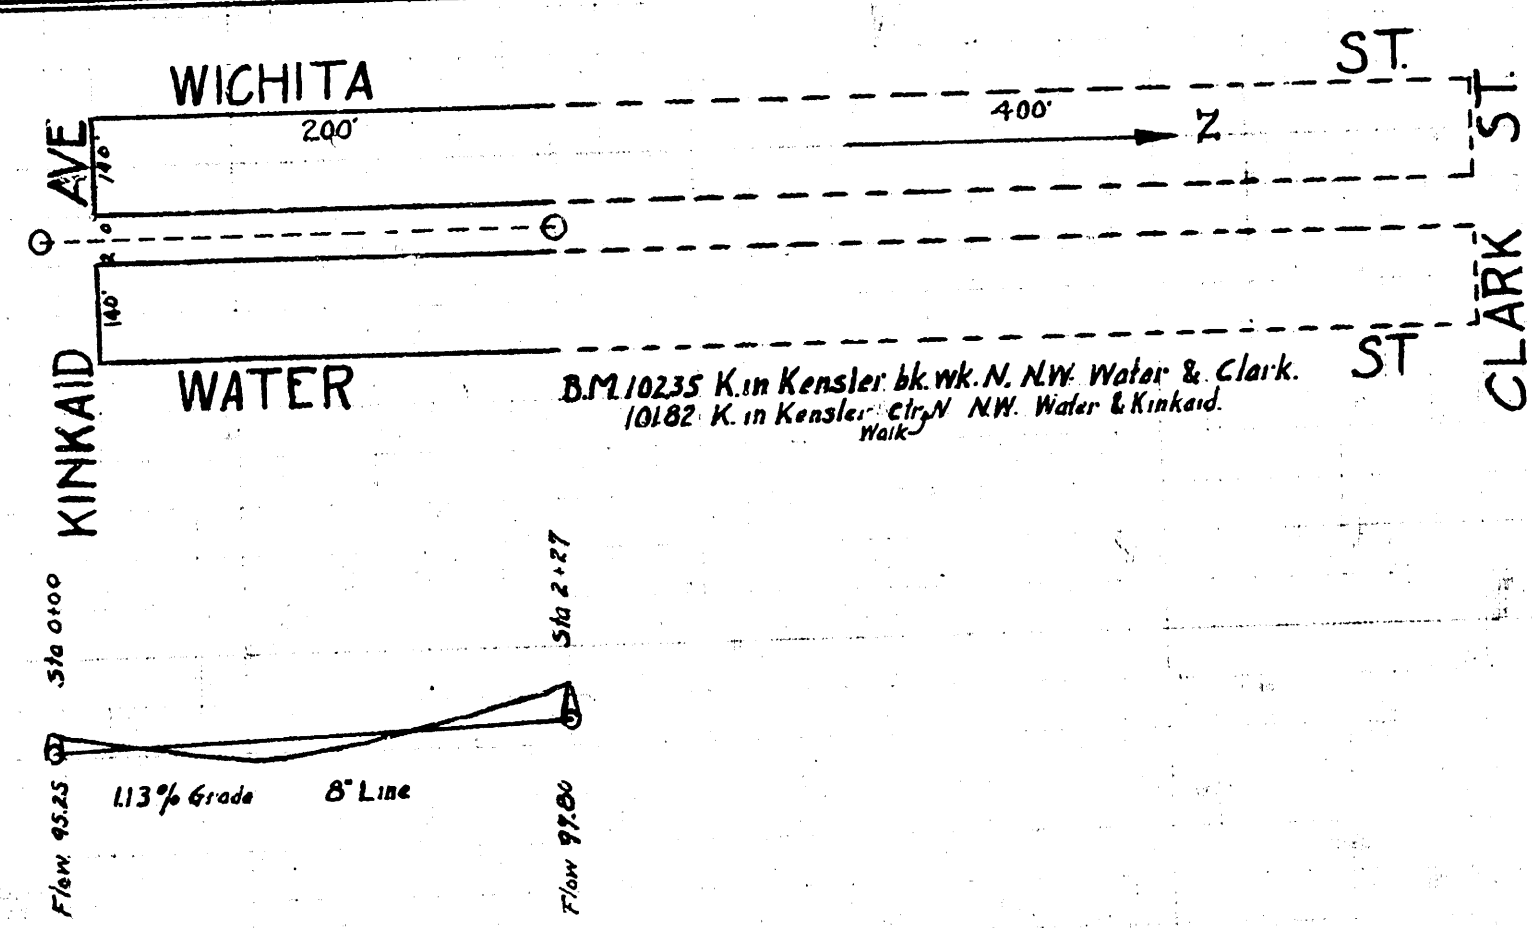

LAT G DIST B S.S. 20