


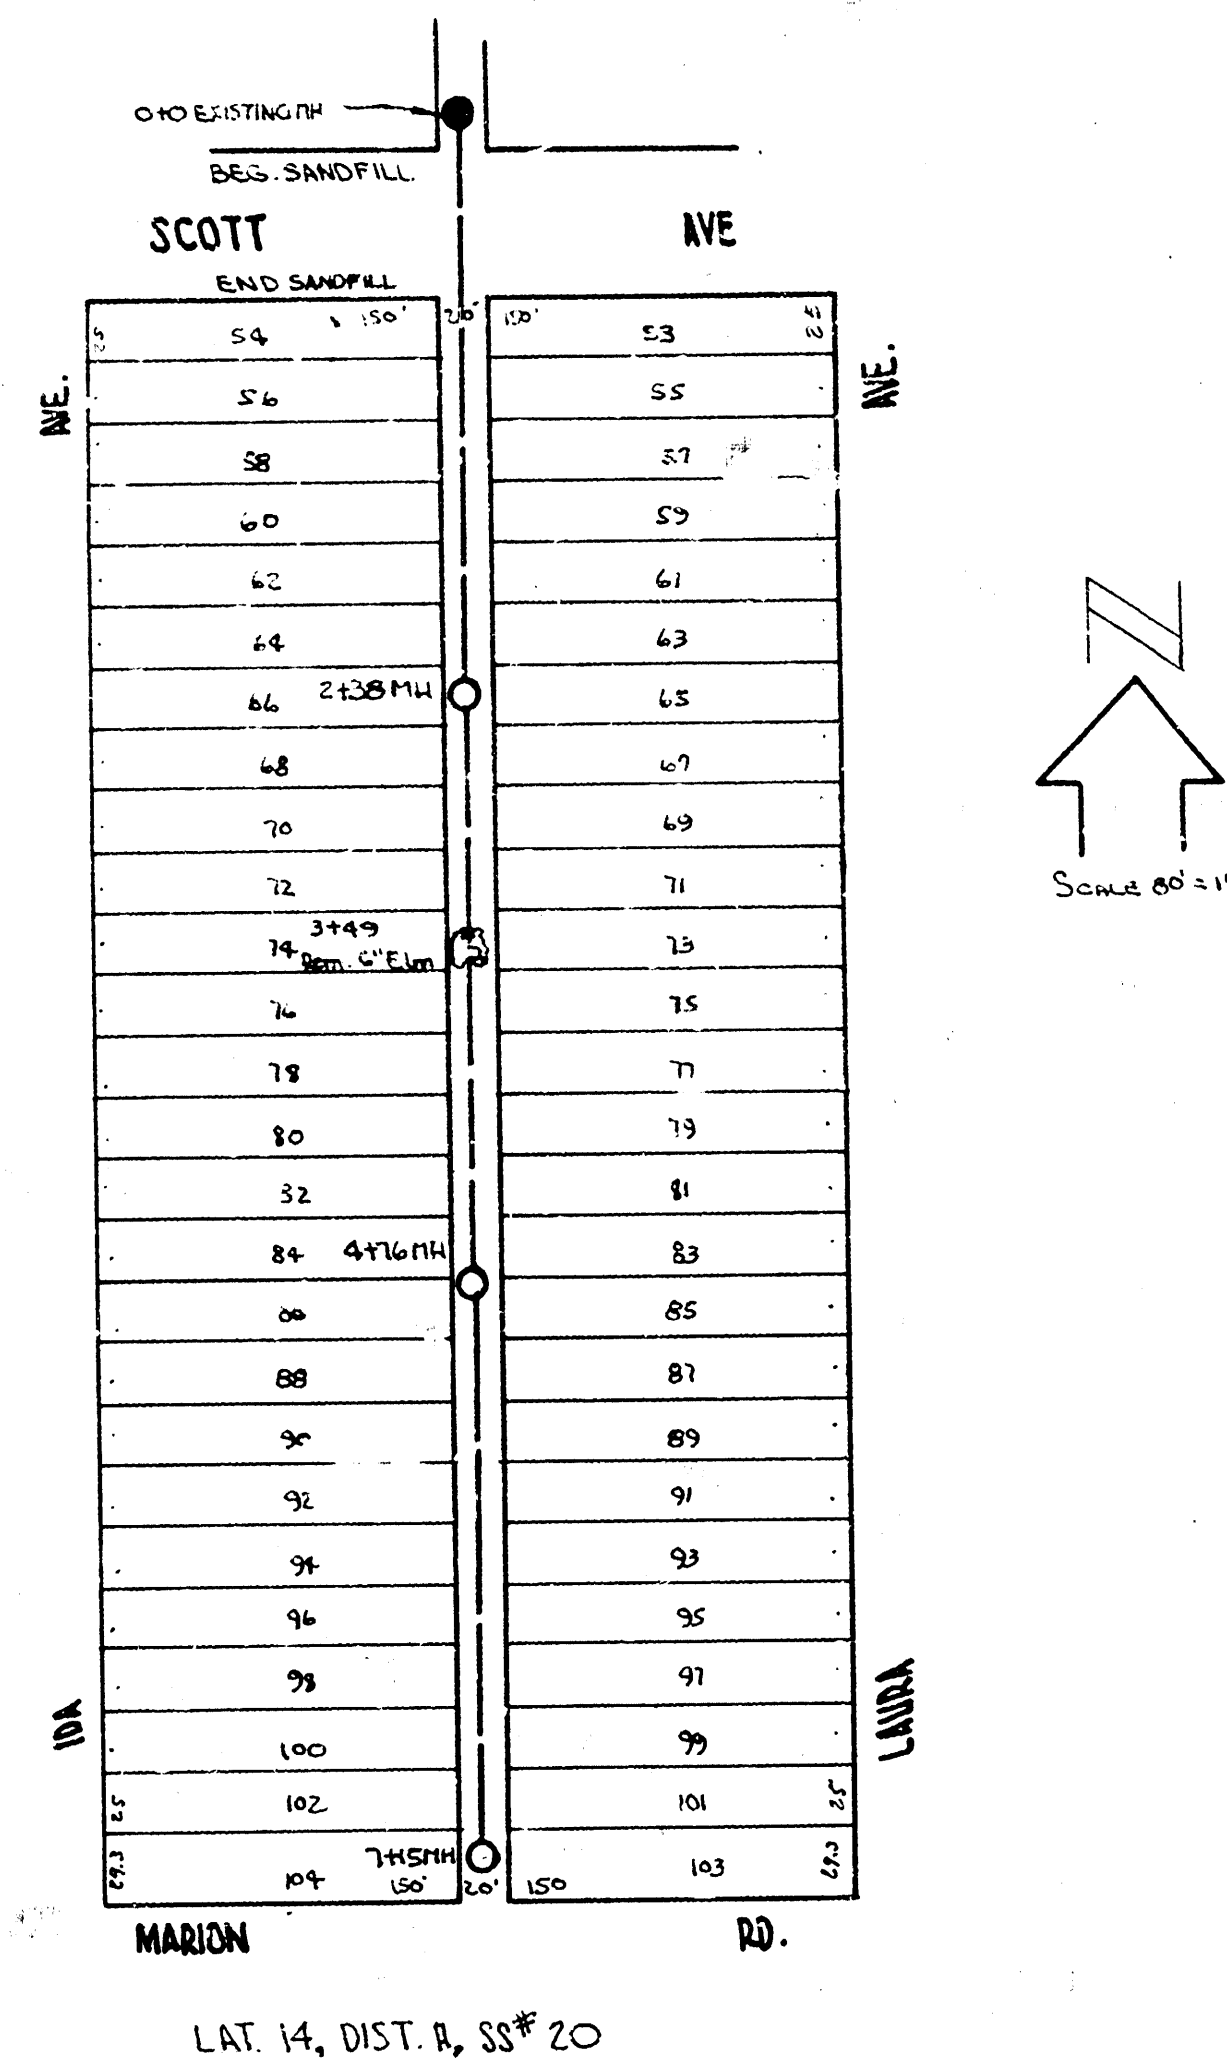
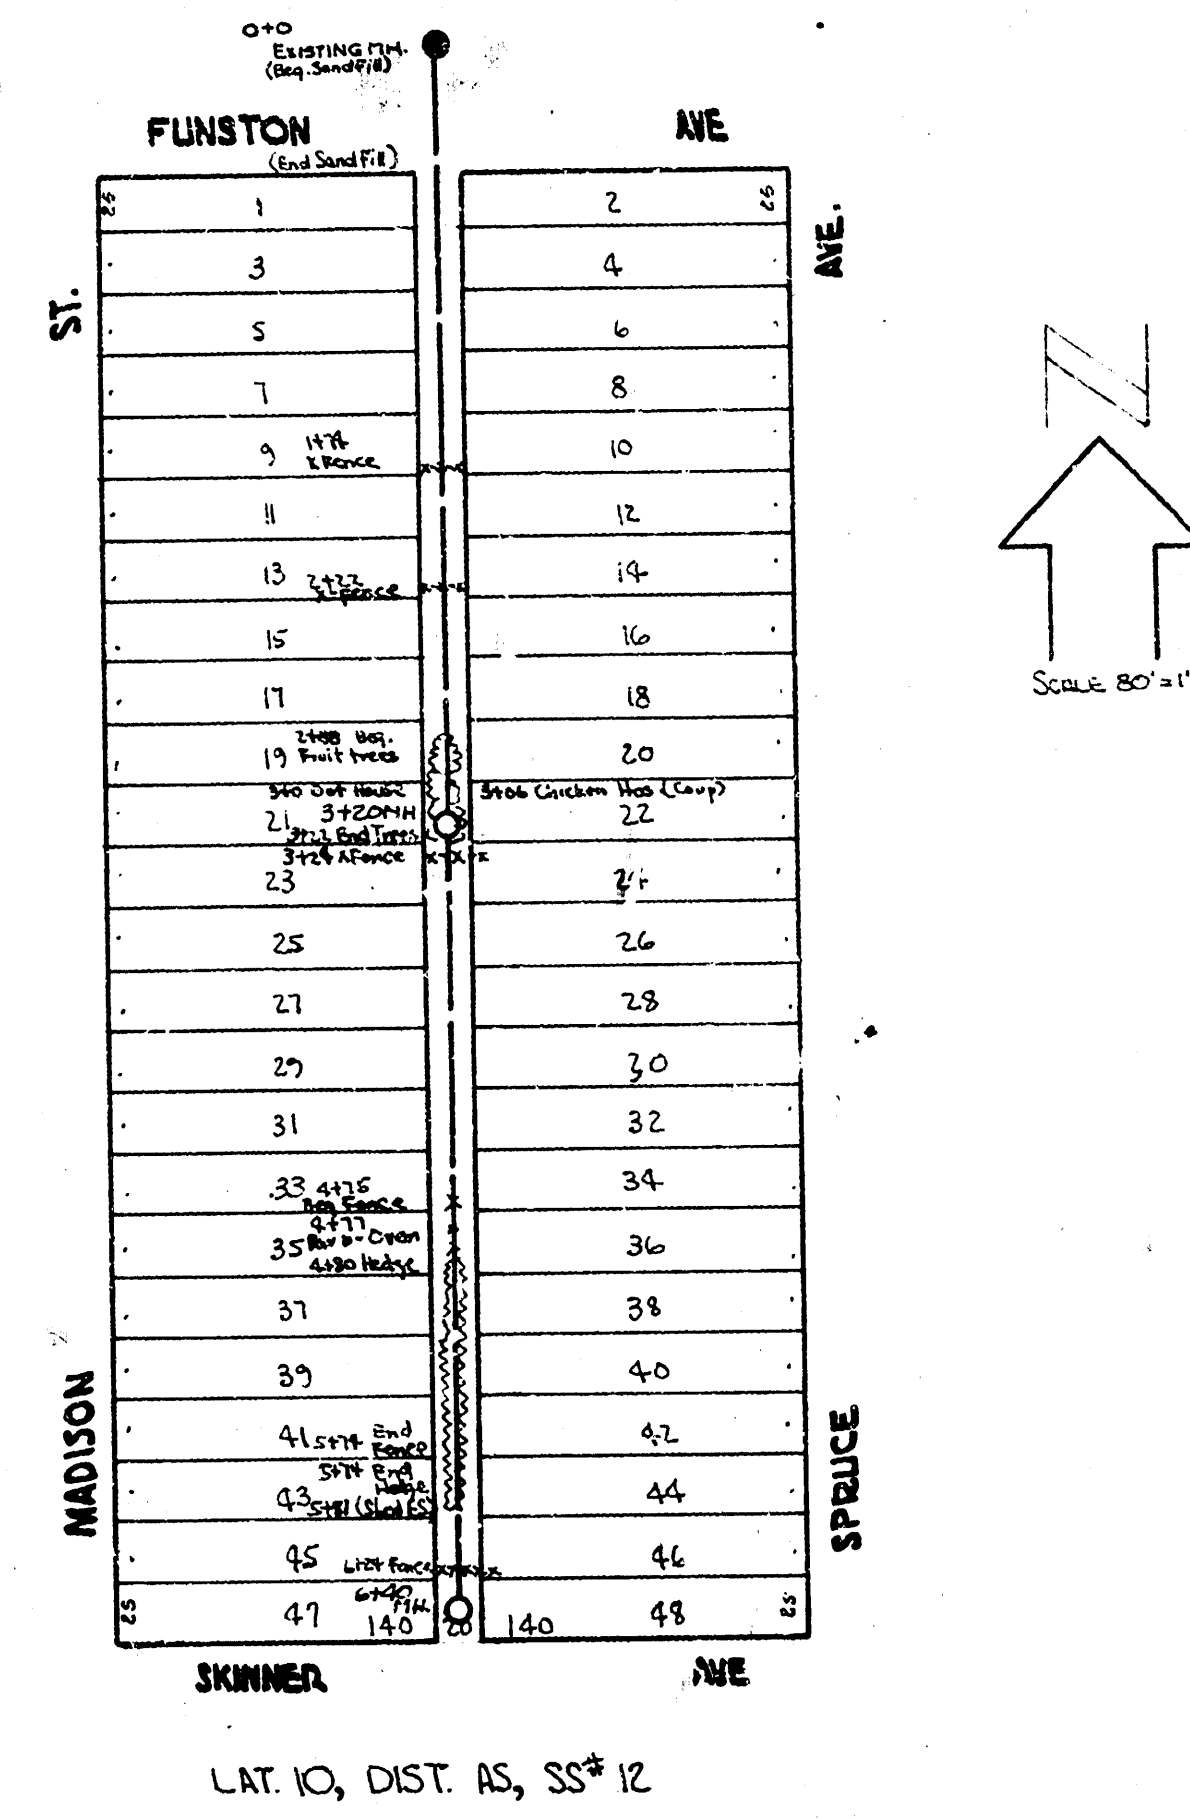


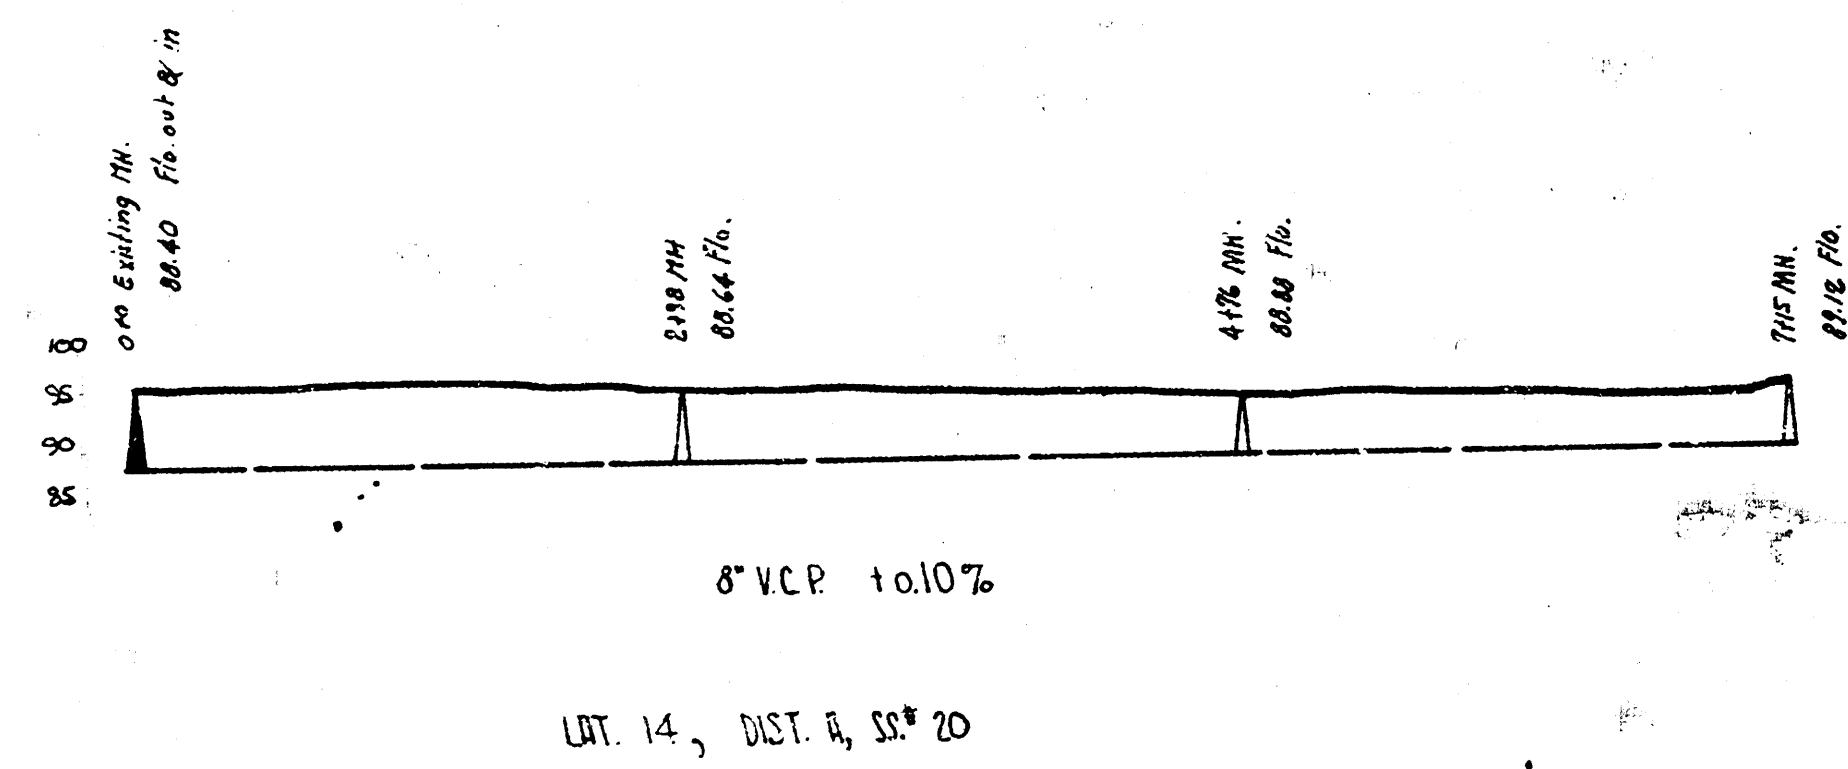



Sta. 74.50 E. Side 7.100 So. Side Scott (Siphon Time of 7.40)

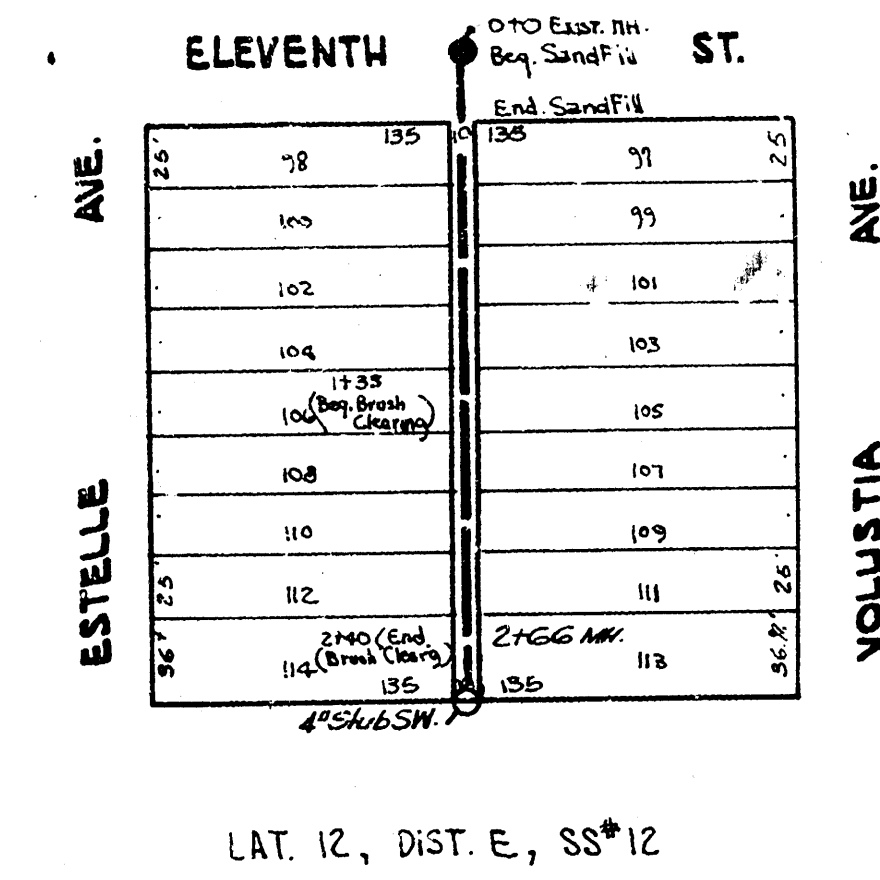


Sta. 99.25 "G" in Globe So. End. W.C.B. Spruce & Funston

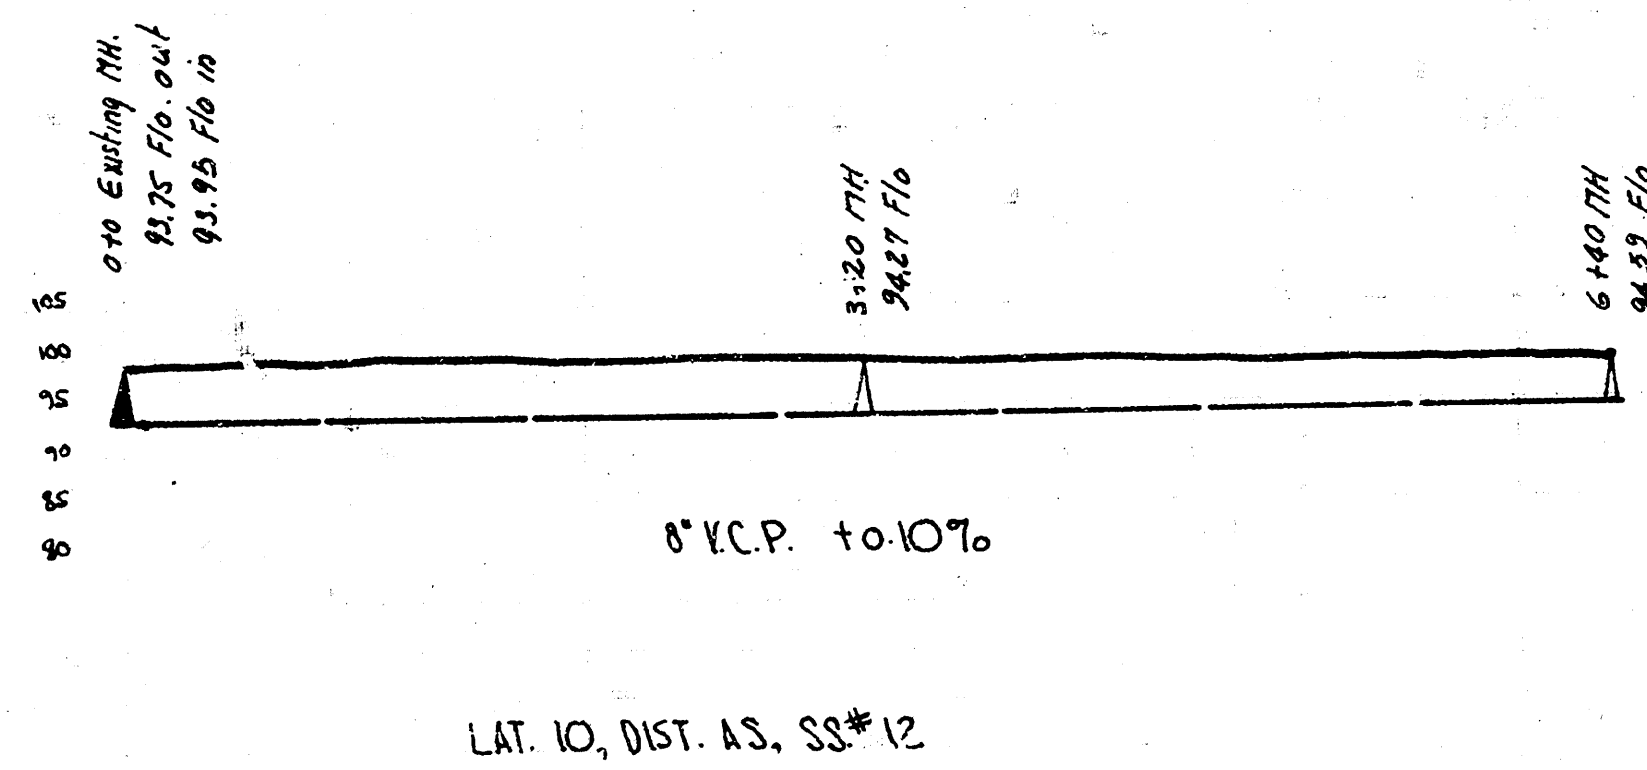

Sta. 123.11 No. Rim HH in Eleventh Street

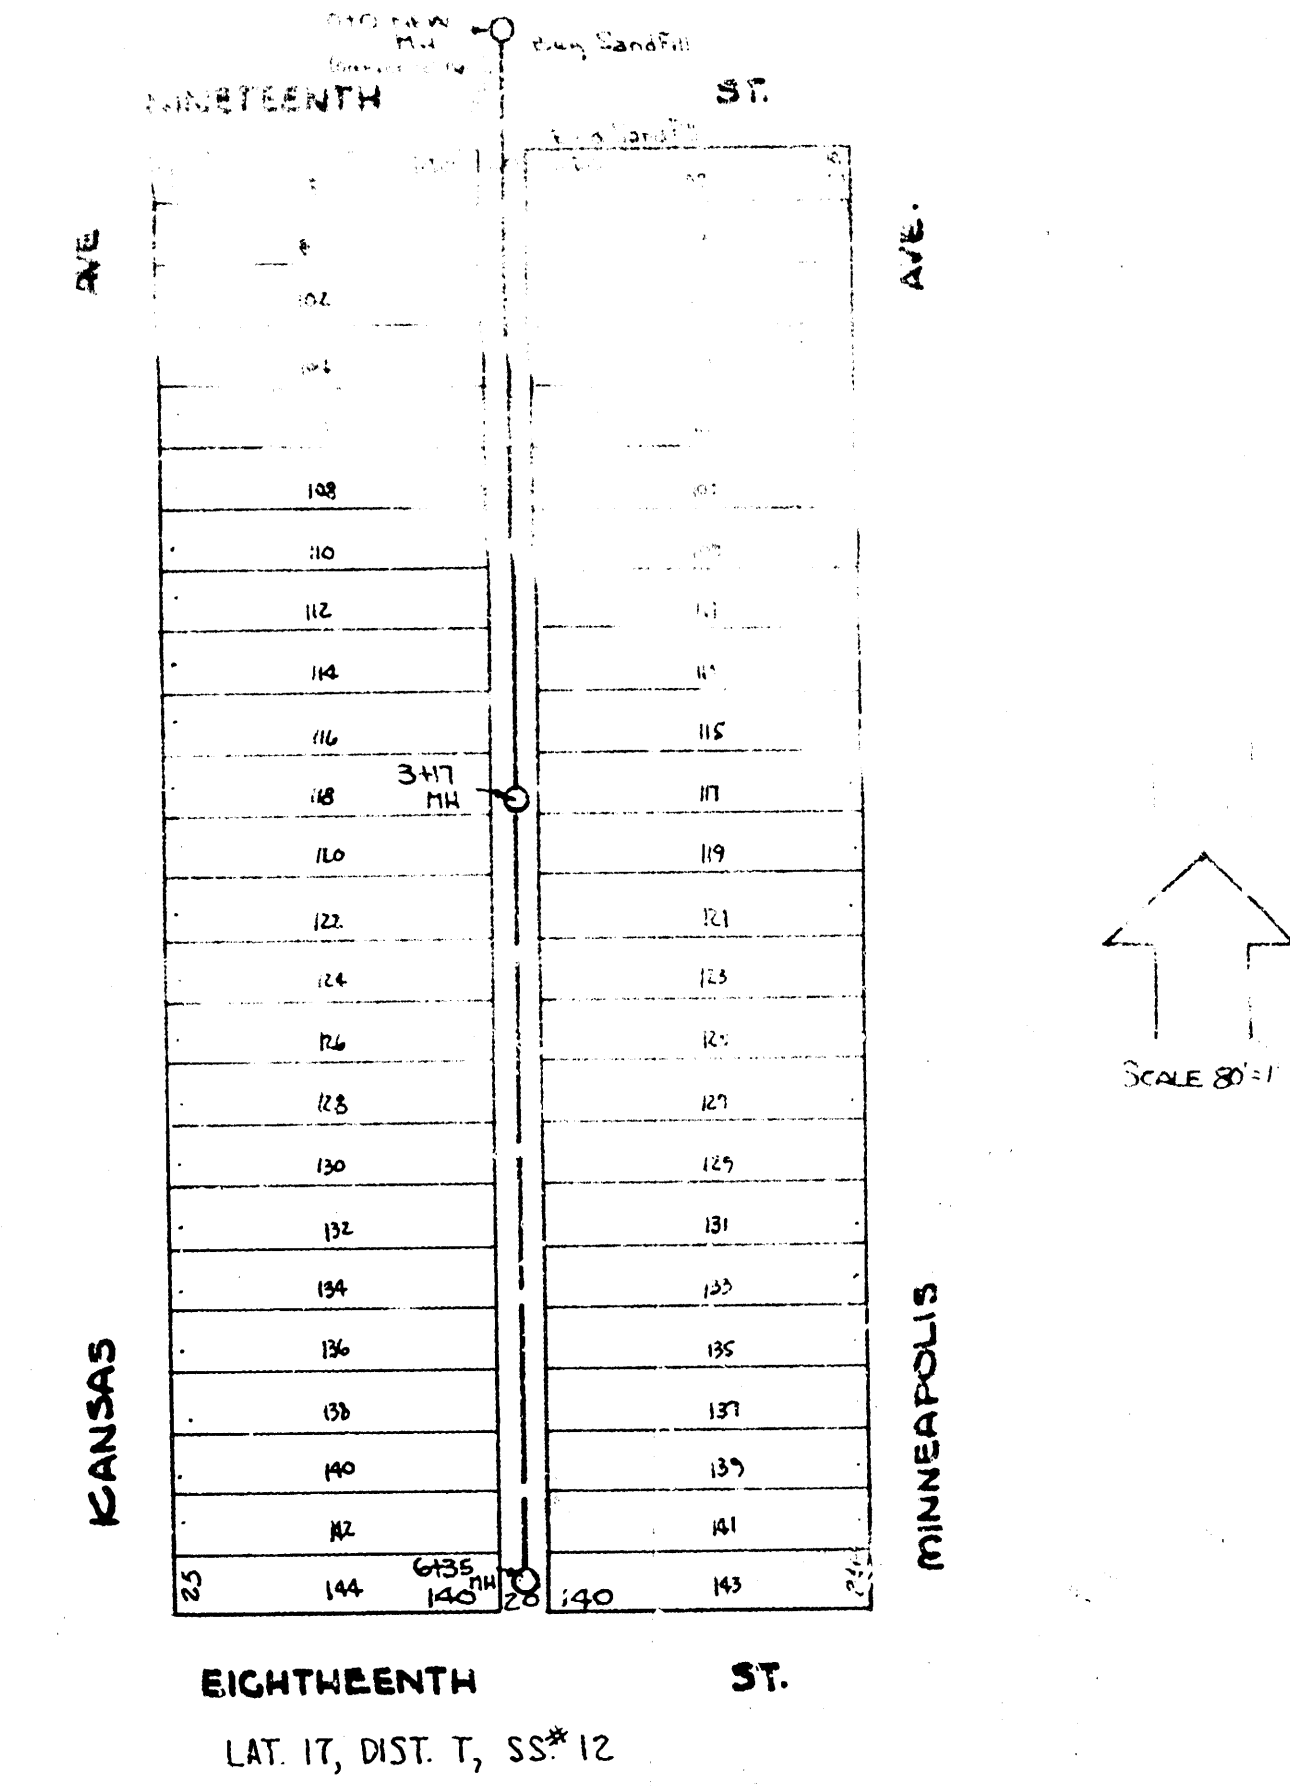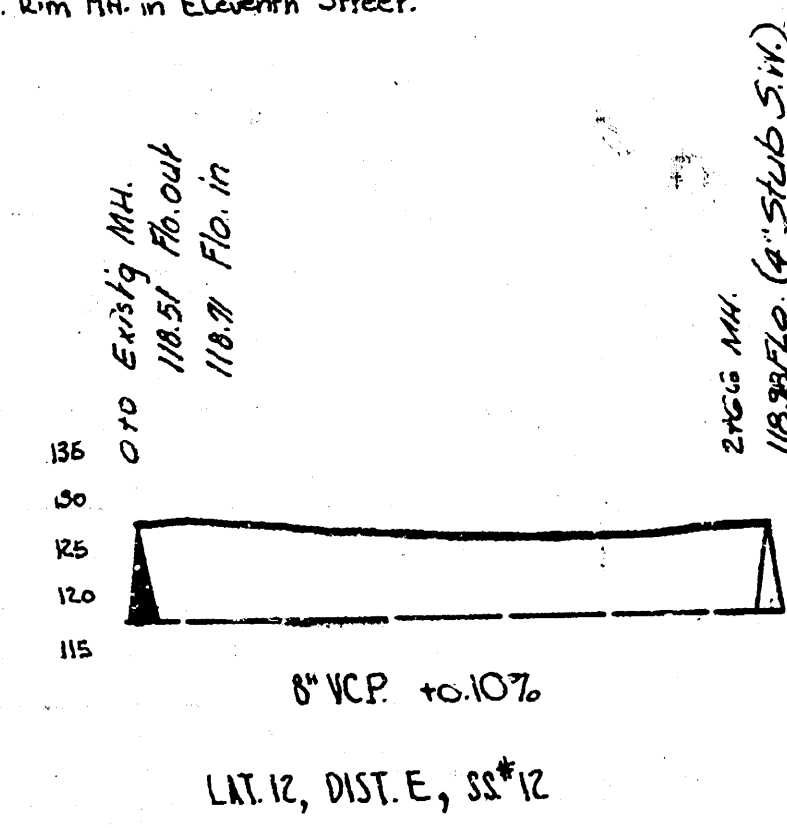

Sta. 120.23 No. Rim of So. Spindle 19th & Hydraulic

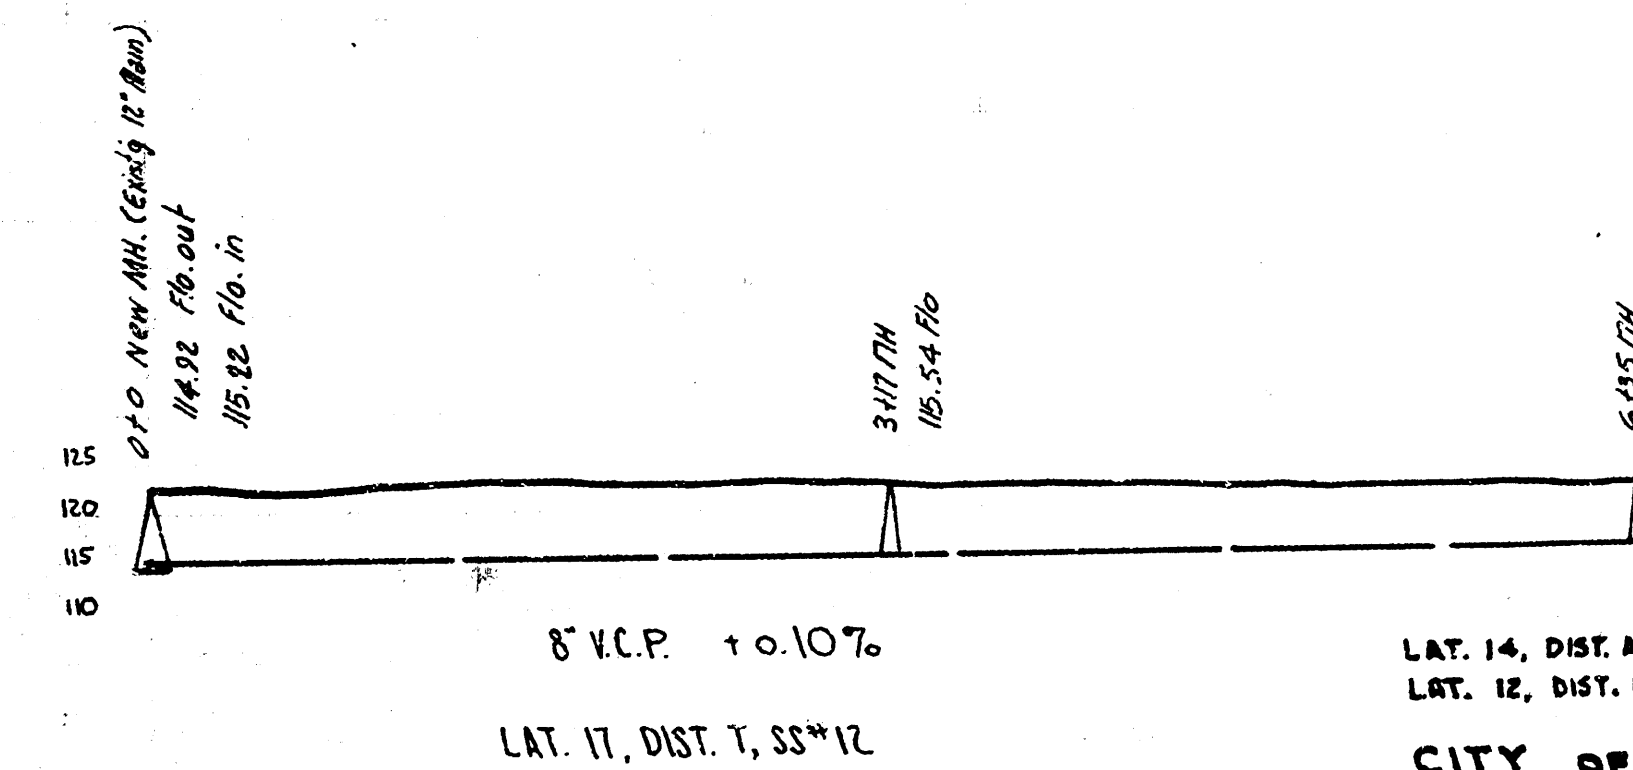

LAT. 14, DIST. A, SS# 20 — LAT. 10, DIST. AS, SS# 12
 LAT. 12, DIST. E, SS# 12 — LAT. 17, DIST. T, SS# 12
 CITY OF WICHITA, KANSAS
 L.K. WHITE - CITY ENGINEER
 1249