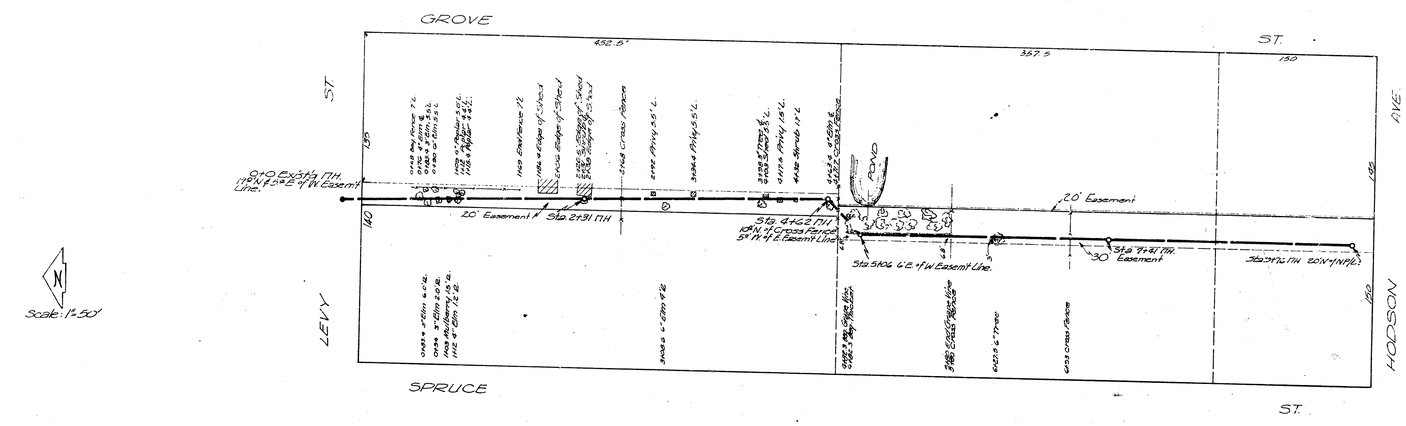
GROVE
ST.
452.6'
357.2
150
ST
AVE.
HOLSON
LEVY
SPRUCE
ST.
ROAD
20' Easement
30' Easement
Sta. 2+91 MH
Sta. 4+62 MH
Sta. 5+06 6.2' f.w. Easement Line.
Sta. 7+41 MH
Easement
20 N.W.P.
Scale: 1"=50'

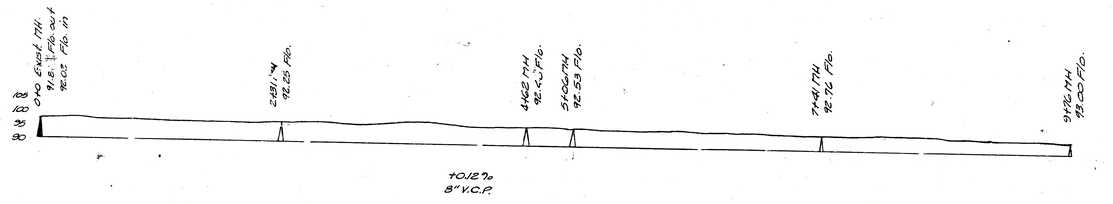

"SEWER PROFILED TO EXAGGERATED SCALE HORIZONTALLY"

LAT. 11, DIST. A.S., SS#12
City of Wichita, Kansas
L.K. White ~ City Engineer
Date: 2-24-50 Proj. No. C29-58