



B.M. 11203 H in east Hurst str. at wt N.E. cor Platt & Central.

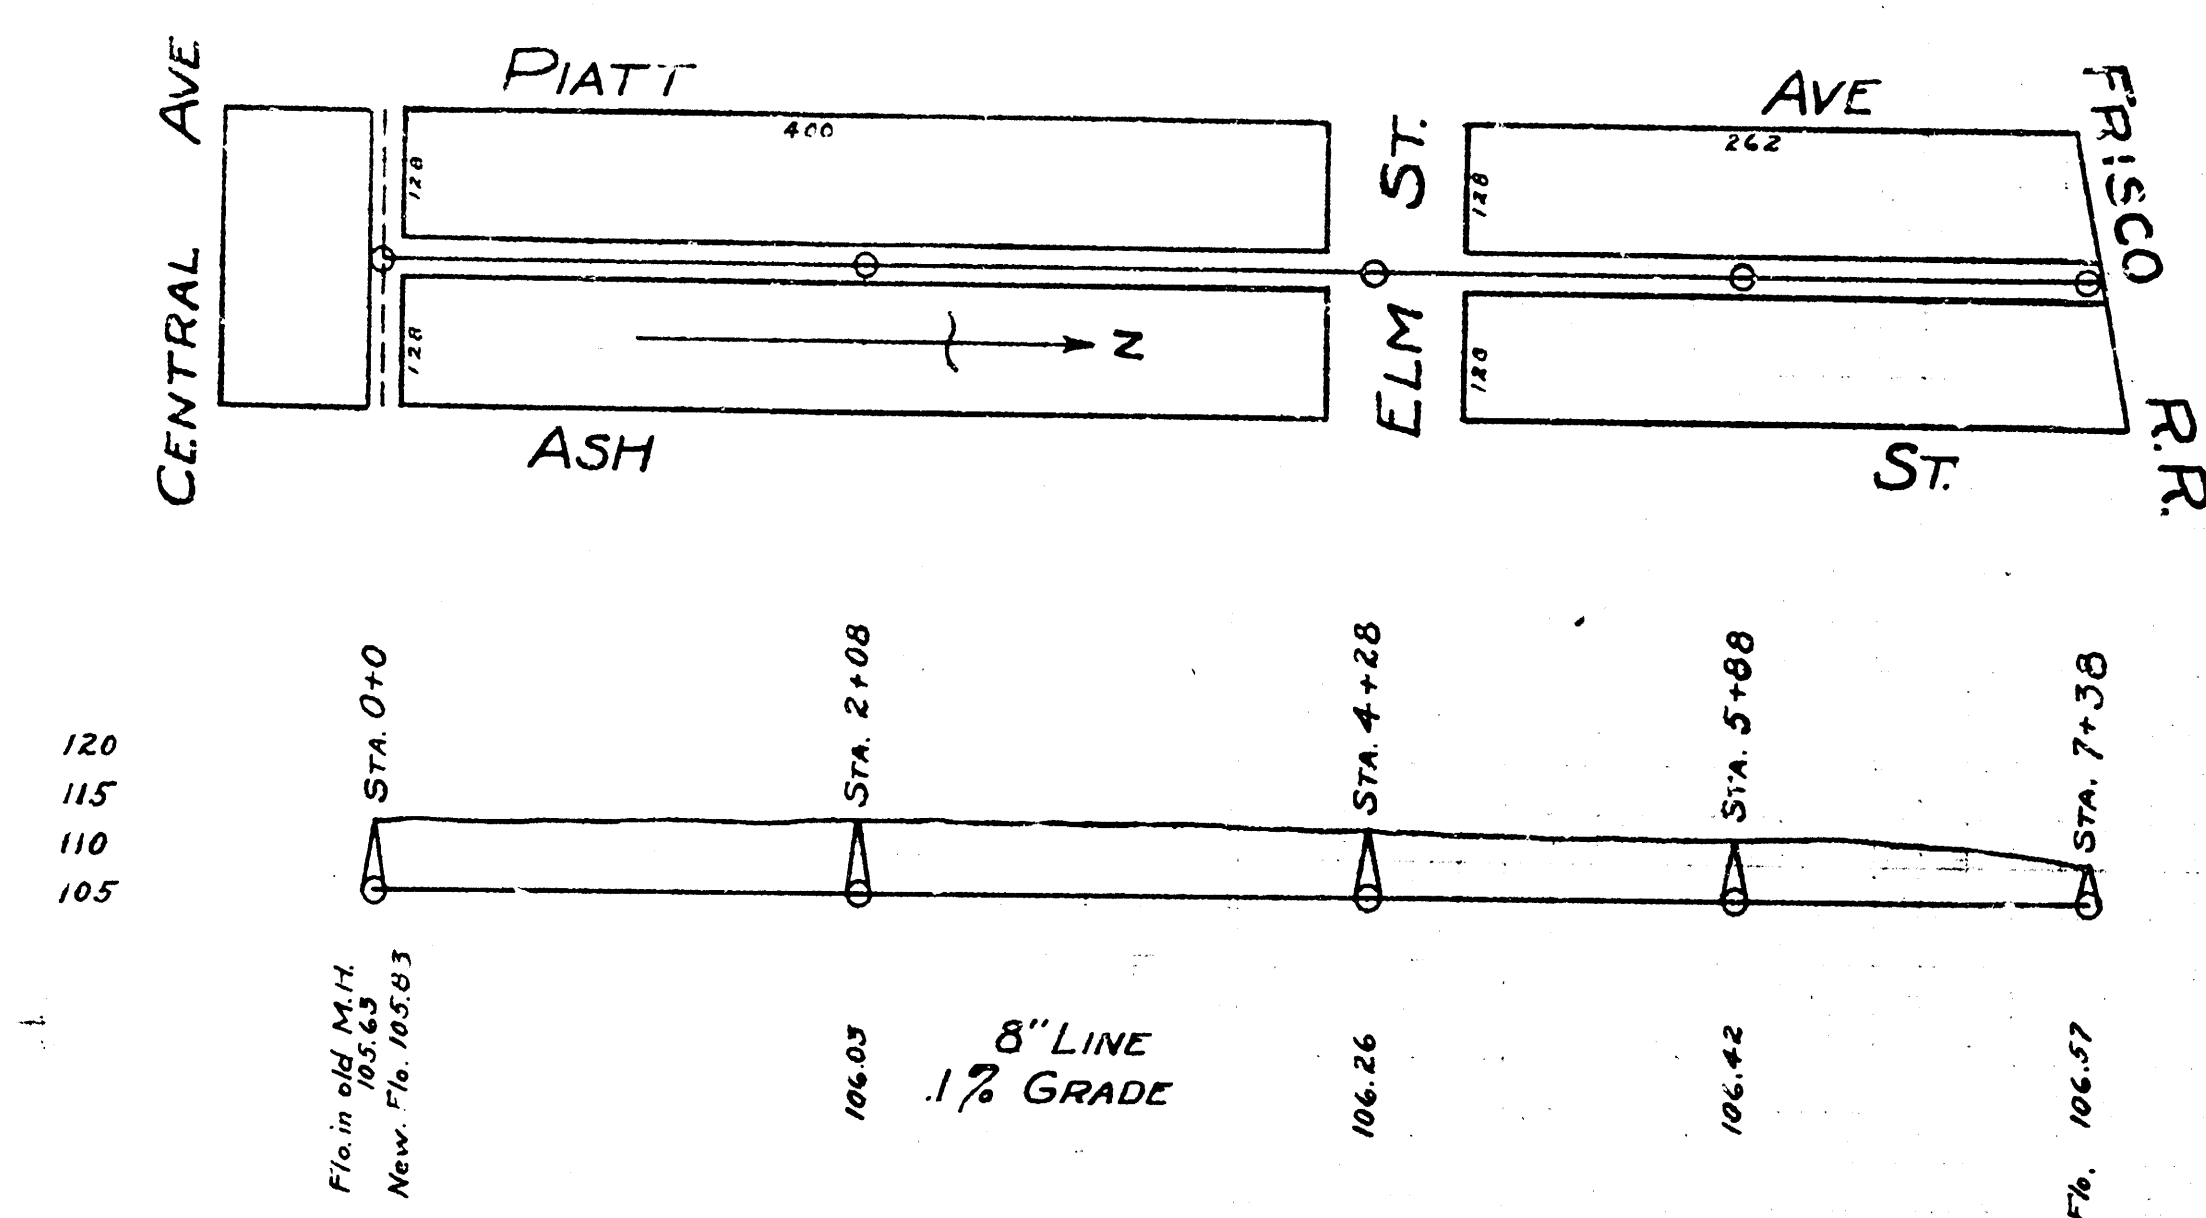


LAT. 0 ~ DIST. D
S.S. No. 12

B.M. 14221 K in Kensler bk. of wt. N.W. cor Elm & Lorraine.
133.91 Property iron N.E. cor Elm & Chautauqua.

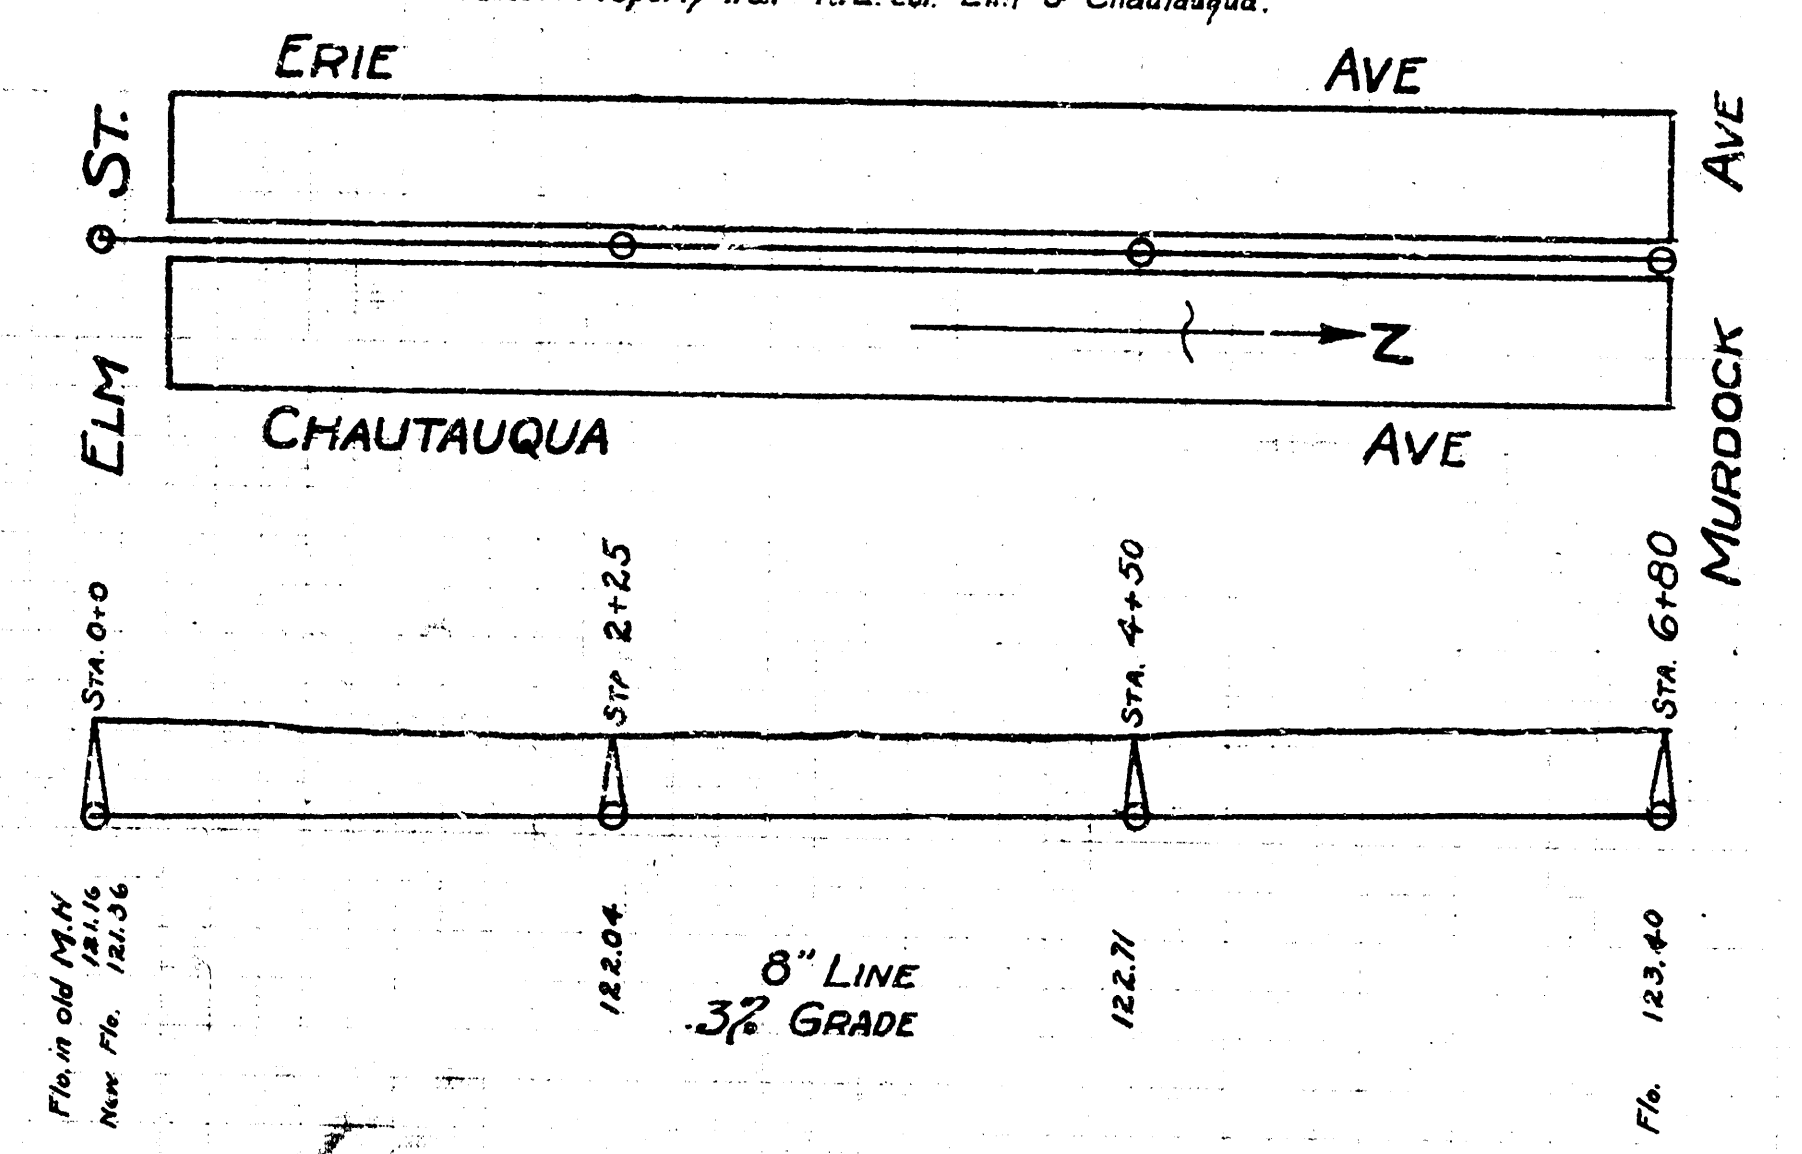

LAT. P ~ DIST. D
S.S. No. 12

B.M. 10226 Std. S.E. cor Washington & Harry.

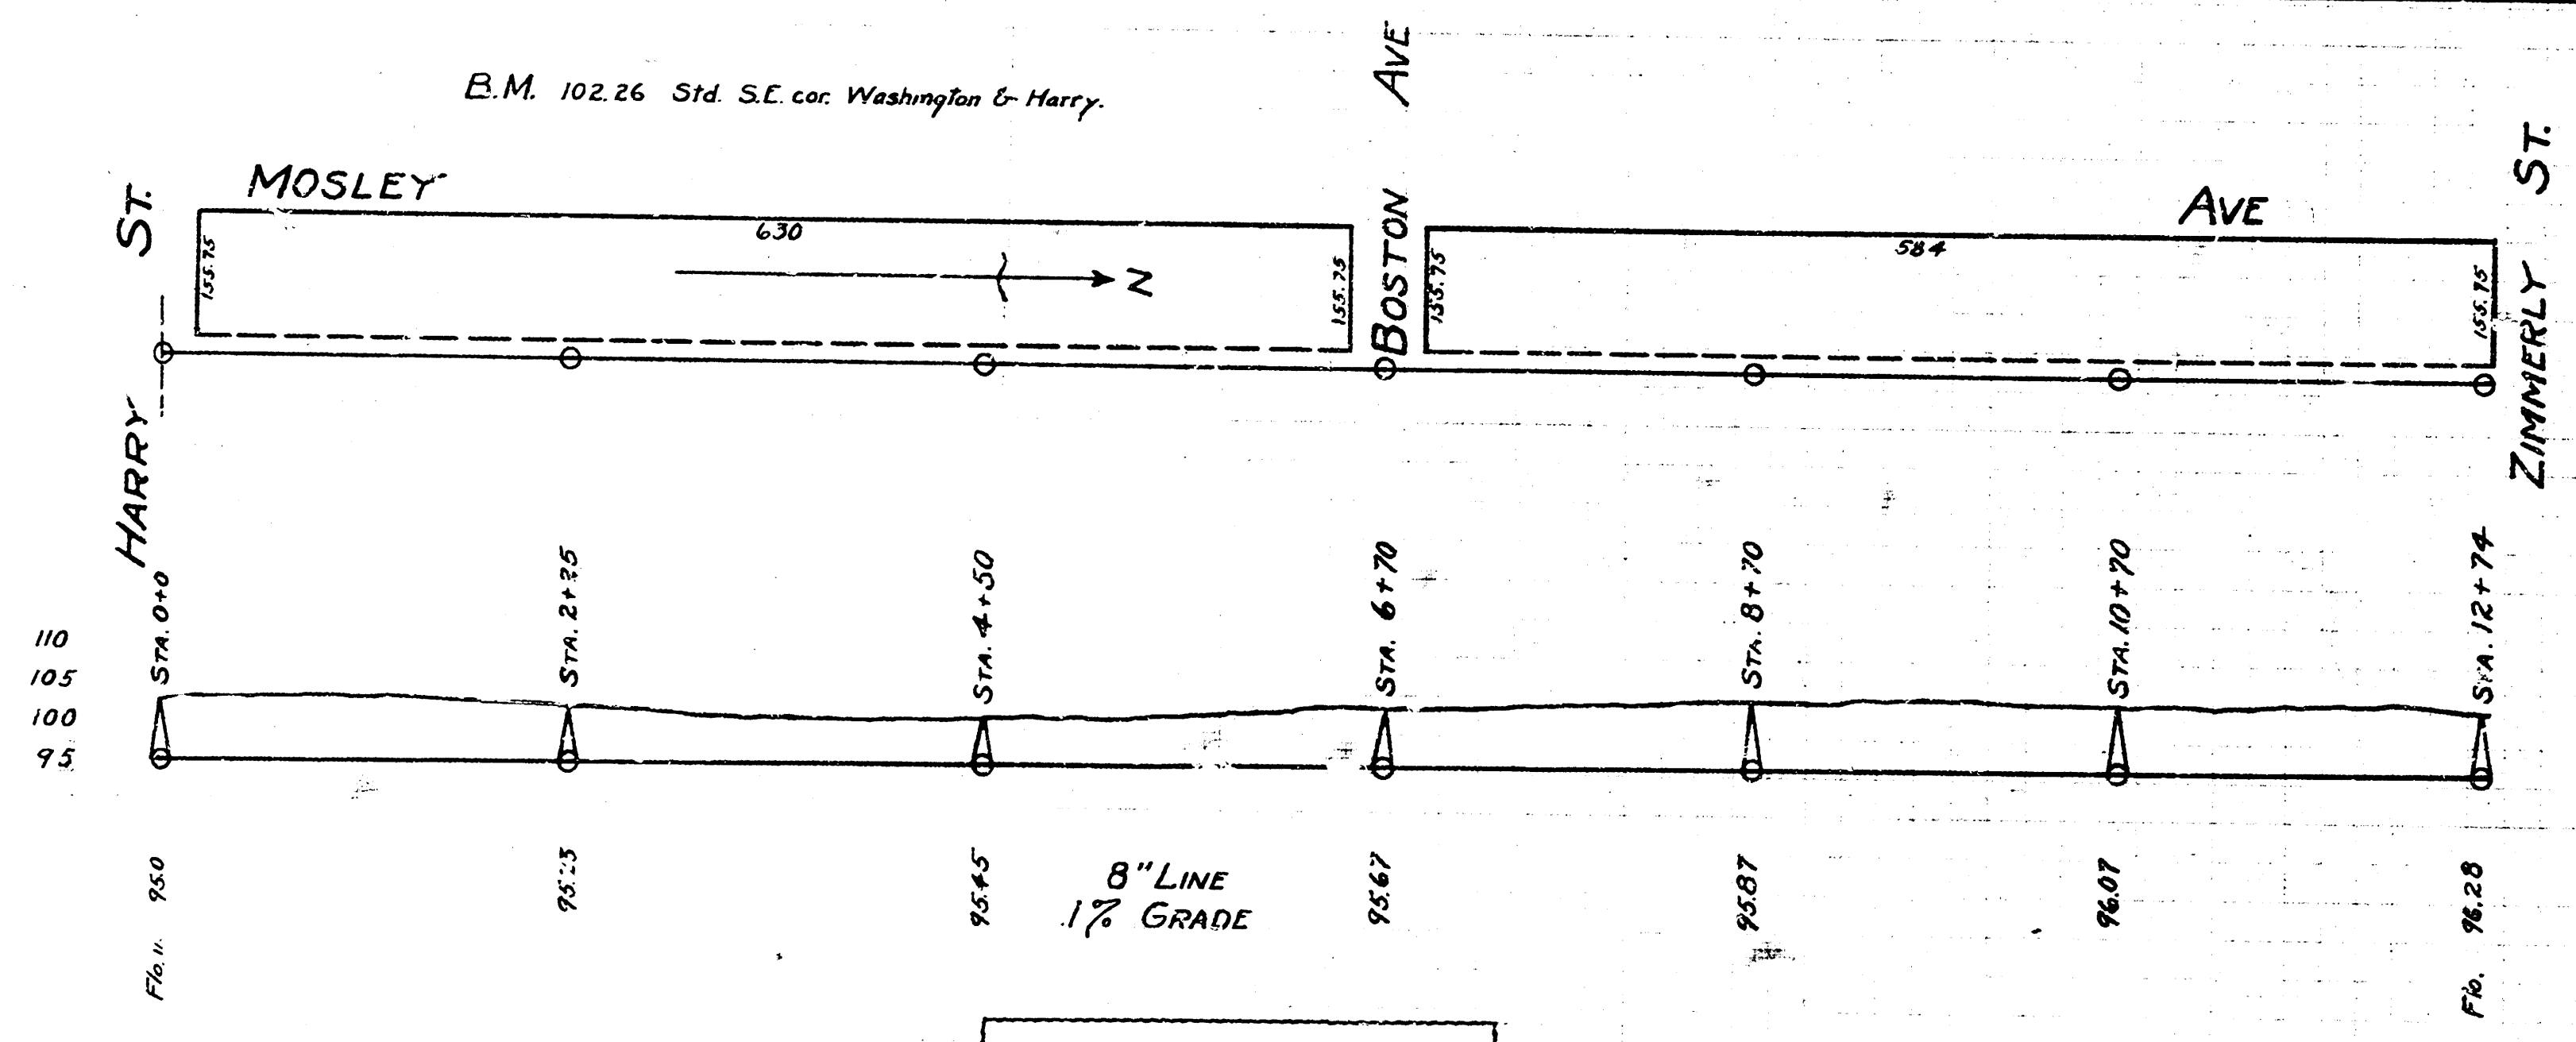

LAT. 5 ~ S.S. No. 1