

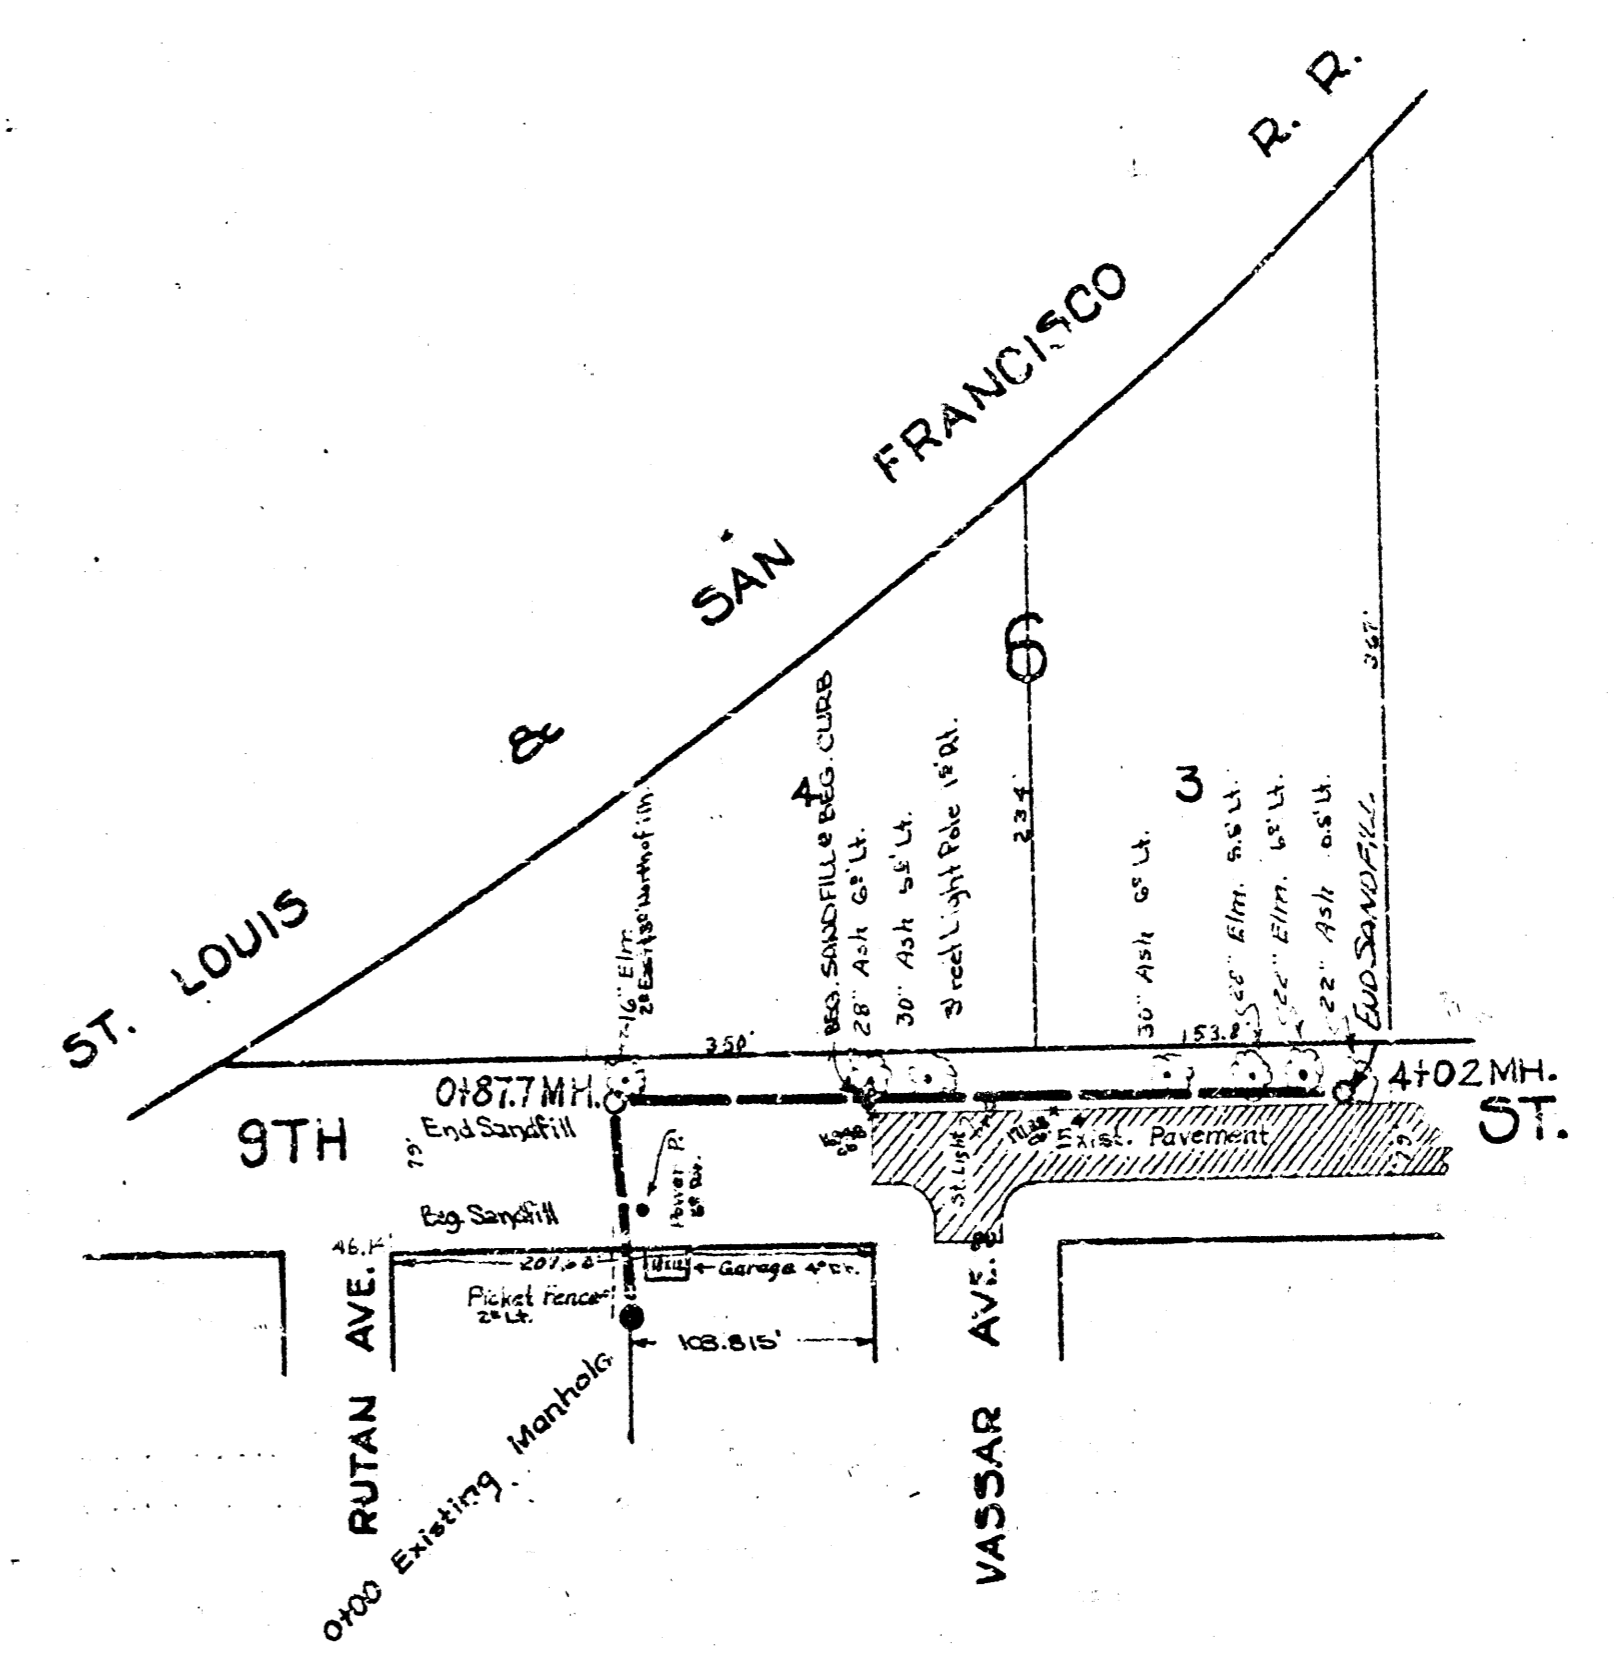


B.M. 128.16 80' Spike N.S. K.G.E. Pole S.L. Detwiller -150' E. of E.L. Kansas.

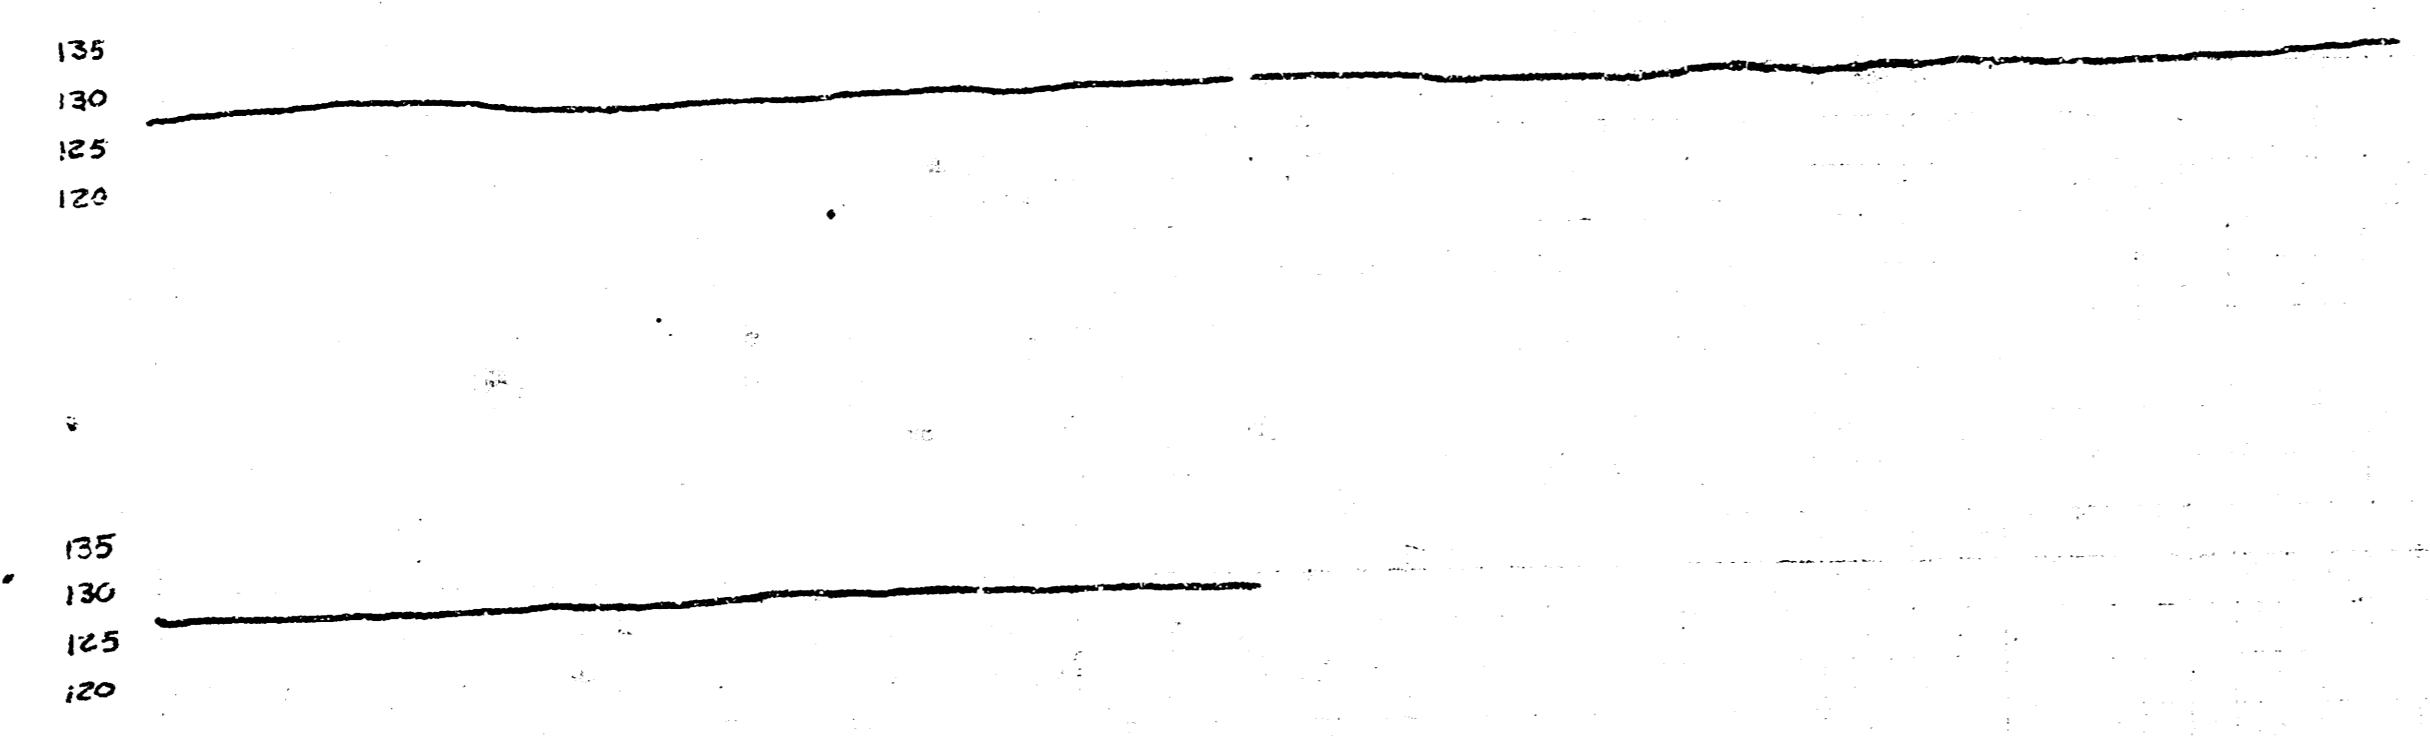

S.M. 166.82 N. Rim MH. 0+0 Bet. Vassar & Rutan.
B.M. 176.19 'G' in Globe W. Lug of Drive Ho. # 3421 E. 9th.

LAT. 13, DIST. D, SS # 12
PROJECT NO. C-20-11

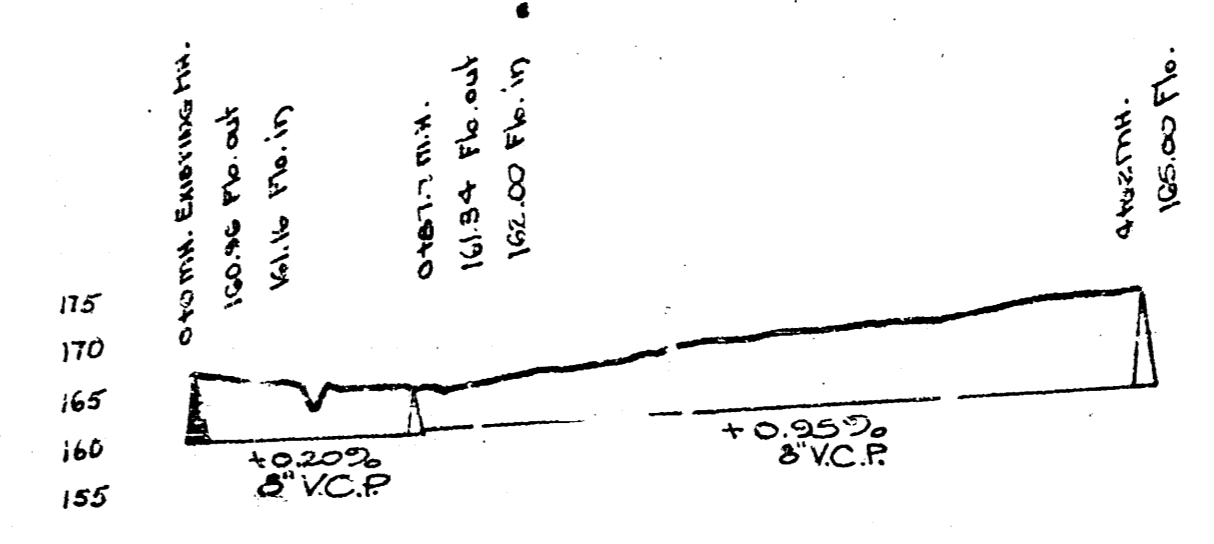

LAT. 13, DIST. D, SS # 12
CITY OF WICHITA, KANSAS
L.R. WHITE CITY ENGINEER
PROJECT NO. C-20-11