

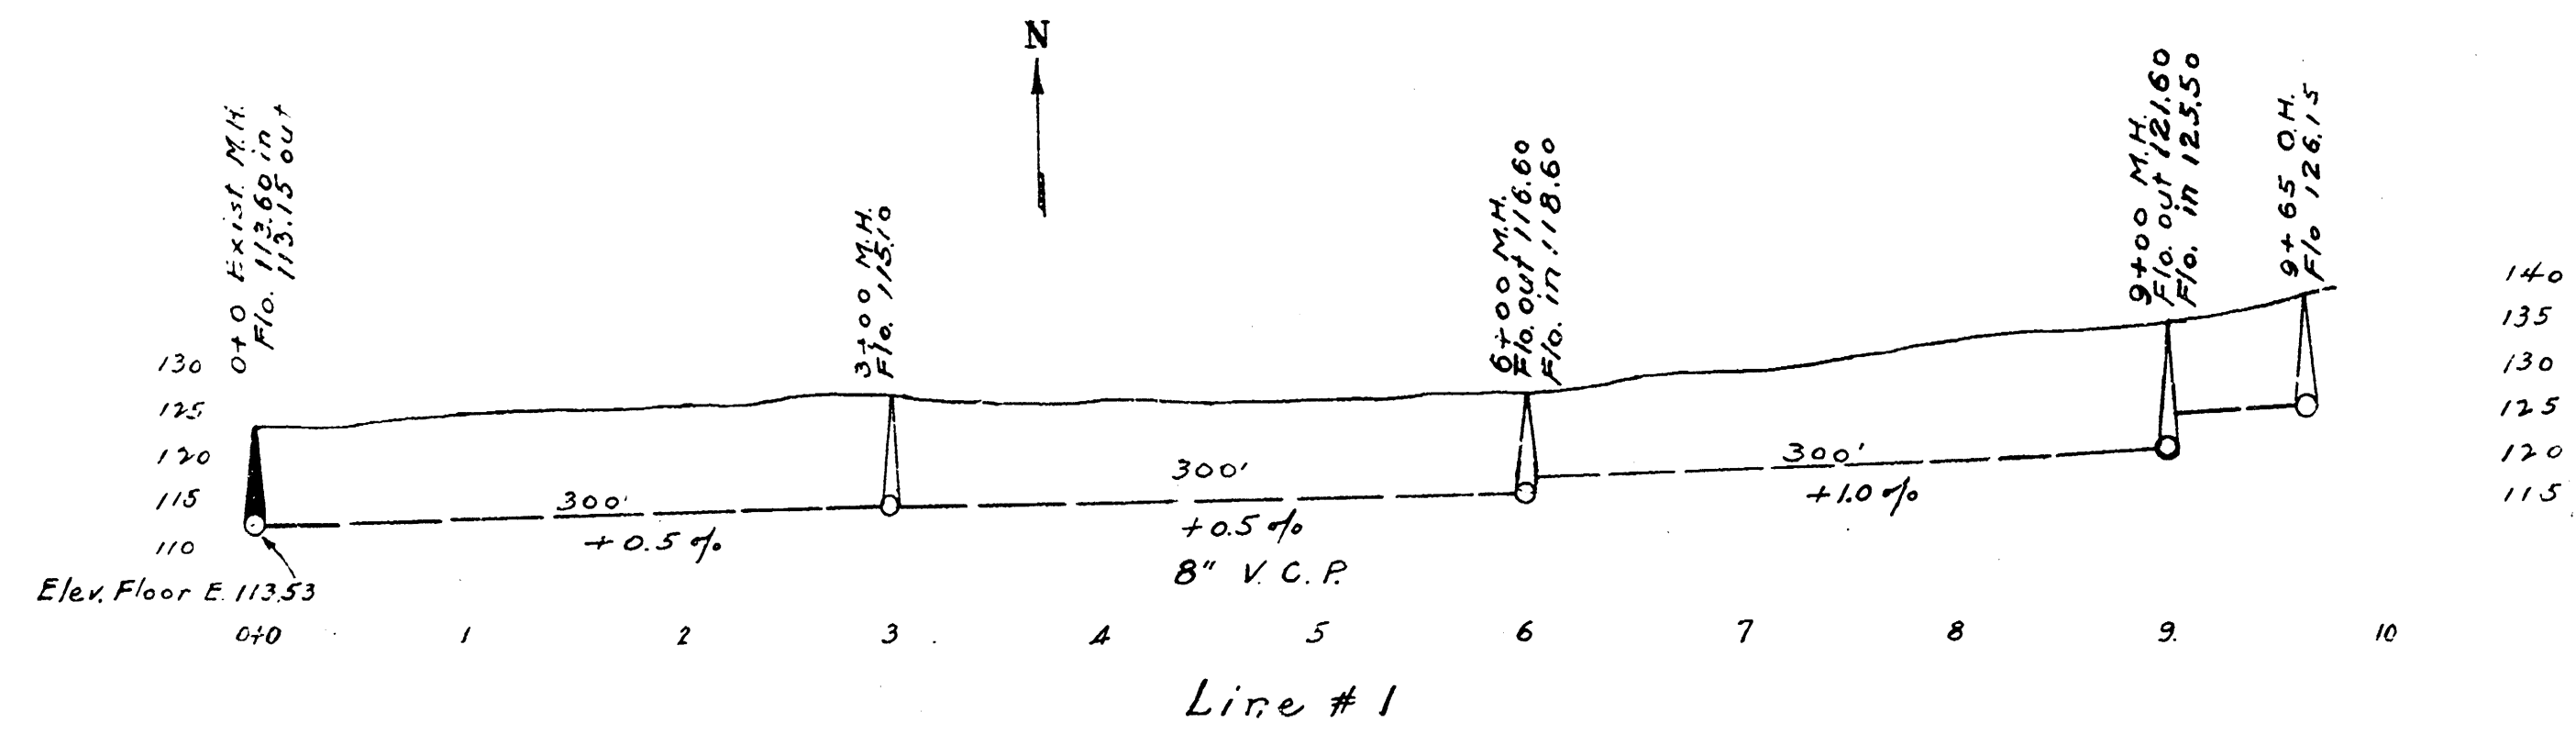
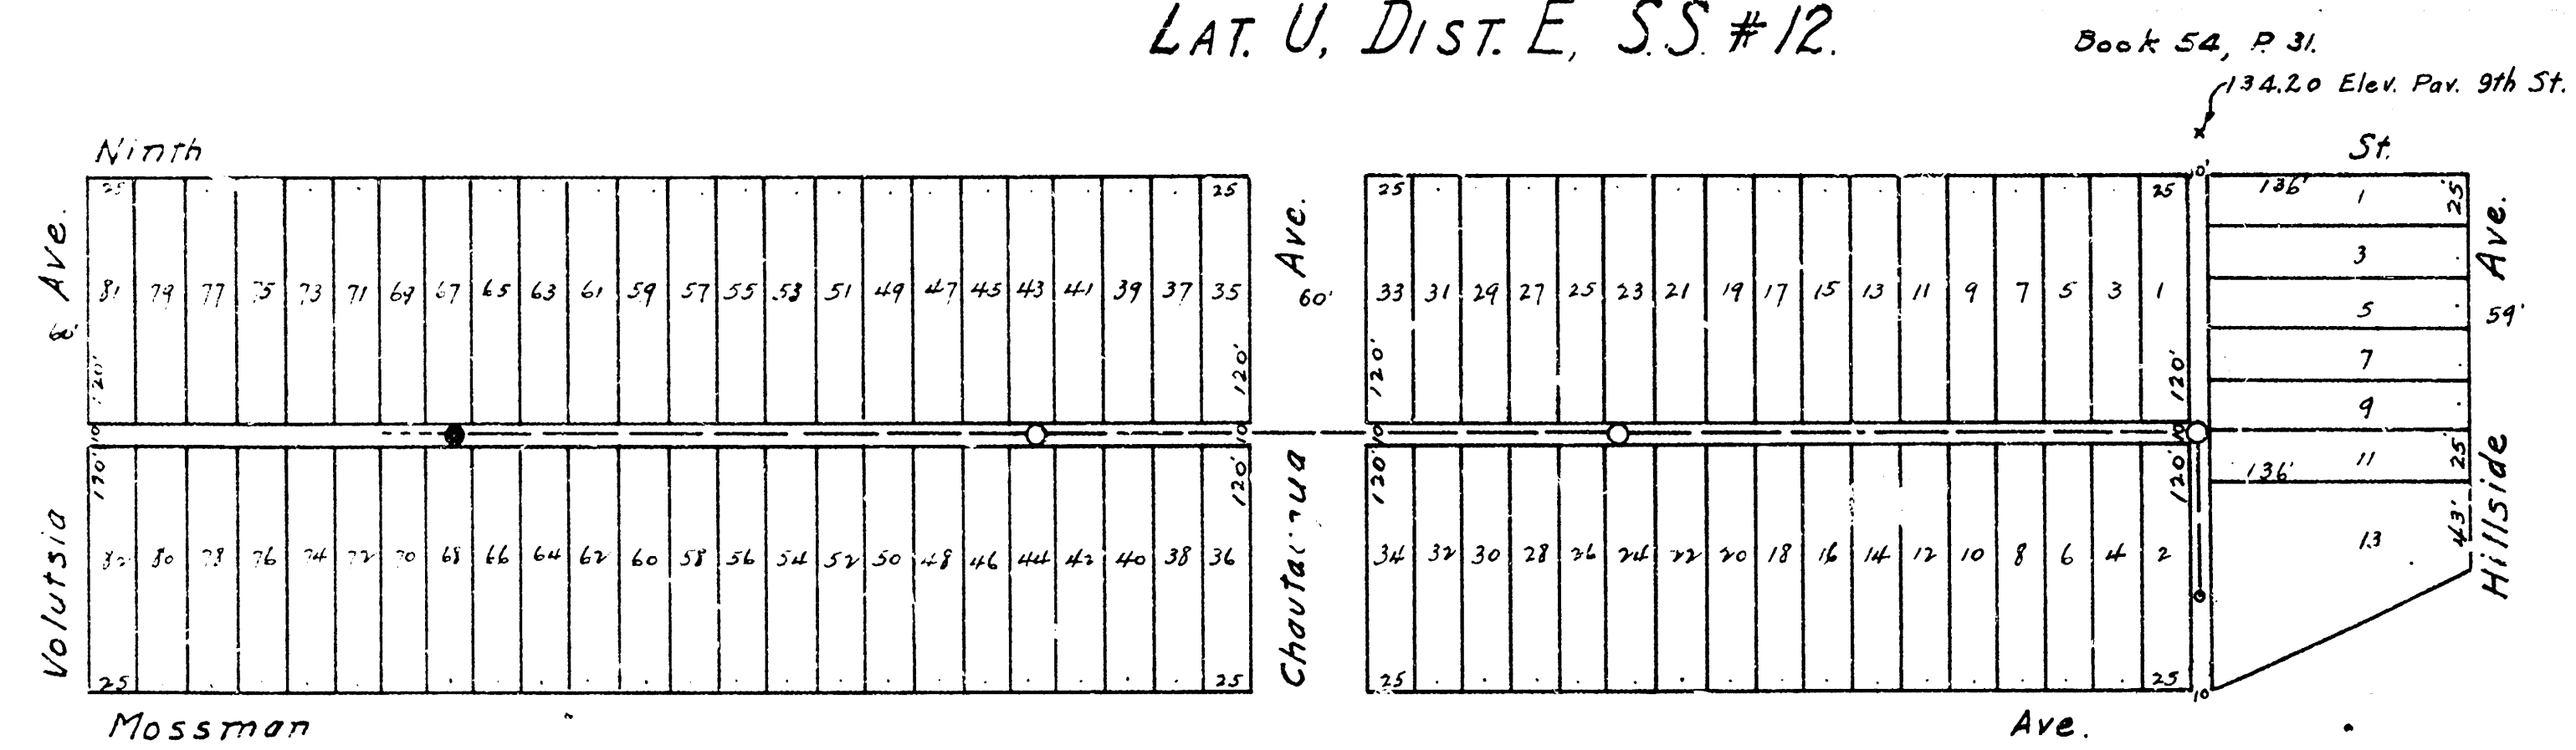


LAT. U, DIST. E, SS #12.

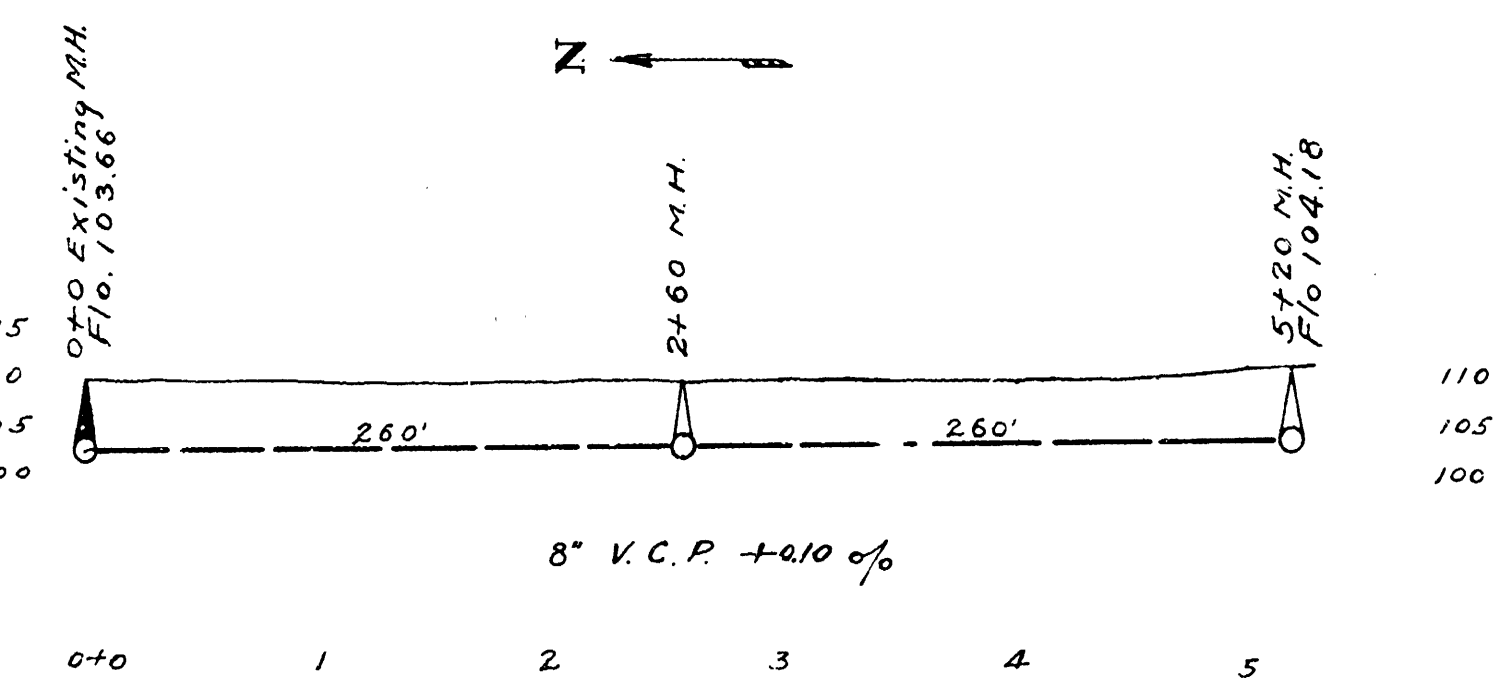


B.M. 122.96 Top of thimble at 9th & SW entrance to Cemetery.
B.M. 136.60 N.W. cor. W. N.S. Ho. #3024 Mossman.

LAT. 20, SS #20

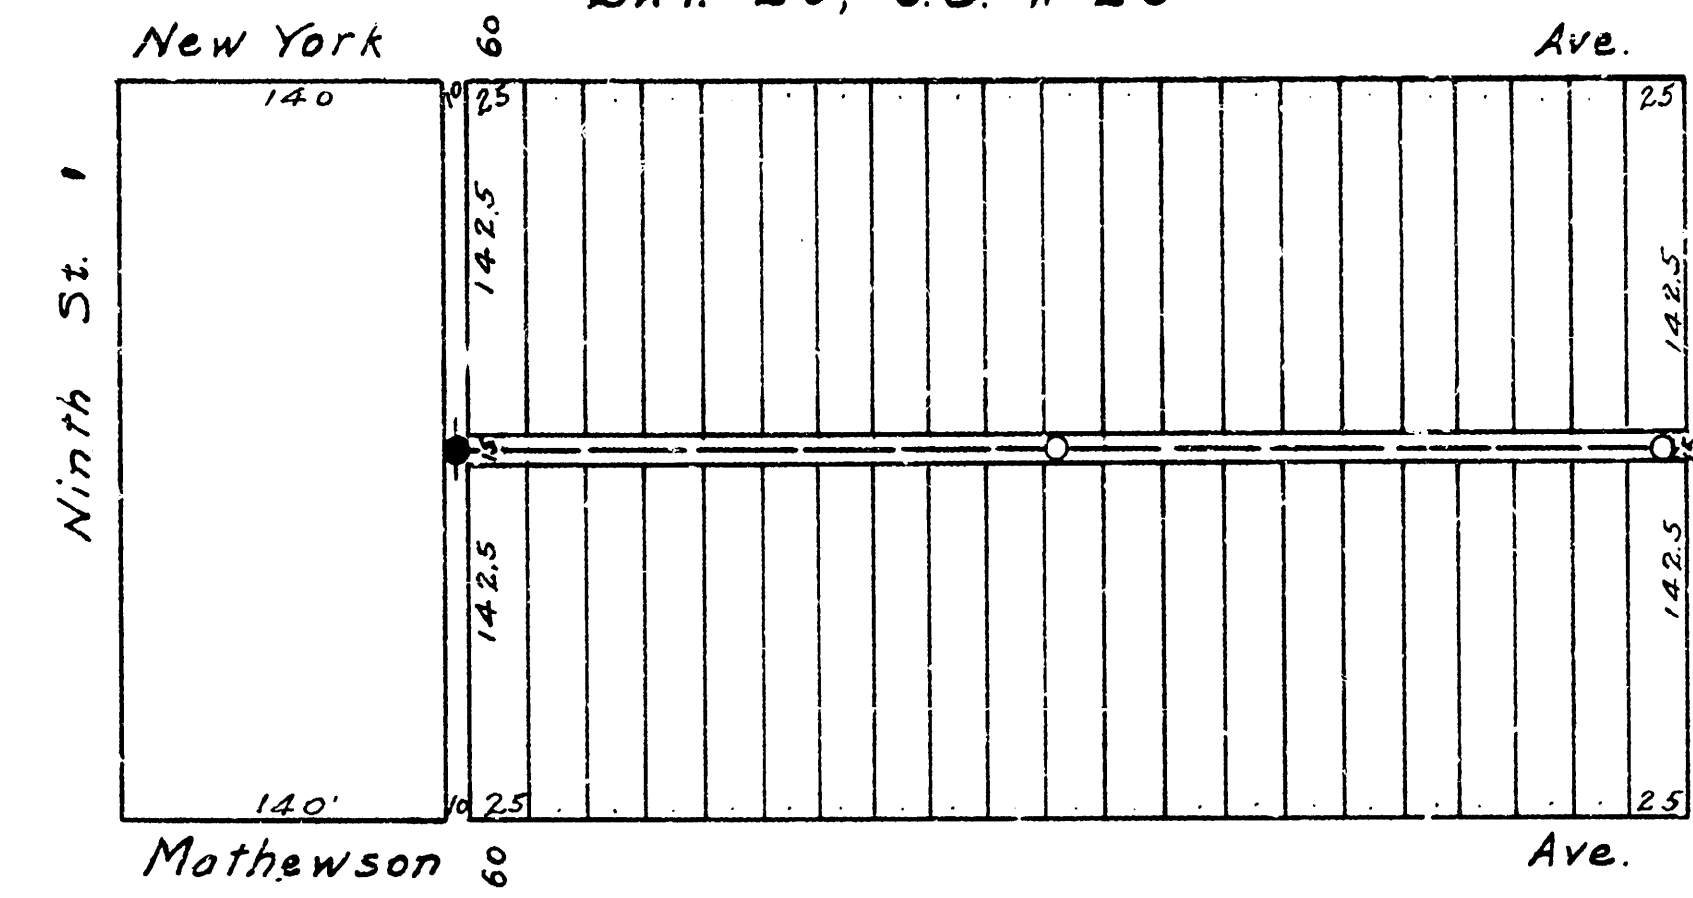

B.M. 112.31 8" in Bunkeridge on curb W.S. Alley N
Lat. New York & Mathewson N.S. 9th St.

LAT. X, DIST. R, SS #20

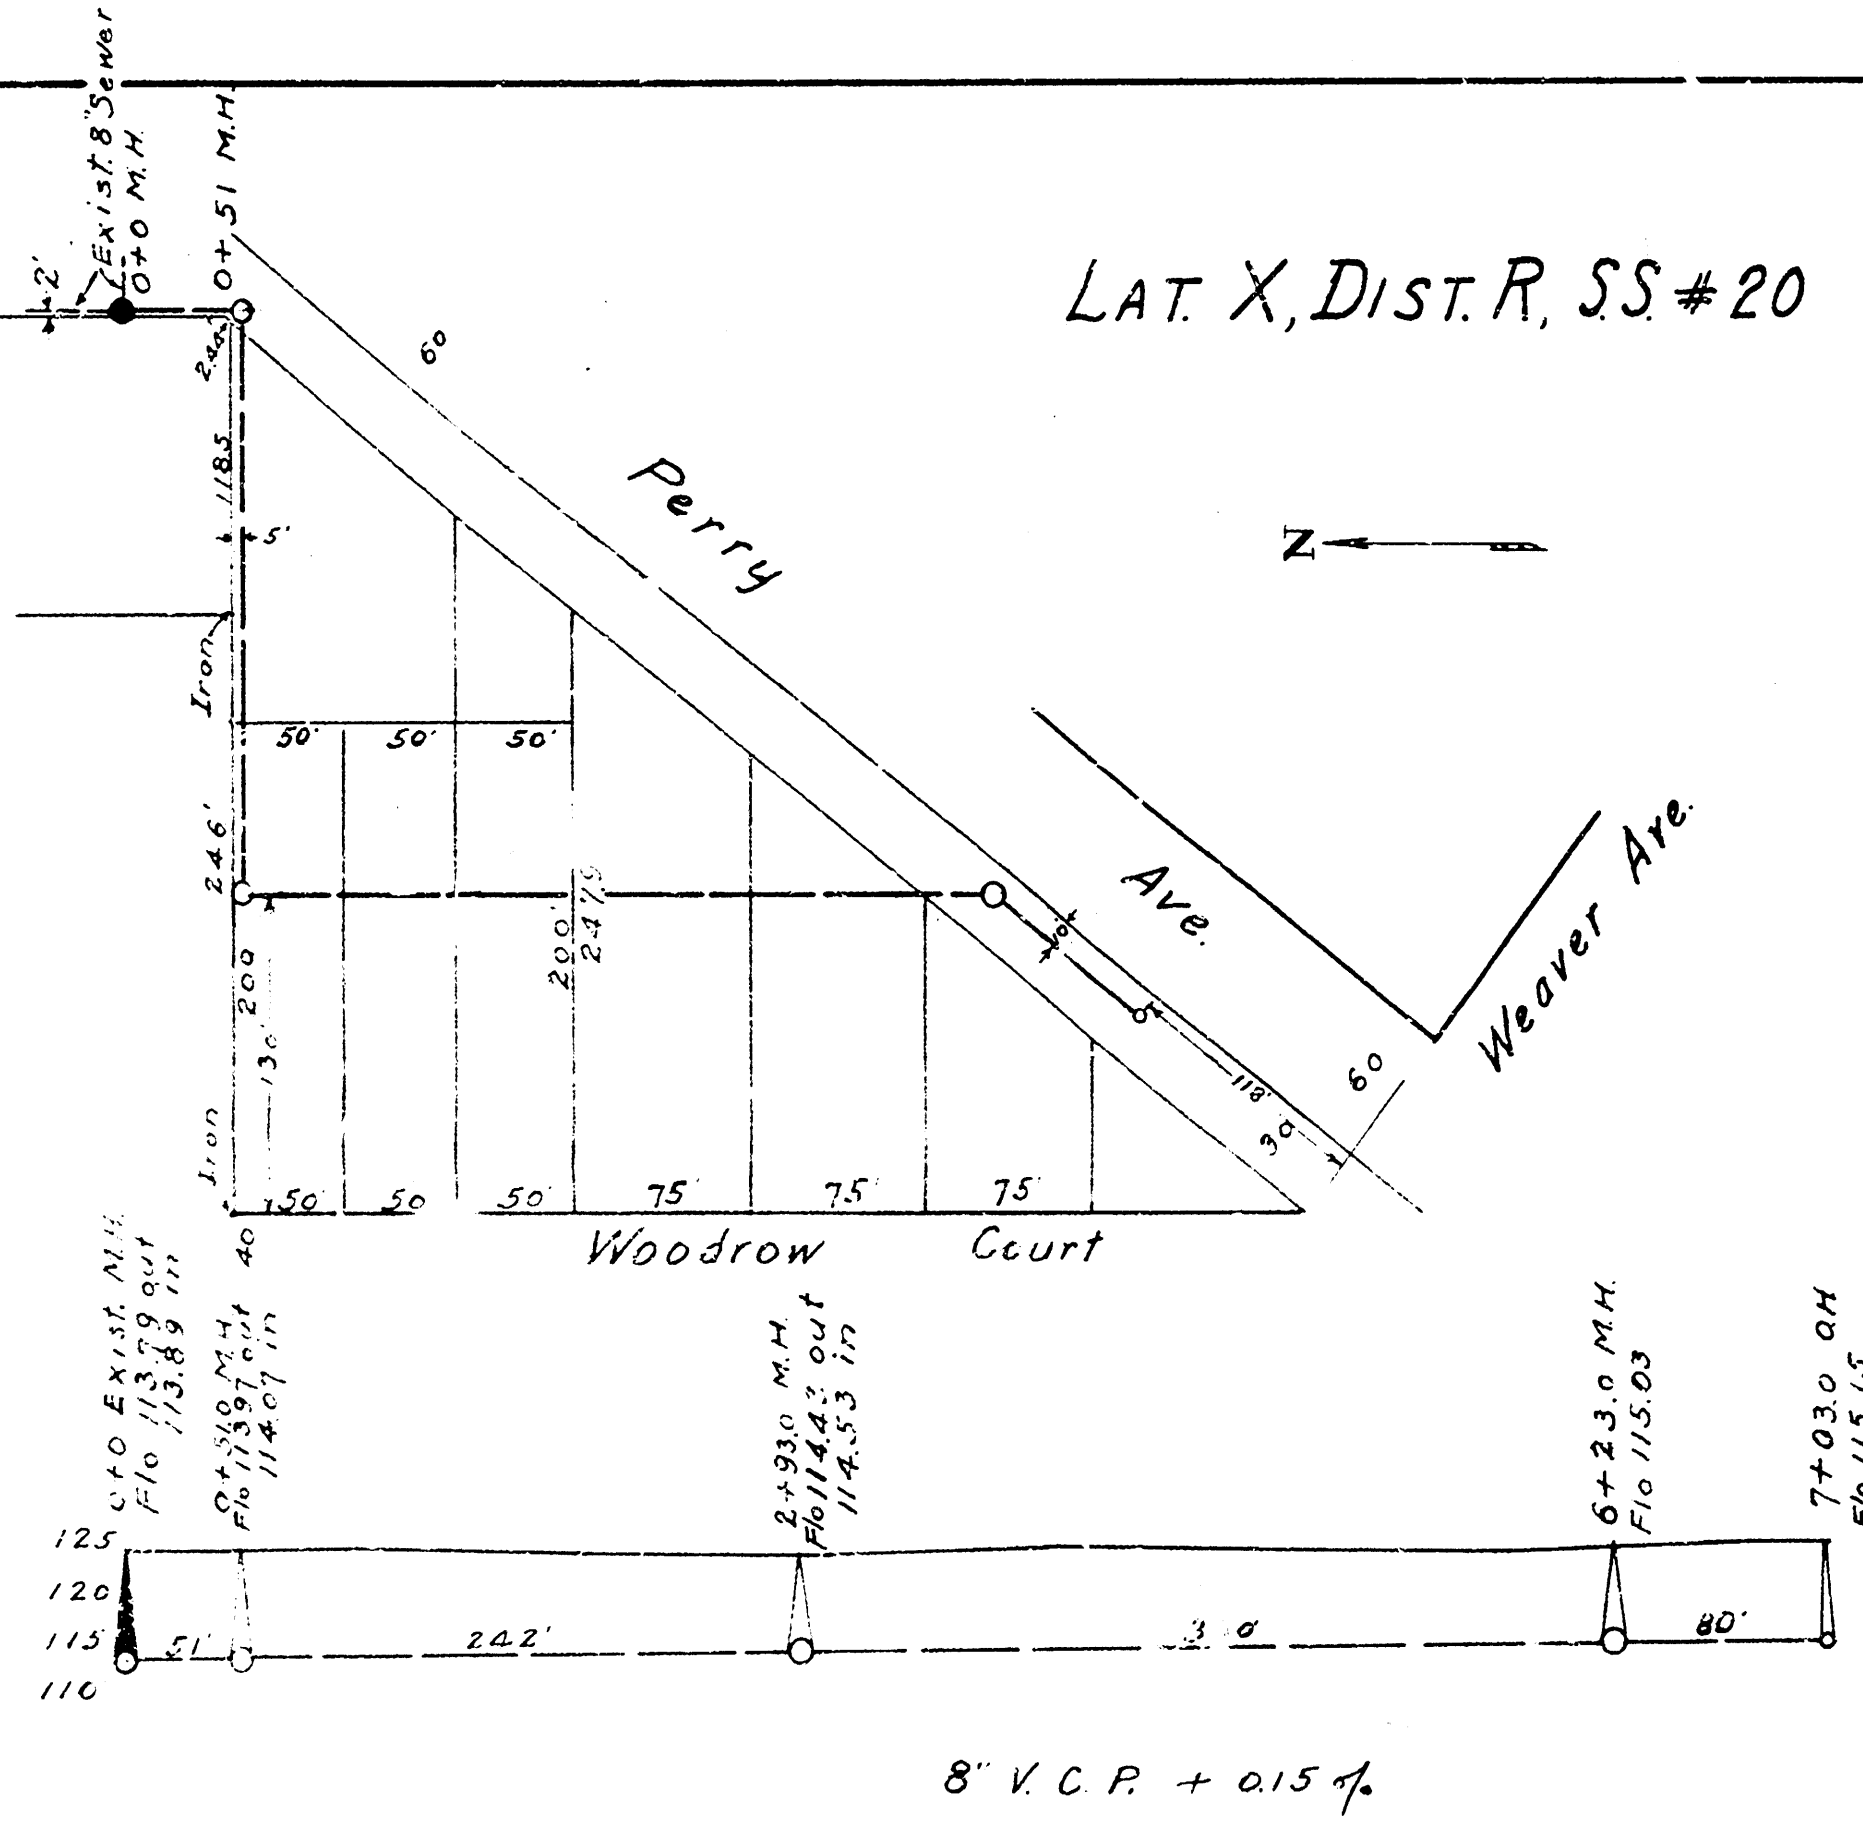

B.M. 123.27 S. cb. 14th, E.L. Perry

ENGINEERING DEPARTMENT
CITY OF WICHITA, KANSAS
L.K. WHITE, CITY ENGINEER.
FEB. 1945. CHMILLS.