




LAT X DIST E. S.S.#12

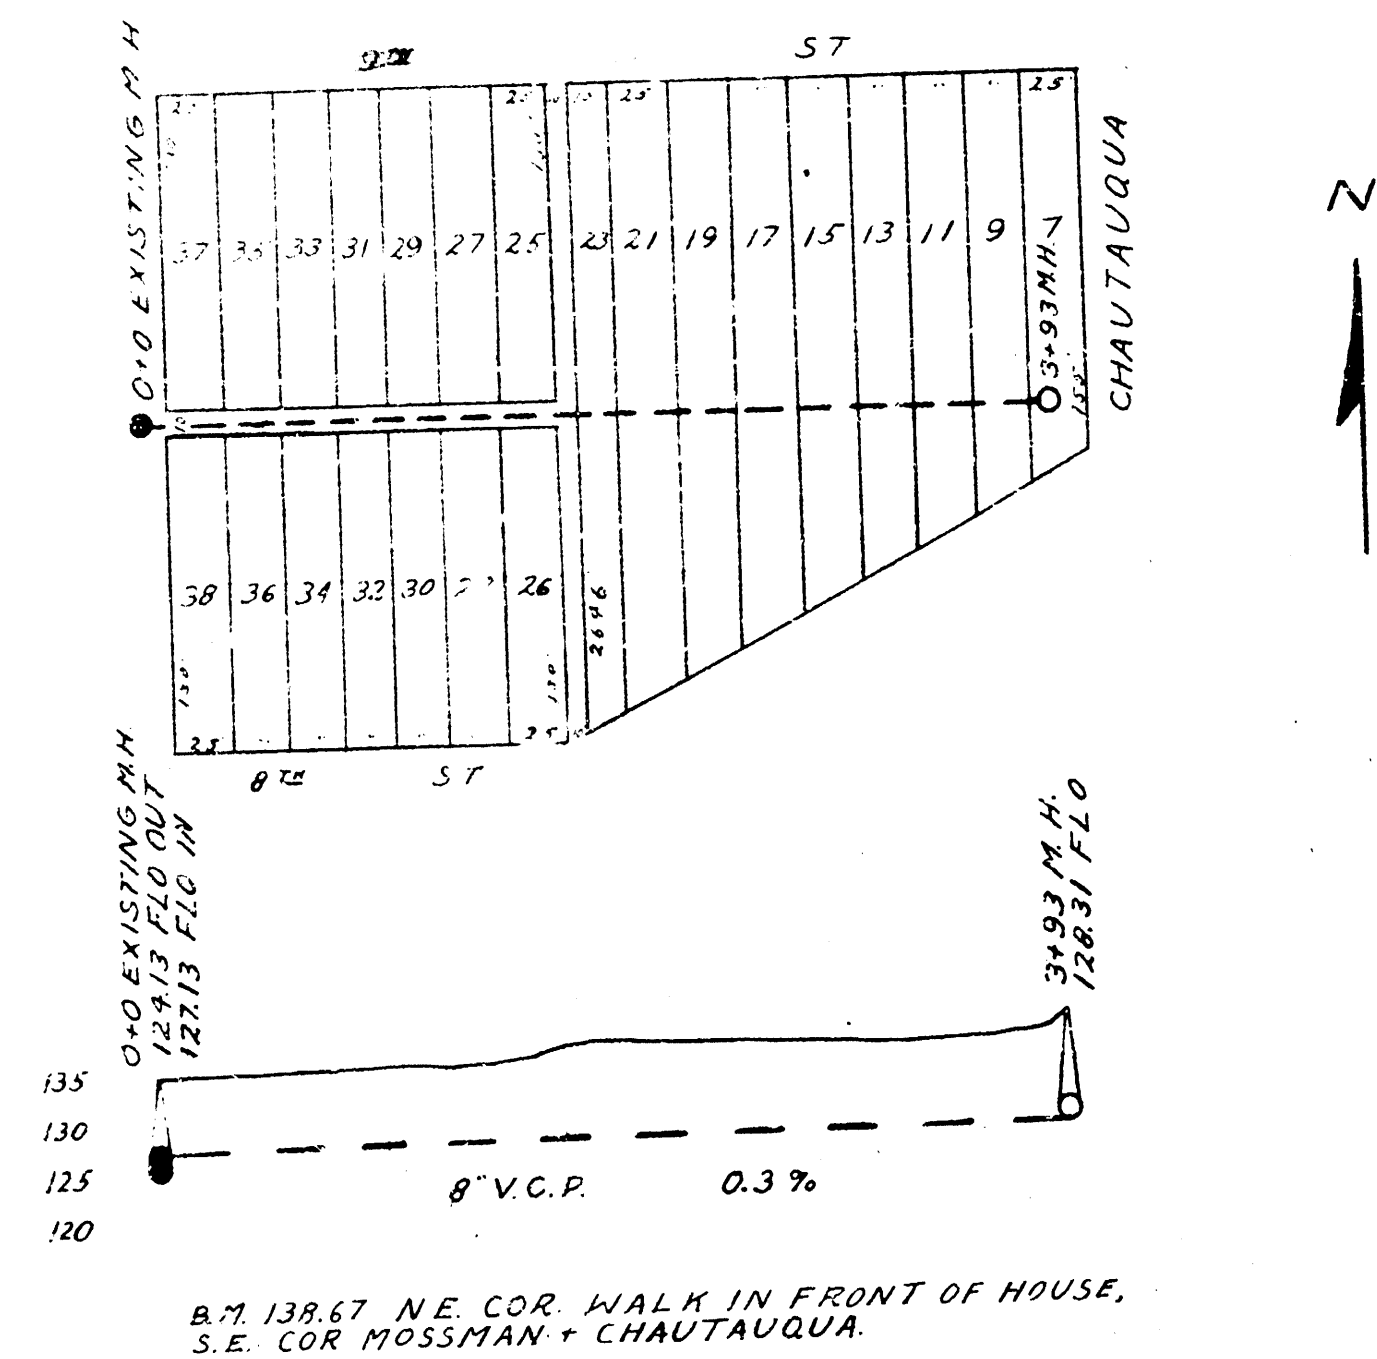


LAT 9 DIST 6 S.S.#12

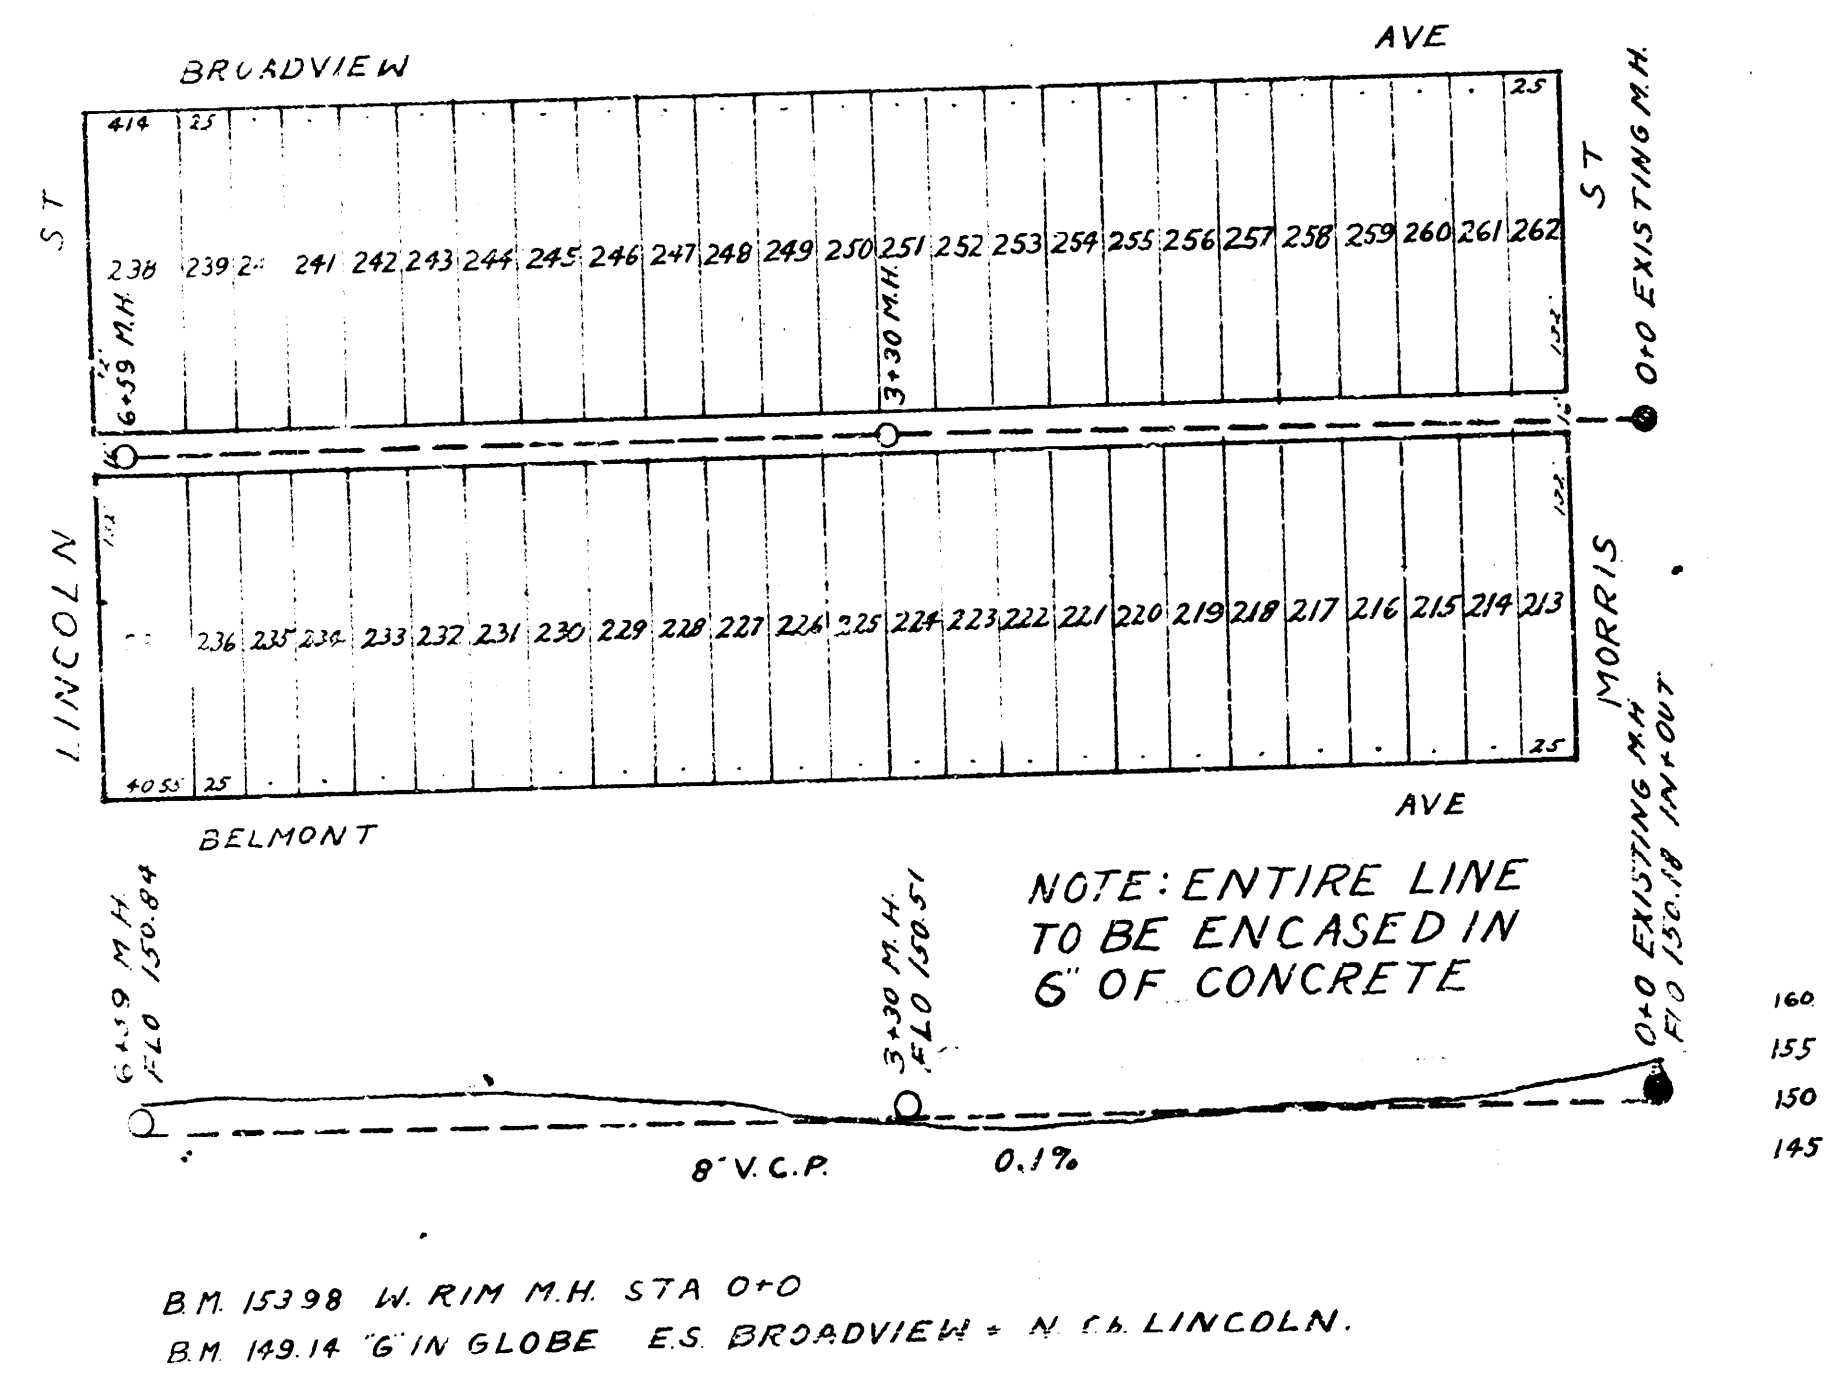

LAT 8 DIST 6 S.S.#12

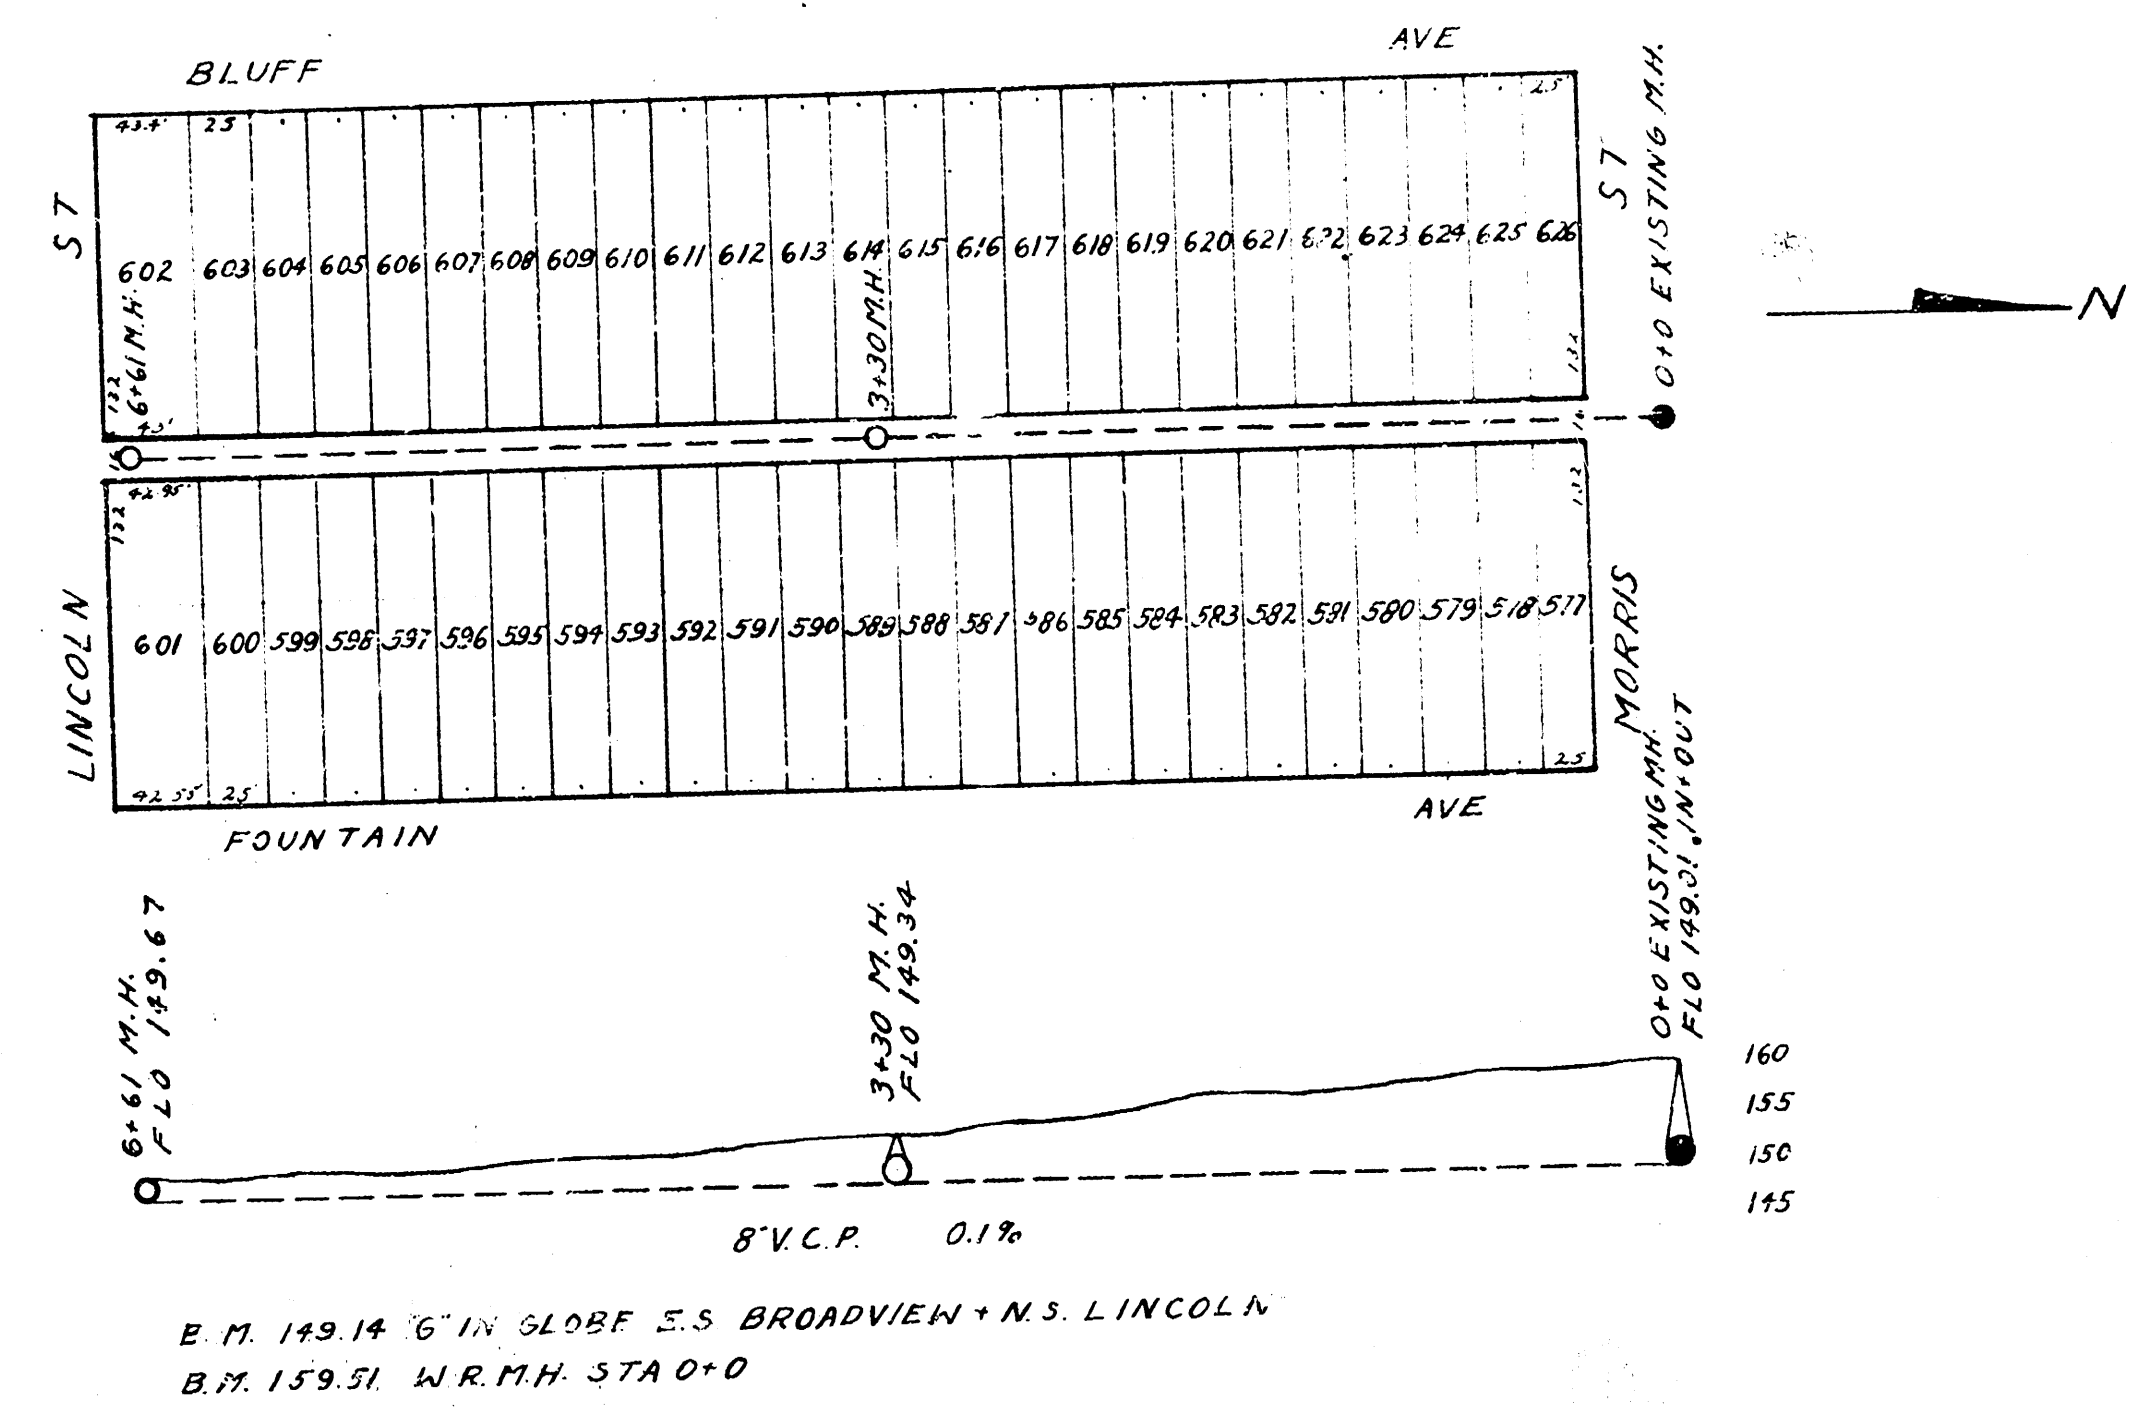

LAT 27 S.S.#20

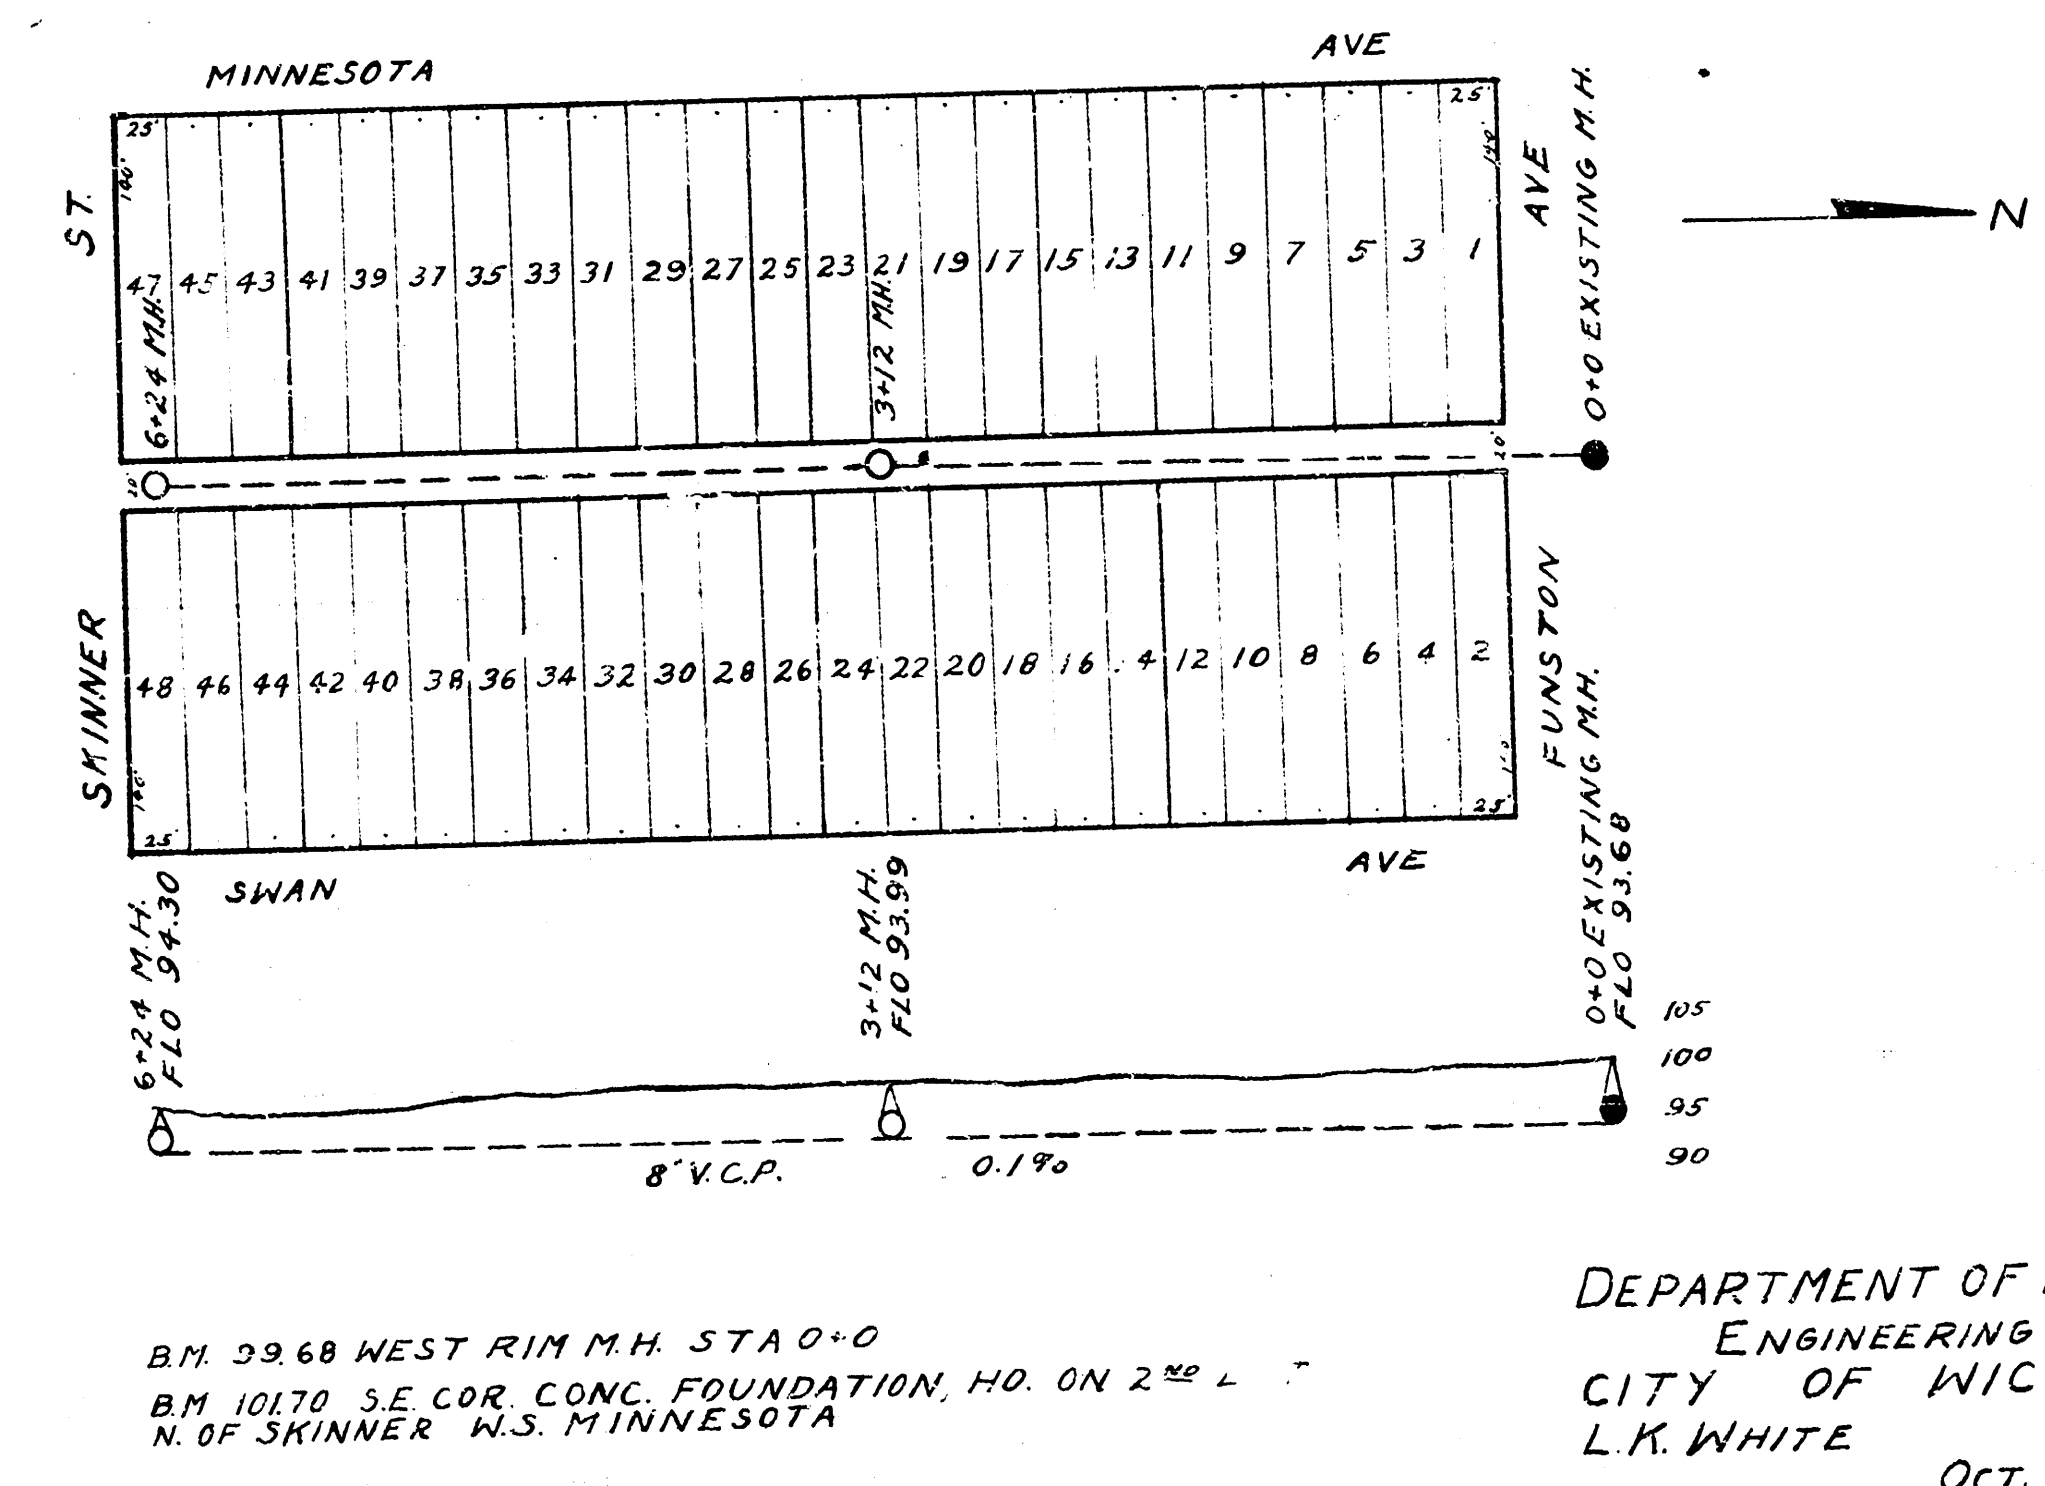

DEPARTMENT OF PUBLIC SERVICE
ENGINEERING DIVISION
CITY OF WICHITA, KANSAS
L.K. WHITE CITY ENGINEER
OCT. 1946