

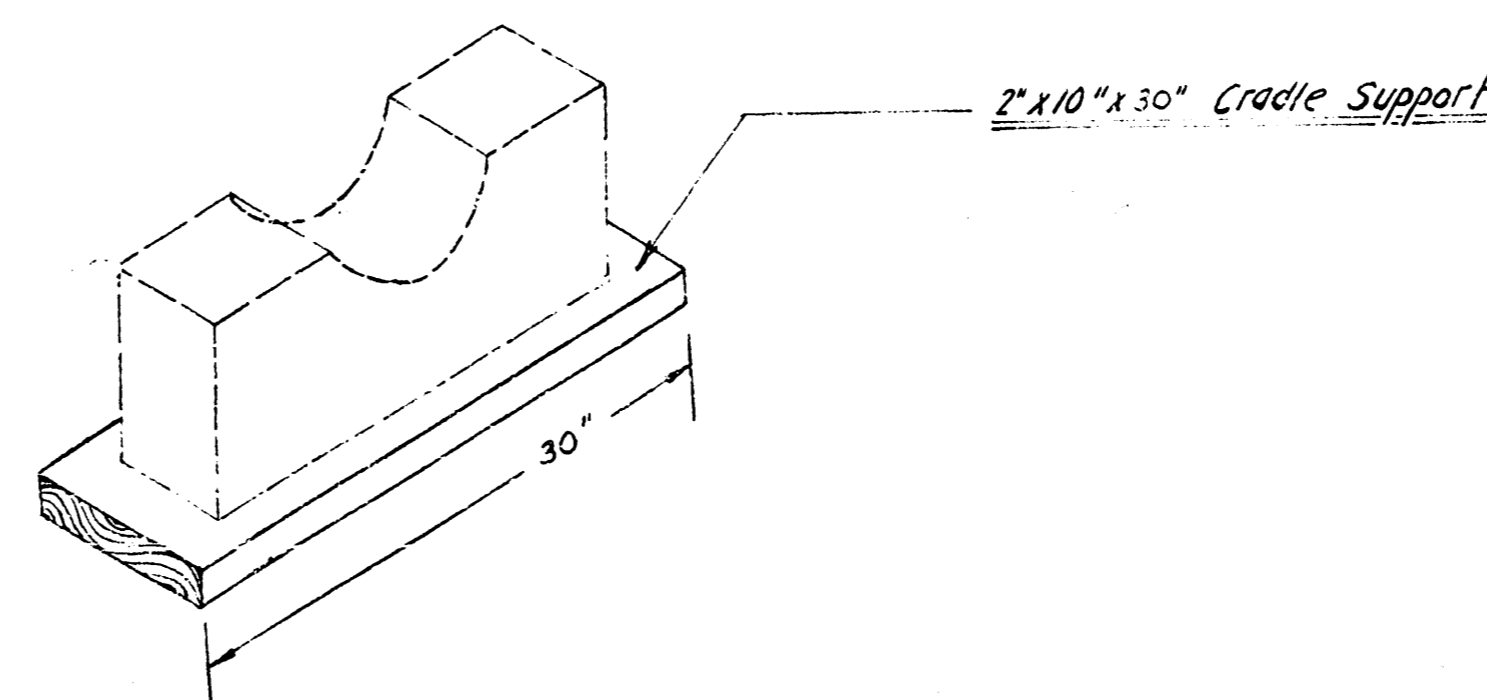
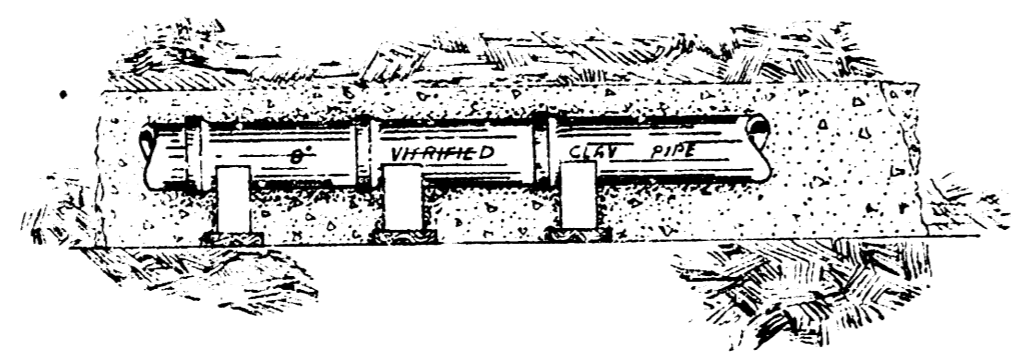
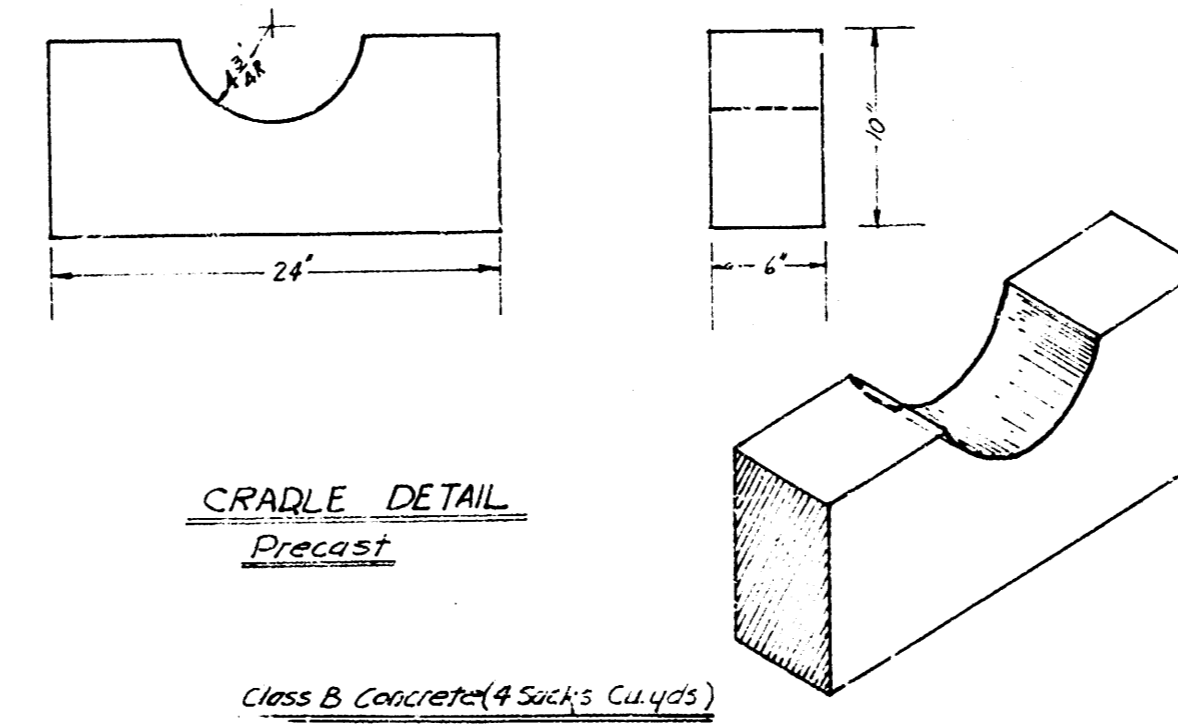
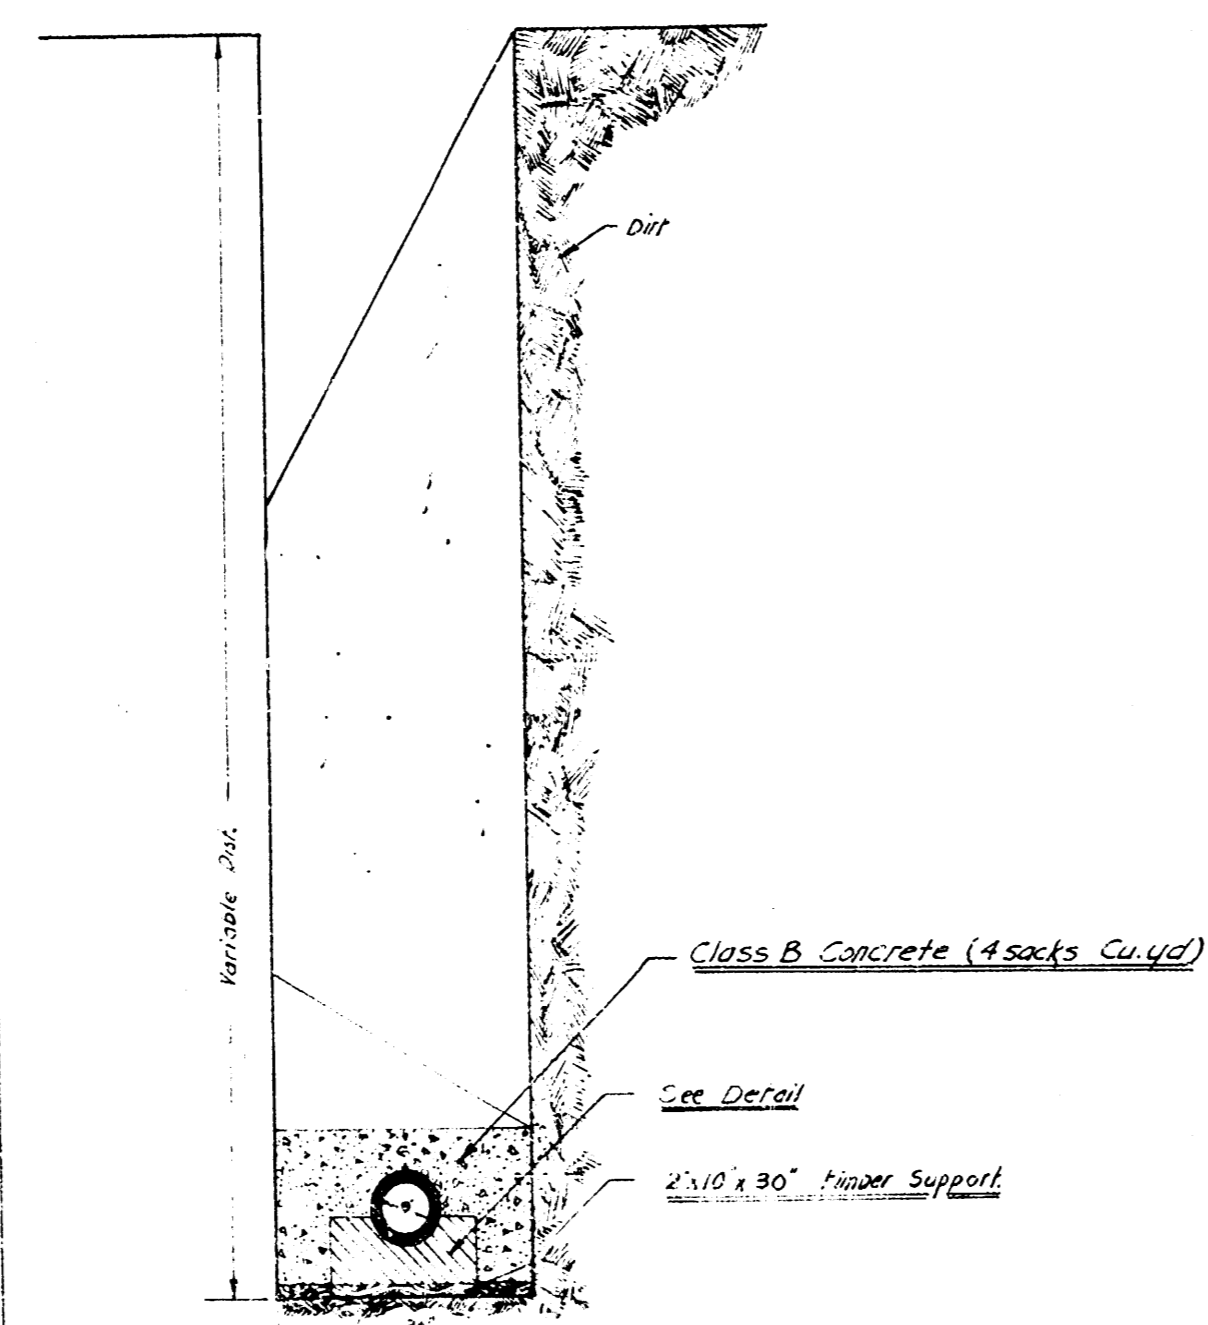


CLAY PIPE ENCASEMENT DETAIL

FROM Sta. 51063 to Sta. 18161
LATERAL 3, DISTRICT E, MAIN 12

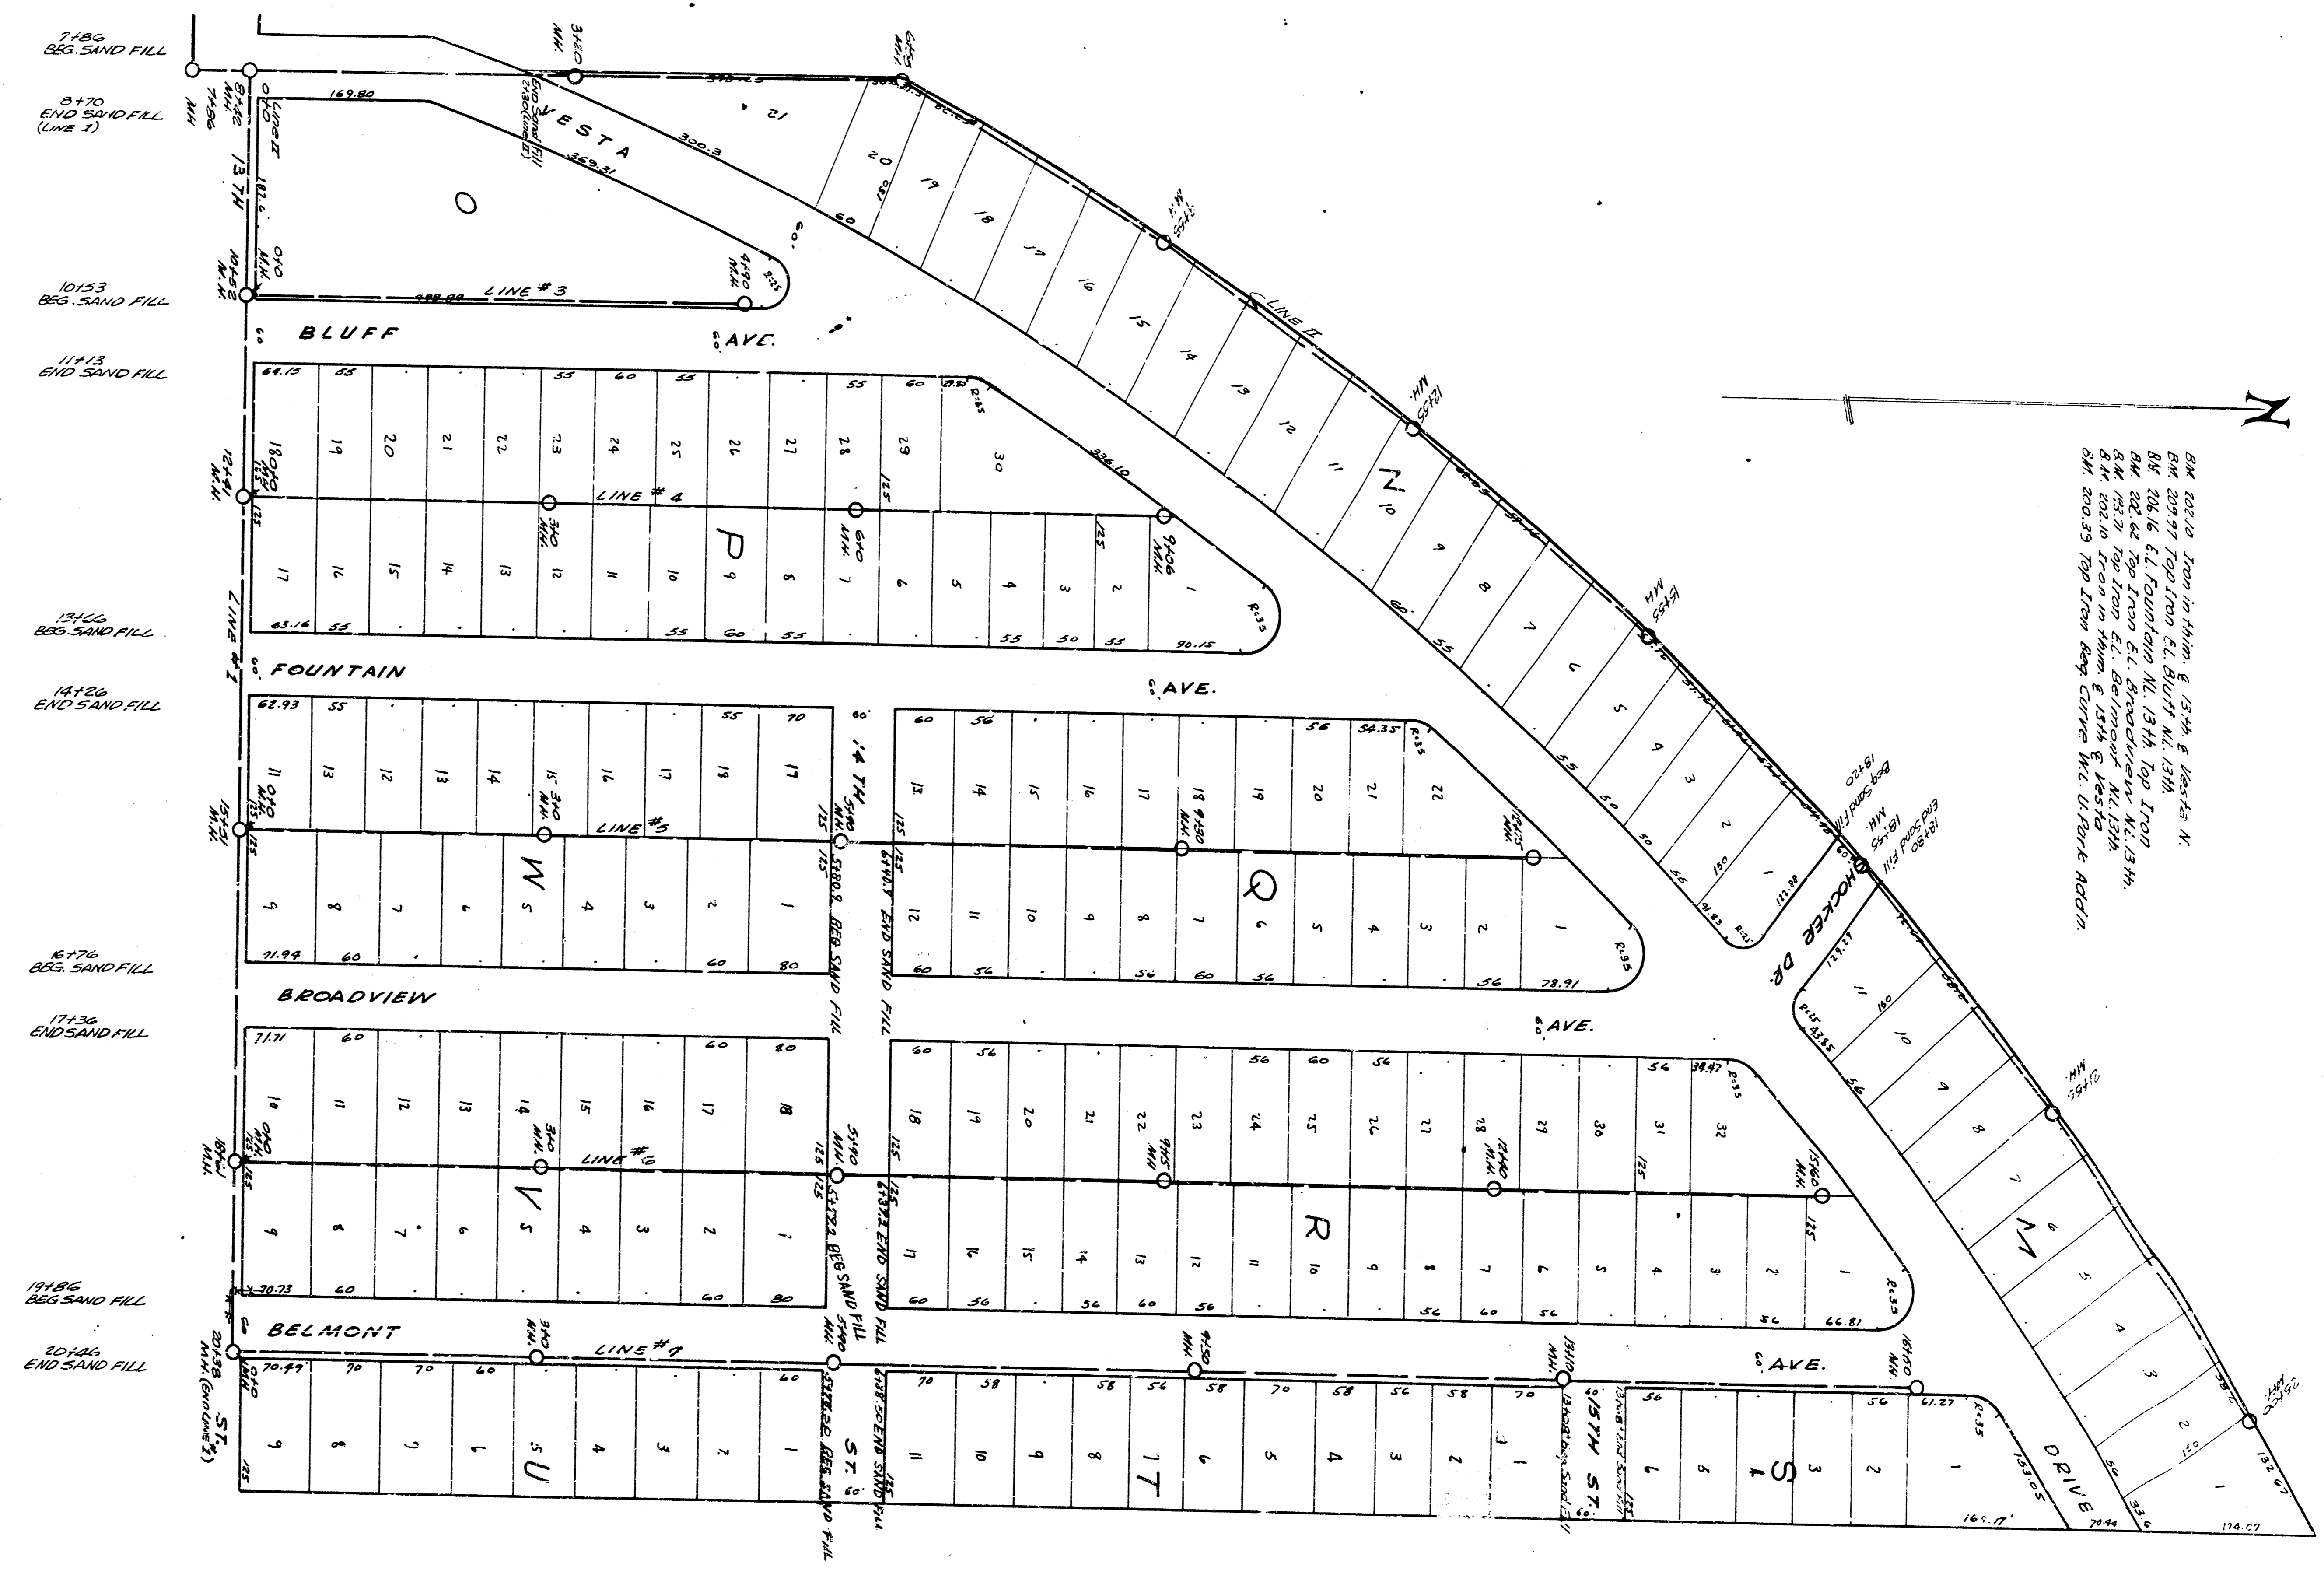

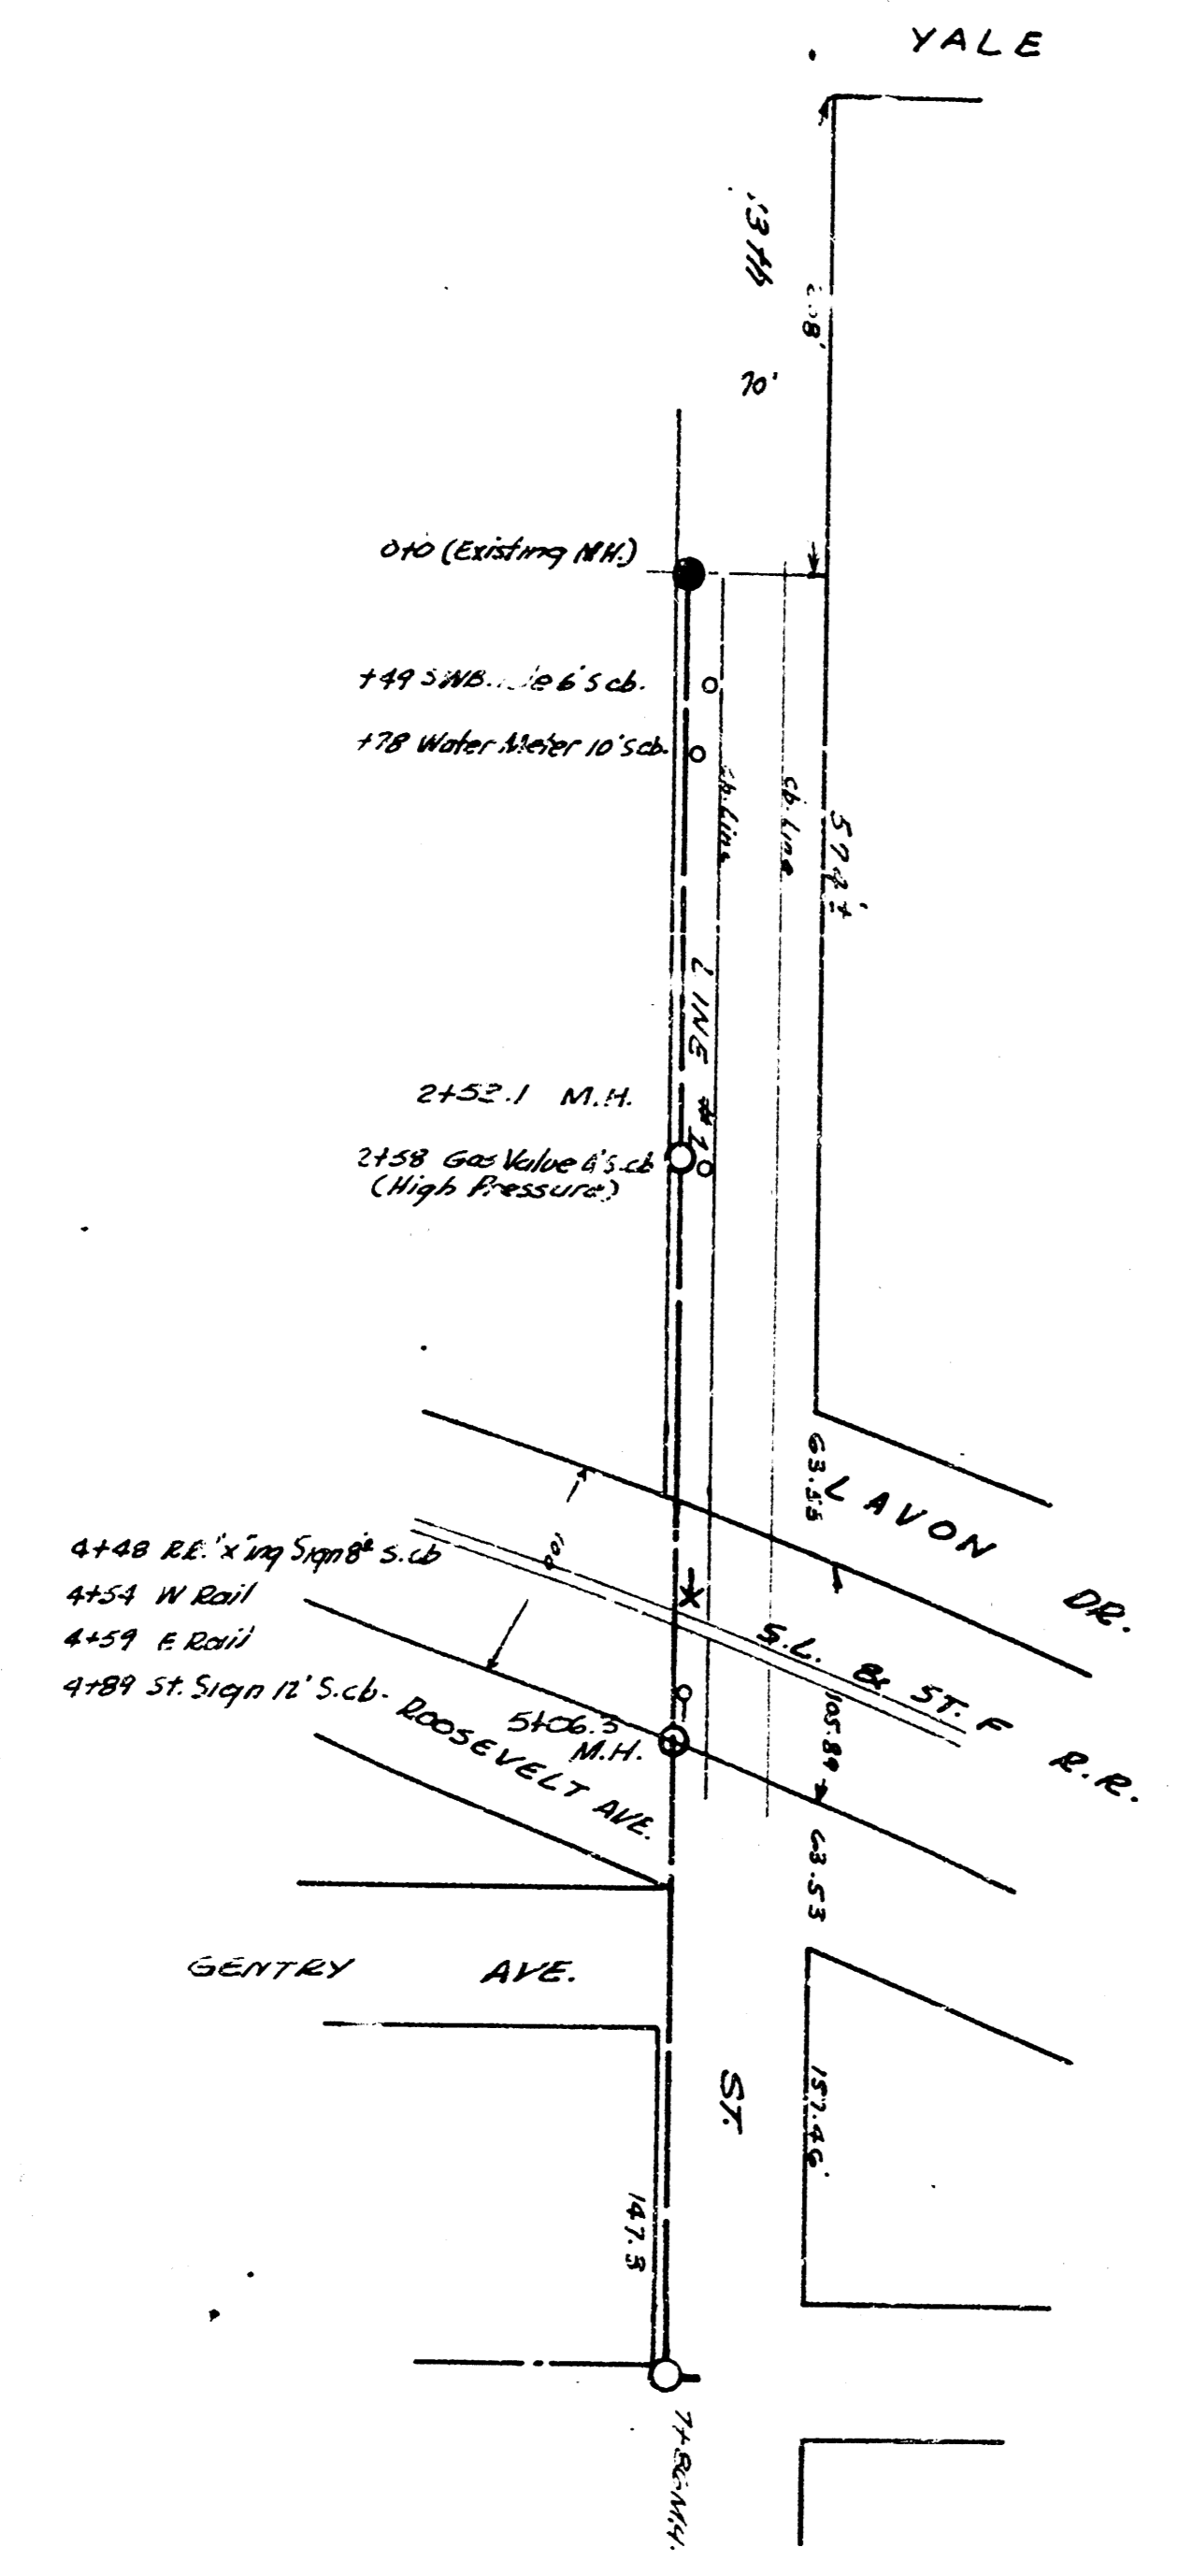


LAT. 3, DIST. E MAIN 12
 CITY OF WICHITA, KANSAS
 L.K. White City Engineer
 Feb. 1948 Proj. No.

