

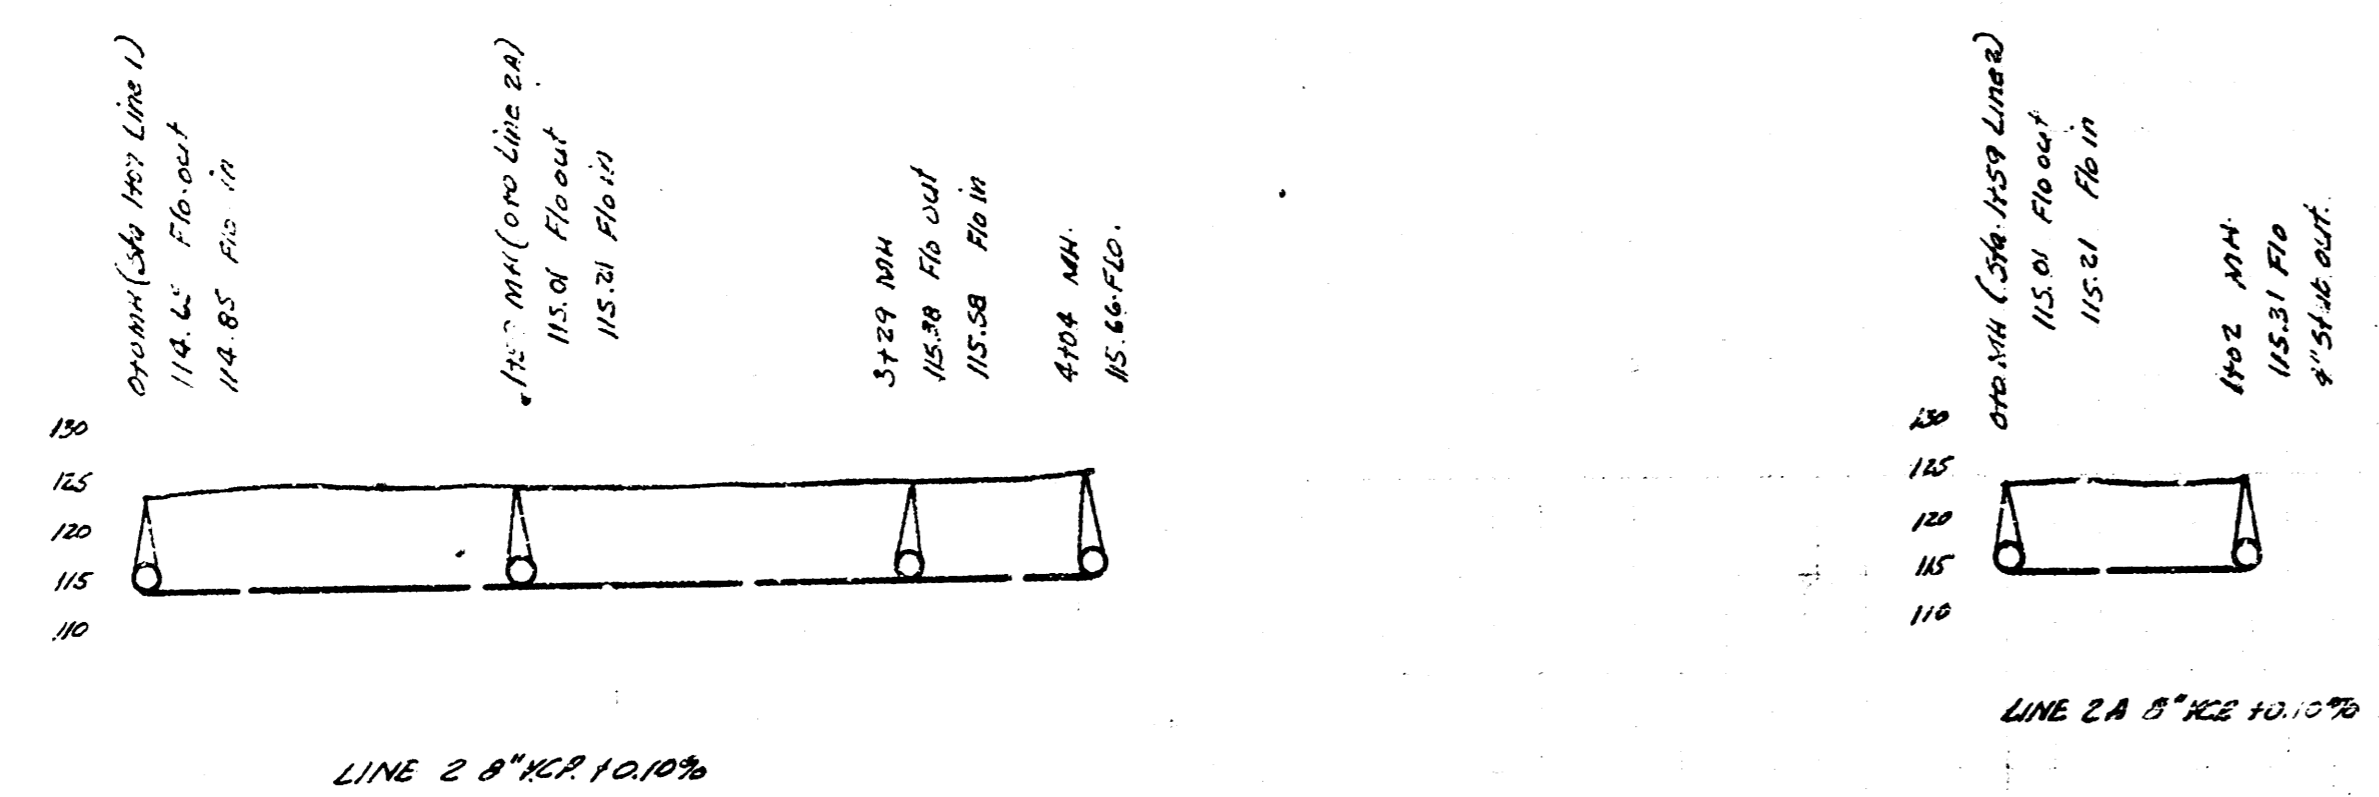
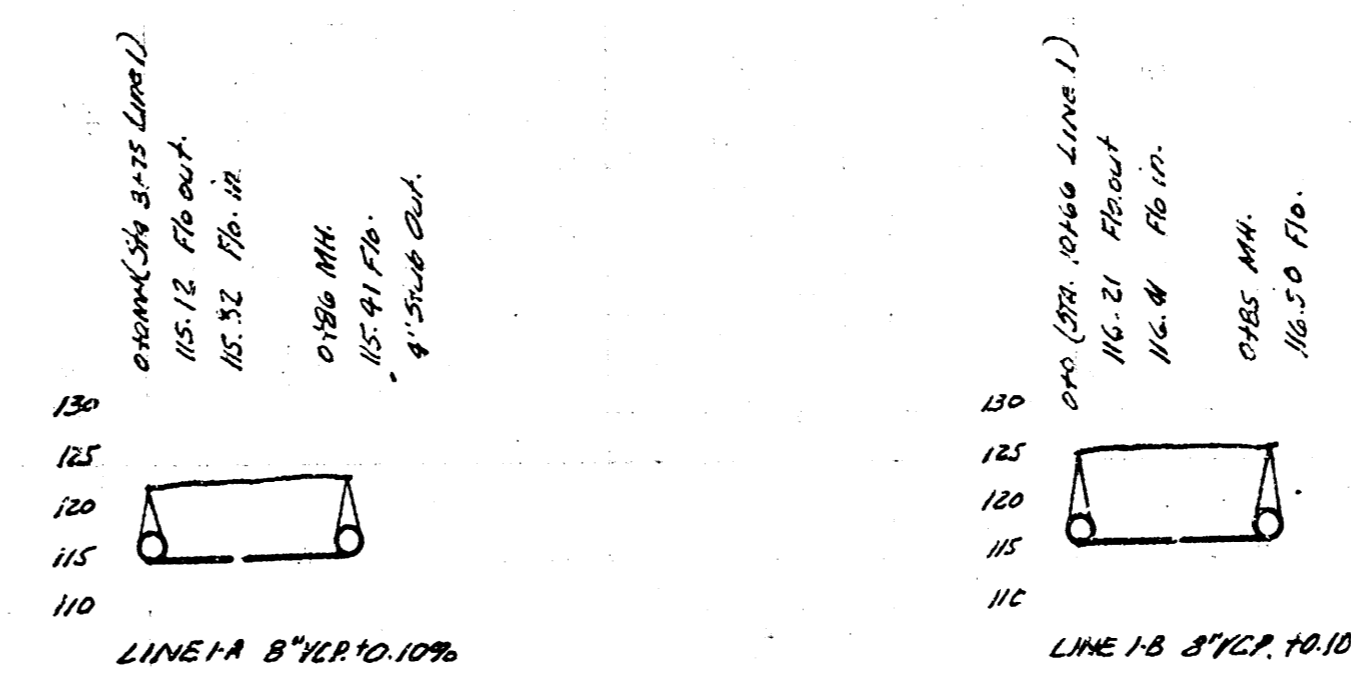


BUILDER'S SECOND ADDITION

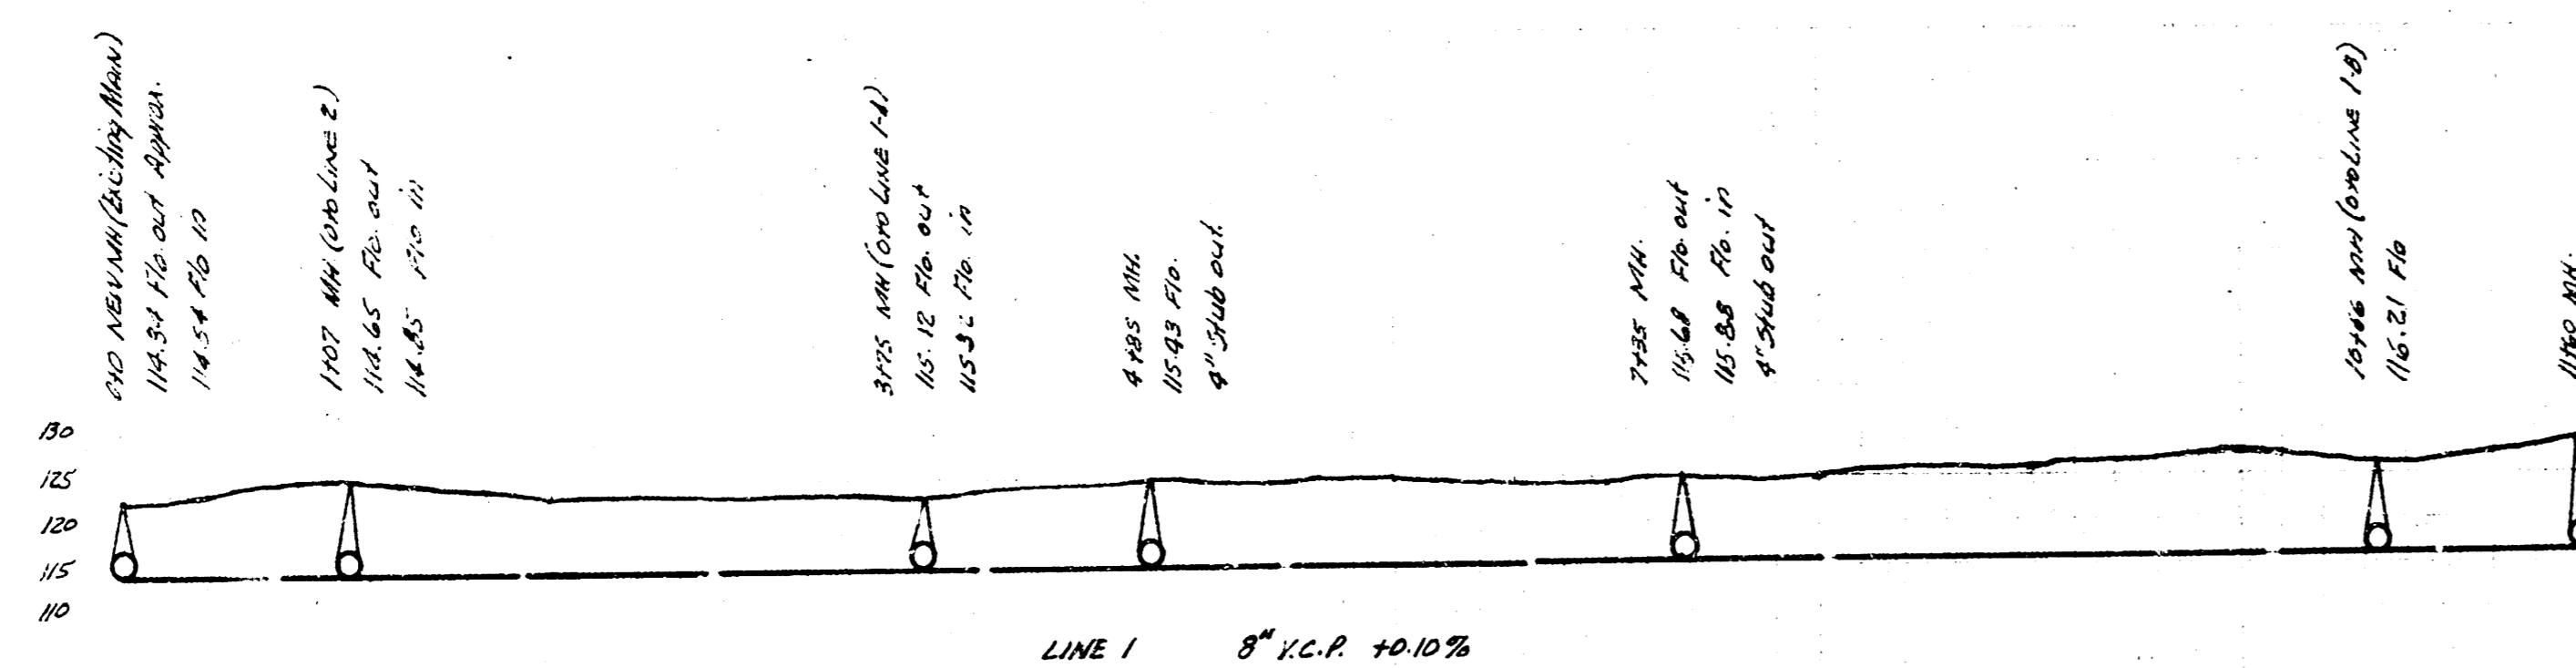

B.M. 126.57' ± IN TOP CURB ES SPRUCE SL 19TH

LAT. 5, DIST. E, MAIN 12.

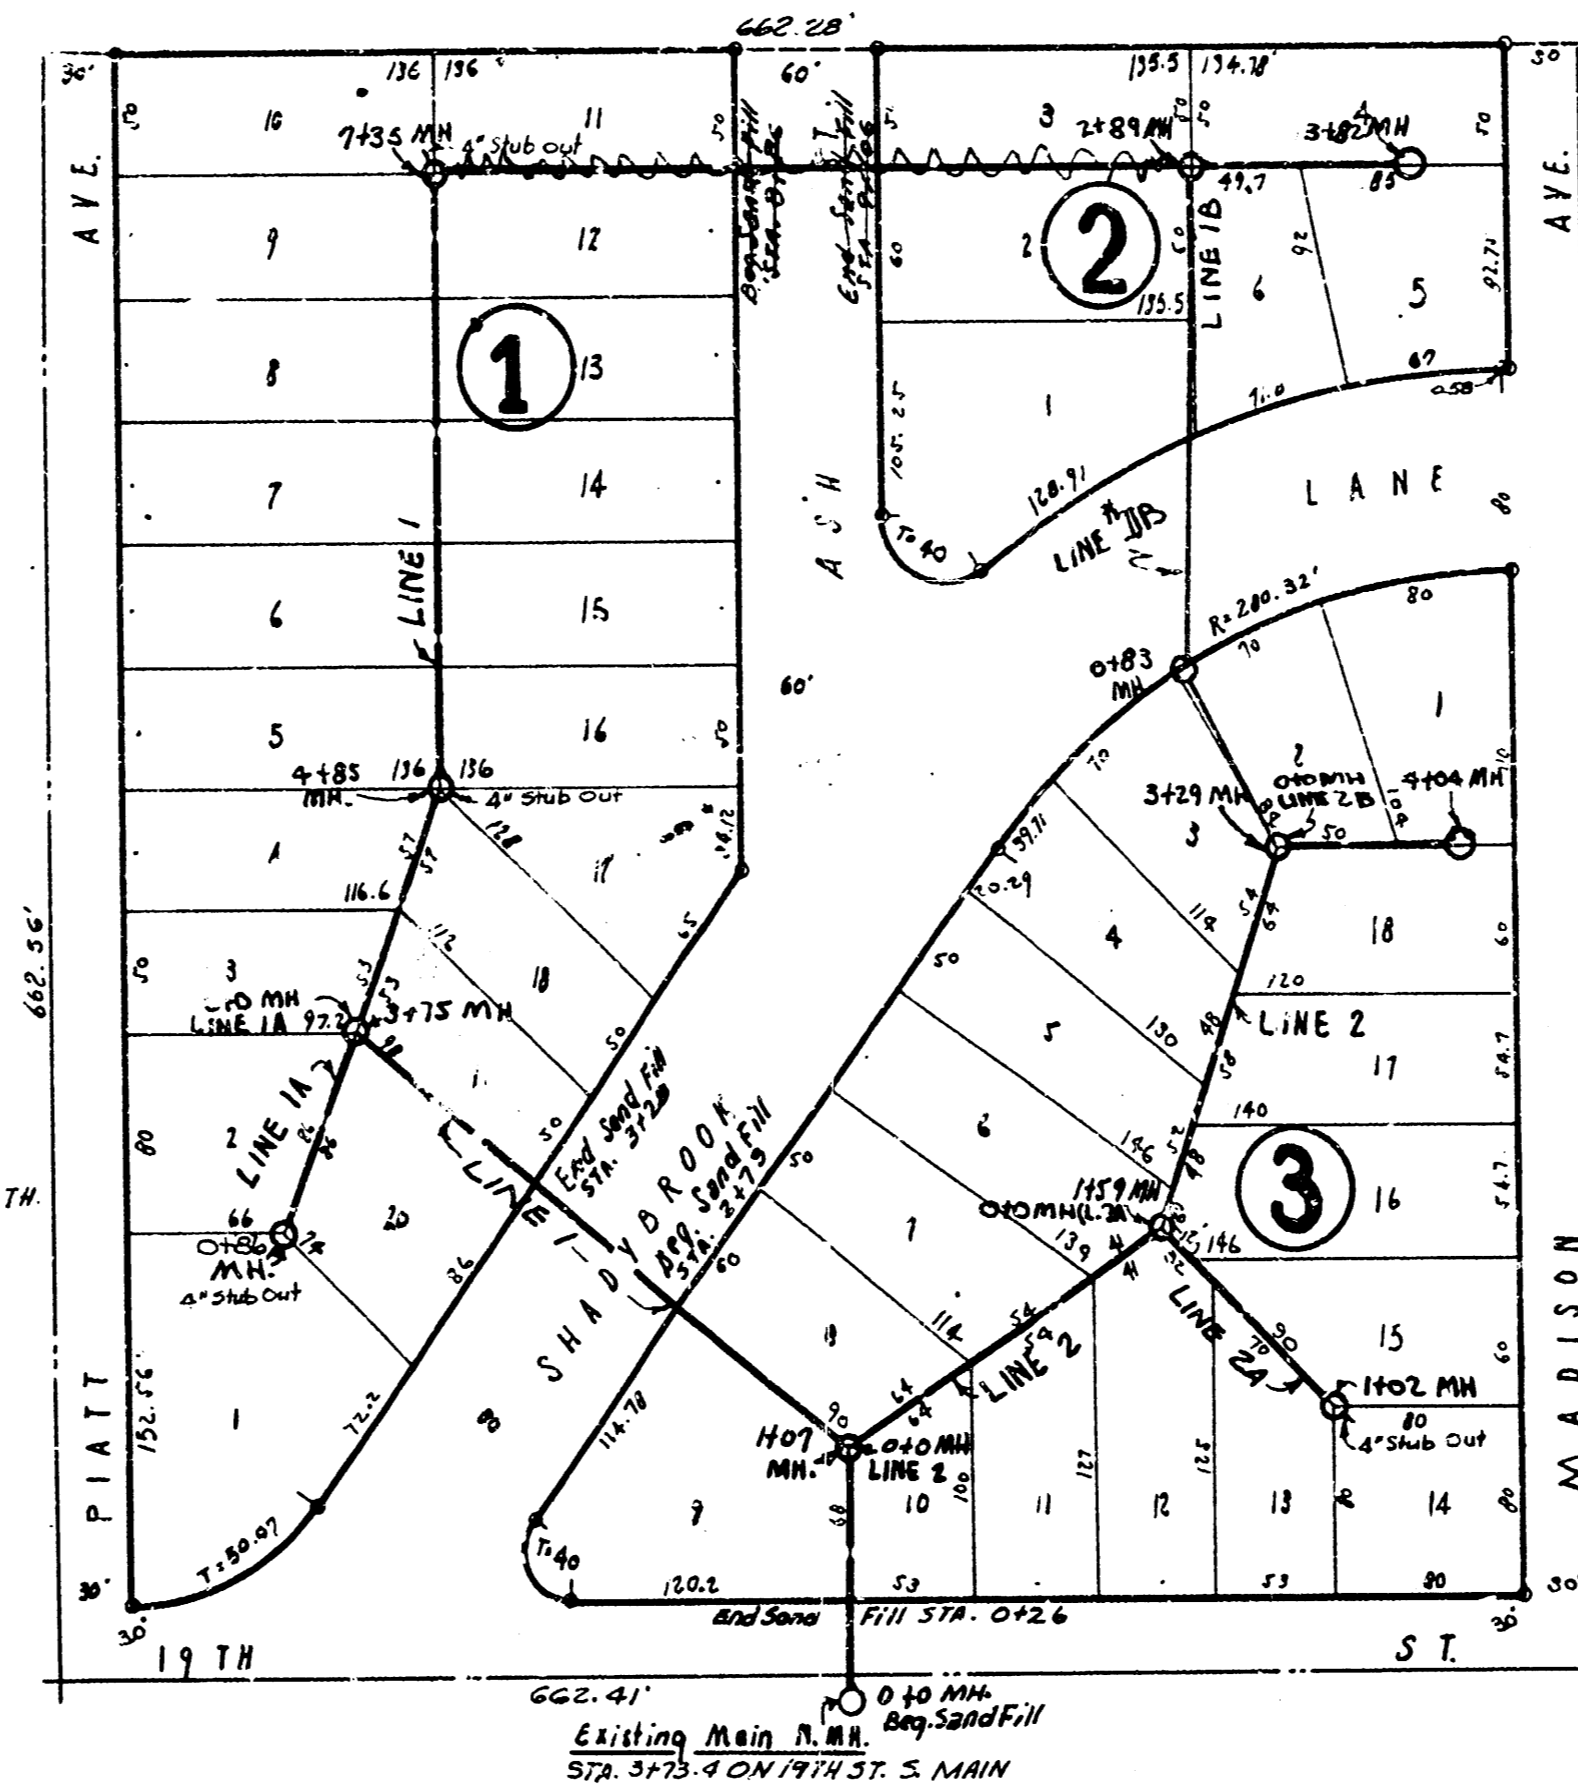

LAT. 5, DIST. E, MAIN 12
 CITY OF WICHITA, KANSAS
 L. K. WHITE City Engineer
 DATE 11-15-48 Proj. No. C 28-25