
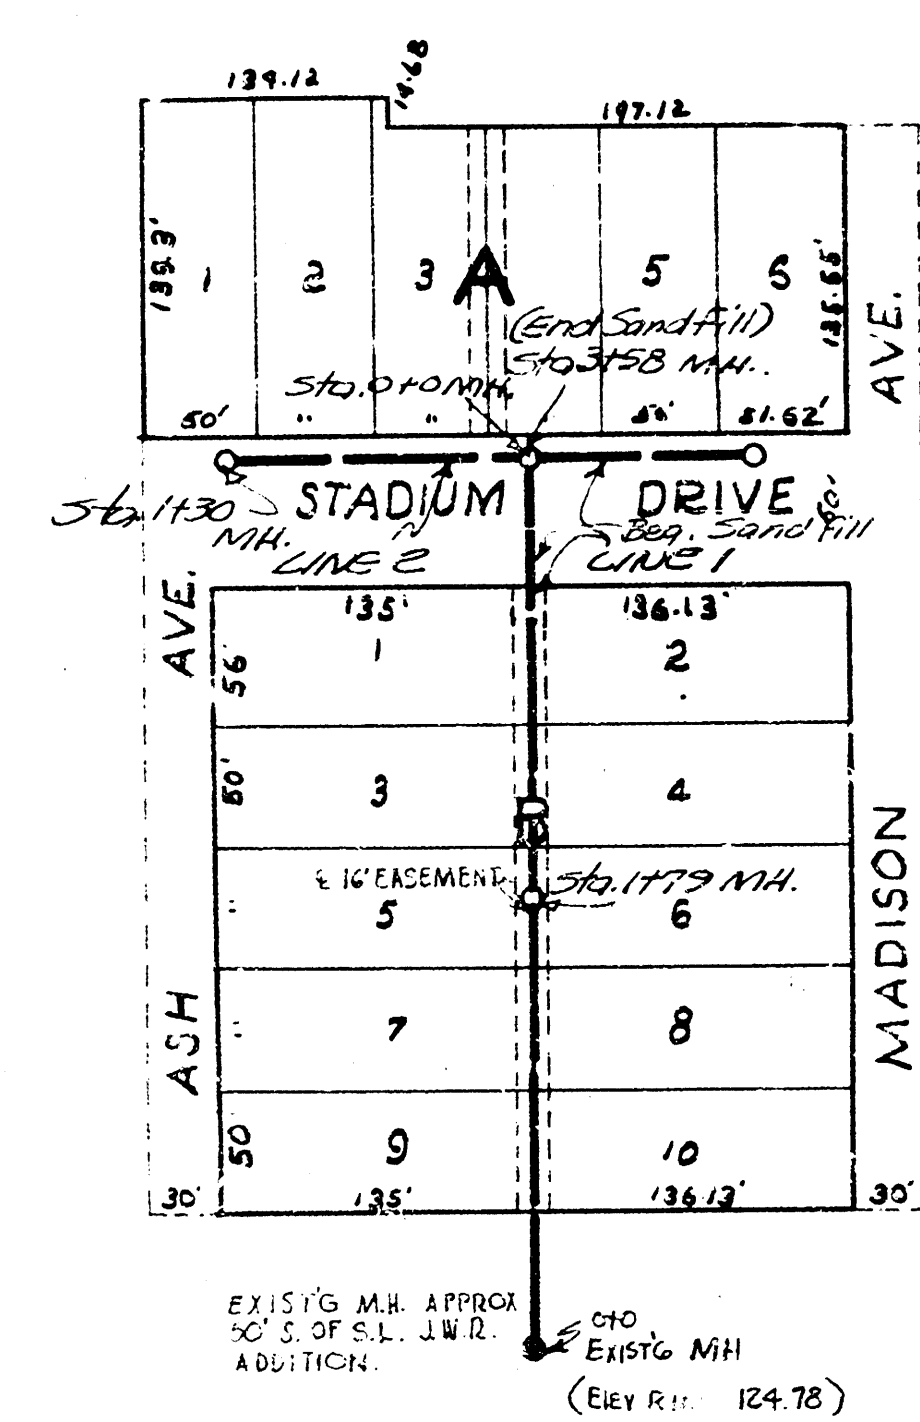


BM. 128.88 N.W. COR. LOWER STEP HOS. S.E. MADISON & 20TH.

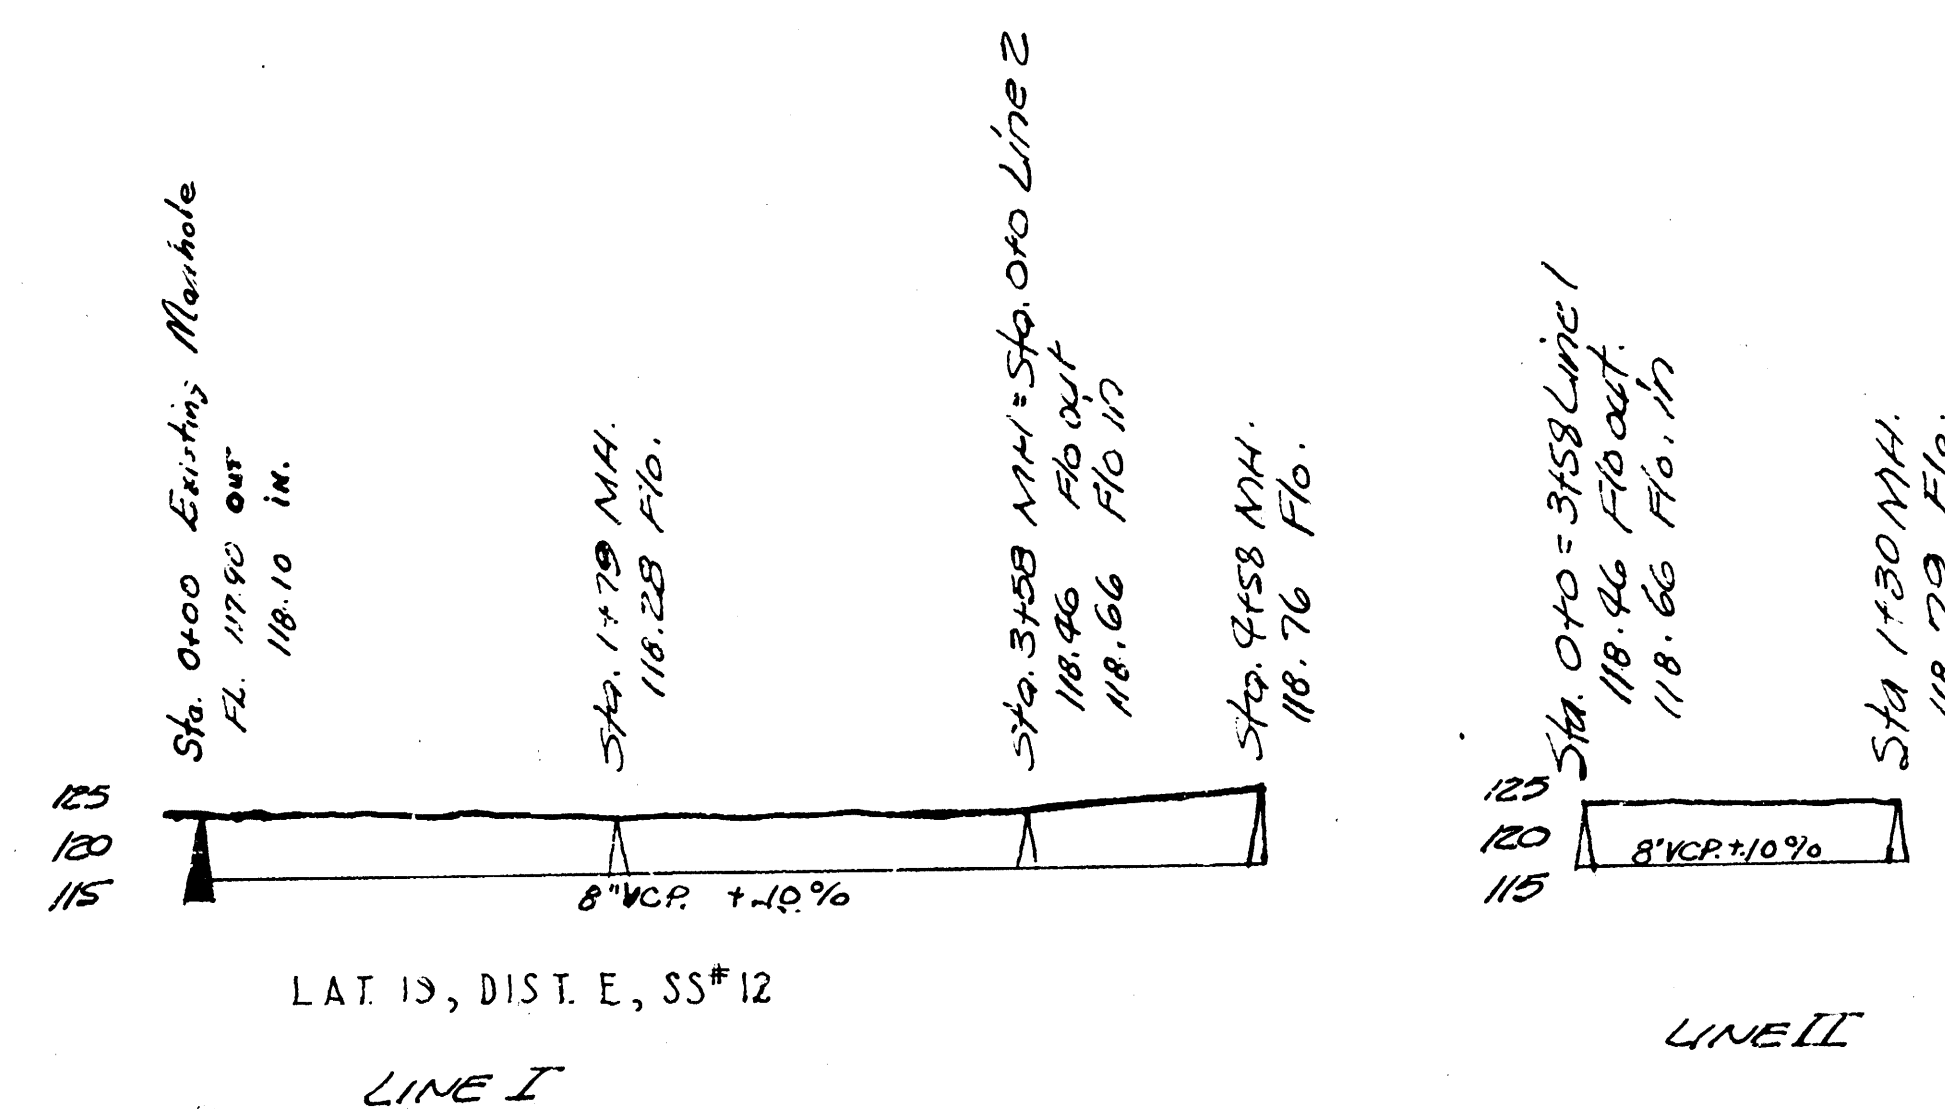

LAT. 19, DIST. E, SS# 12
 PRIVATE SEWER CONTRACT - J. Walter Ross Second Addn.
 CITY OF WICHITA, KANSAS
 L. K. WHITE CITY ENGINEER
 1950