



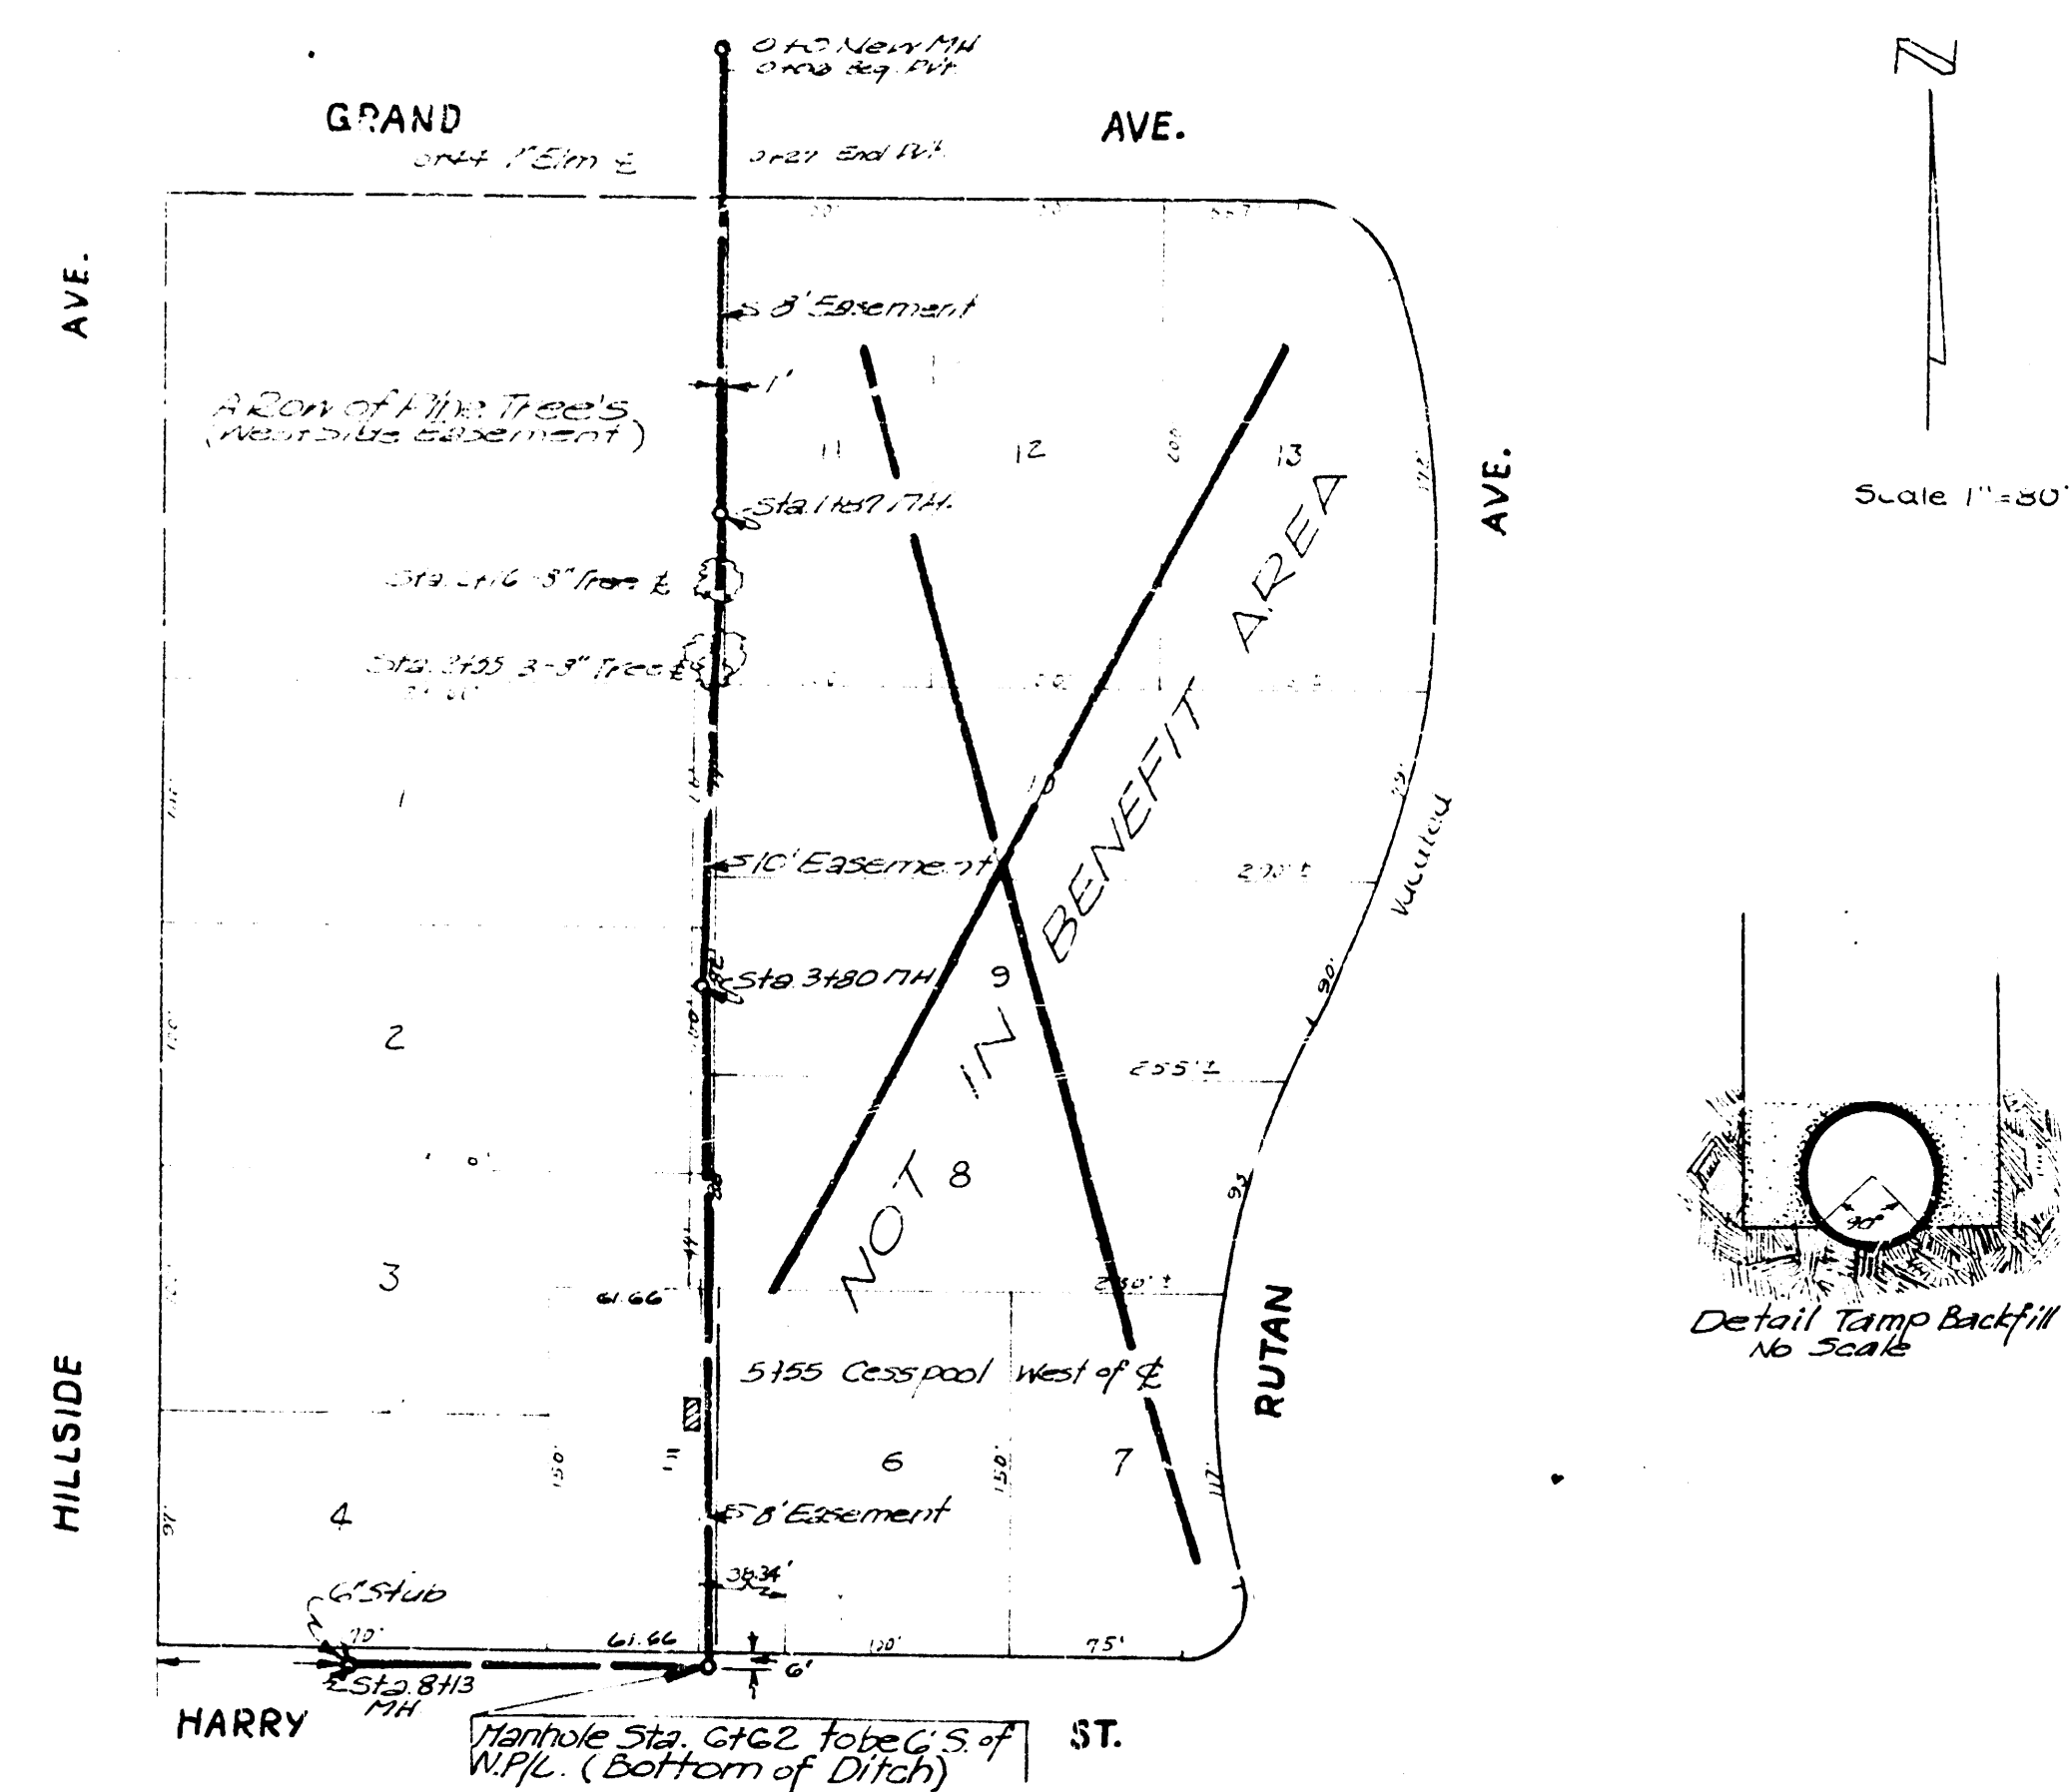


End of New Line running west on N.S. Harry to be Established by Proposed Line running from the Texas Station. Consult with the Texas Station Manager or Authorities on Location of Proposed Line.



B.M. 125.08 Eas. 1/2 in Sta 8446 ALL SAINTS SEWER.

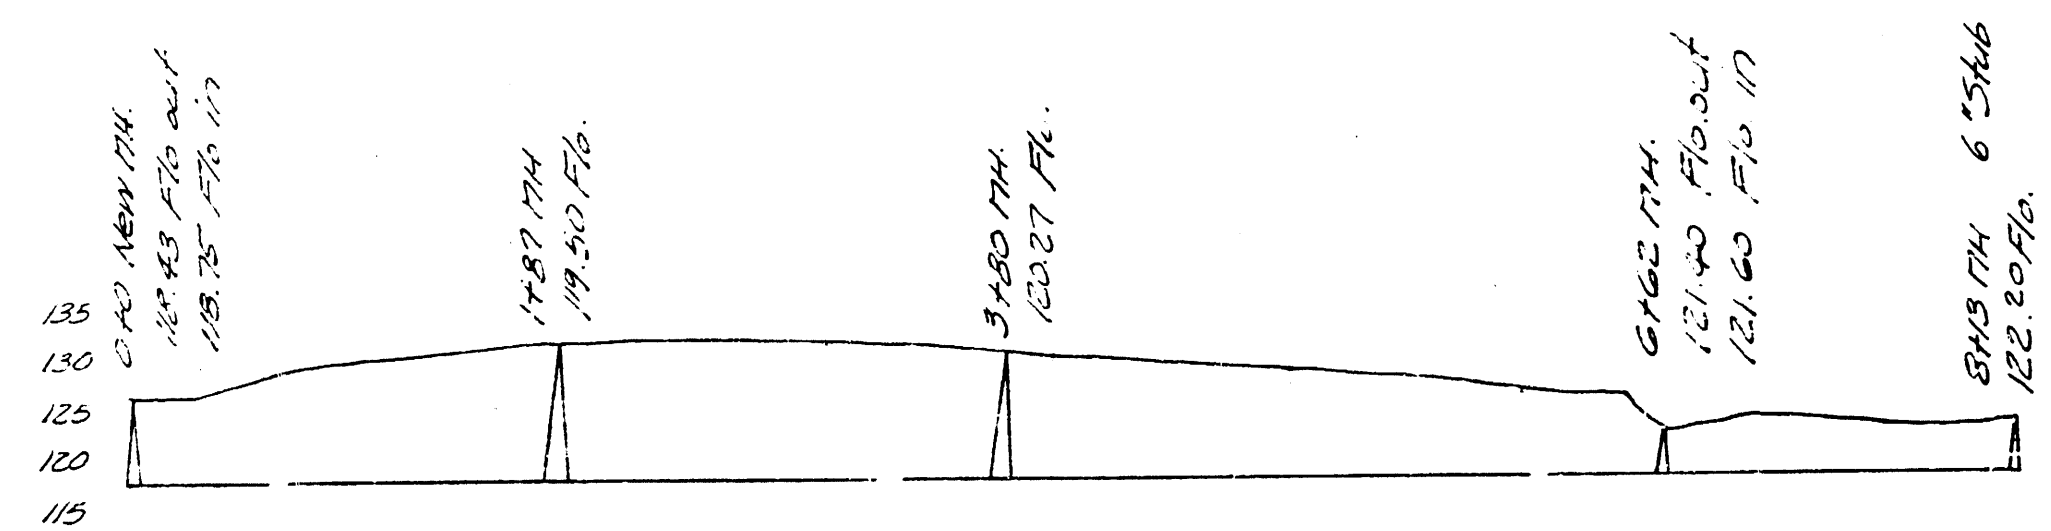

LAT. 5, DIST. 10, SS. 12  
Proj. No. C29-57

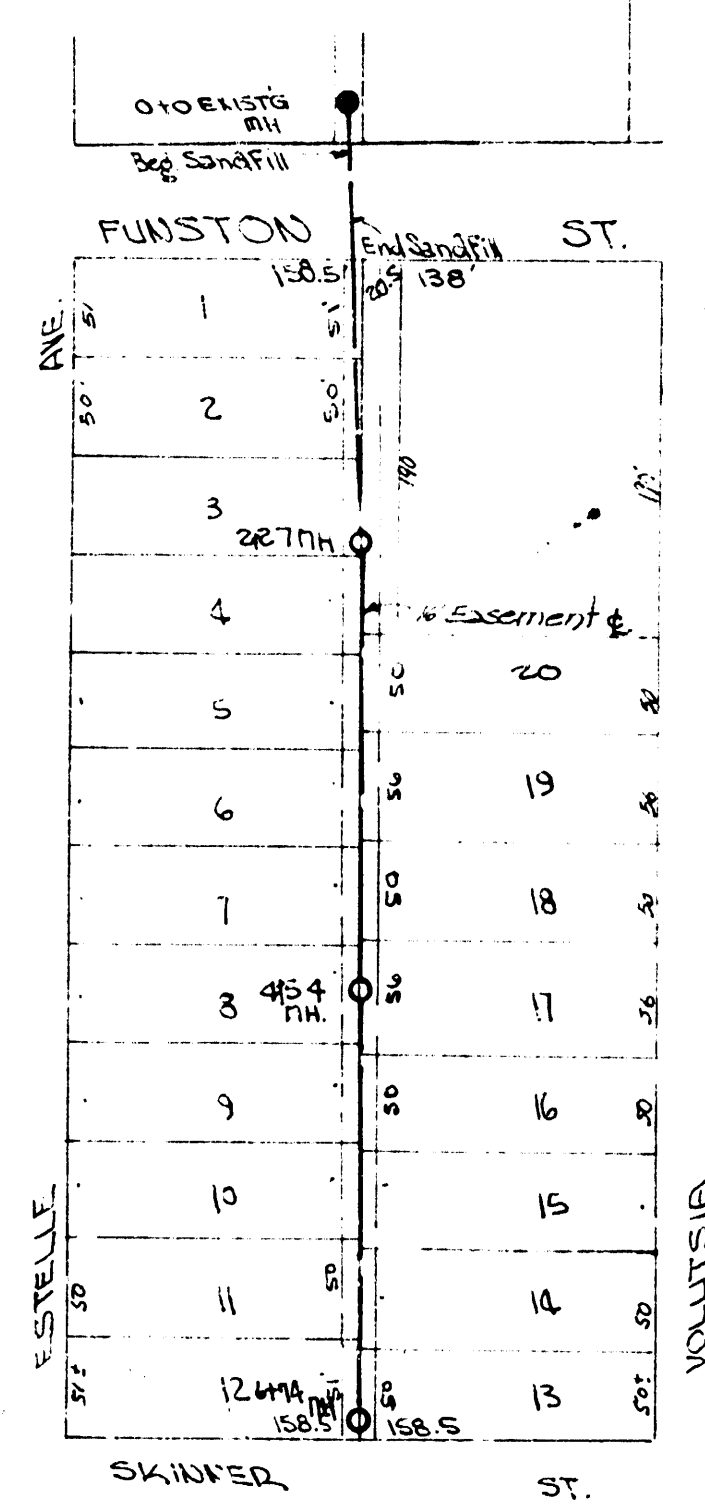


B.M. 120.74 6" in SLOPE S END CURB ESTELLE & FUNSTON.

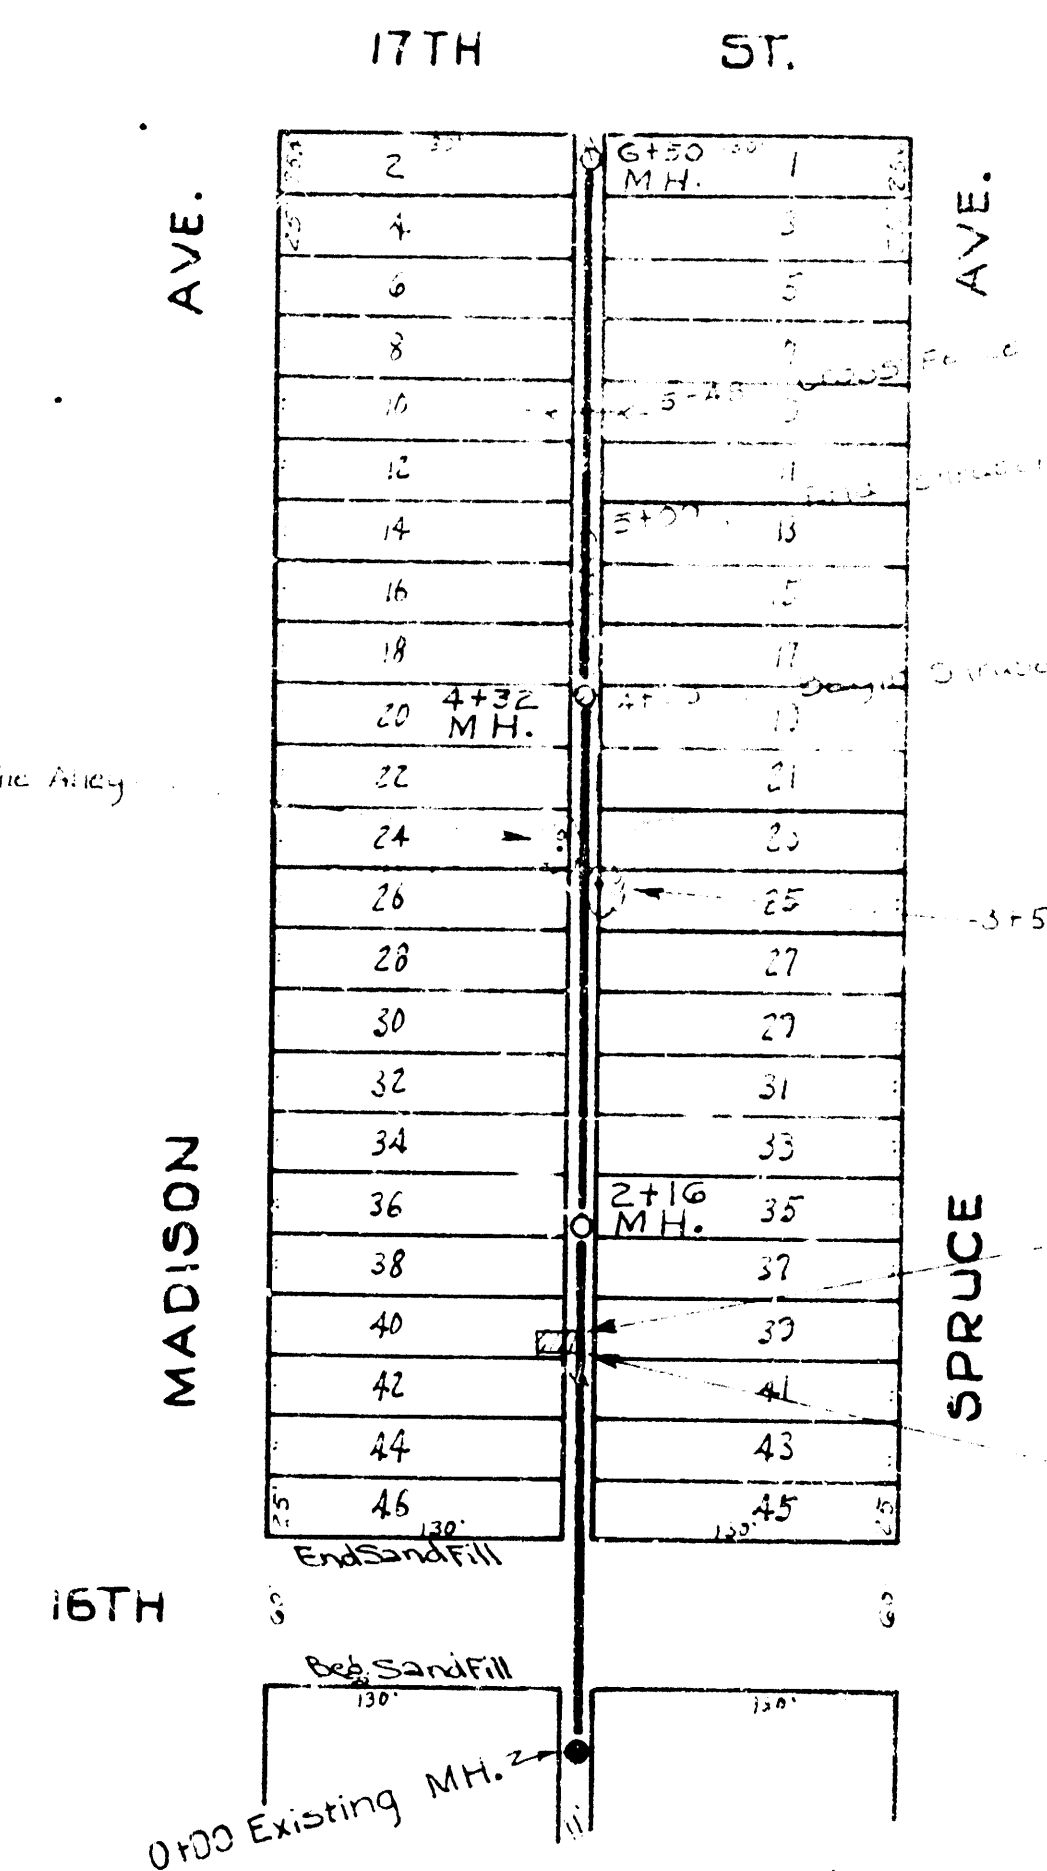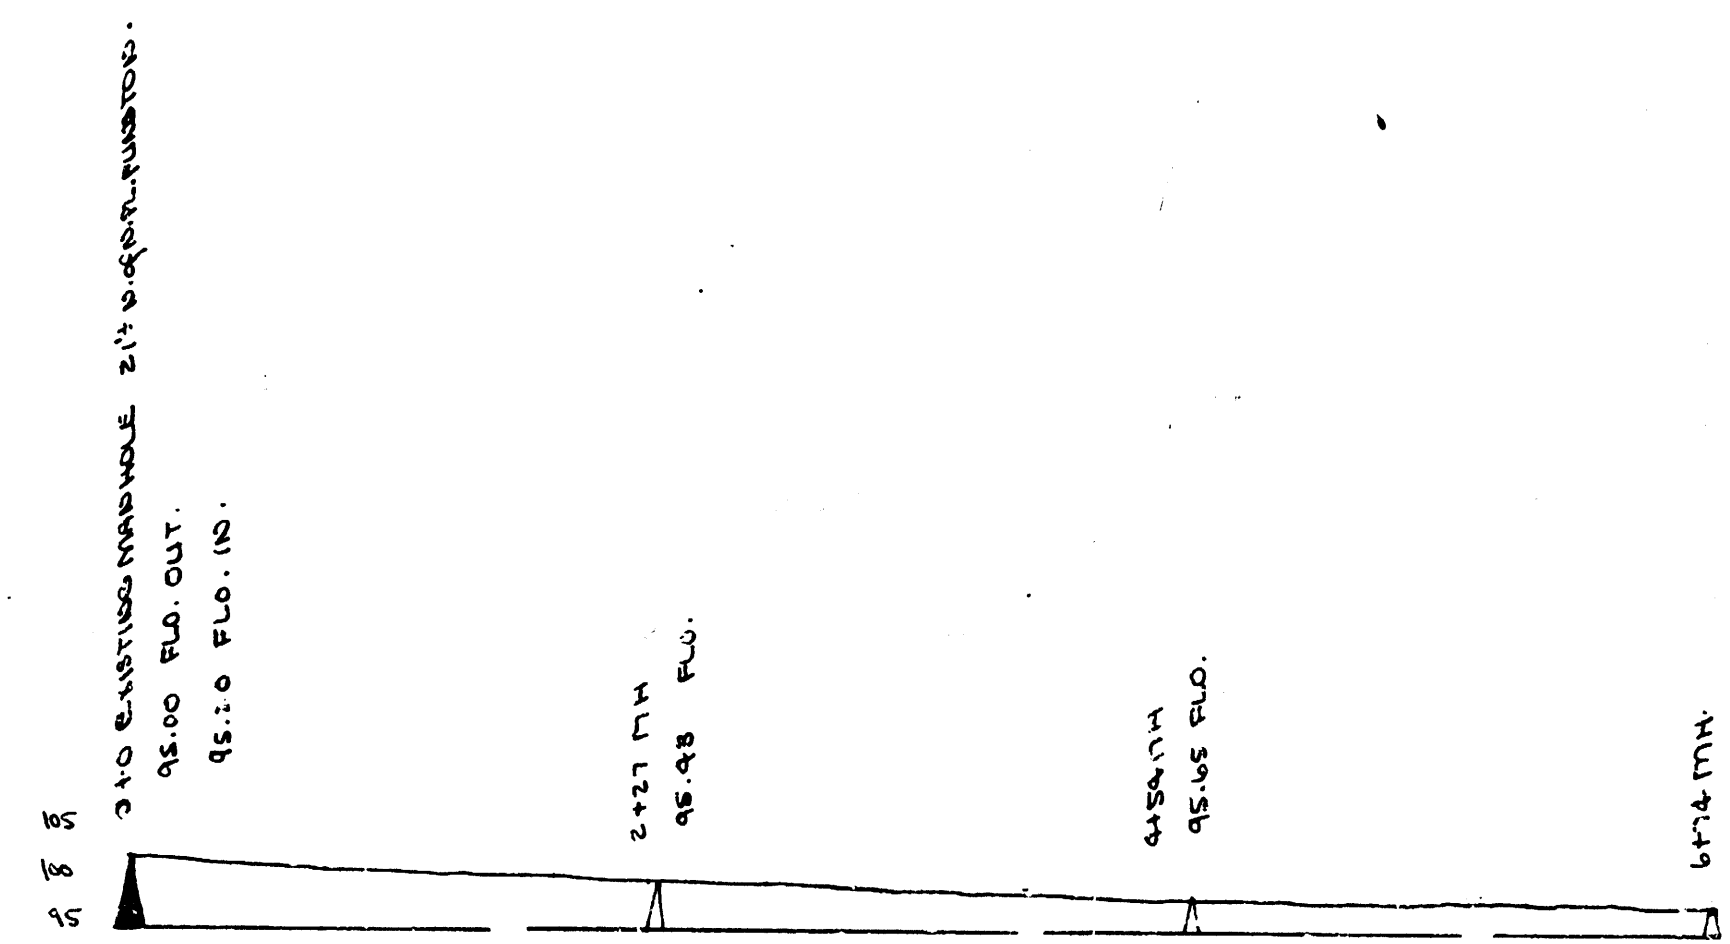

NOTE: 6" P.P. are on 2' to 3' East of W. Alley Line. Alley is 11' wide.

B.M. 120.44 So. Rim M.H. Sta. 1100.

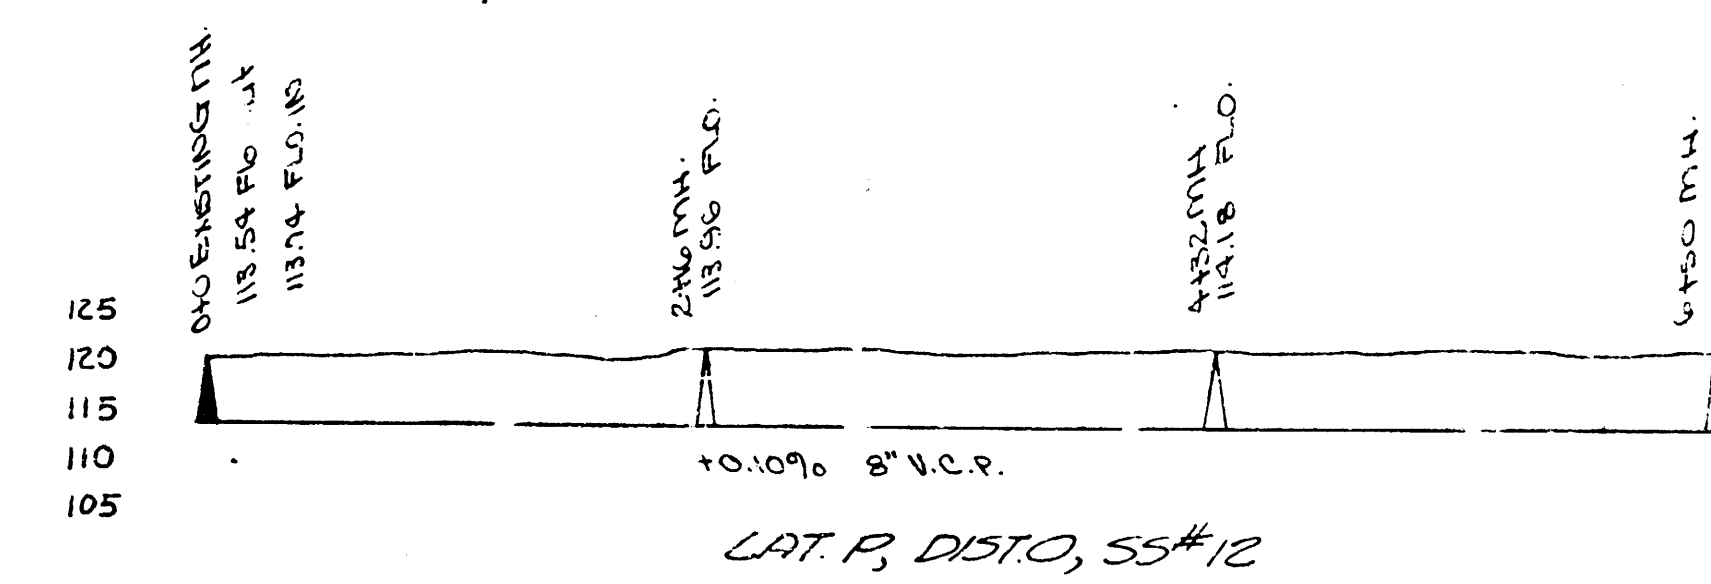

LAT. 6, SUBMAIN W, SS. 12  
LAT. 5, DIST. 10, SS. 12  
CITY OF WICHITA, KANSAS  
L.K. White ~ City Engineer  
Date: 2-23-50 Proj. No. C29-57