

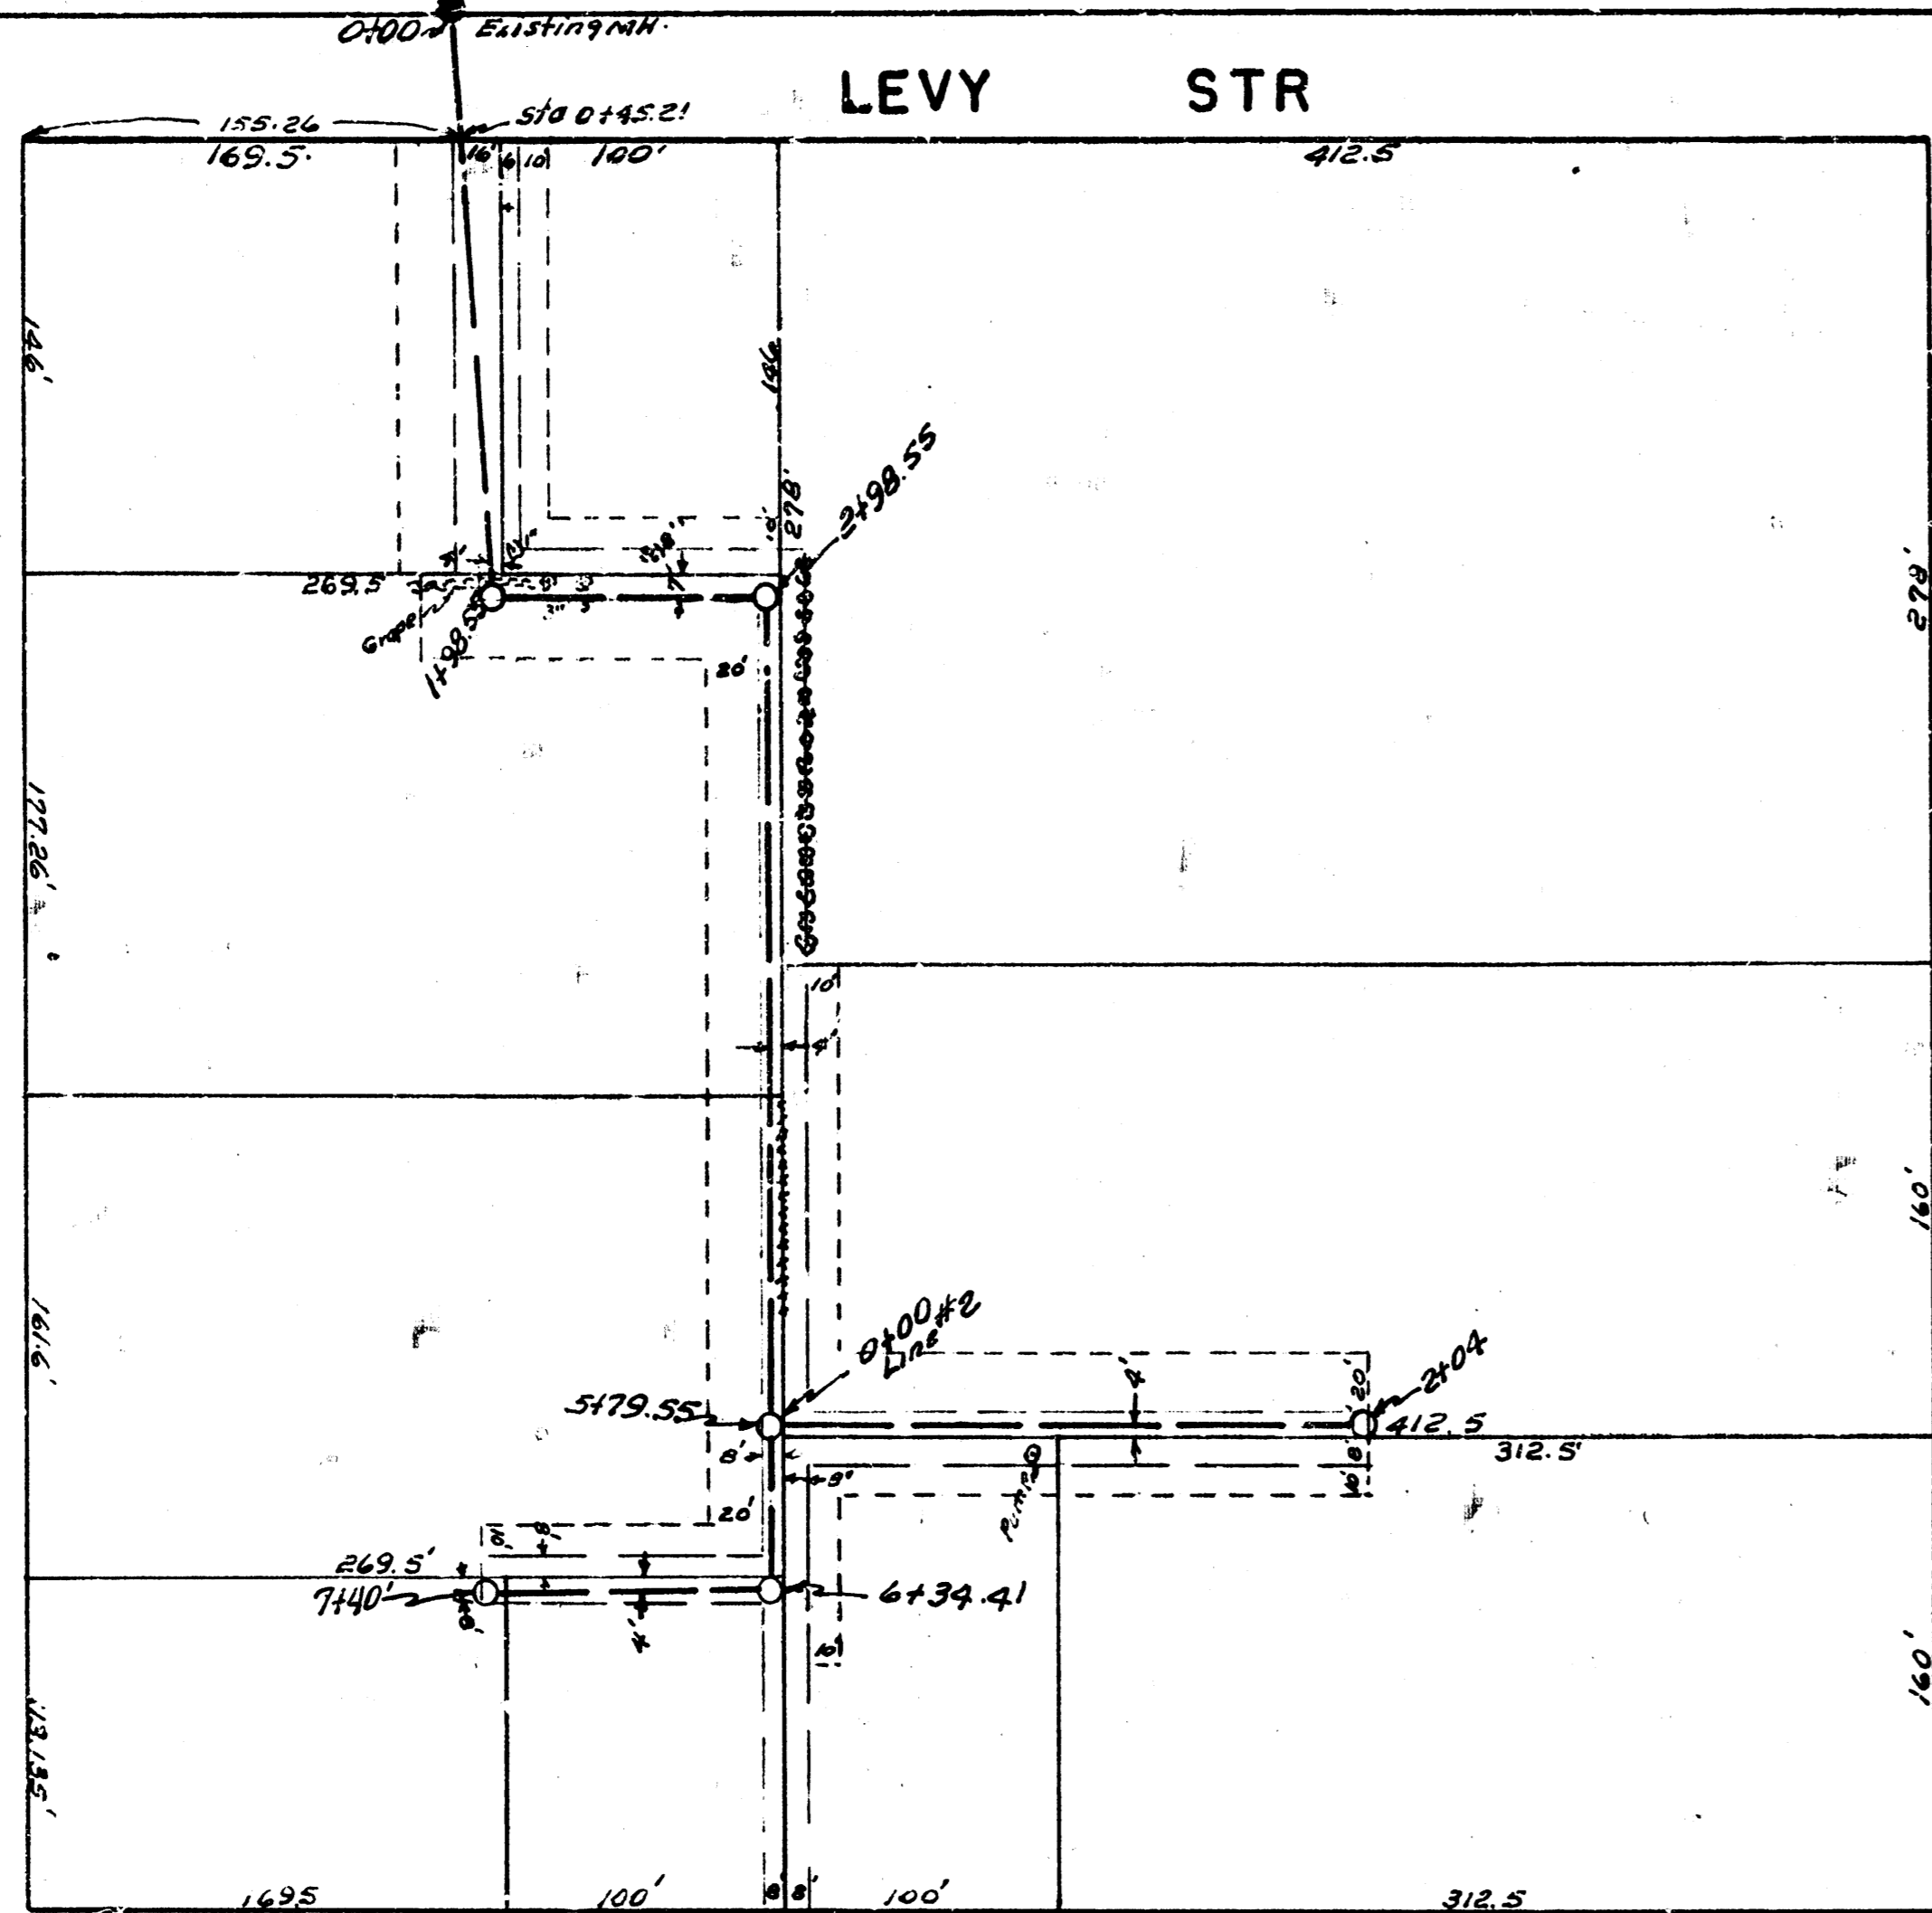


Date 9-19-52
 Drawn by M. C. Klein
 Checked by [Signature]
 Block No. N-26

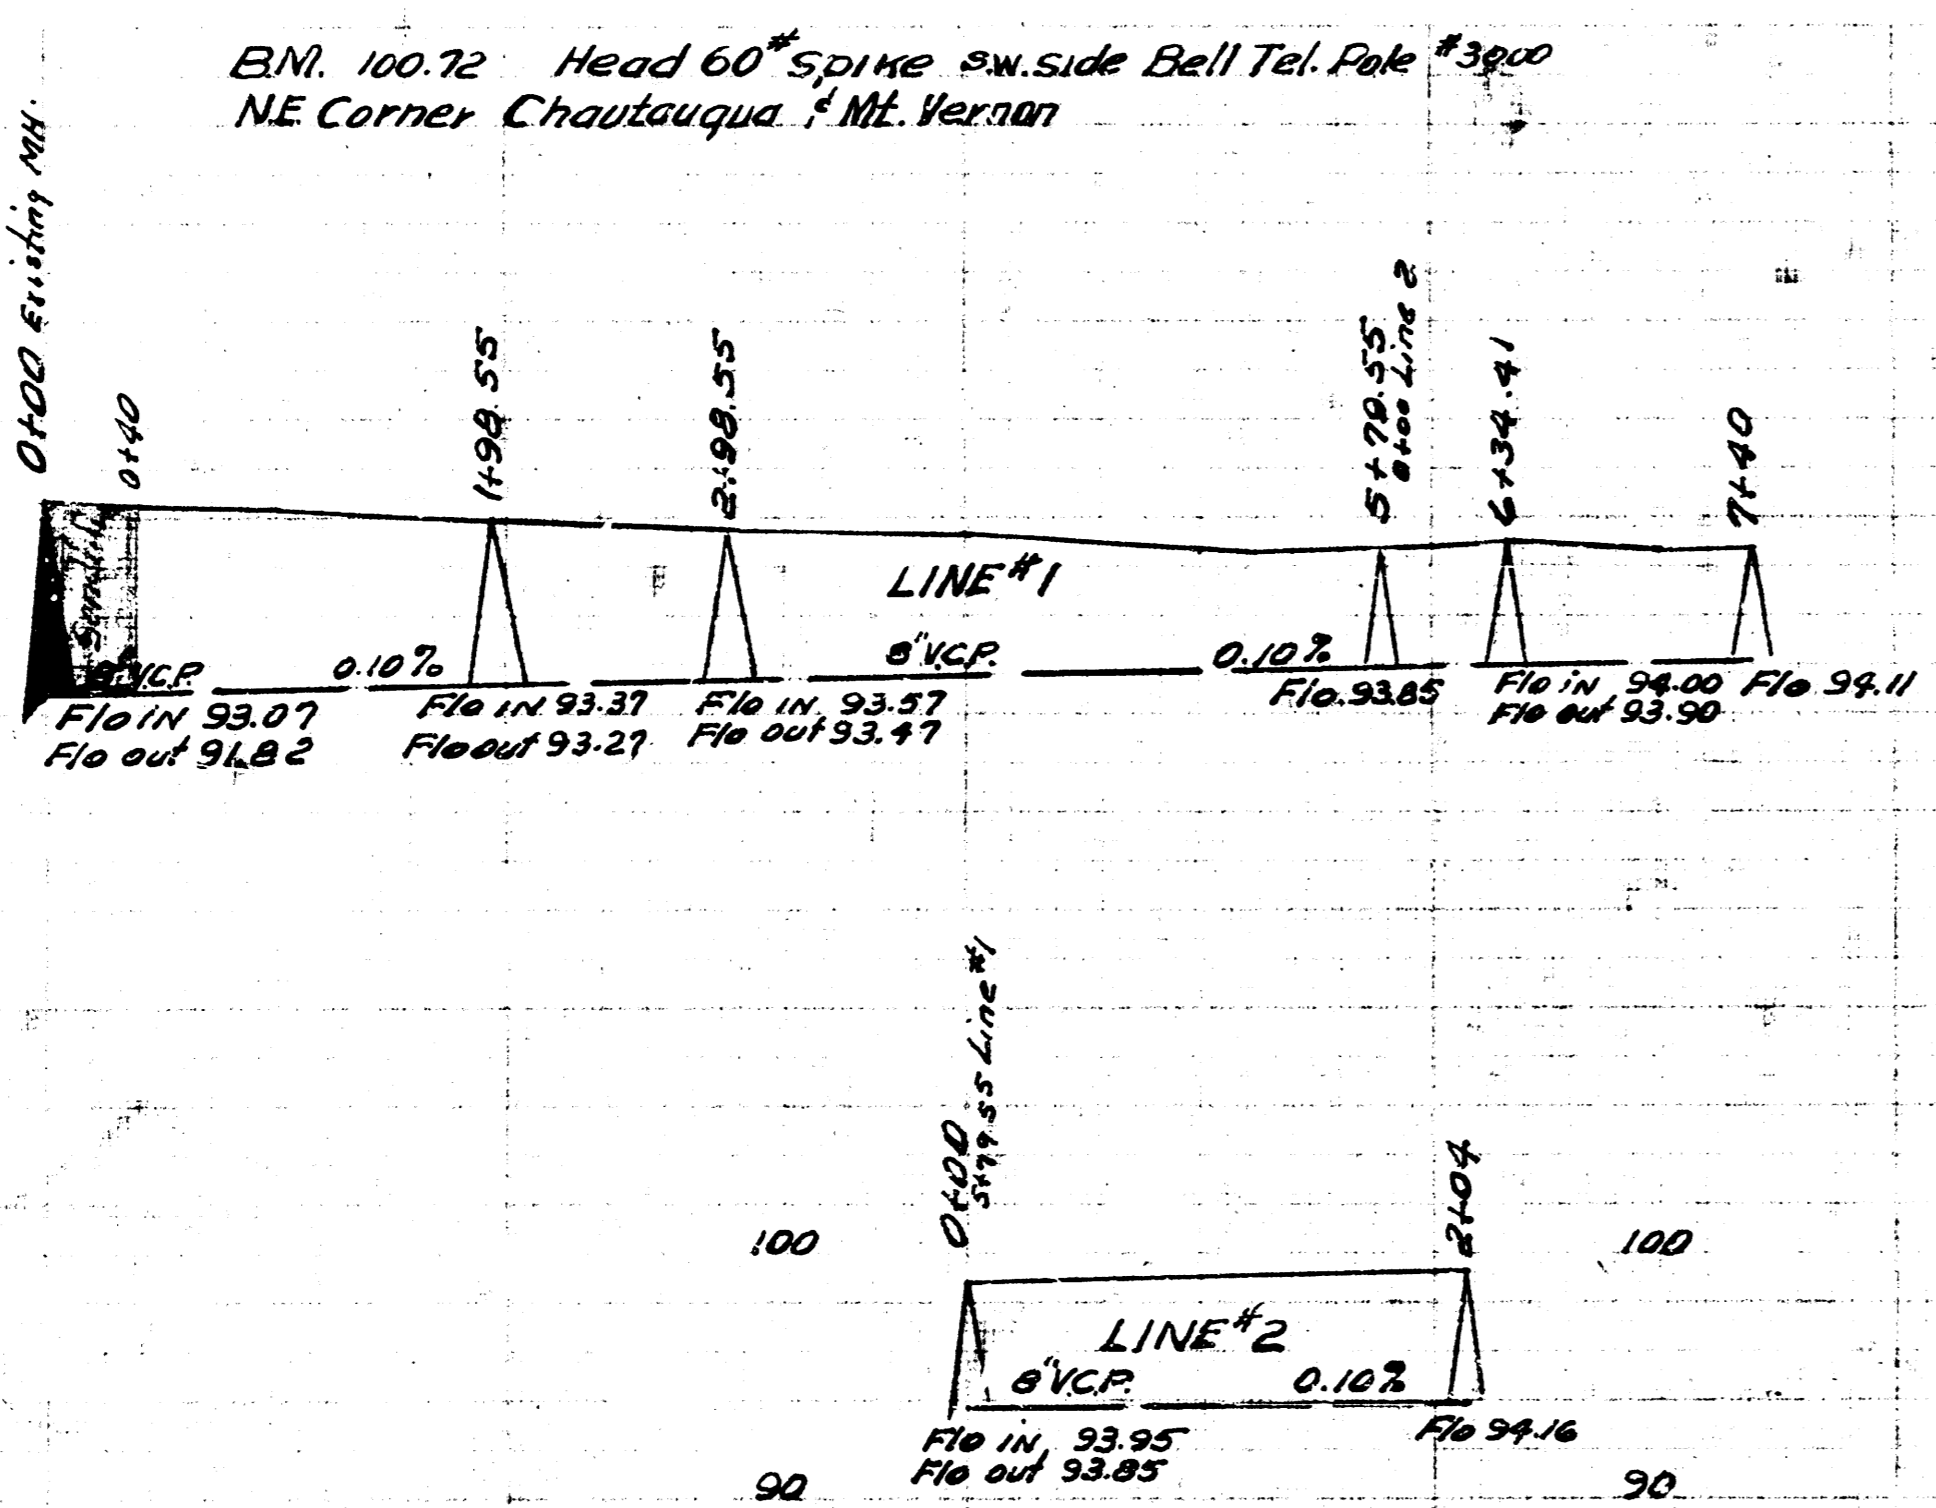


N
 Scale 1"=60'

N
 Scale 1"=60'

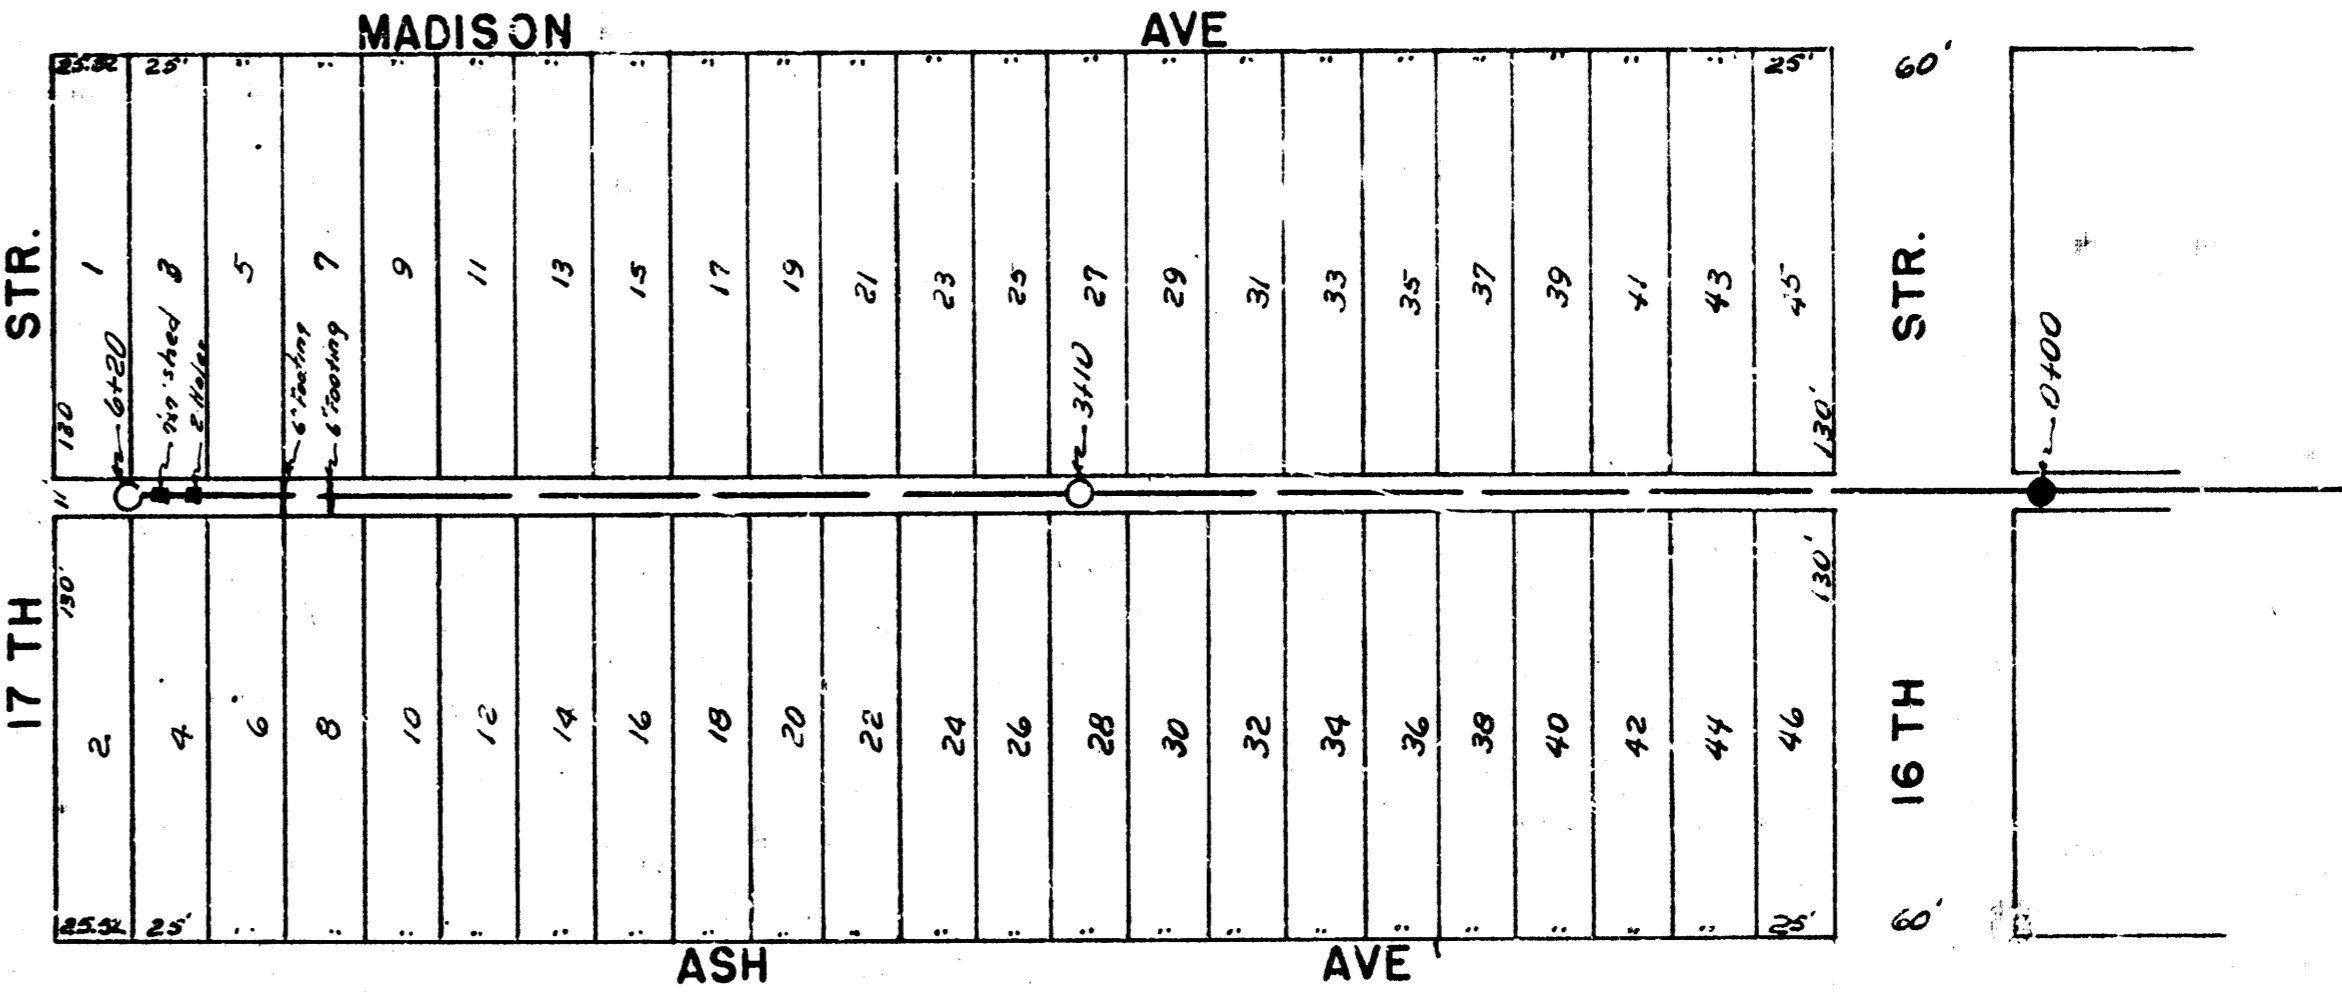

Date 9-23-52
 Drawn by M. C. Klein
 Checked by [Signature]
 Book No. 274

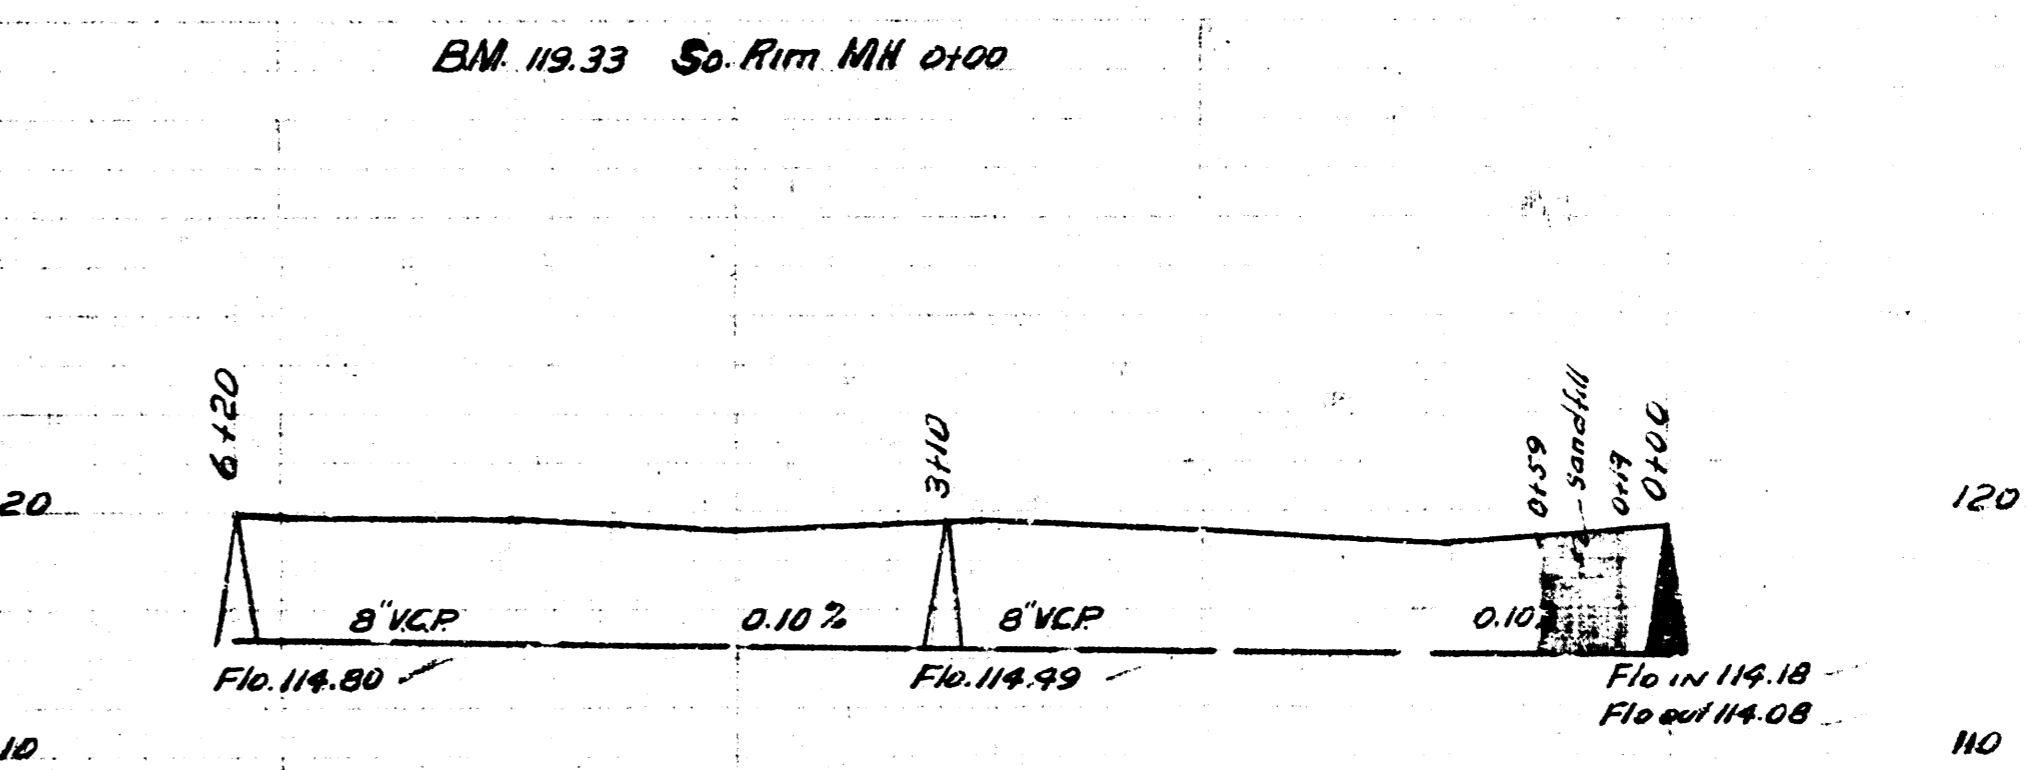

LAT 13 DC S 2 5512
 CITY OF WICHITA KANSAS
 LK WHITE CITY ENGINEER
 Proj No. C-22-29

LAT. Q DIST. D 5512
 CITY OF WICHITA KANSAS
 LK WHITE CITY ENGINEER
 Proj No. C-22-29

