

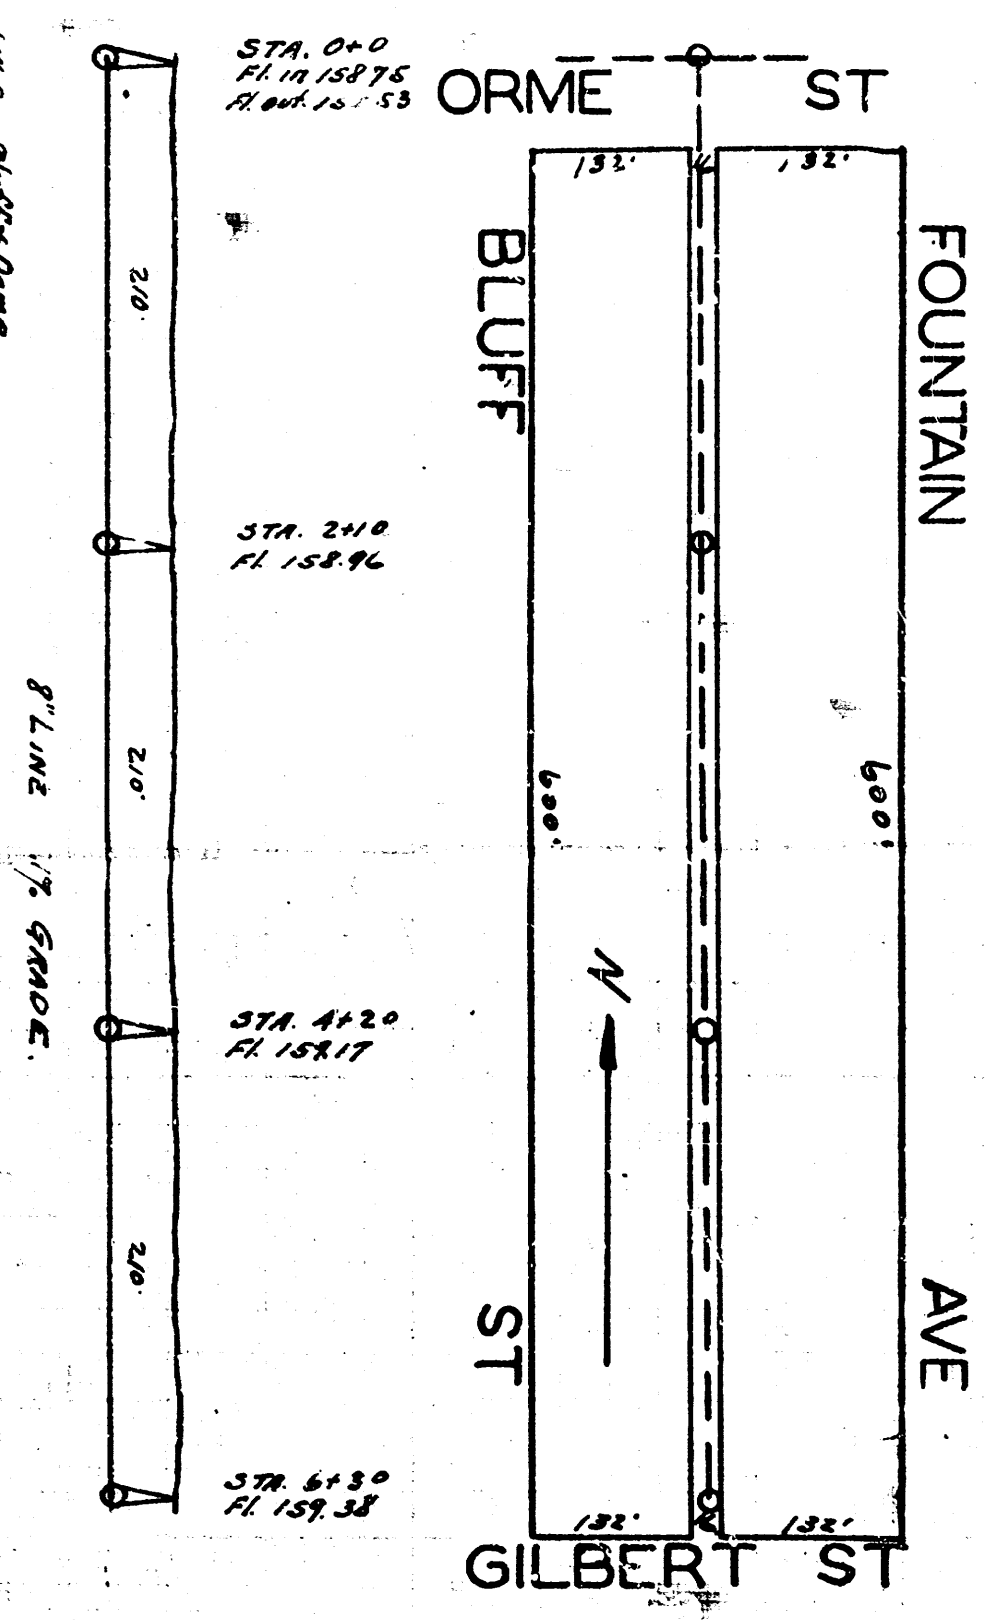








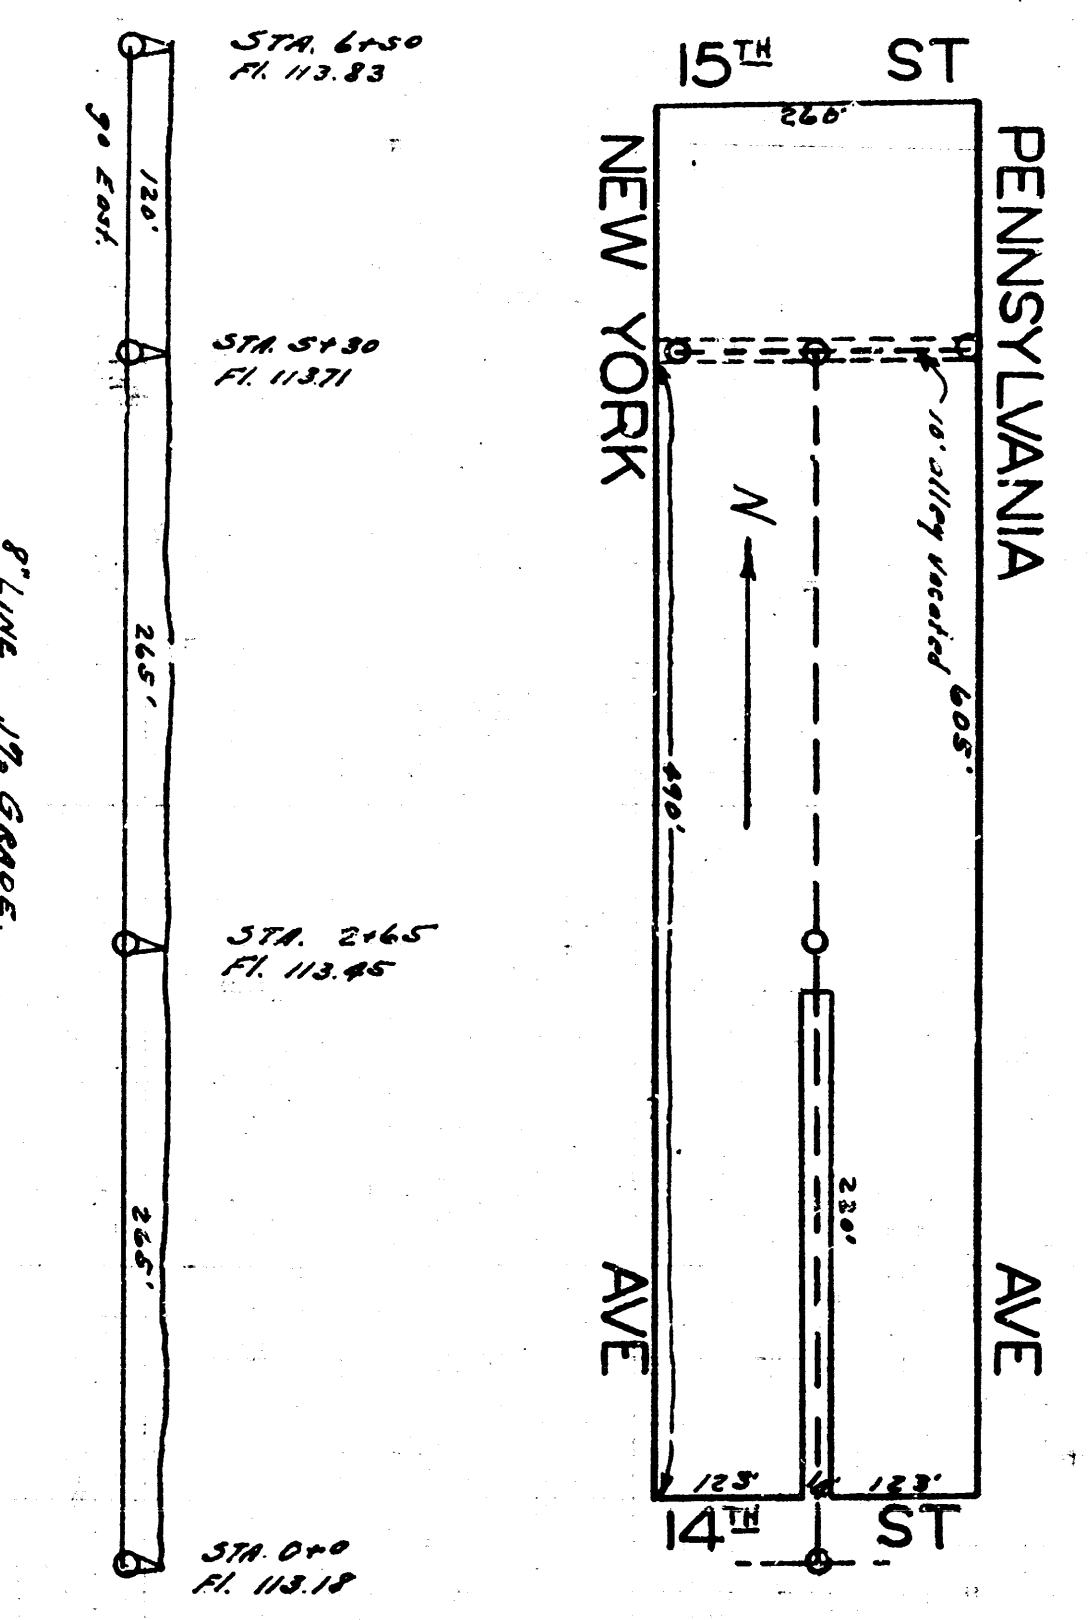

LAT. H, DIST. 6,
S.S. 12.

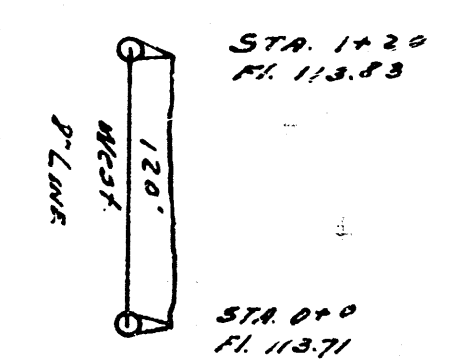

LAT. C, DIST. R, S.S. 12.

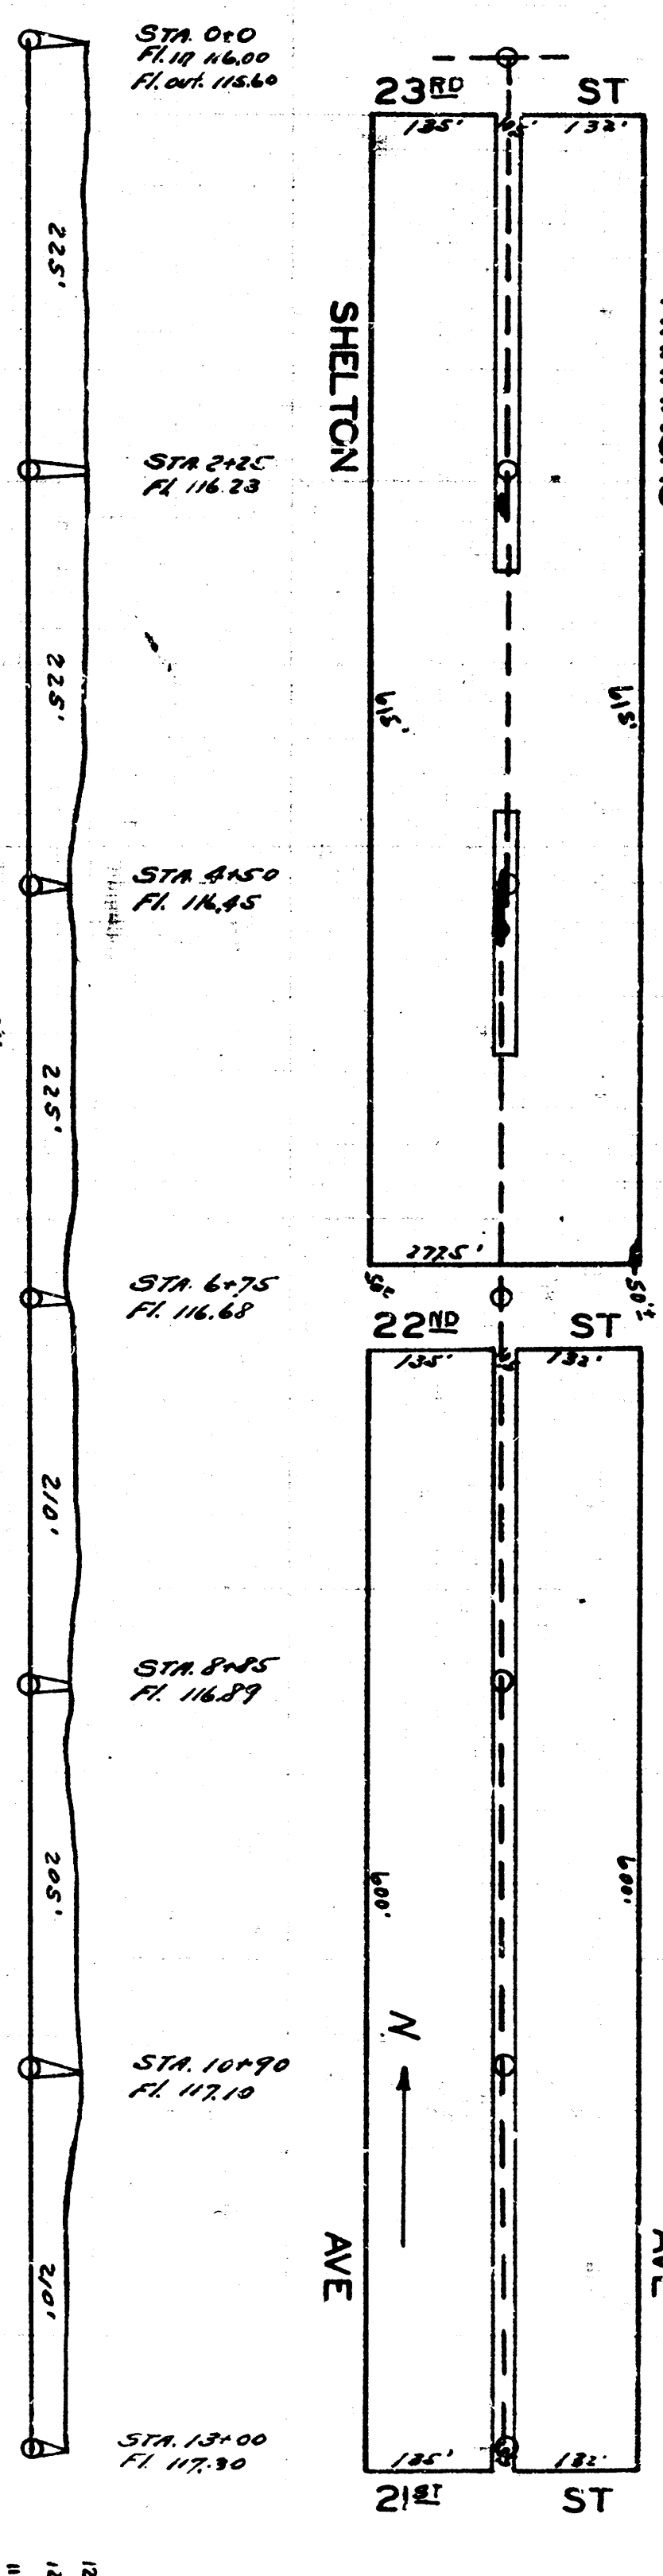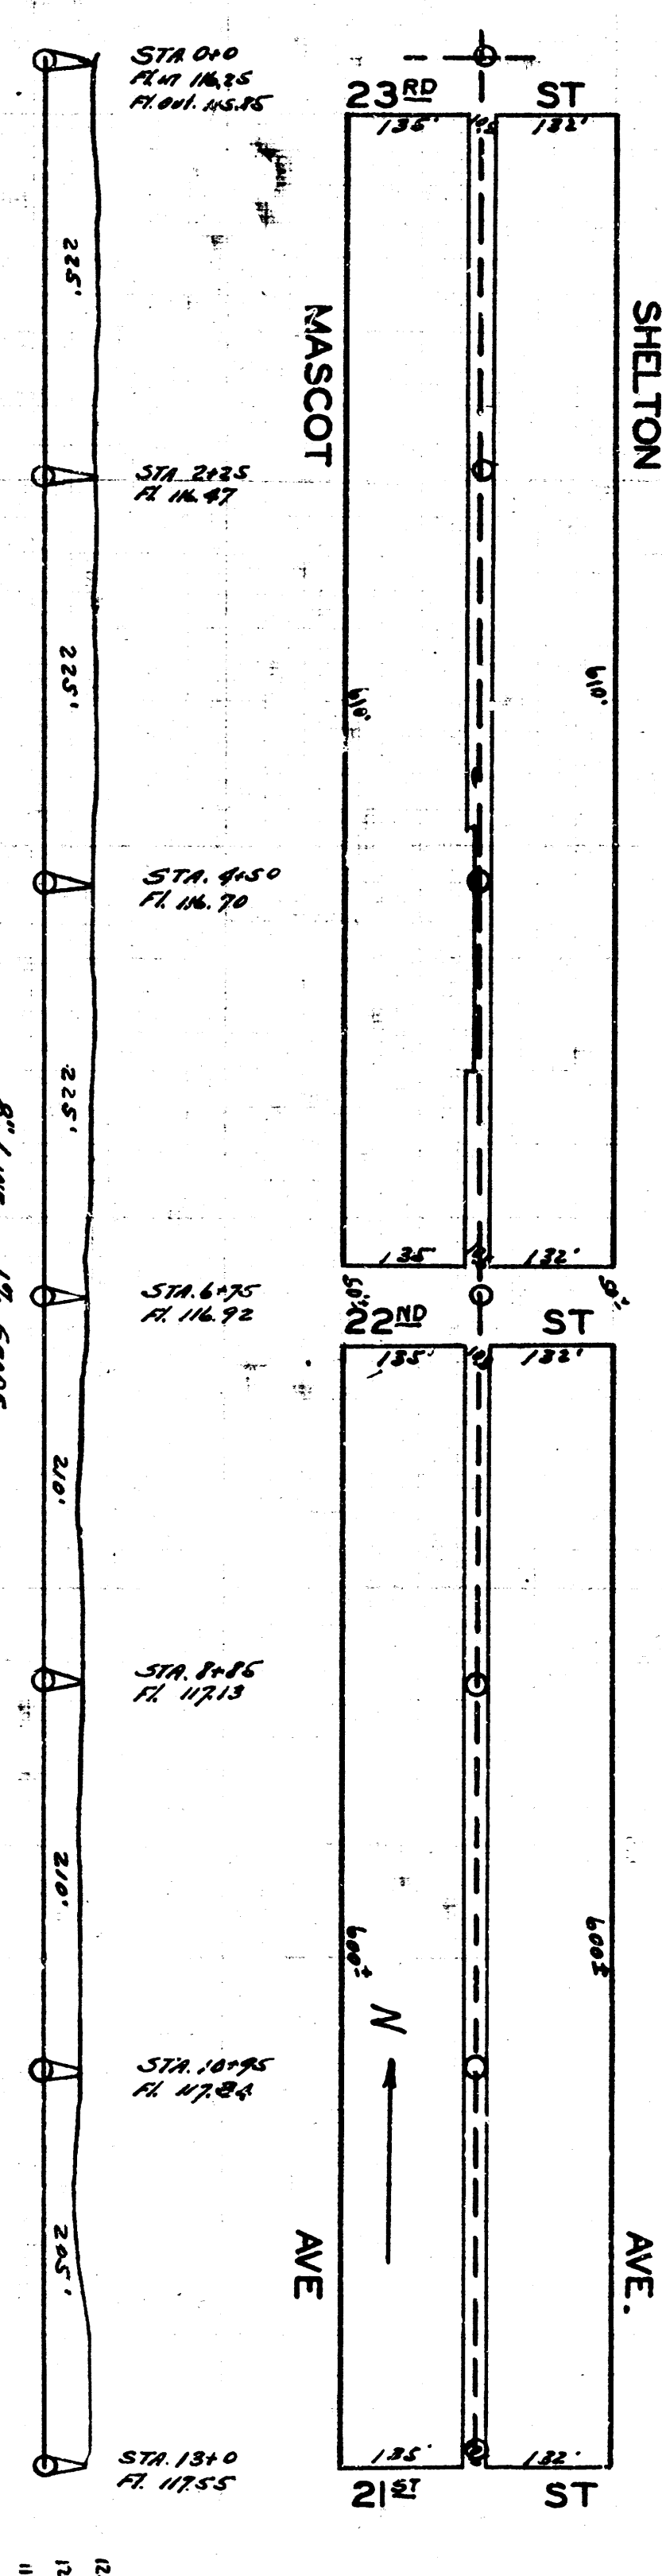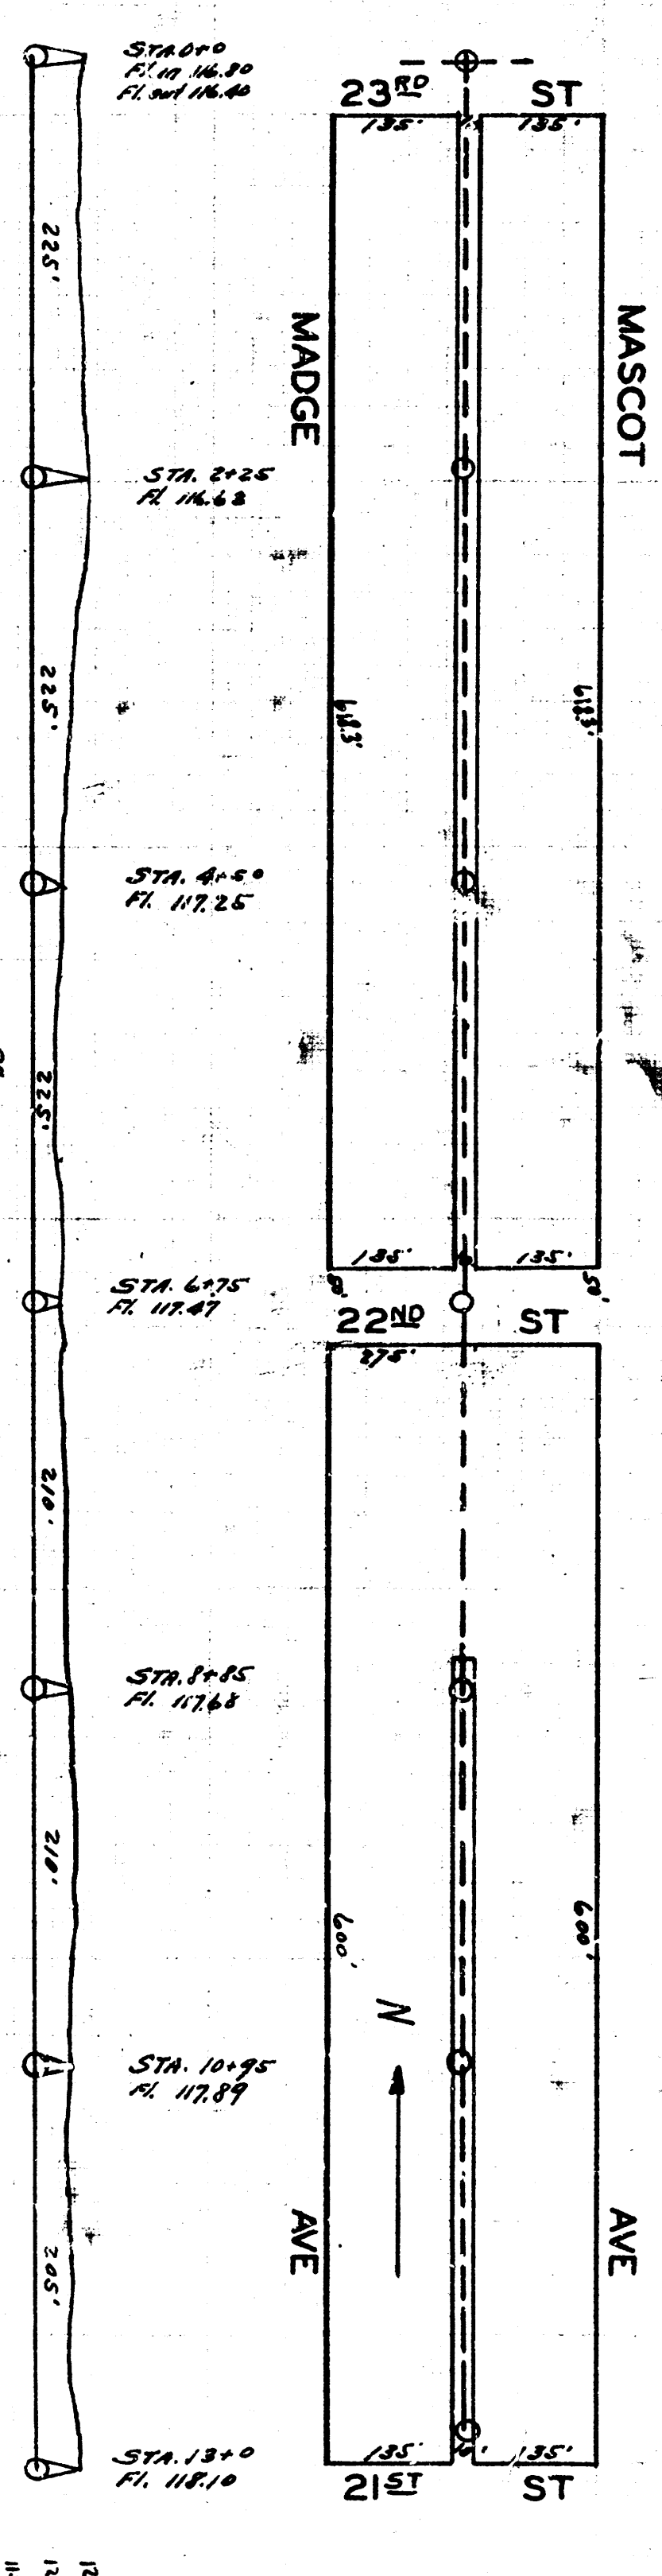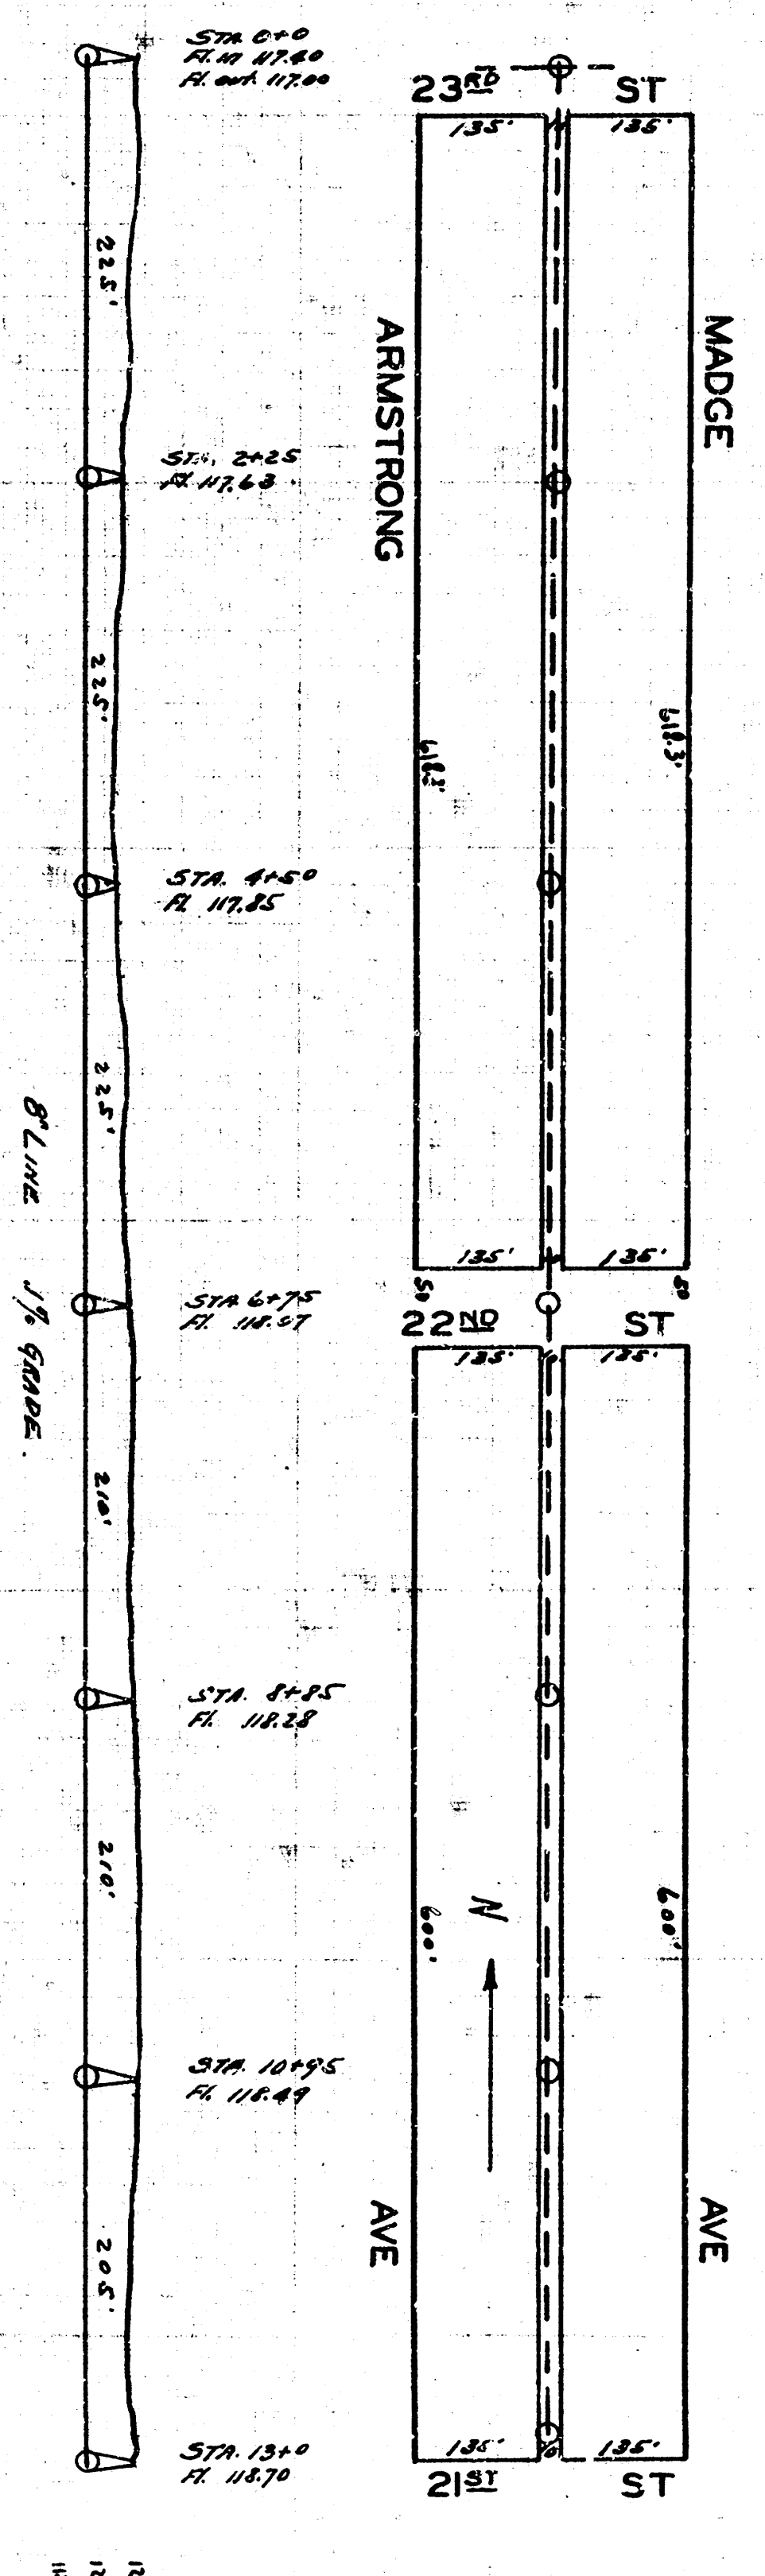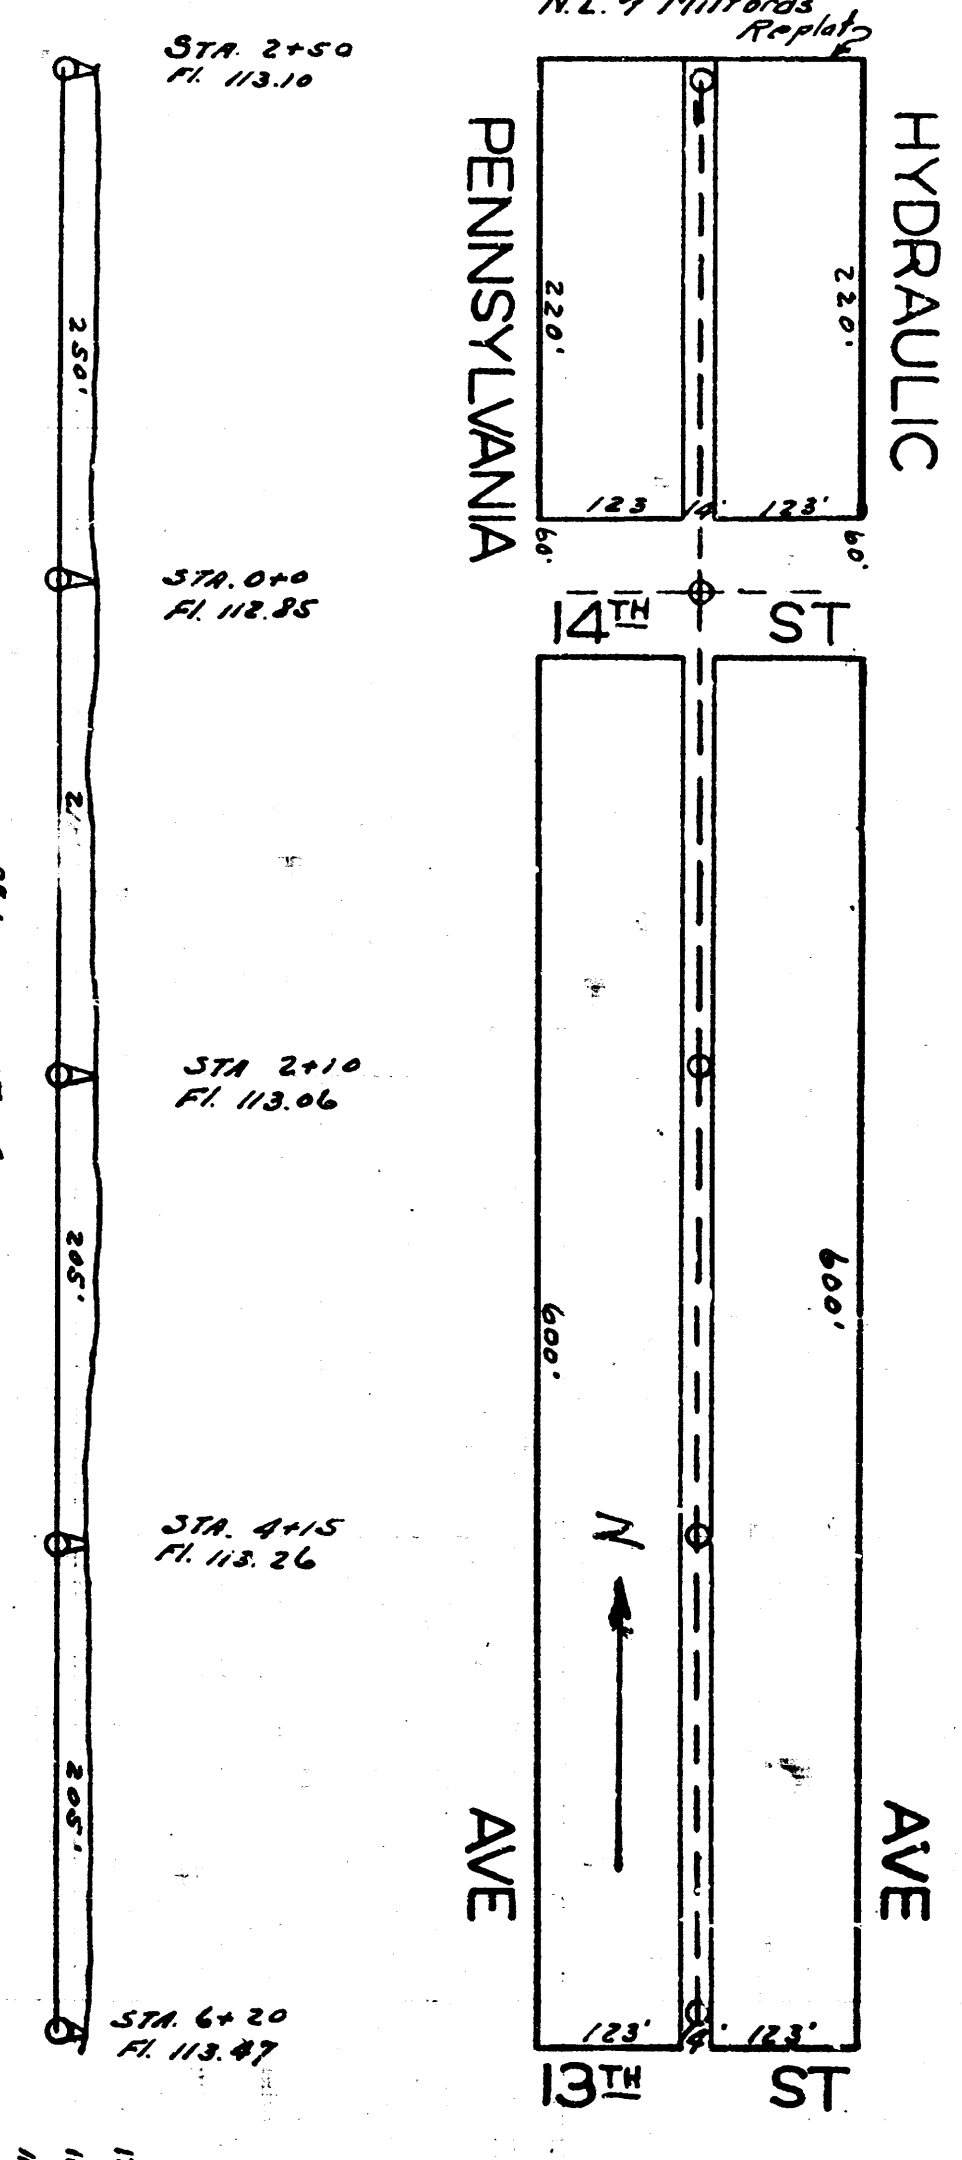

LAT. E, DIST. T, S.S. 20.

1/4" = 100' 1/2" = 200' 3/4" = 300' 1" = 400' 1 1/4" = 500' 1 1/2" = 600' 1 3/4" = 700' 2" = 800' 2 1/4" = 900' 2 1/2" = 1000'