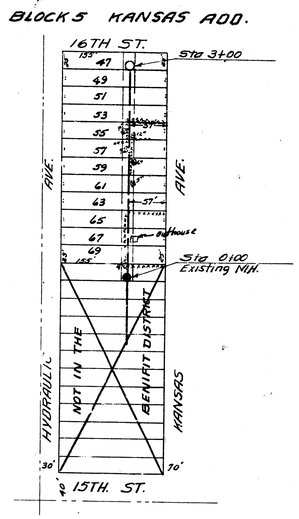

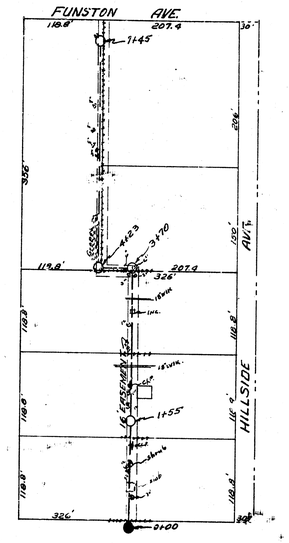
FUNSTON AVE.
118.8'
207.4
36'
1+45
326'
4+23
3+70
118.8'
207.4
326'
206'
130'
AVE.
118.8'
118.8'
118.8'