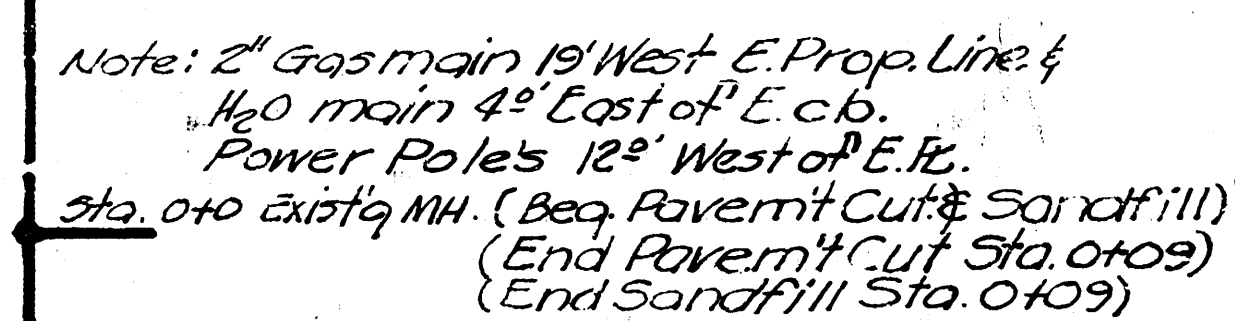


CITY OF WICHITA, KANSAS

L.K. WHITE
DATE: 9-20-50

CITY ENGINEER
PROJ. NO. C20-63