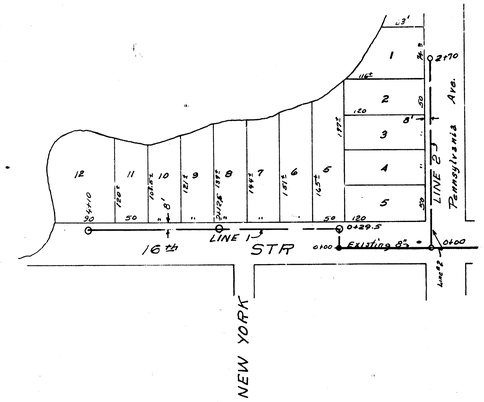

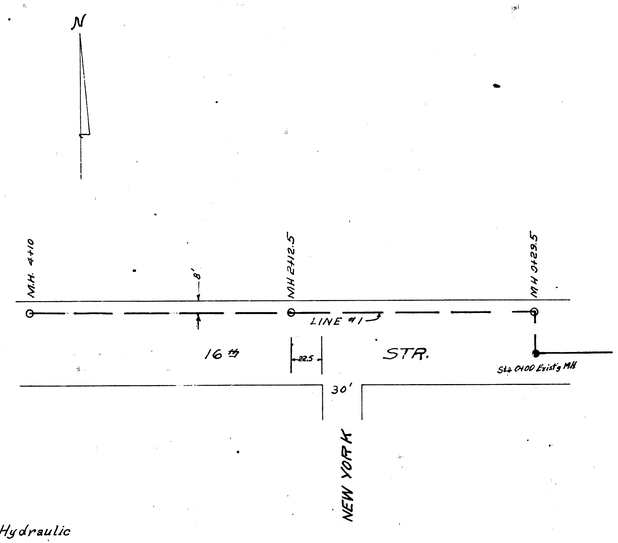

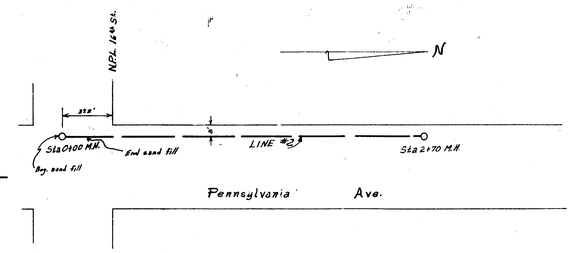

B.M. 116.41 No rim of thimble, 16th & Hydraulic

Sand fill Lines 1 & 2 Sta's 0+00 to 0+25

NOTE SCALE :-
1" = 4' VERT.
1" = 40' HORIZ.

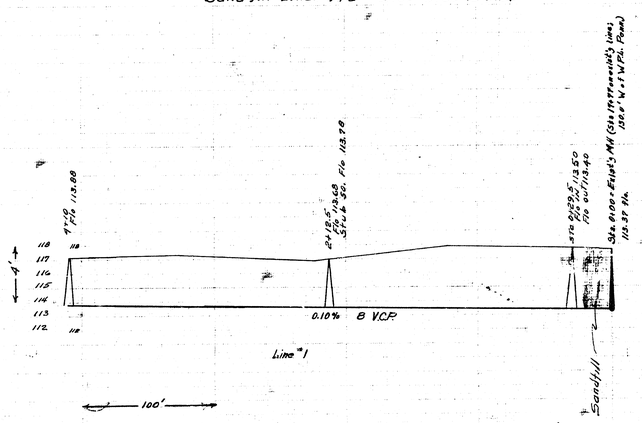

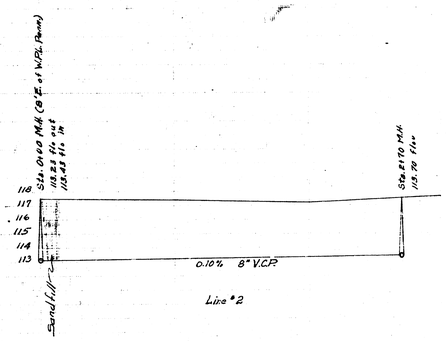

Date 1-19-52
Drawn by L.K.W.
Checked by J.E.
Book No. M 85

LAT. 4, SUB Y. SS # 12
City of Wichita, Kansas
L.K. White City Engineer
March 1951 Proj. No. C21-14