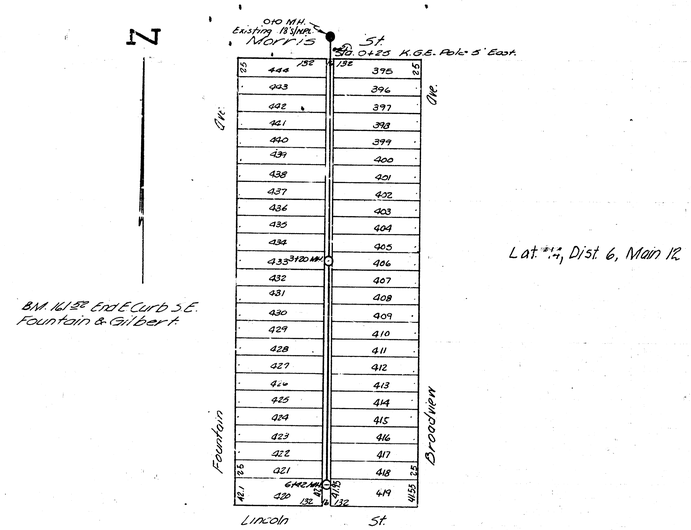

Lat. 14, Dist. 6, Main 12

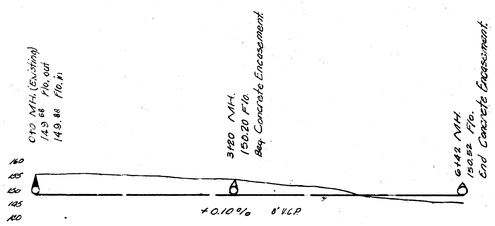

Lat. 14, Dist. 6, Main 12

City of Wichita Kansas

L.K. White City Engineer

July 1948 Proj. No.