




YALE AVE.		ZIMMERLY AVE.	


P.M. 127.2m. W. 2m. M.M. Alley Bet. Clifford & Vassar

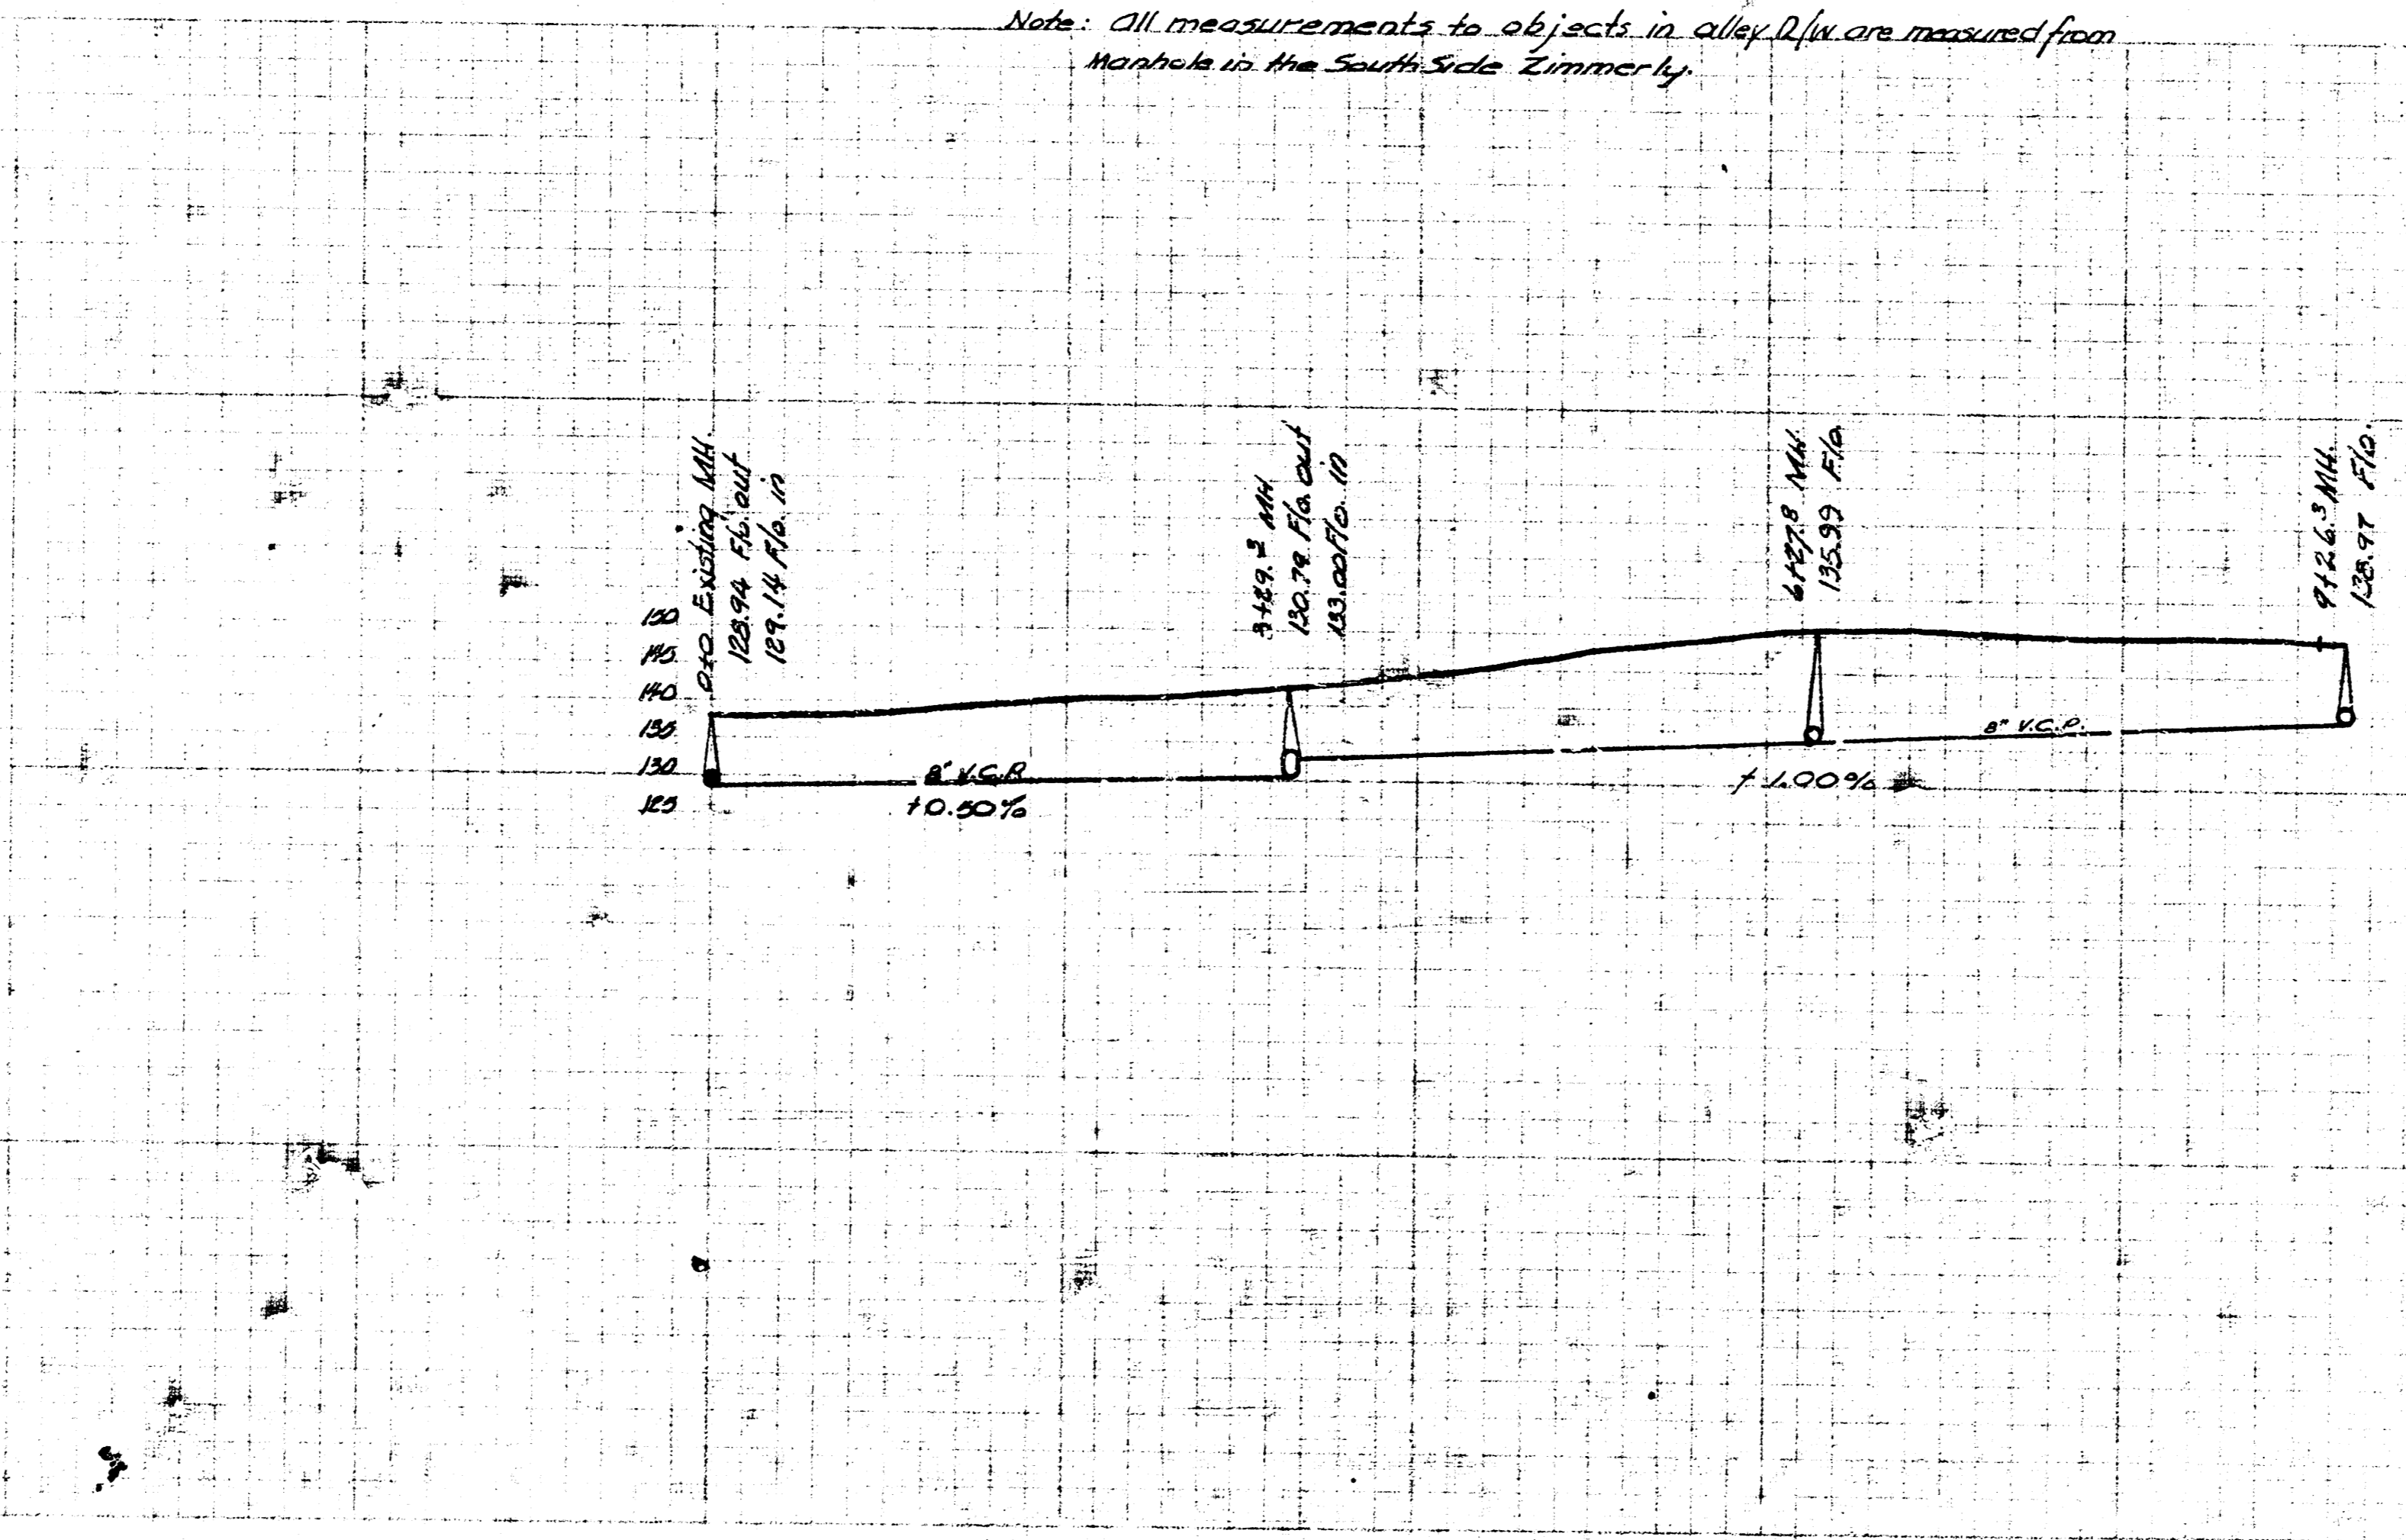

LAT 15, DISTG, S.S. 12
 CITY OF WICHITA, KANSAS
 L.R. WHITE - CITY ENGINEER
 DATE 5-14-48 PROJ. NO. C28-36