
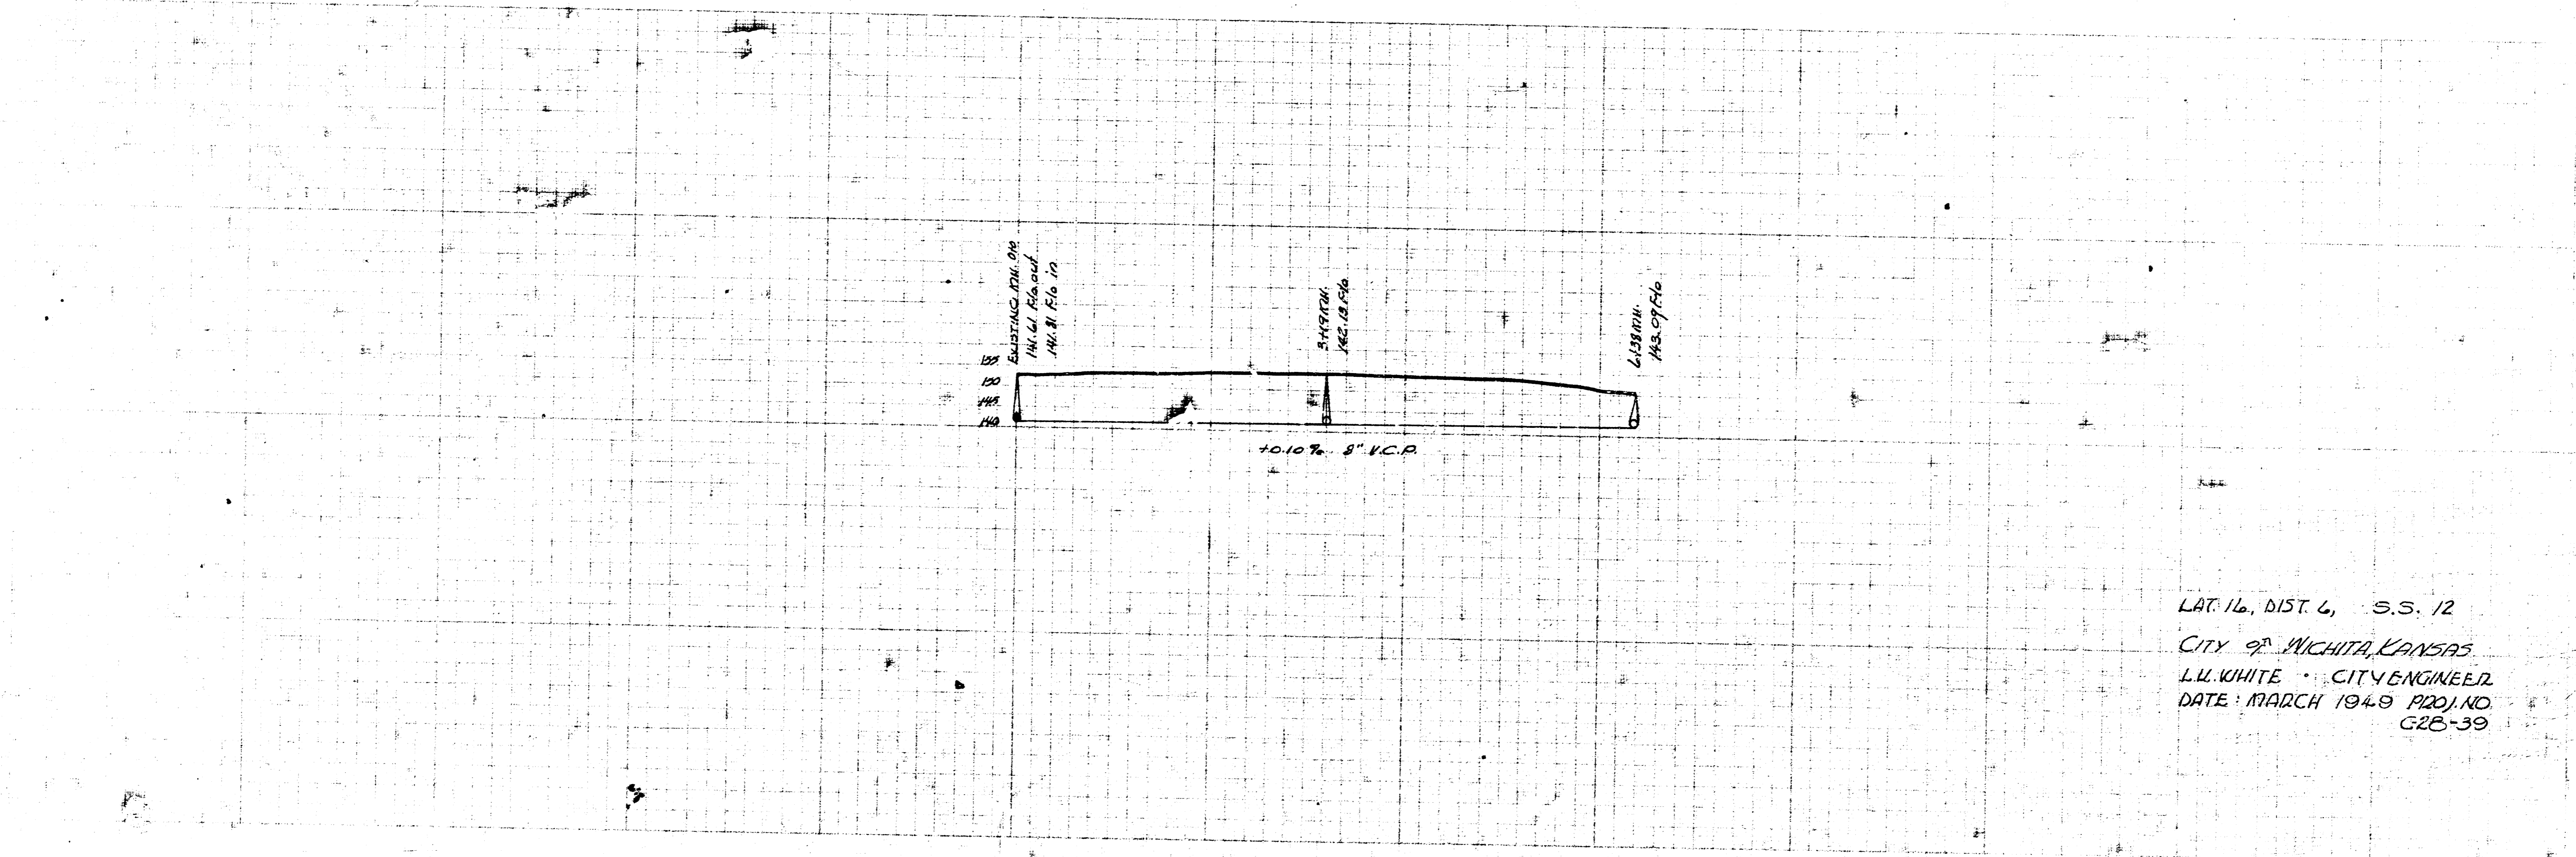


BAR - 14.25 N.E. Cor. Conc. Walk Rear Ho. # 1006 Yale

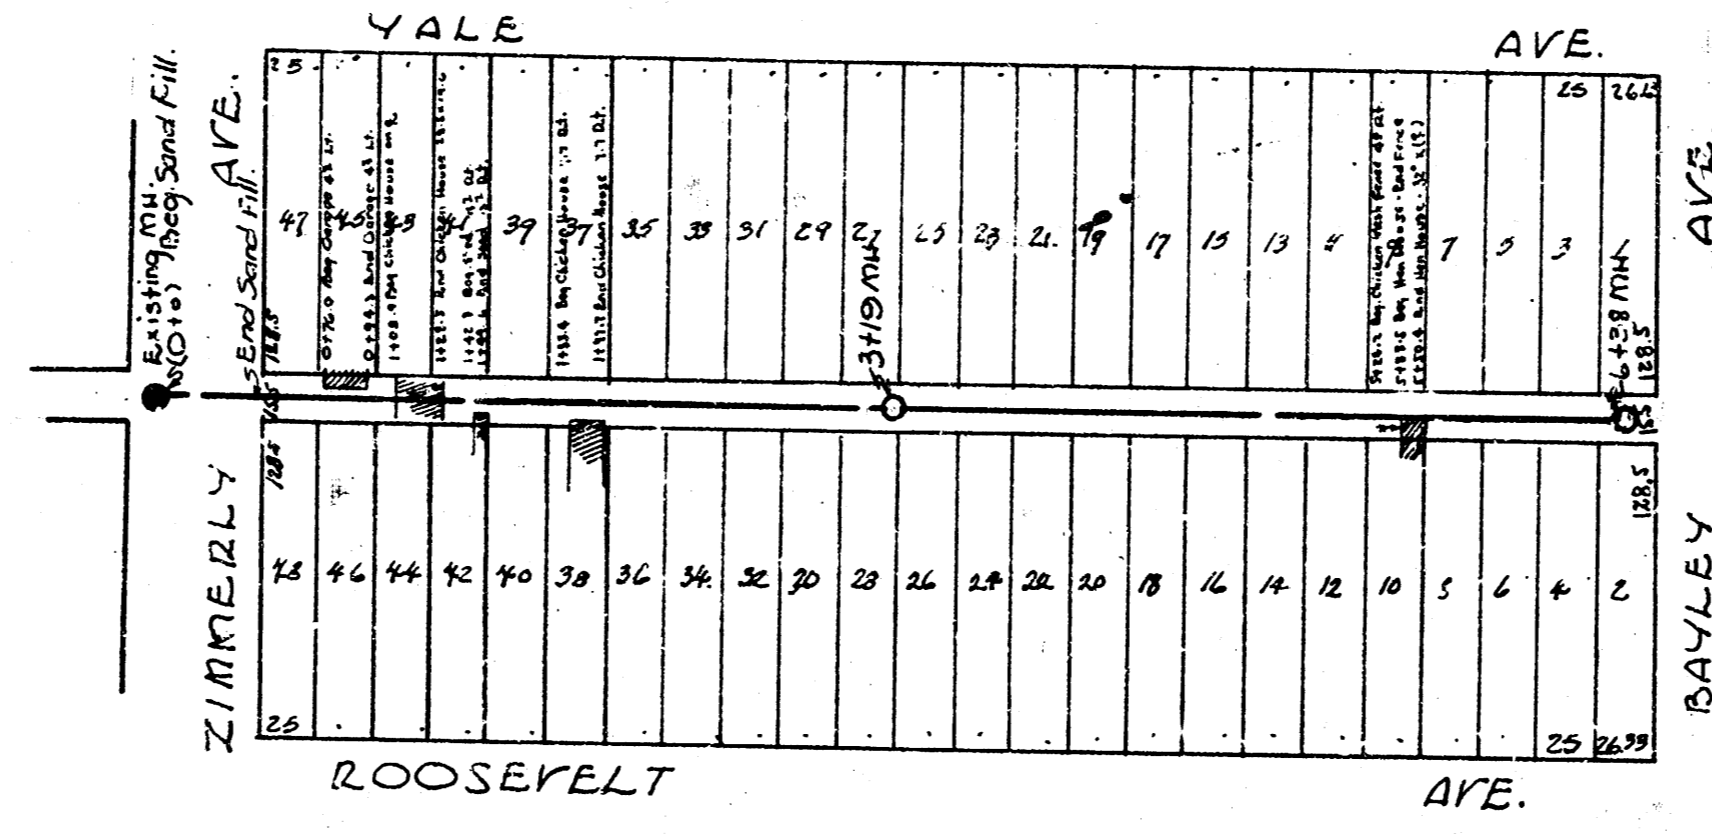

LAT. 16, DIST. 6, S.S. 12
 CITY OF WICHITA, KANSAS
 L.L. WHITE, CITY ENGINEER
 DATE: MARCH 1949 P201 NO
