



SANITARY SEWER PLANS
KRUG SOUTH ADDITION
PHASE 1

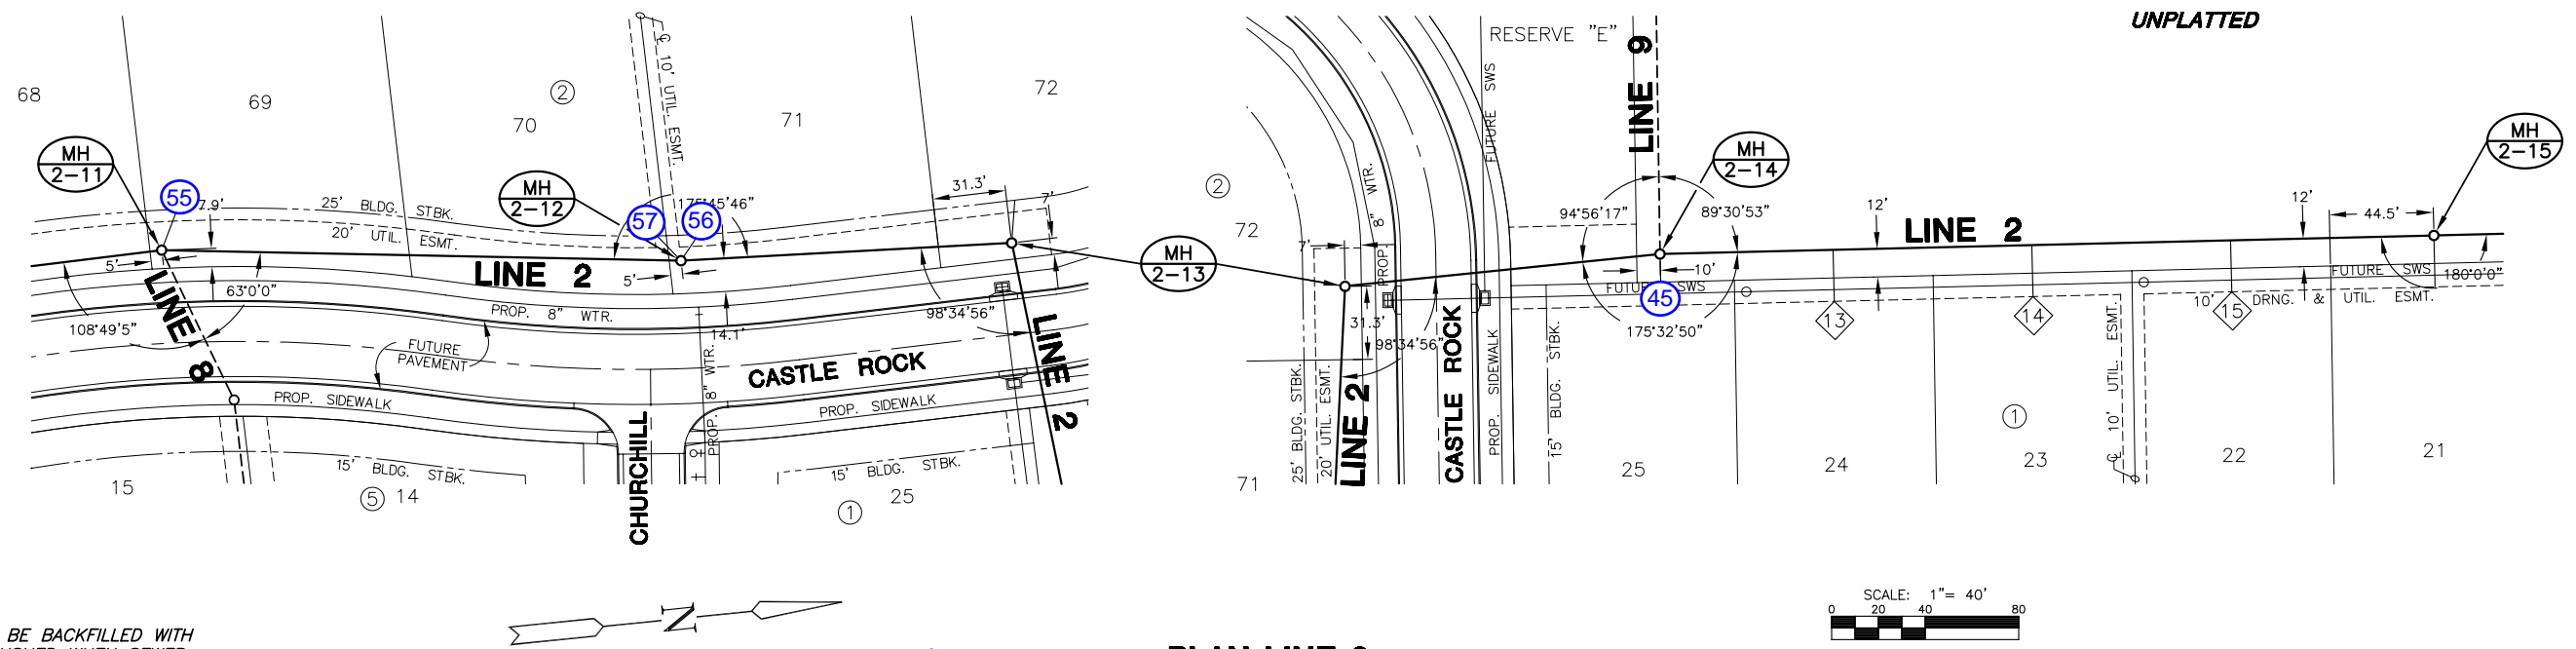

NOTE:
TRENCHES TO BE BACKFILLED WITH SAND AND FLUSHED WHEN SEWER LINE RUNS ALONG FRONT OF LOTS.

PLAN LINE 2

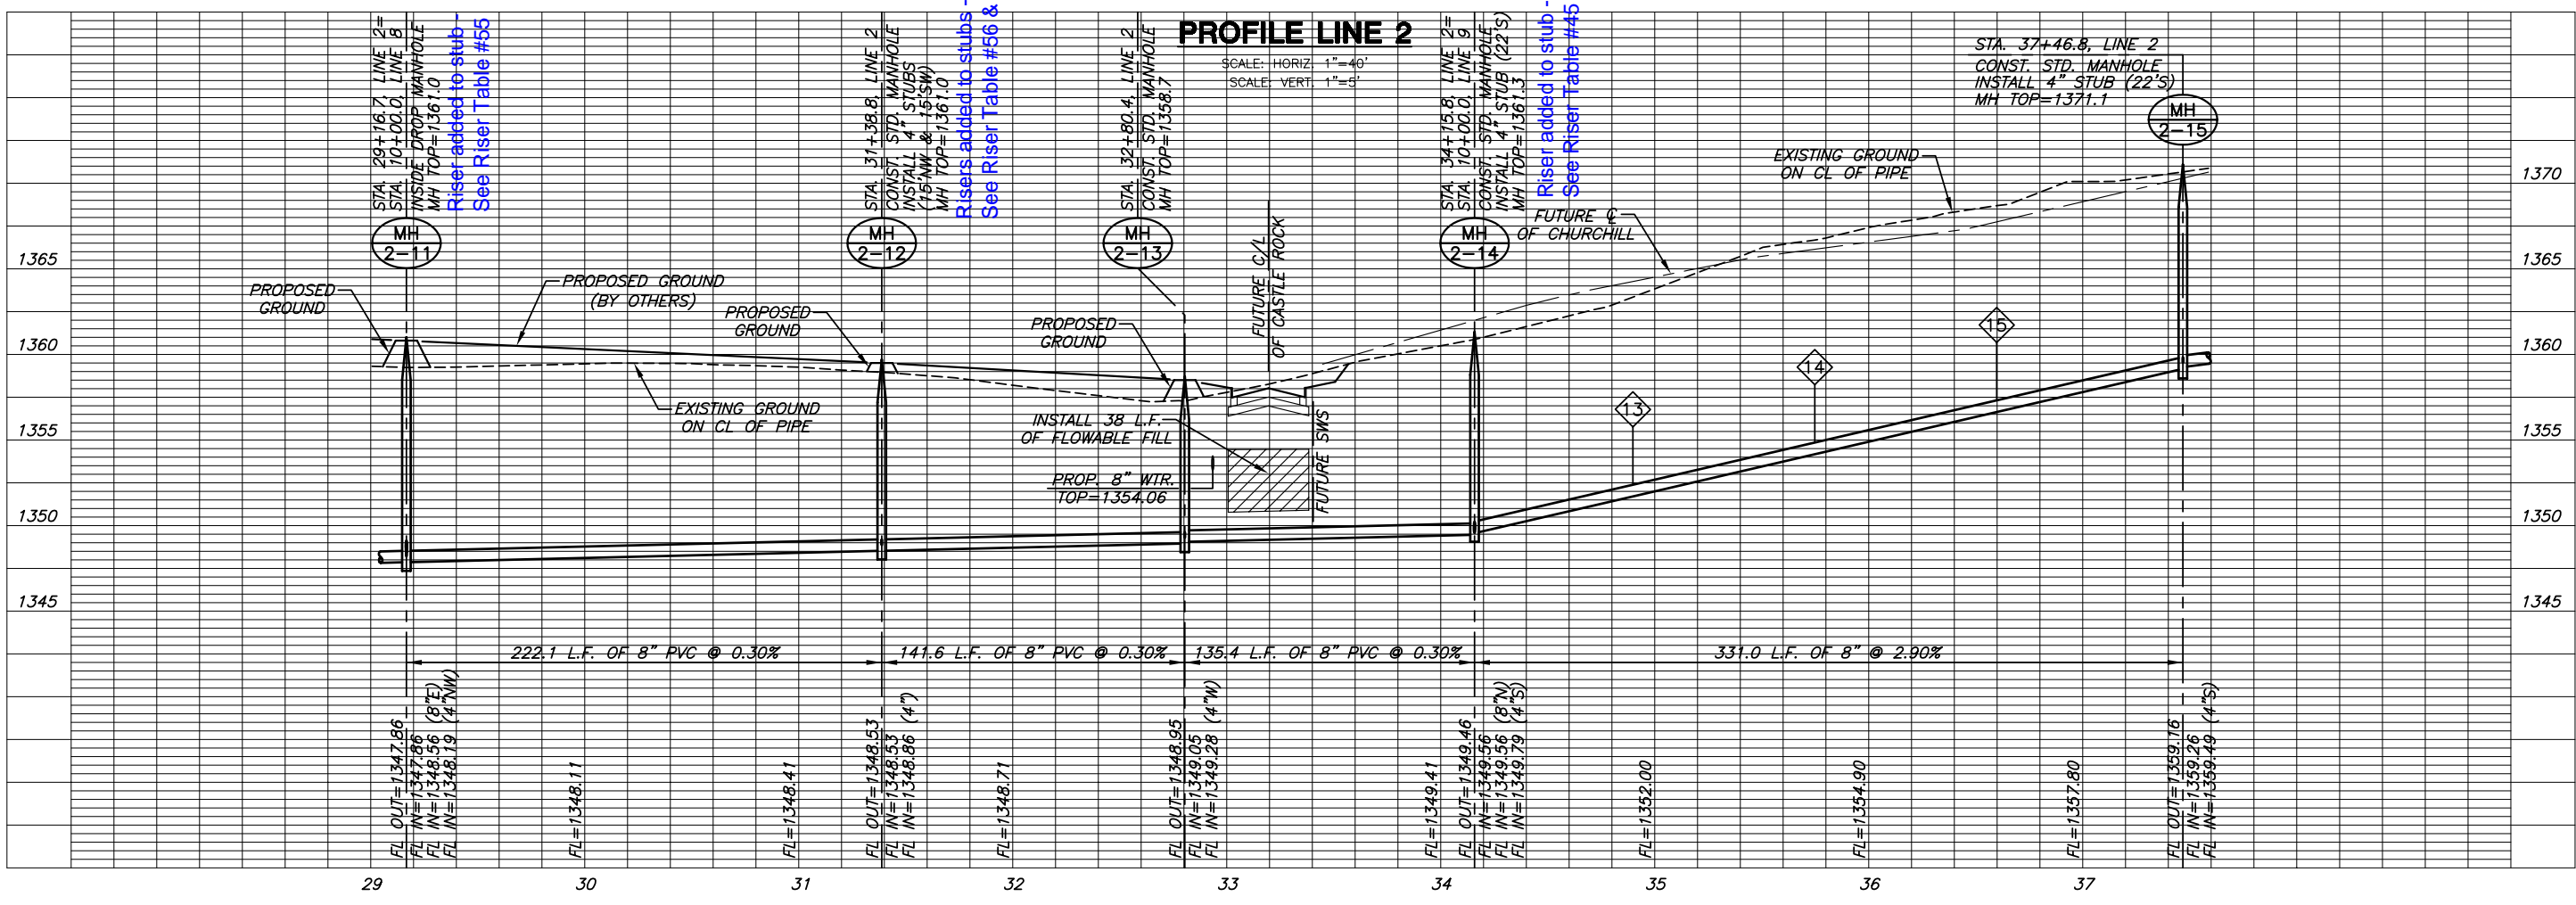

PROFILE LINE 2

LINE 2
SHEET TITLE
468-84321
PROJECT NUMBER

DESIGN BY: DFL
DRAWN BY: DMU
CHECKED BY: GJA

ISSUED: February 2007
REVISED:

SHEET NO.
13 of 31