
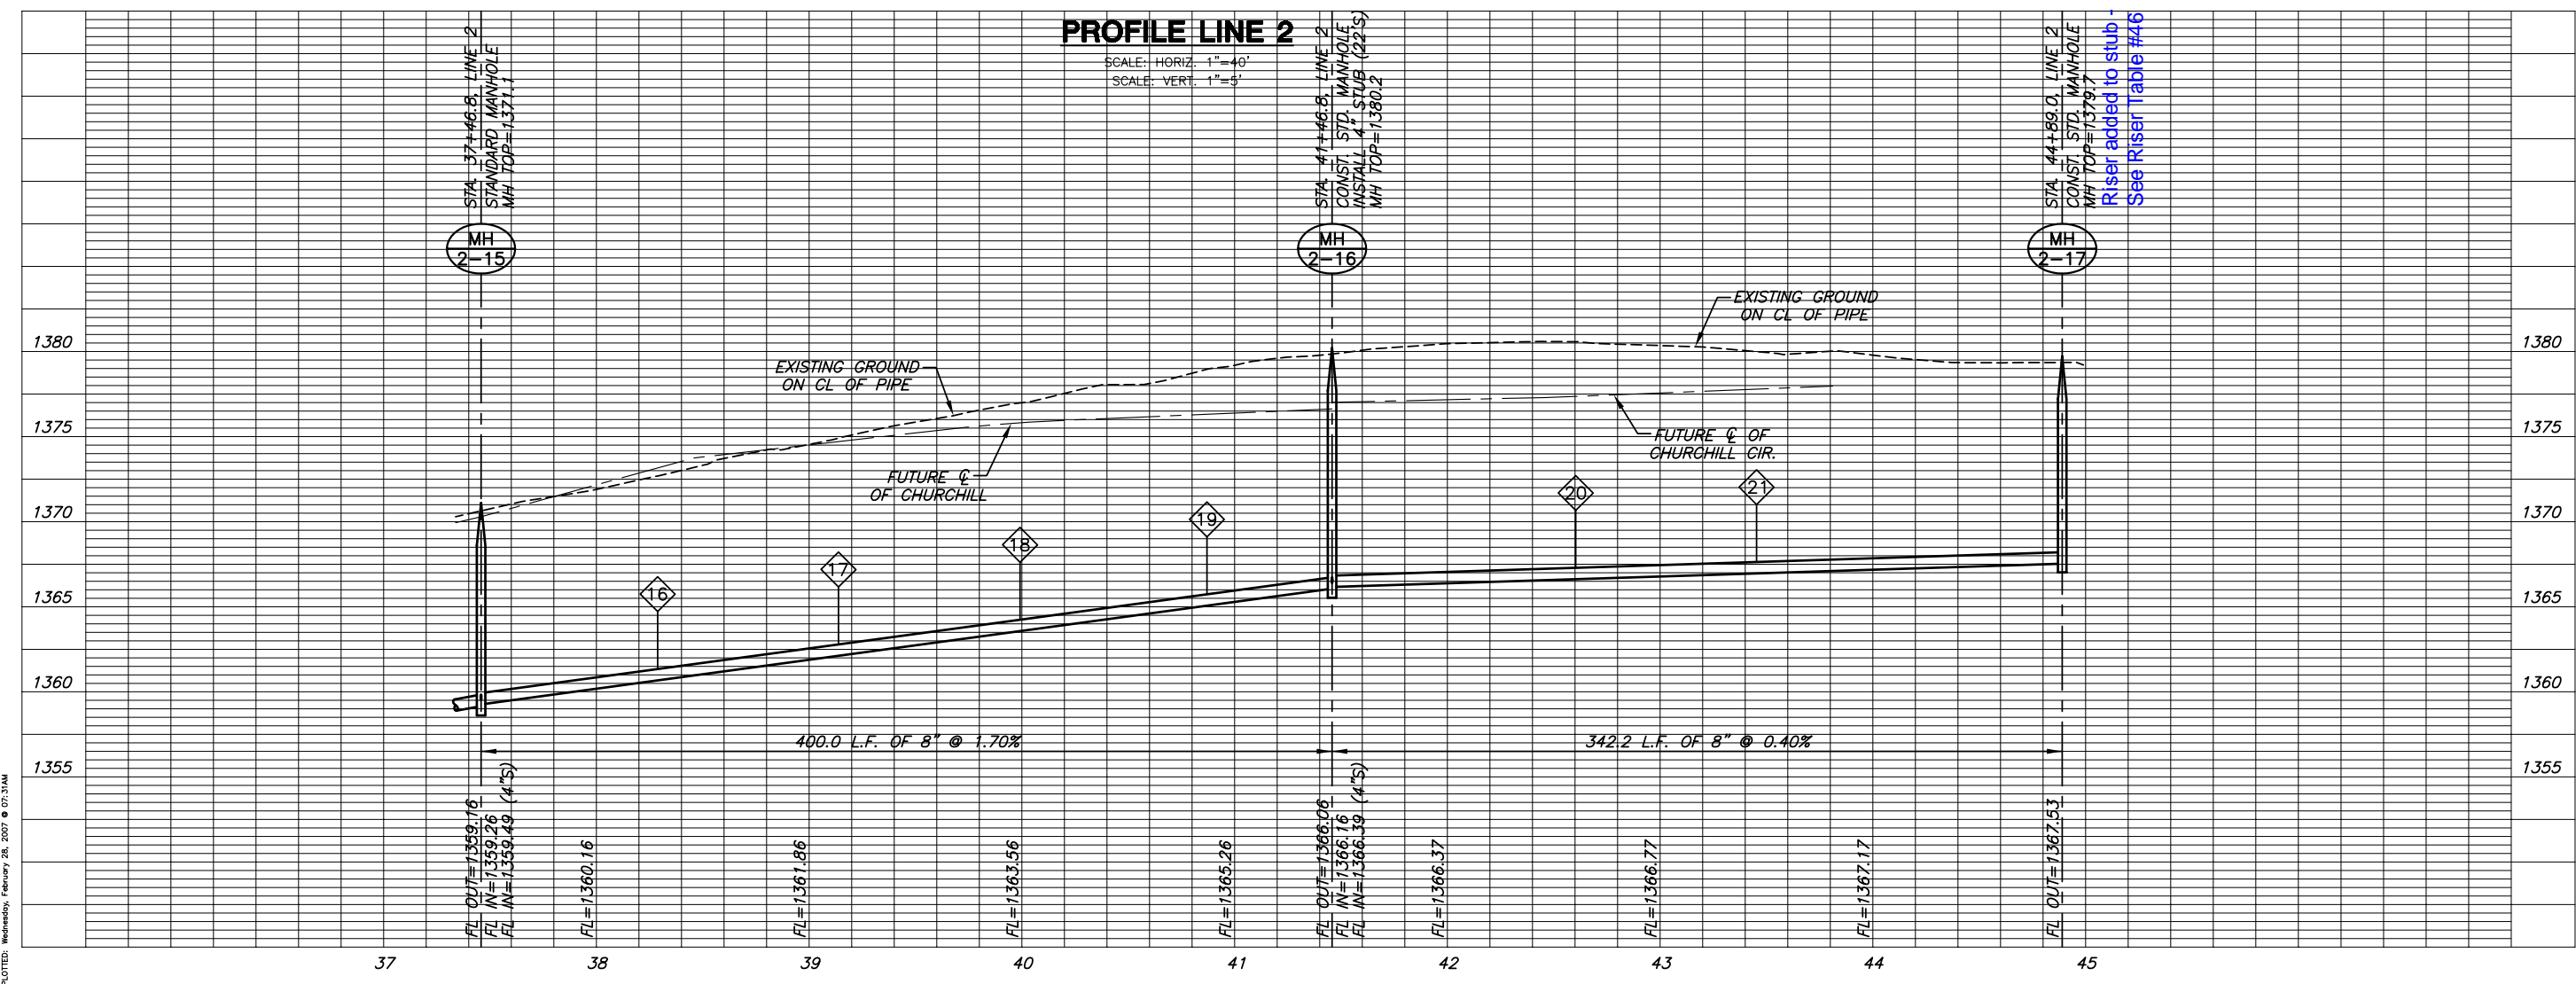


**SANITARY SEWER PLANS**  
**KRUG SOUTH ADDITION**  
**PHASE 1**

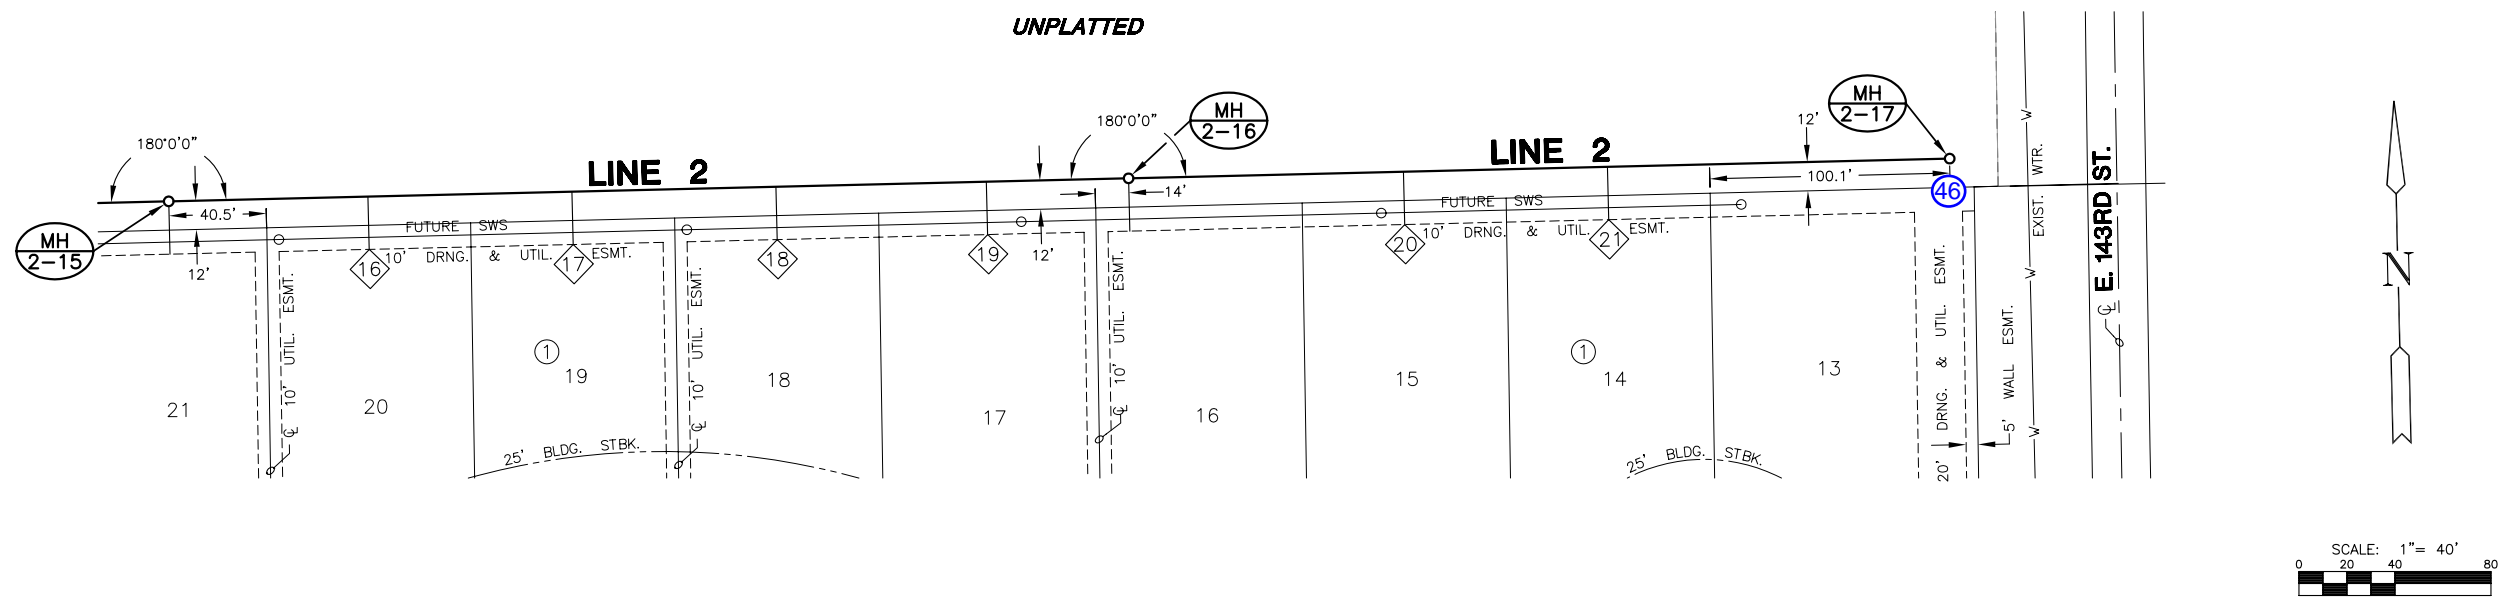

PLOTED: Wednesday, February 28, 2007 @ 07:37AM

J:\CIVIL\05291\DWG\SAN\PH1\05291\_LB8.DWG

**LINE 2**  
SHEET TITLE  
468-84321  
PROJECT NUMBER

DESIGN BY: DFL  
DRAWN BY: DMU  
CHECKED BY: GJA

ISSUED: February 2007  
REVISED:

SHEET NO.  
**14 of 31**