



**SANITARY SEWER PLANS**  
**KRUG SOUTH ADDITION**  
**PHASE 1**

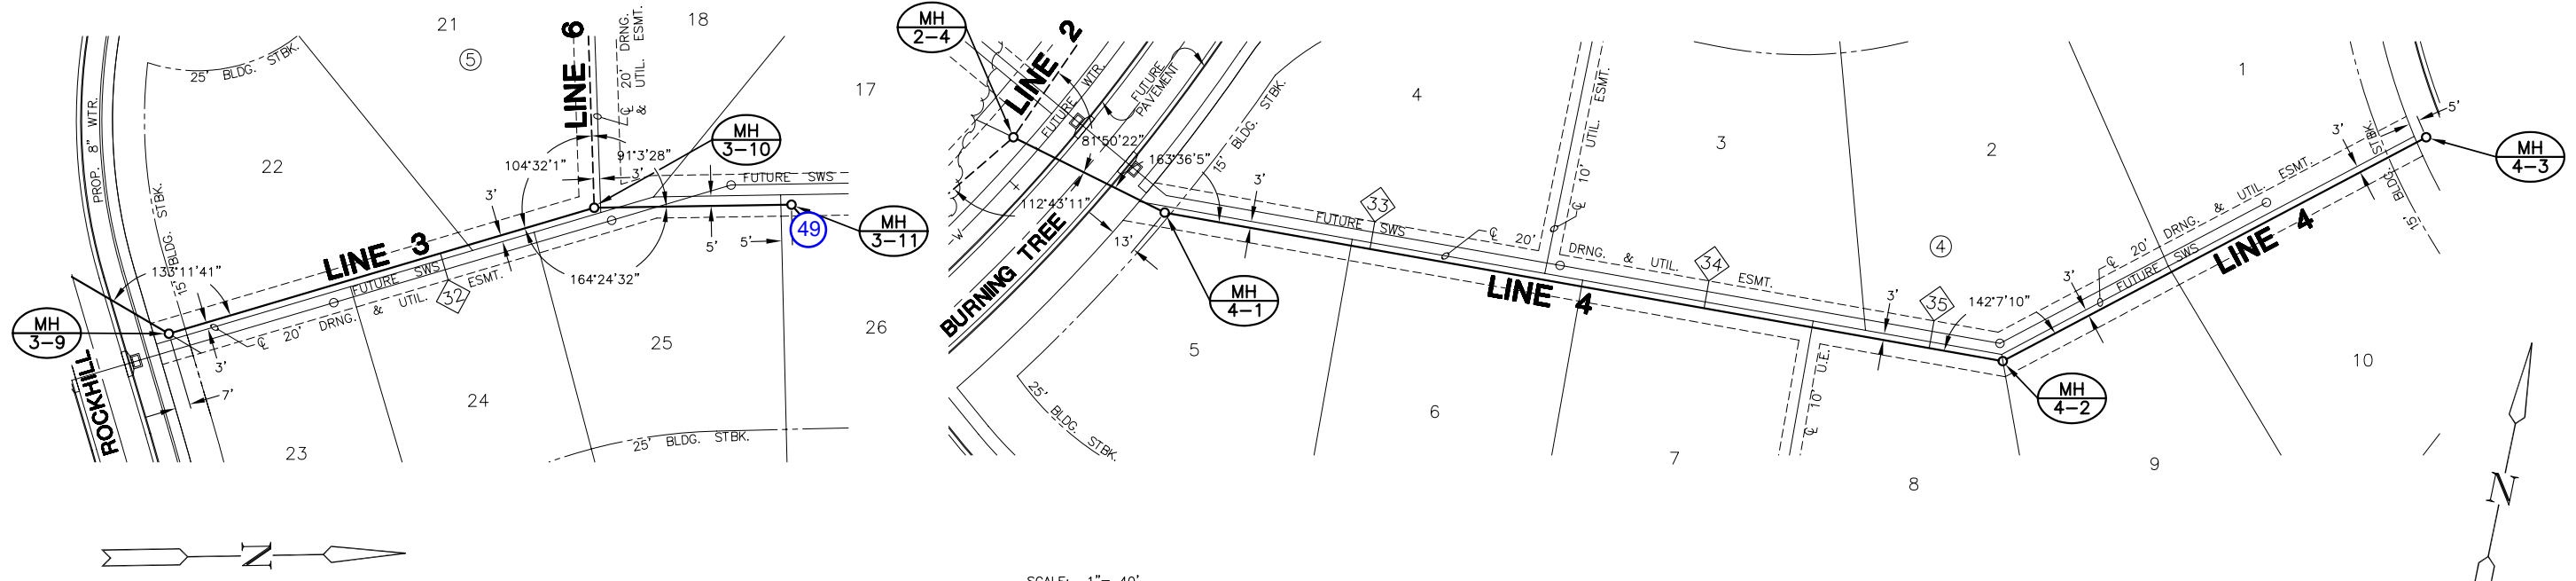

**PLAN LINE 3**

**PLAN LINE 4**

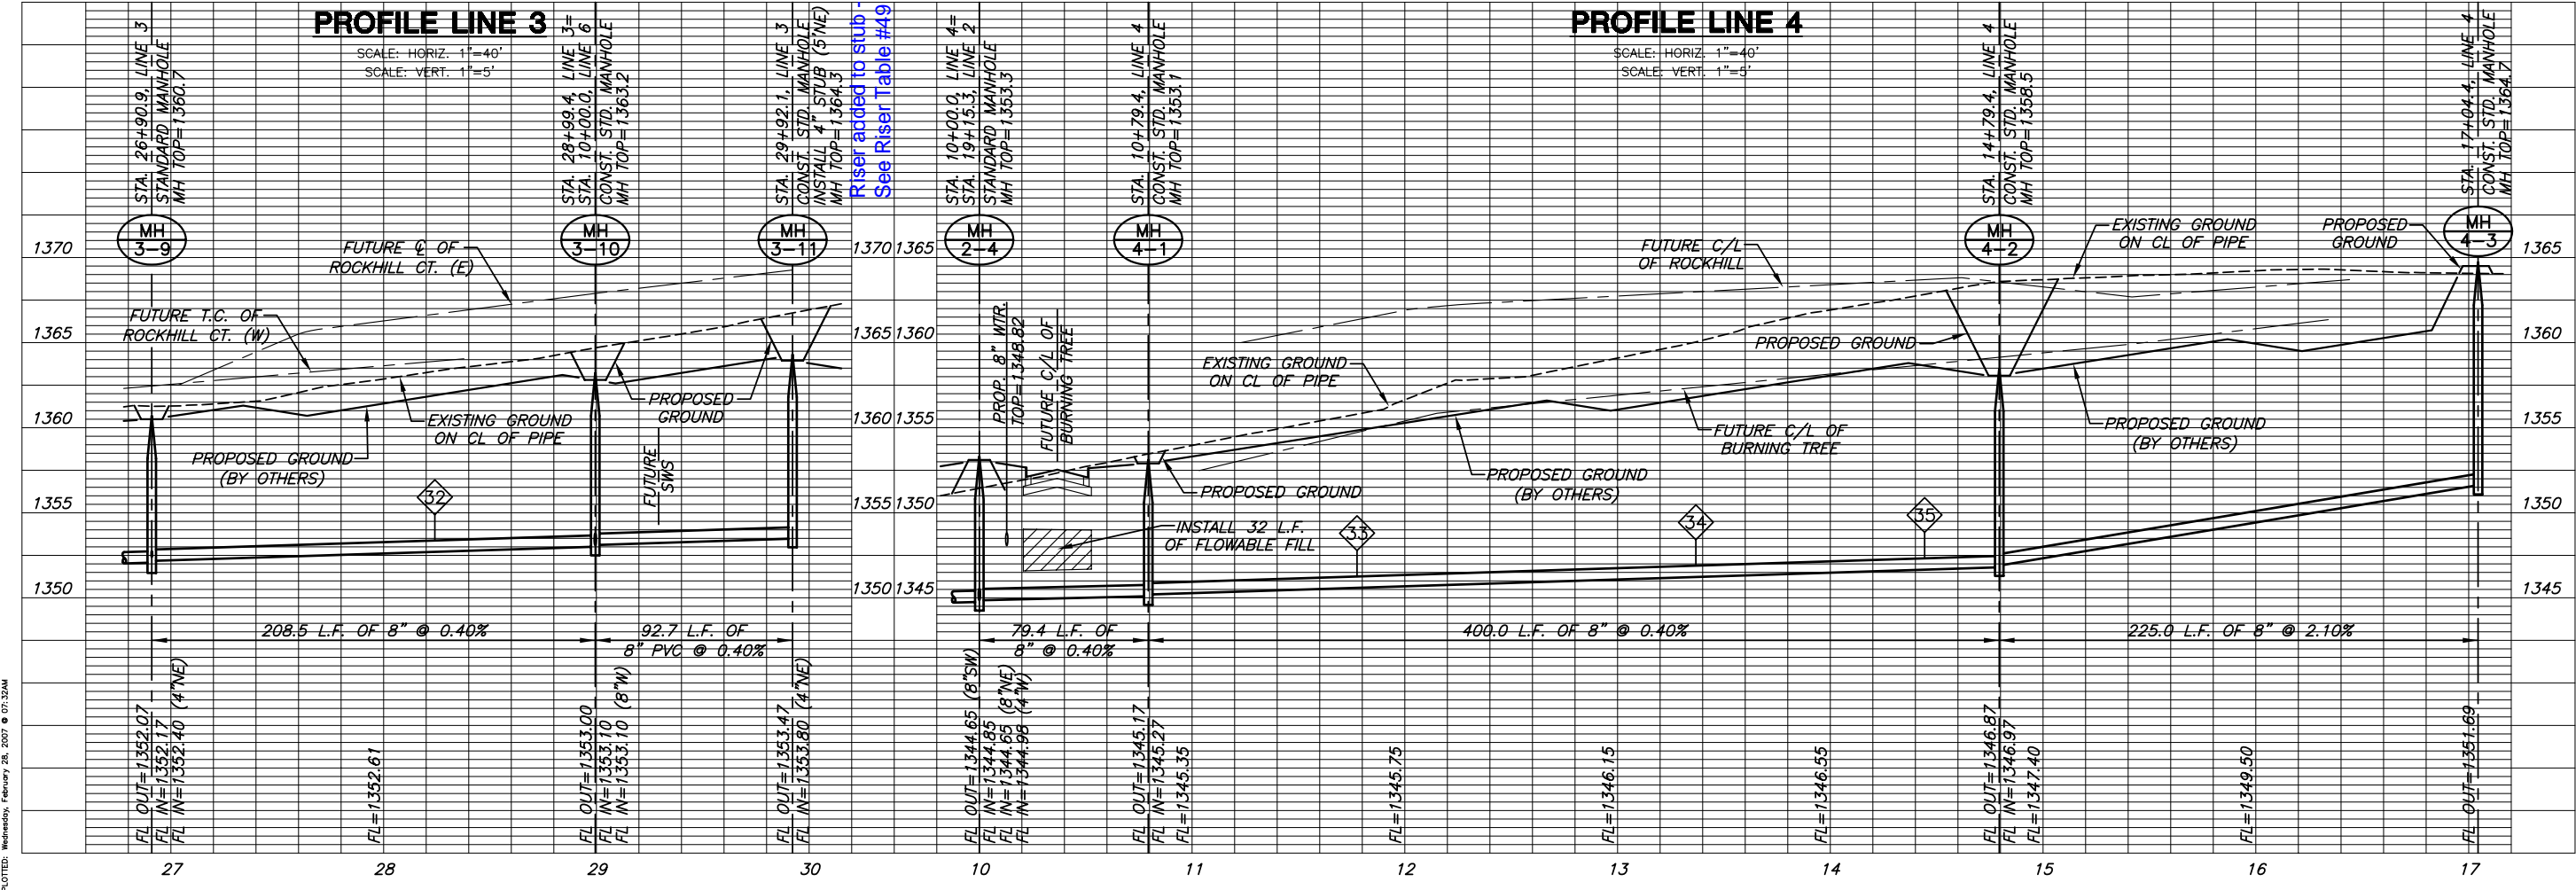

**PROFILE LINE 3**

**PROFILE LINE 4**

**LINES 3 & 4**  
SHEET TITLE  
468-84321  
PROJECT NUMBER

DESIGN BY: DFL  
DRAWN BY: DMU  
CHECKED BY: GJA

ISSUED: February 2007  
REVISED:

SHEET NO.  
**17 of 31**

PL07B: Wednesday, February 28, 2007 9:03:32AM

J:\CIVIL\05291\DWG\SAN\PH1\05291\_LB11.DWG