



**SANITARY SEWER PLANS**  
**KRUG SOUTH ADDITION**  
**PHASE 1**

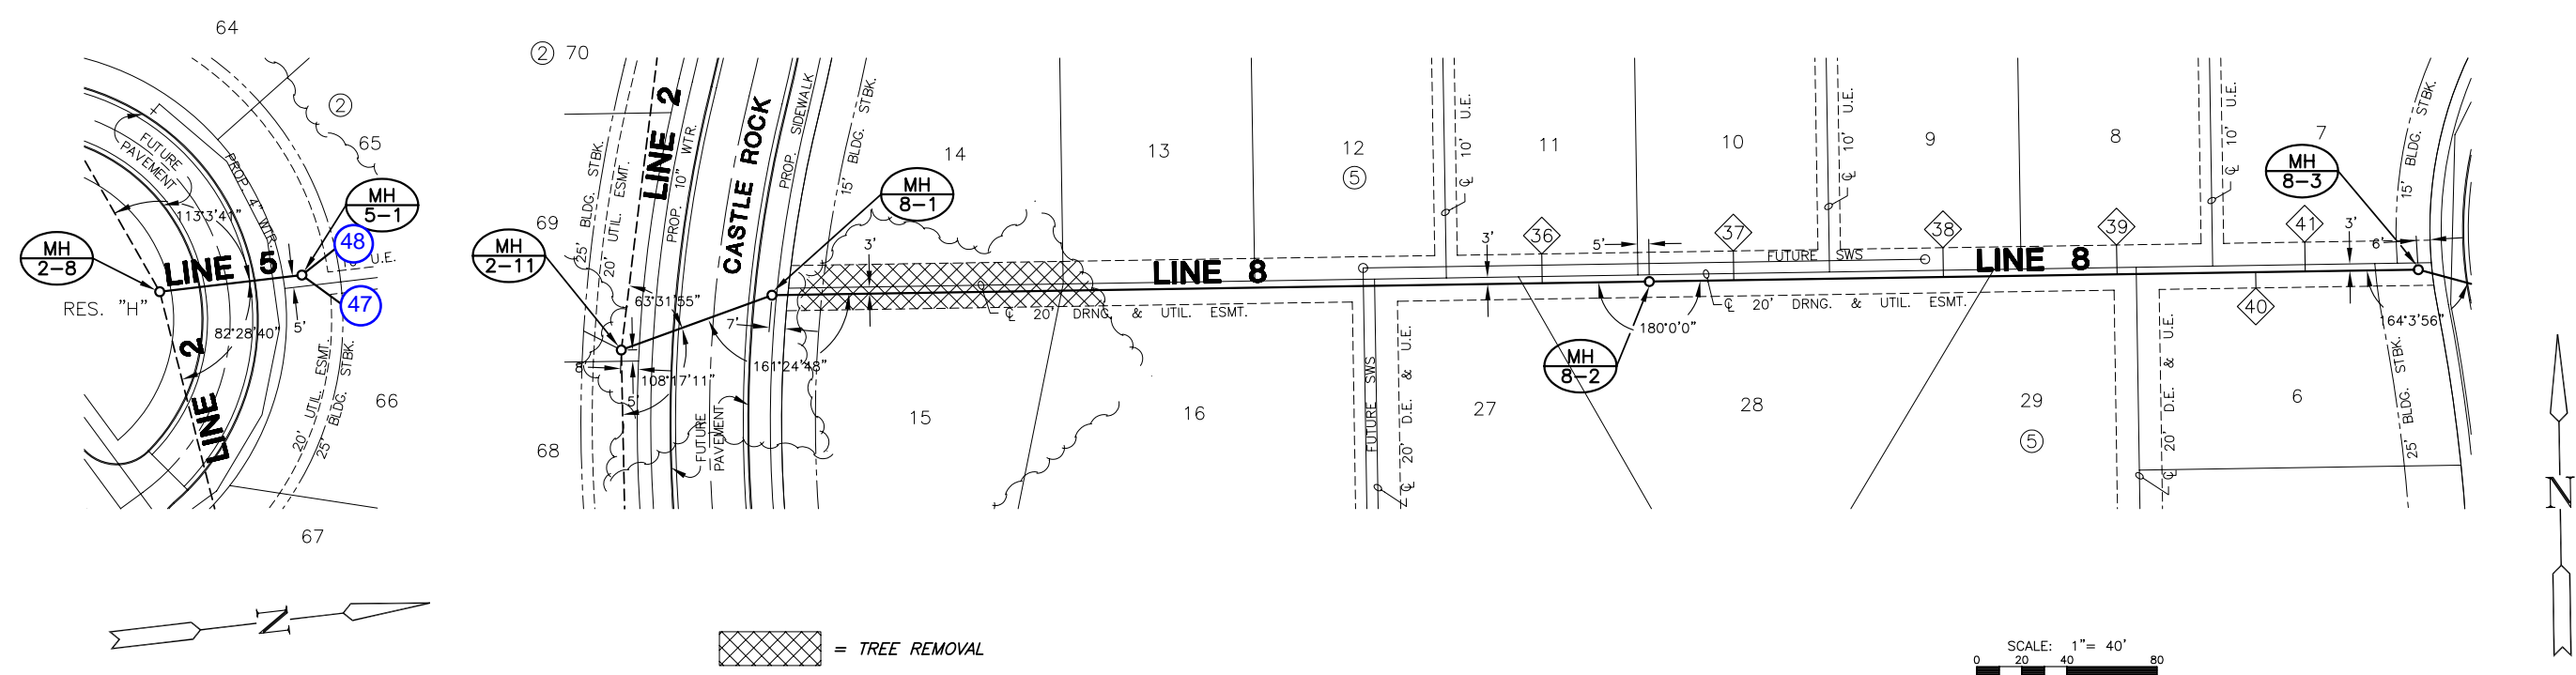

**PLAN LINE 5**

**PLAN LINE 8**

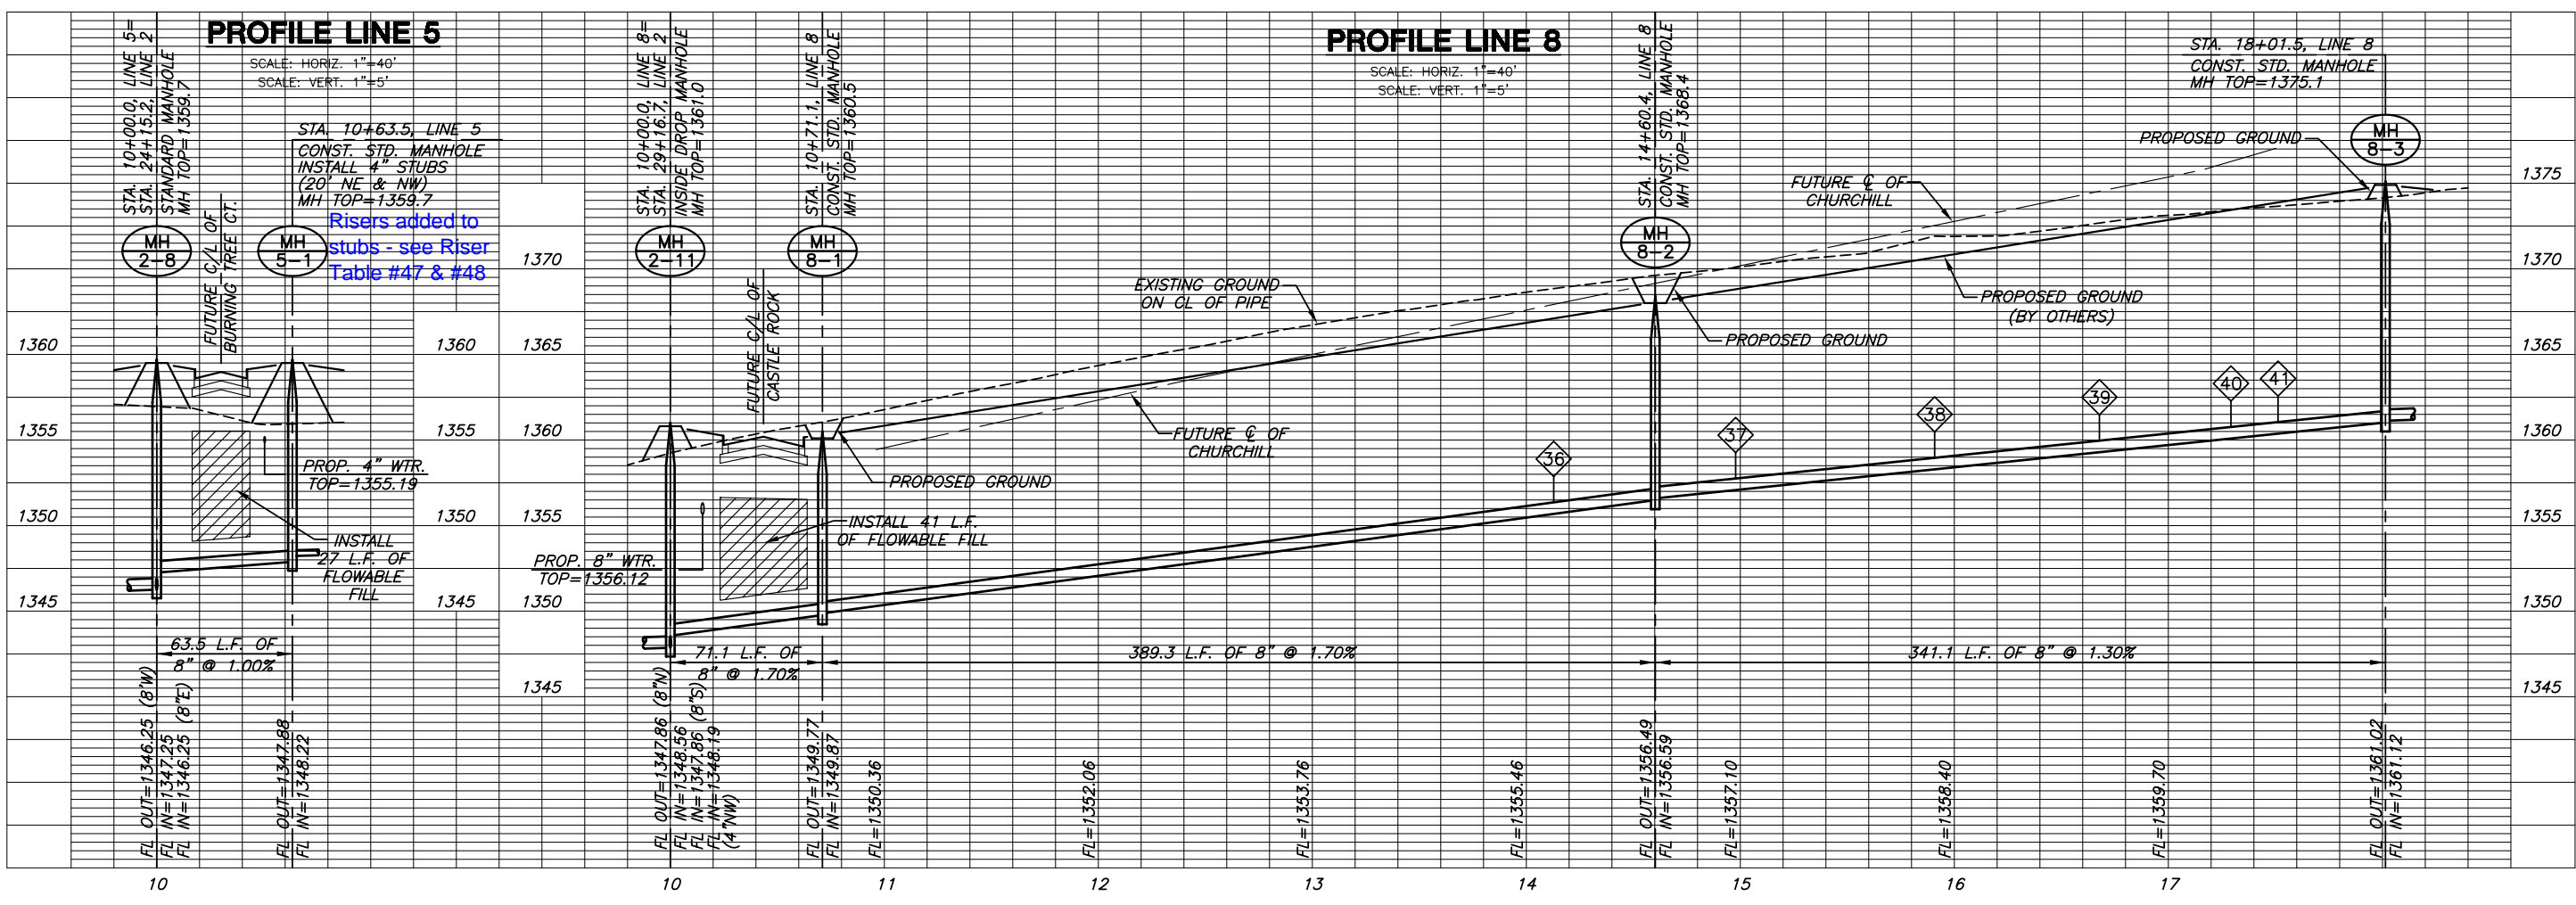

**PROFILE LINE 5**

**PROFILE LINE 8**

PLOTTER: Wednesday, February 28, 2007 9:07:33AM

J:\CIVIL\05291.DWG (SAN) (PH1) (05291\_LB13.DWG)

**LINE 5 & 8**  
SHEET TITLE  
468-84321  
PROJECT NUMBER

DESIGN BY: DFL  
DRAWN BY: DMU  
CHECKED BY: GJA

ISSUED: February 2007  
REVISED:

SHEET NO.  
**19 of 31**