
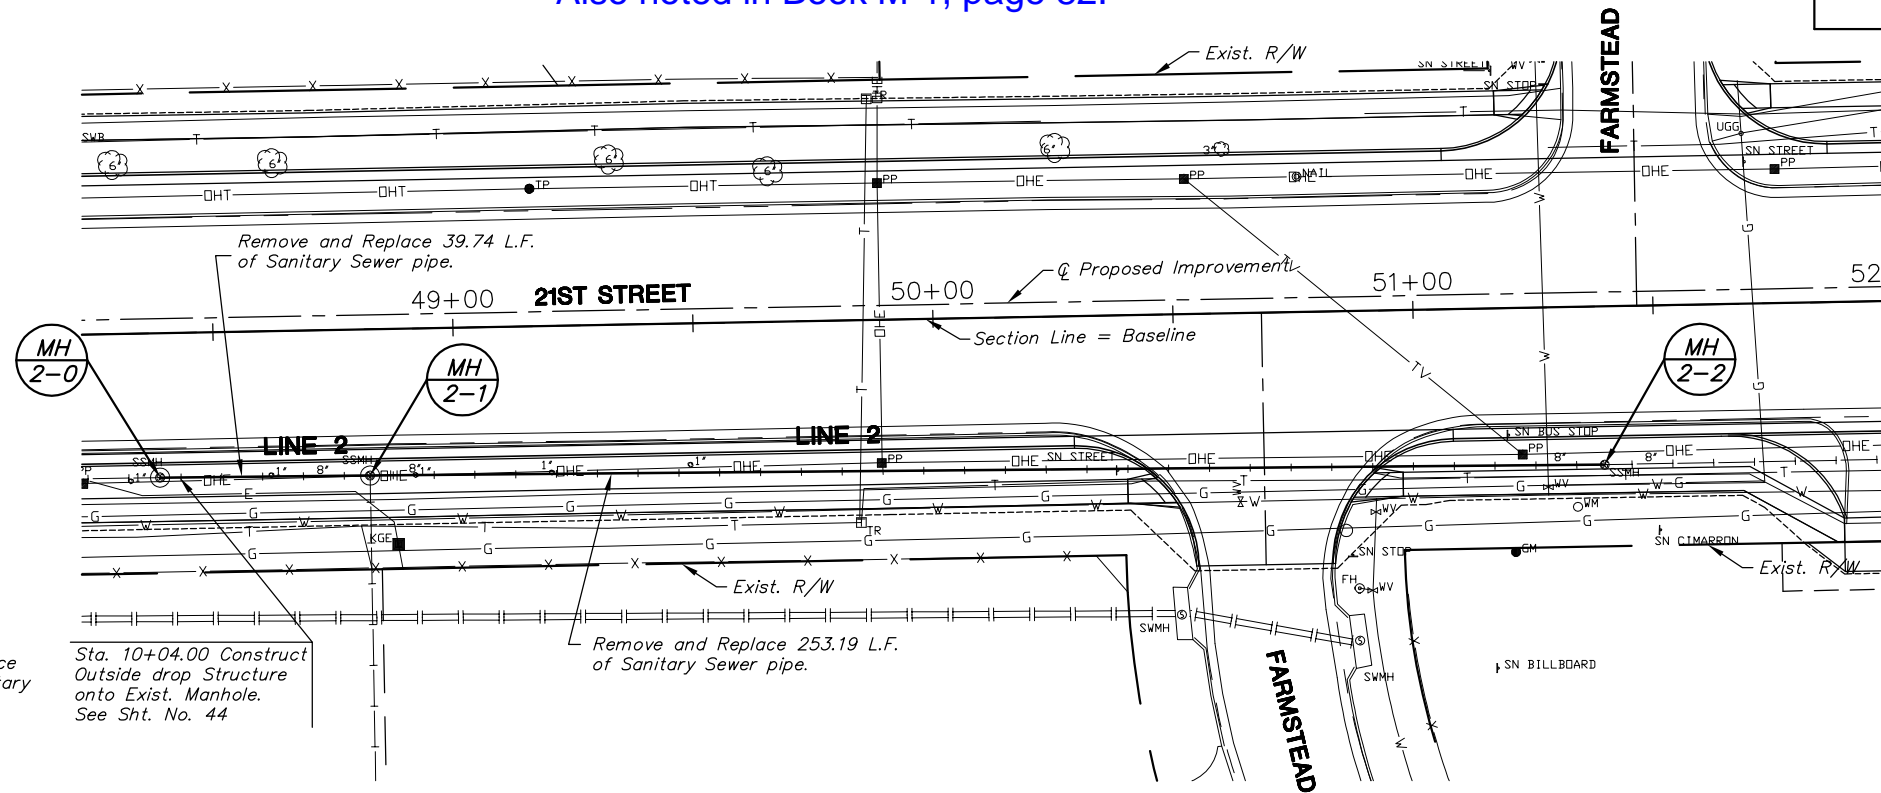


Also noted in Book M-1, page 82.

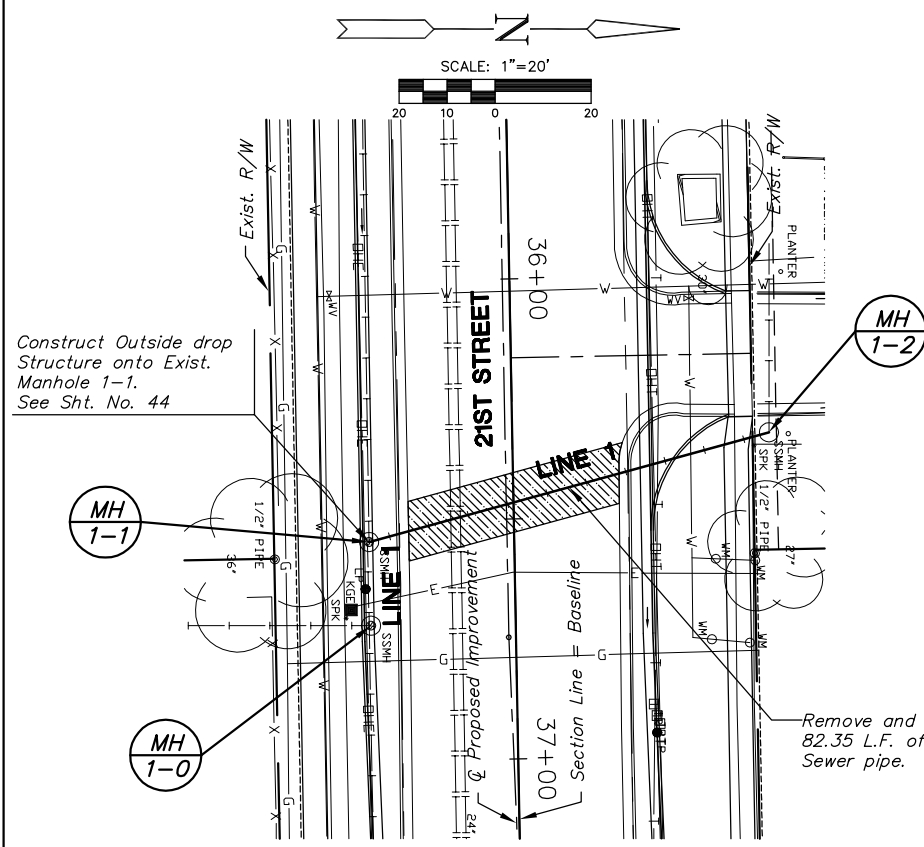

Also noted in Book M-2, page 233.


Full Depth Pavement Patch

PLAN - LINE 1

PLAN - LINE 2

PROFILE - LINE 1

Scale: 1" = 20' Horiz.
1" = 5' Vert.

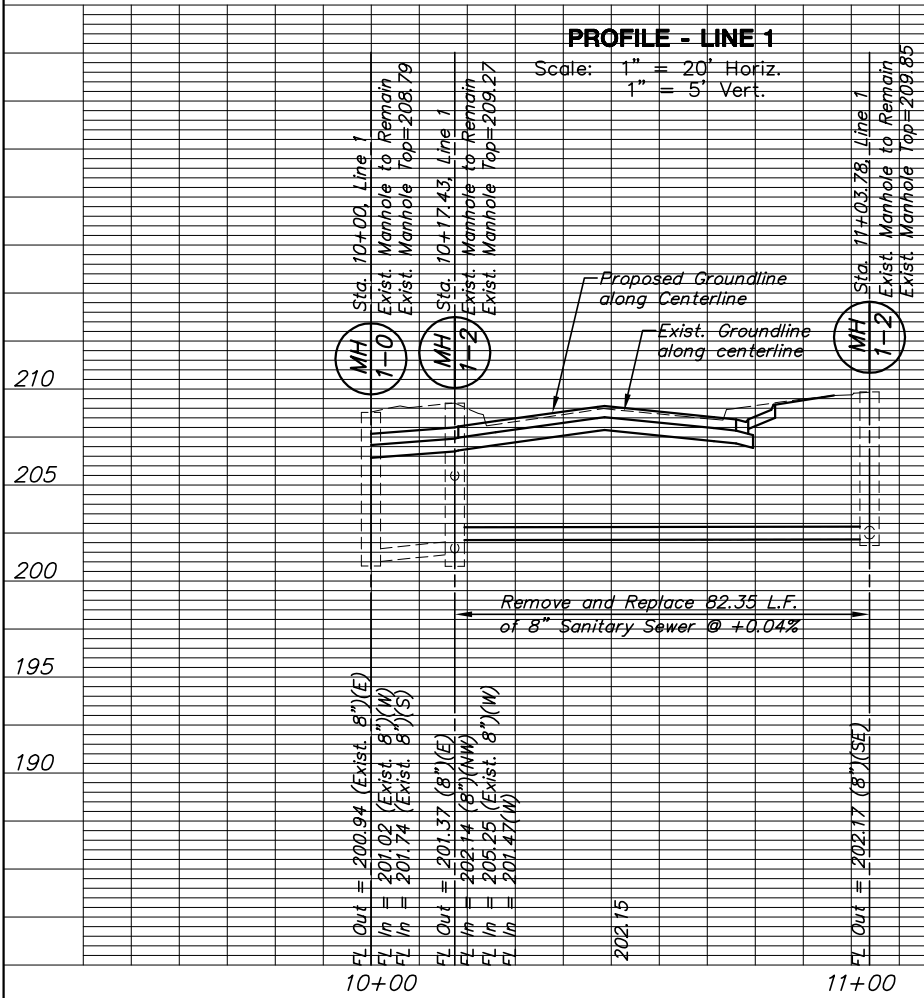

PROFILE - LINE 2

Scale: 1" = 20' Horiz.
1" = 5' Vert.

