
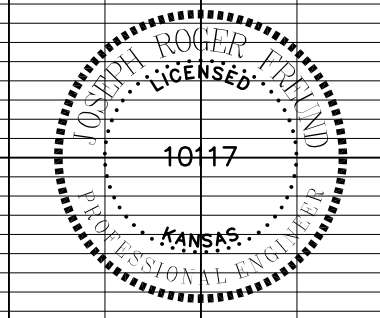


# STORM DRAIN LINE "3"

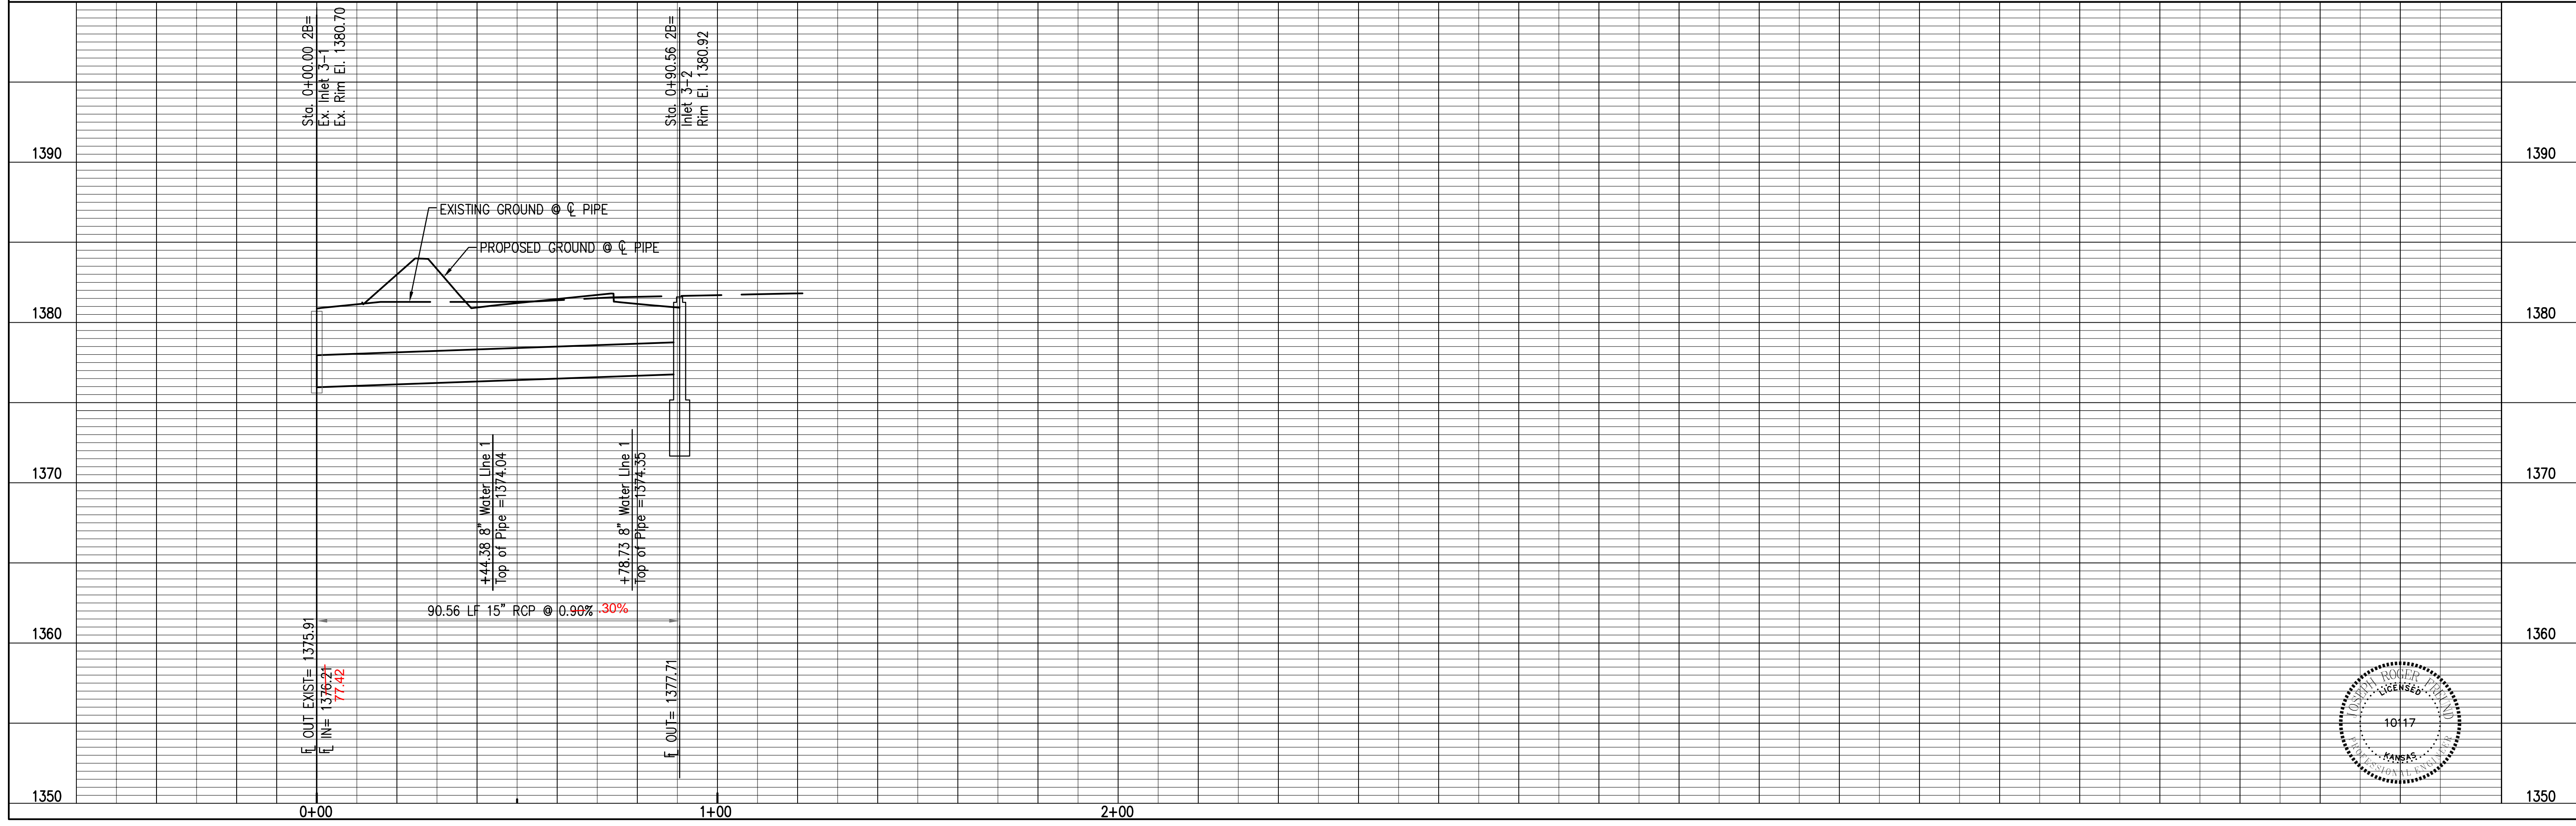

No.	Date	By	Approved	Revision
1				
2				
3				

PLAN AND PROFILE  
STORM DRAIN LINE "3"  
Webber Group  
Inwood Apartments

**POE & ASSOCIATES, INC.**  
CONSULTING ENGINEERS  
5940 E. Central, Suite 200 ■ Wichita, KS 67208-4242  
Phone 316/685-4114 ■ FAX 316/685-4444

Engineer: JRF  
Designer: KJW  
Poe Job No.: 1909  
Date: 8-31-07

Sheet 12 of 20

P:\1909A Revise\Inwood\Working Draw\PS\SHEET3.dwg & P as 3 - SHT 36.dwg, SHT 34, 4/9/2008 9:08:55 AM