

B.M. 101.64 R.R. Spike in the East face of the Power Pole on the Southwest corner of Richmond and Crawford.
 B.M. 103.28 Southeast corner of bottom step of Mennonite Church on the Northeast corner of Crawford and Meridian.



Plan Scale: 1" = 40'
 Profile Scale: 1" = 40' Horiz.
 1" = 5' Vert.

PLAN	NOTES
1. 8" Ductile Iron Pipe	2. 8" Ductile Iron Pipe

Note: Joint between 8" Ductile Iron Pipe and 8" A.S. Composite Pipe is to be encased in 8" Reinforced Concrete. Encasement is to extend 2.0 ft each way from joint.

Sta 0+42
 End Ductile Iron Pipe, Begin 8" A.S. Composite Pipe

Sta 0+100
 Begin 8" Sanitary Extension of Kist. MH. Modify Invert for Flow Begin Ductile Iron Pipe

Sta 1+42
 End Pipe and Plug

Sta 3+00
 MH by Others

PROFILE	NOTES
1. 8" Ductile Iron Pipe	2. 8" Ductile Iron Pipe


42 Lin. Ft. of 8" Ductile Iron Pipe @ 0.25% Grade

180 Lin. Ft. of 8" A.S. Composite Pipe @ 0.15% Grade

NOT Part of this contract

AD BUILT 4-11-79

D 257
 TCD 39

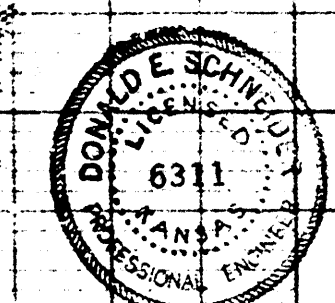

PRIVATE CONTRACT
 SANITARY SEWER EXTENSION TO SERVE LOTS 2, 4, 6, 8, 10, AND 12, BLOCK 18, ORIENTA PARK SECOND ADDITION
 CITY OF WICHITA, KANSAS
 R. W. LINN CITY ENGINEER
 DATE: PROJ. NO. 468-76-245-80750-000-008

17 e 5 15