


1. Underground utility service lines and overhead utility pole lines are to be adjusted as necessary by others prior to construction unless the plans specifically call for their adjustment by the Contractor or unless the plans specifically identify a utility to be adjusted by its owner during construction. The Contractor shall be responsible for locating all utilities and their locations as shown on the plans, representing the best information obtainable for design. The Contractor will be required to work around existing utilities within the right-of-way which do not conflict with proposed construction.
2. Trees and shrubs in public right-of-way which are in direct conflict with proposed new construction shall be removed by the Contractor with the Engineer's approval. Trees and shrubs which are not in direct conflict with proposed new construction shall be saved and protected from damage.
3. The Contractor shall be responsible for preserving property irons. The Contractor will be required to re-establish any property irons which are damaged or destroyed by his construction operations. Such irons shall be re-established by a licensed land surveyor in accordance with state laws.
4. Contractor will be required to provide notice to utility companies a minimum of twenty-four (24) hours prior to any excavation, as follows:

The Contractor must notify the following in case of an emergency:

APPROVED AS NOTED
BY CITY ENGINEER OF WICHITA
Sanitary Sewers VRH 9/14/90
Storm Sewers _____
Driveway Approaches _____
Water Mains _____
Paving _____


NOTE TO CONTRACTOR

NO WORK SHALL BE PERFORMED IN DESIGNATED EASEMENTS OR RIGHT-OF-WAY OF ANY CITY OR COUNTY WITHOUT SUCH INSPECTION NOR SHALL ANY WORK BE COMMENCED WITHOUT WRITTEN AUTHORIZATION BY THE CITY ENGINEER.

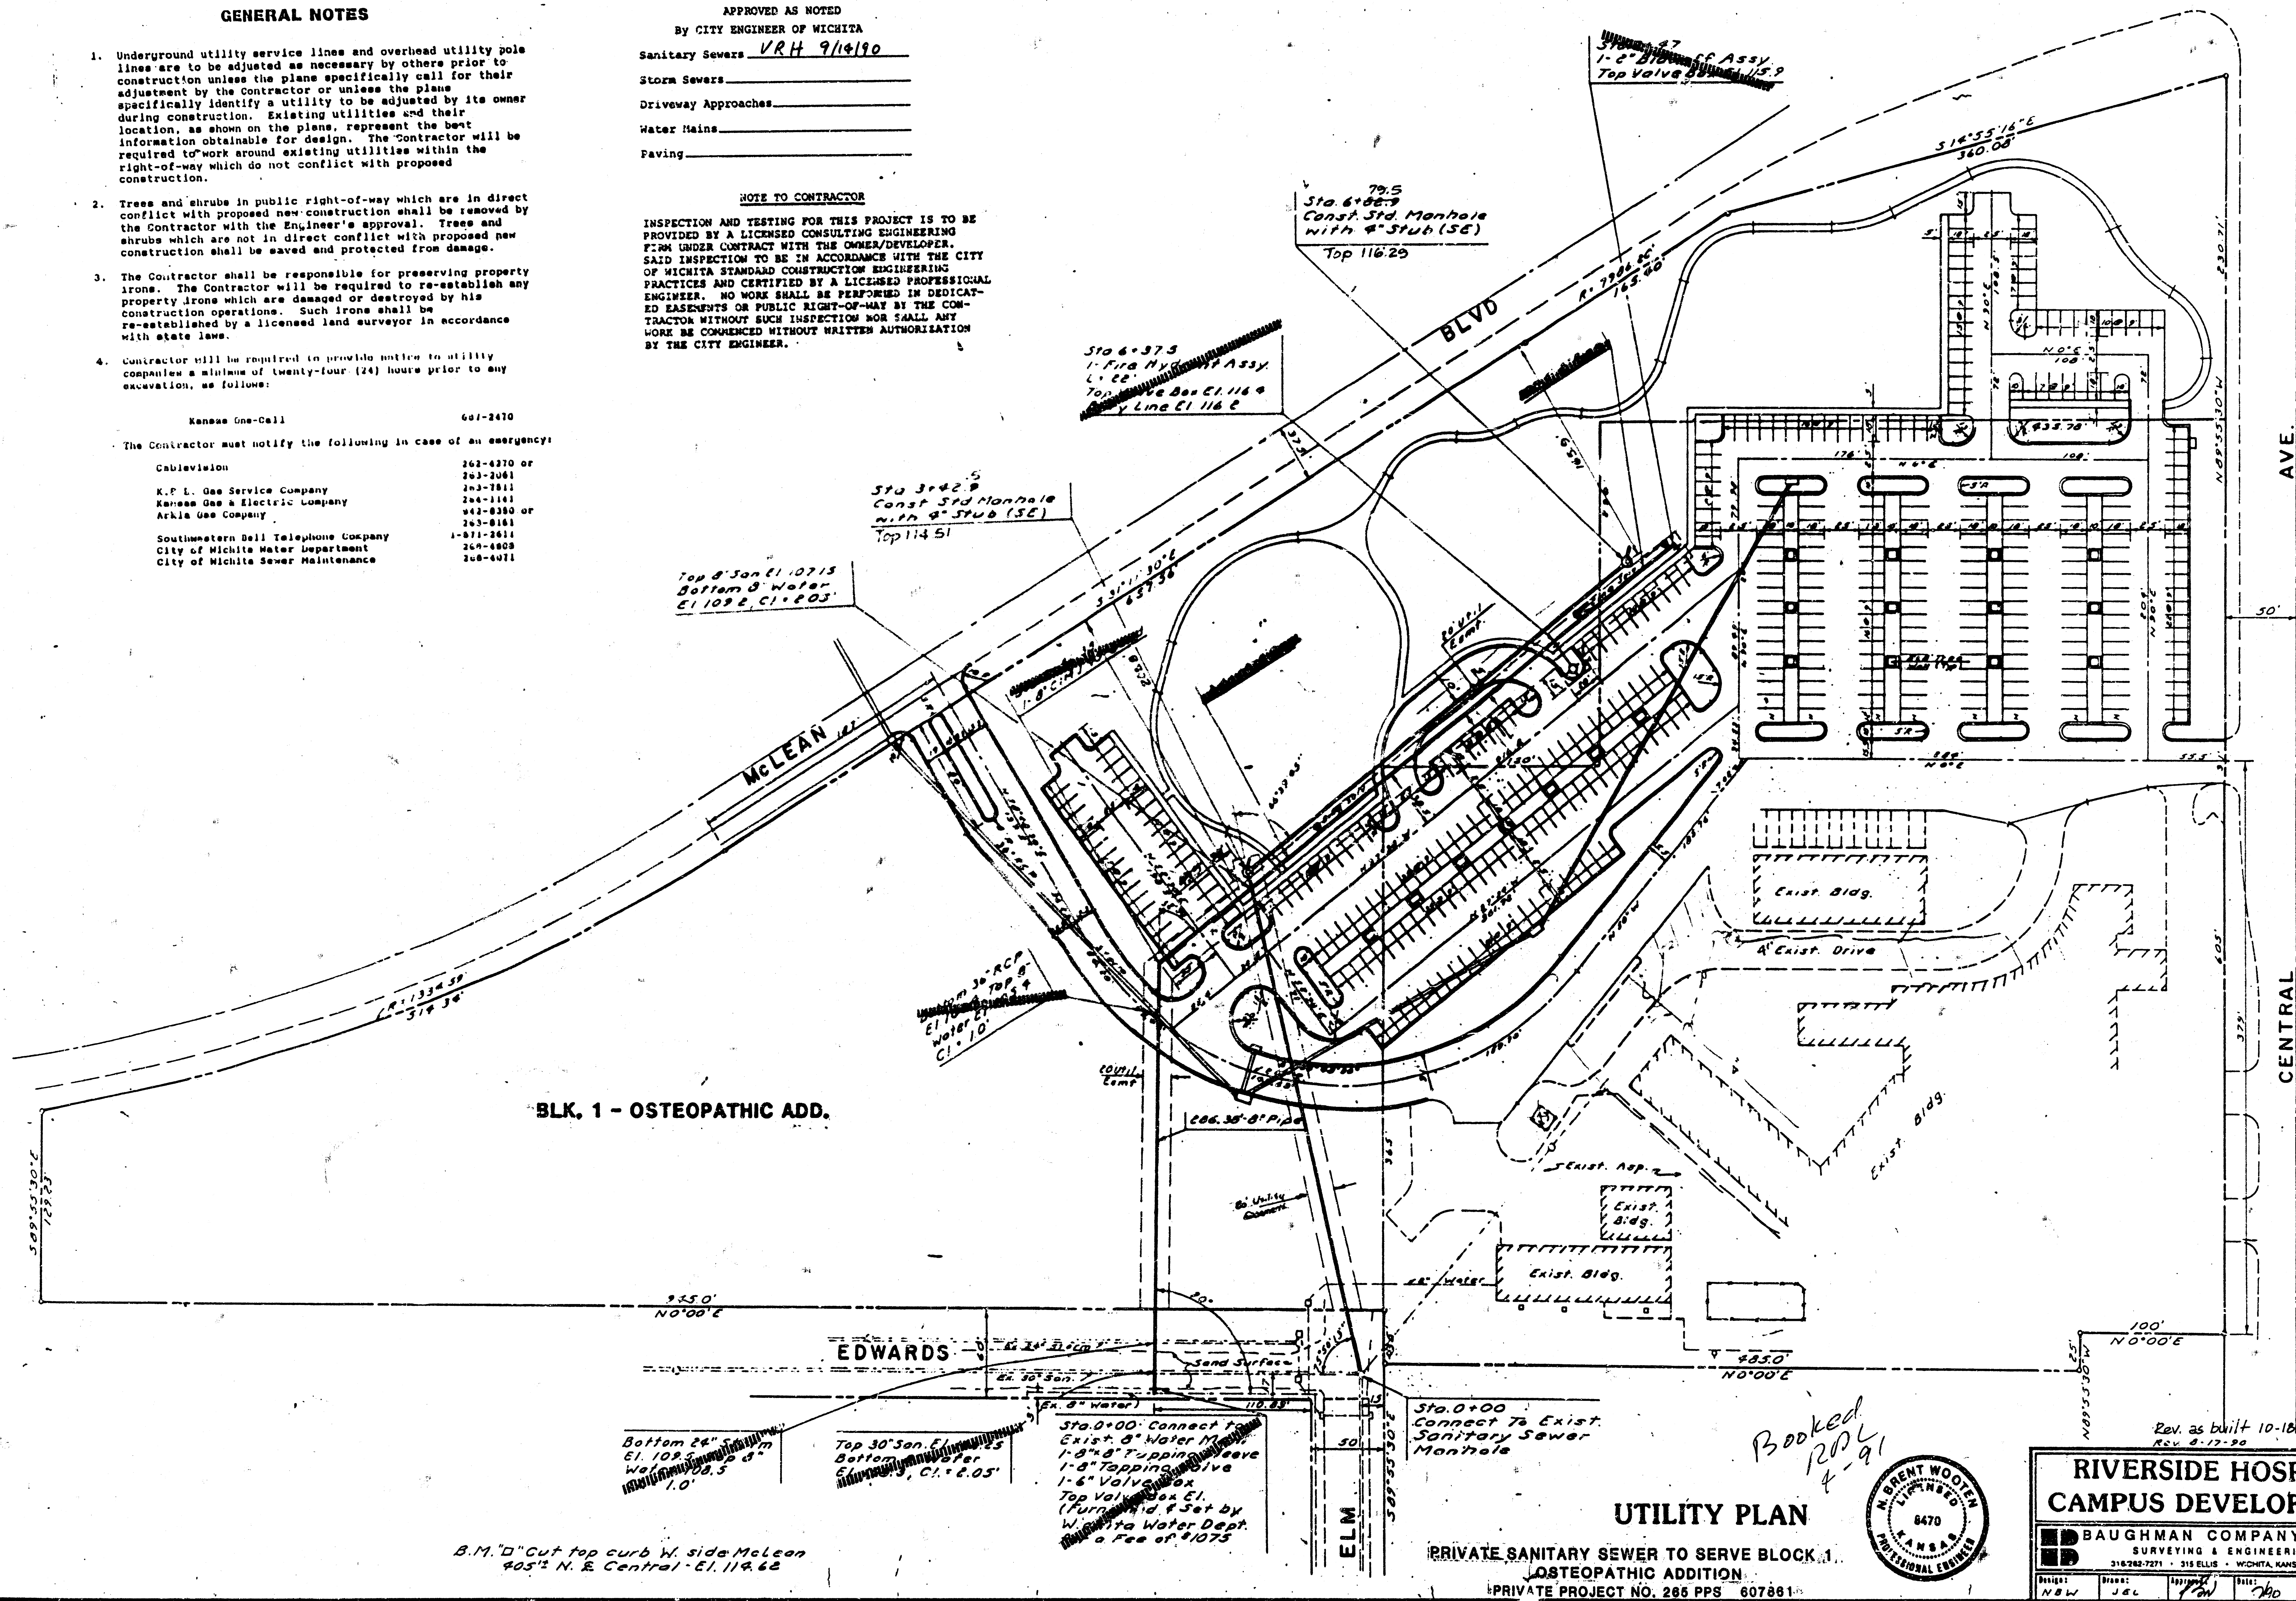

UTILITY PLAN

**PRIVATE SANITARY SEWER TO SERVE BLOCK 1
OSTEOPATHIC ADDITION
PRIVATE PROJECT NO. 265 PPS 607861**

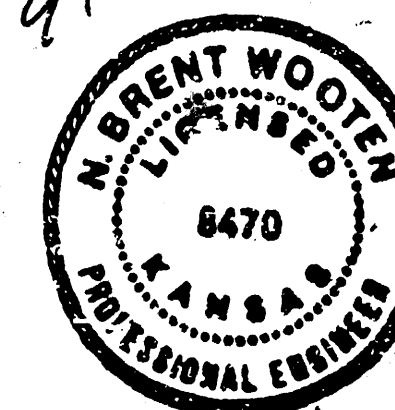

RIVERSIDE HOSPITAL CAMPUS DEVELOPMENT


ED BAUGHMAN COMPANY, P.A. SURVEYING & ENGINEERING 316-262-7271 • 315 ELLIS • WICHITA, KANSAS 67211				
Design: NBW	Drawn: JGL	Approved: <i>[Signature]</i>	Date: 7/60	Scale: 60
Project Number:				

1. Underground utility service lines and overhead utility pole lines are to be adjusted as necessary by others prior to construction unless the plans specifically call for their adjustment by the Contractor or unless the plans specifically identify a utility to be adjusted by its owner during construction. The Contractor shall locate their construction, as shown on the plans, represent the best information obtainable for design. The Contractor will be required to work around existing utilities within the right-of-way which do not conflict with proposed construction.
2. Trees and shrubs in public right-of-way which are in direct conflict with proposed new construction shall be removed by the Contractor with the Engineer's approval. Trees and shrubs which are not in direct conflict with proposed new construction shall be saved and protected from damage.
3. The Contractor shall be responsible for preserving property irons. The Contractor will be required to re-establish any property irons which are damaged or destroyed by his construction operations. Such irons shall be re-established by a licensed land surveyor in accordance with state laws.
4. Contractor will be required to provide notice to utility companies a minimum of twenty-four (24) hours prior to any construction, as follows:

NOTE TO CONTRACTOR

INSPECTION AND TESTING FOR THIS PROJECT IS TO BE PROVIDED BY A LICENSED CONSULTING ENGINEERING FIRM UNDER CONTRACT WITH THE OWNER/DEVELOPER. SAID INSPECTION TO BE IN ACCORDANCE WITH THE CITY OF WICHITA STANDARD CONSTRUCTION ENGINEERING PRACTICES AND CERTIFIED BY A LICENSED PROFESSIONAL ENGINEER. NO WORK SHALL BE PERFORMED IN DEDICATED EASEMENTS OR RIGHT-OF-WAY WITHOUT THE COMPLETION OF THE INSPECTION. NO WORK SHALL BE COMMENCED WITHOUT WRITTEN AUTHORIZATION BY THE CITY ENGINEER.

Kansas One-Call	681-2410
The Contractor must notify the following in case of an emergency:	
Cablevision	262-6270 or 263-7061
K.P. L. Gas Service Company	263-7511
Kansas Gas & Electric Company	264-1141
Arkia Gas Company	243-6350 or 263-8161
Southwestern Bell Telephone Company	1-811-2611
City of Wichita Water Department	268-0800
City of Wichita Sewer Maintenance	268-4071

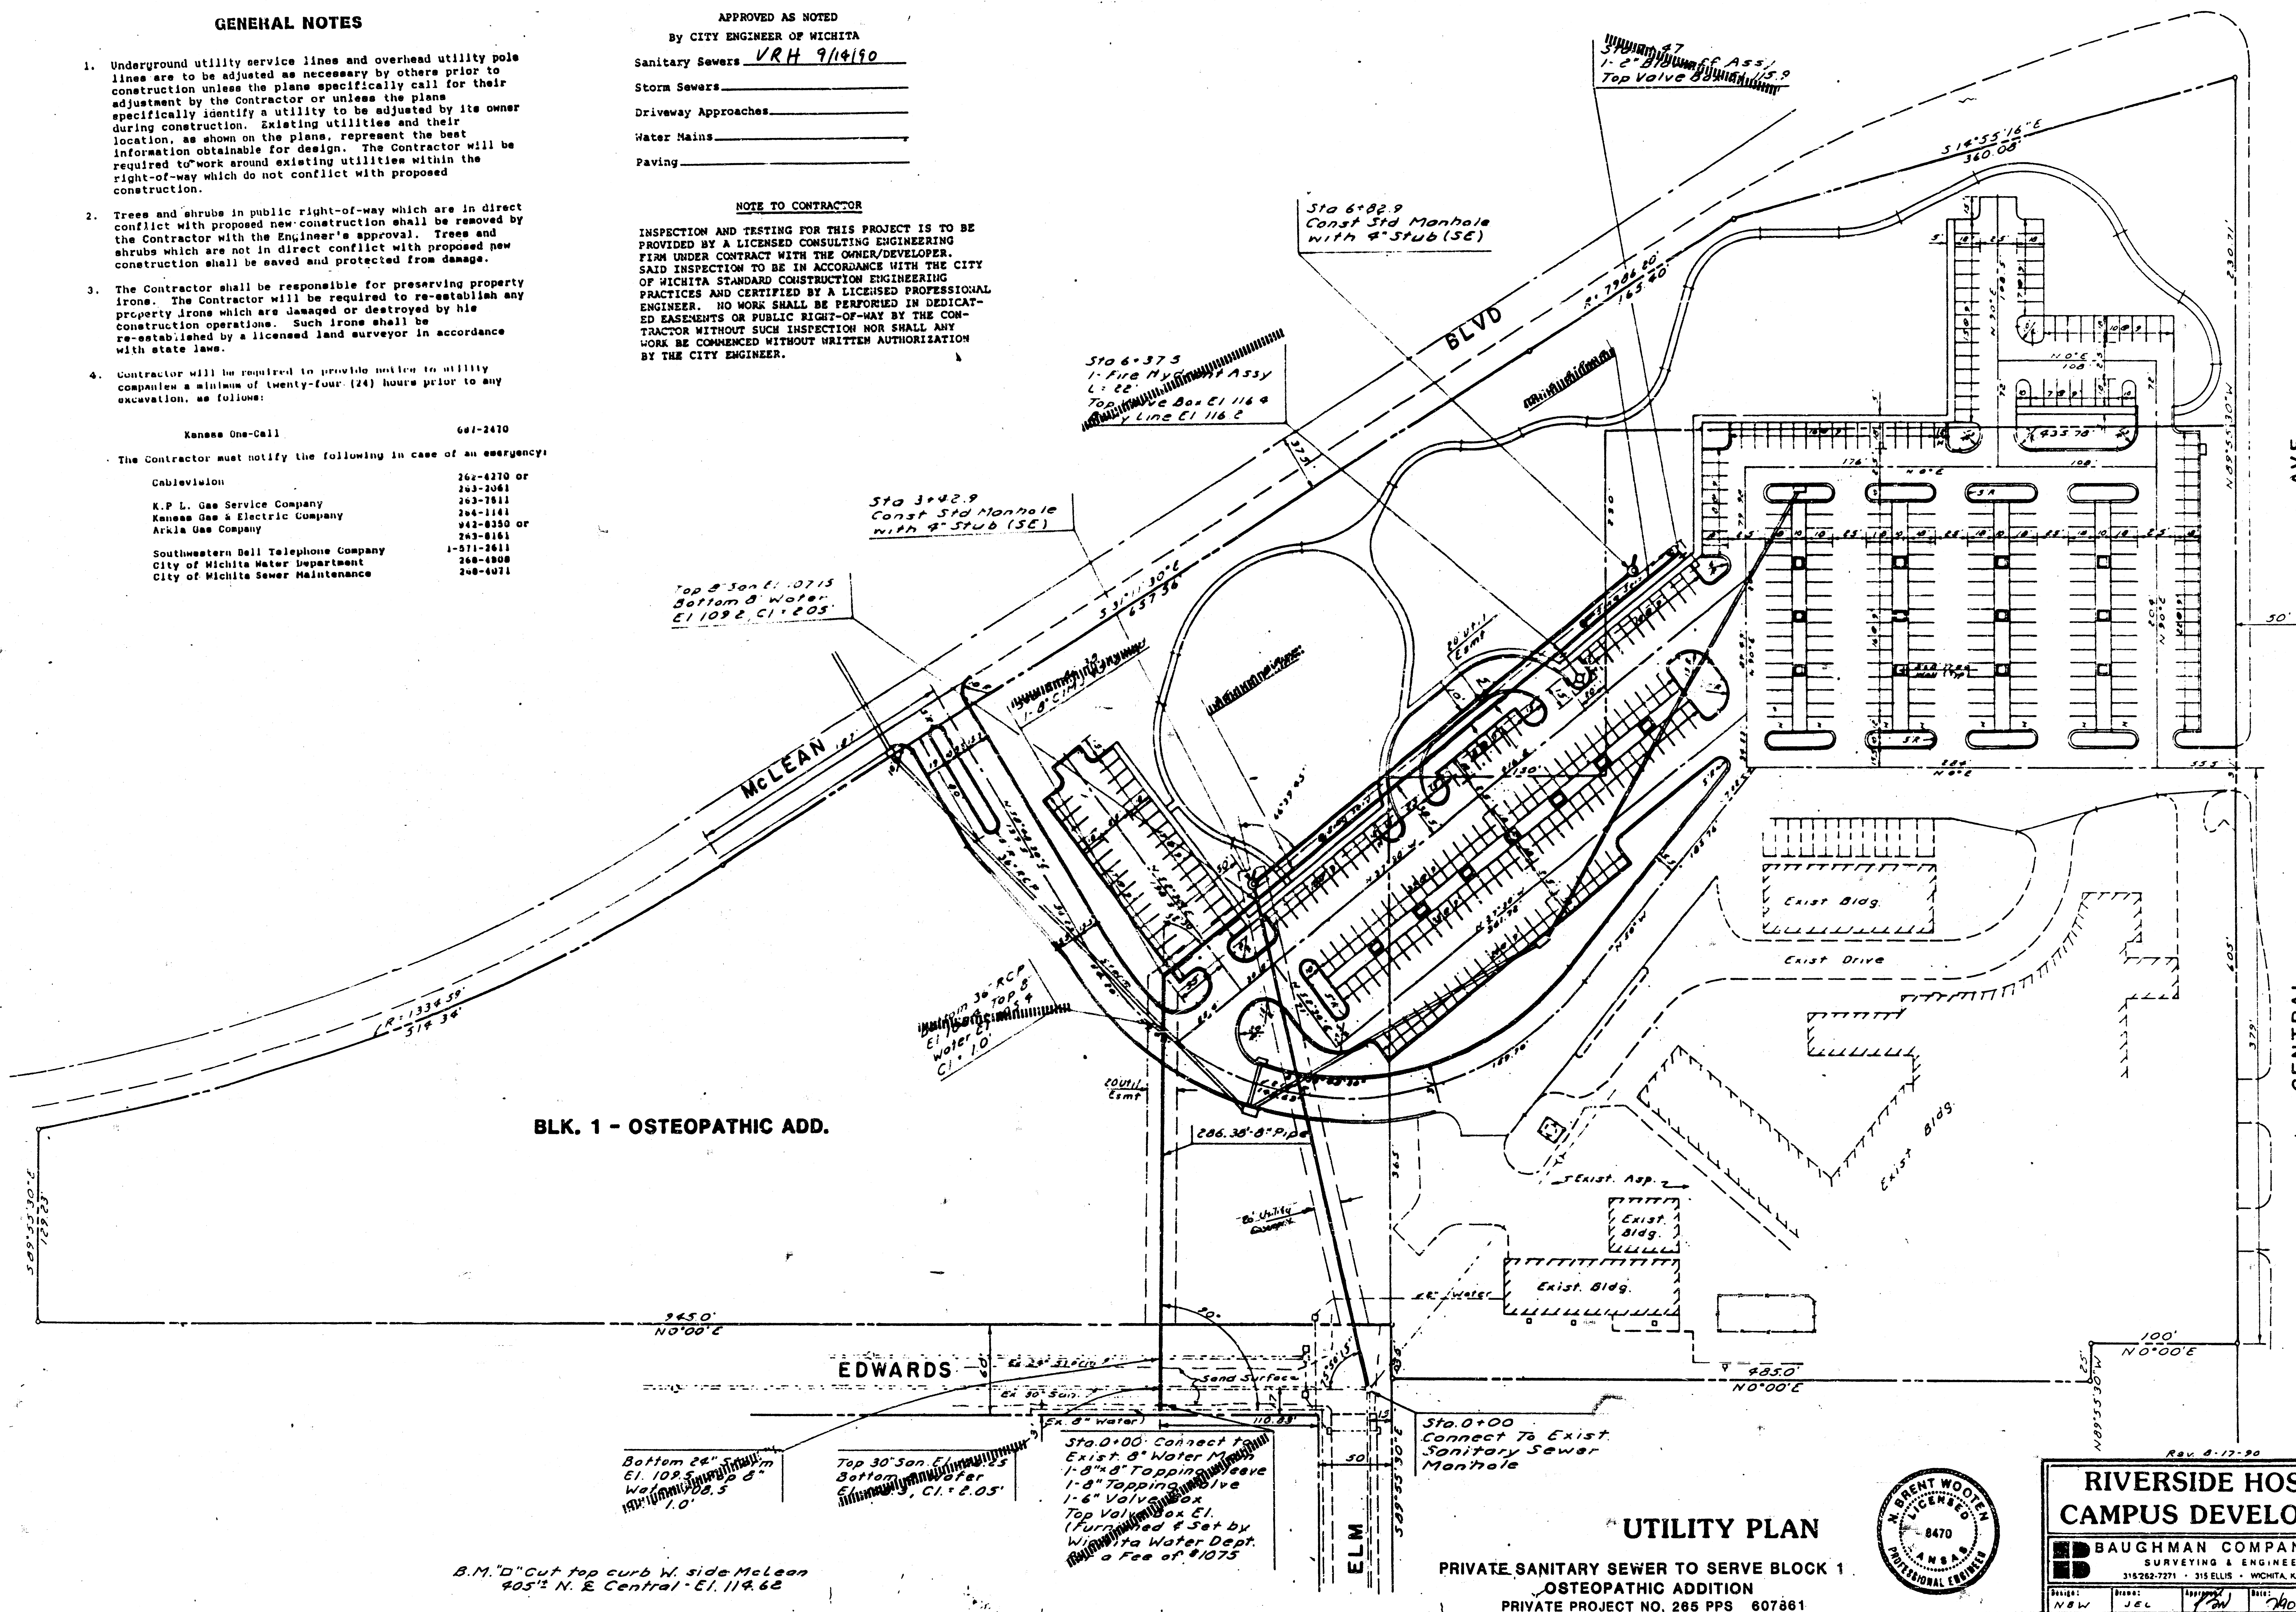

RIVERSIDE HOSPITAL CAMPUS DEVELOPMENT

BAUGHMAN COMPANY, P.A.
SURVEYING & ENGINEERING

Design:	Drawn:	Approved:	Date:	Scale:
---------	--------	-----------	-------	--------

NBW	JEL	7 th DW	MD	50
-----	-----	--------------------	----	----

7/19/61 KCM:llf

FILMED FROM THE BEST

