
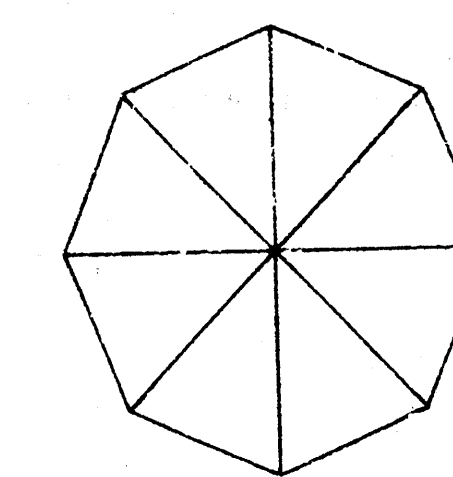


PROFILE NOTE BOOK GRADE'S CHECKED 2. M. NOTED	SURVEYED	BY	DATE
	"LOTTED" NOTE BOOK GRADE'S CHECKED 2. M. NOTED		

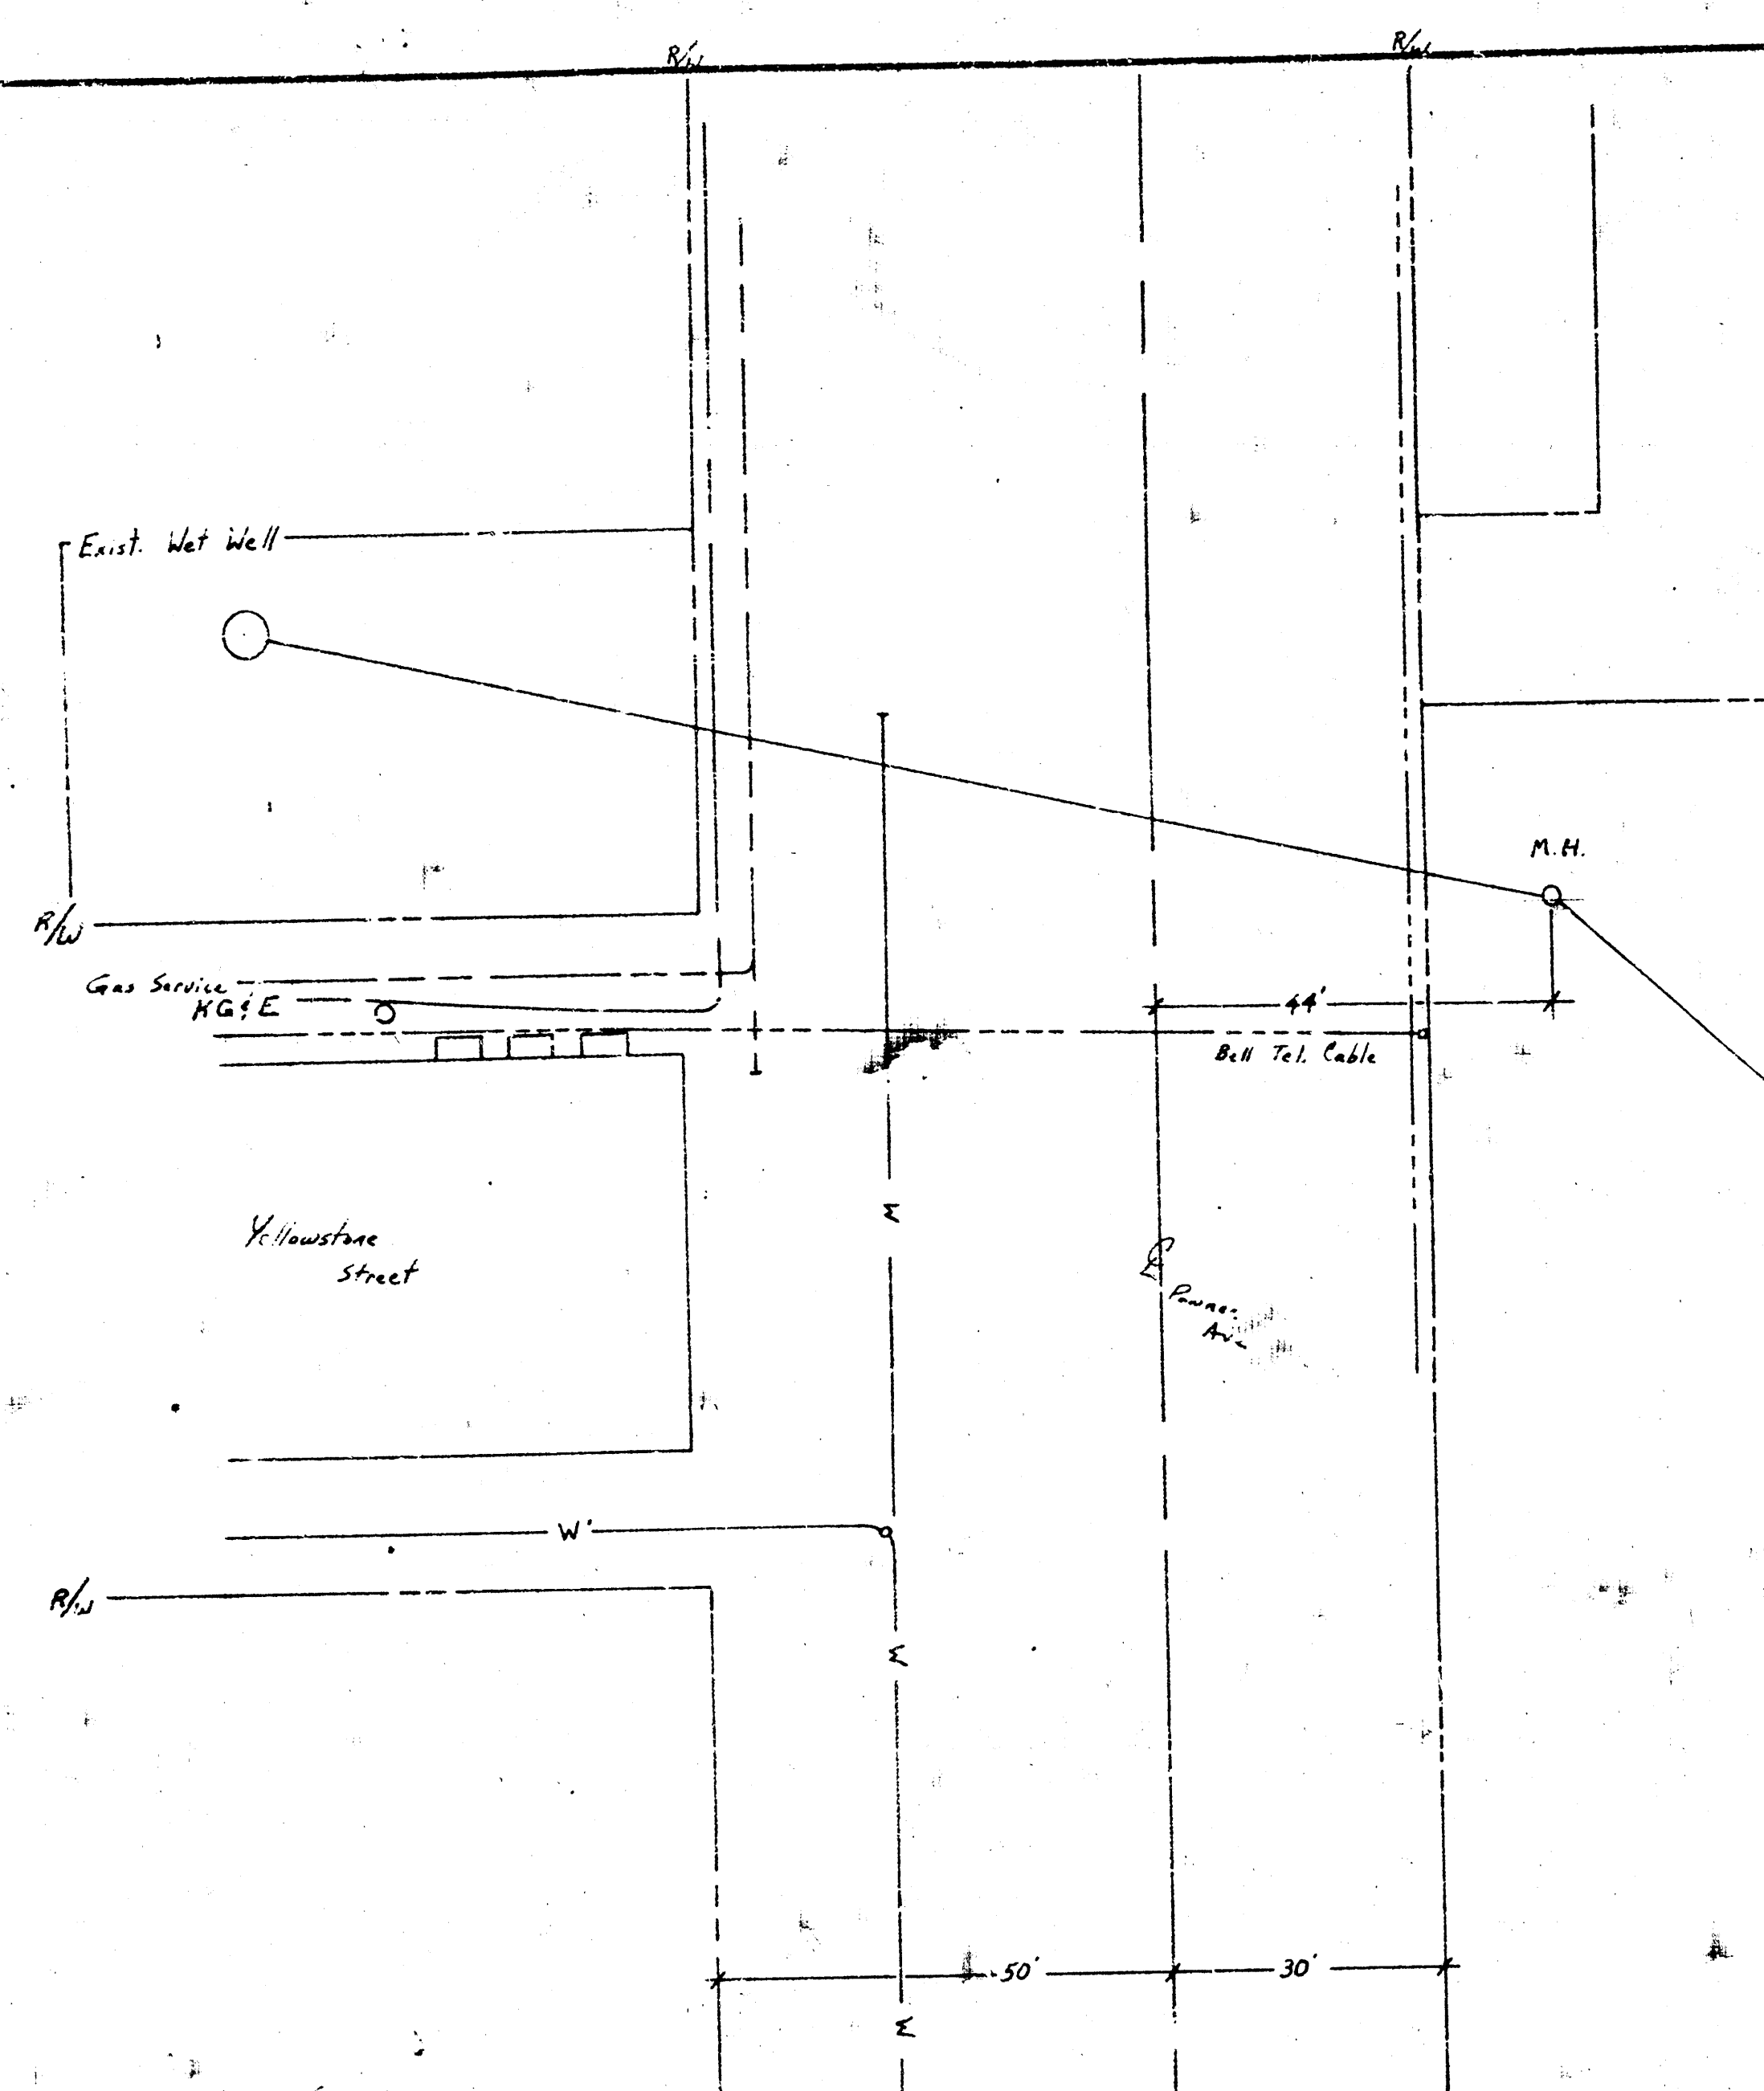



SHELTER

NOTE TO CONTRACTOR

This project will be constructed under the supervision of the CITY ENGINEER and conforming to the SPECIFICATIONS of the CITY OF WICHITA. The CONTRACTOR will pay the City of Wichita for all costs of inspection.

APPROVED AS NOTED
By CITY ENGINEER OF WICHITA
Sanitary Sewers _____
Storm Sewers _____
Driveway Approaches _____

RESTROOMS

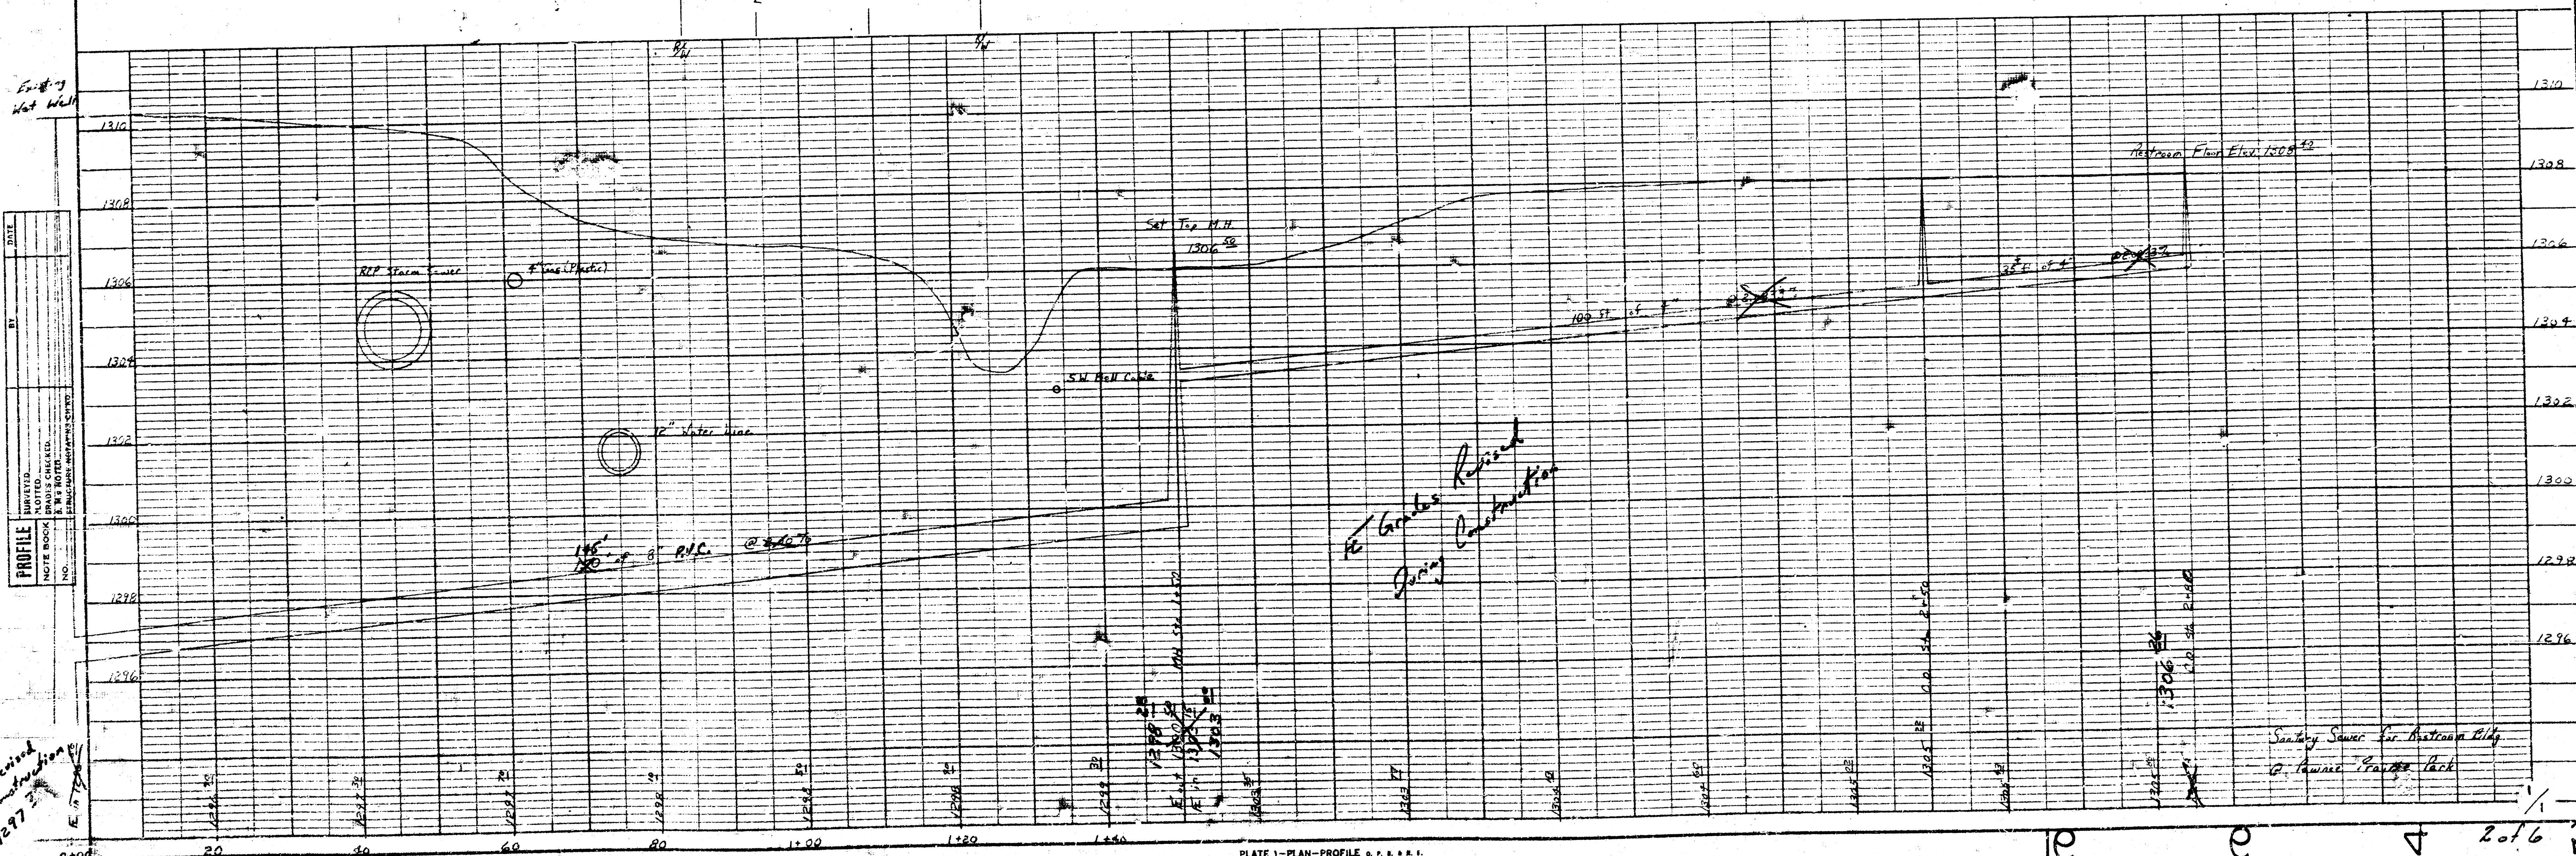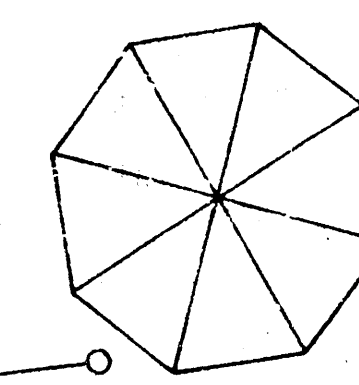

12 Grades Revised
During Construction

Sanitary Sewer for Astorham Bldg
@ Pioneer Park