


PLAN	DATE
SURVEYED	BY
ALIGNED	BY
NOTE BOOK	DATE
NO.	

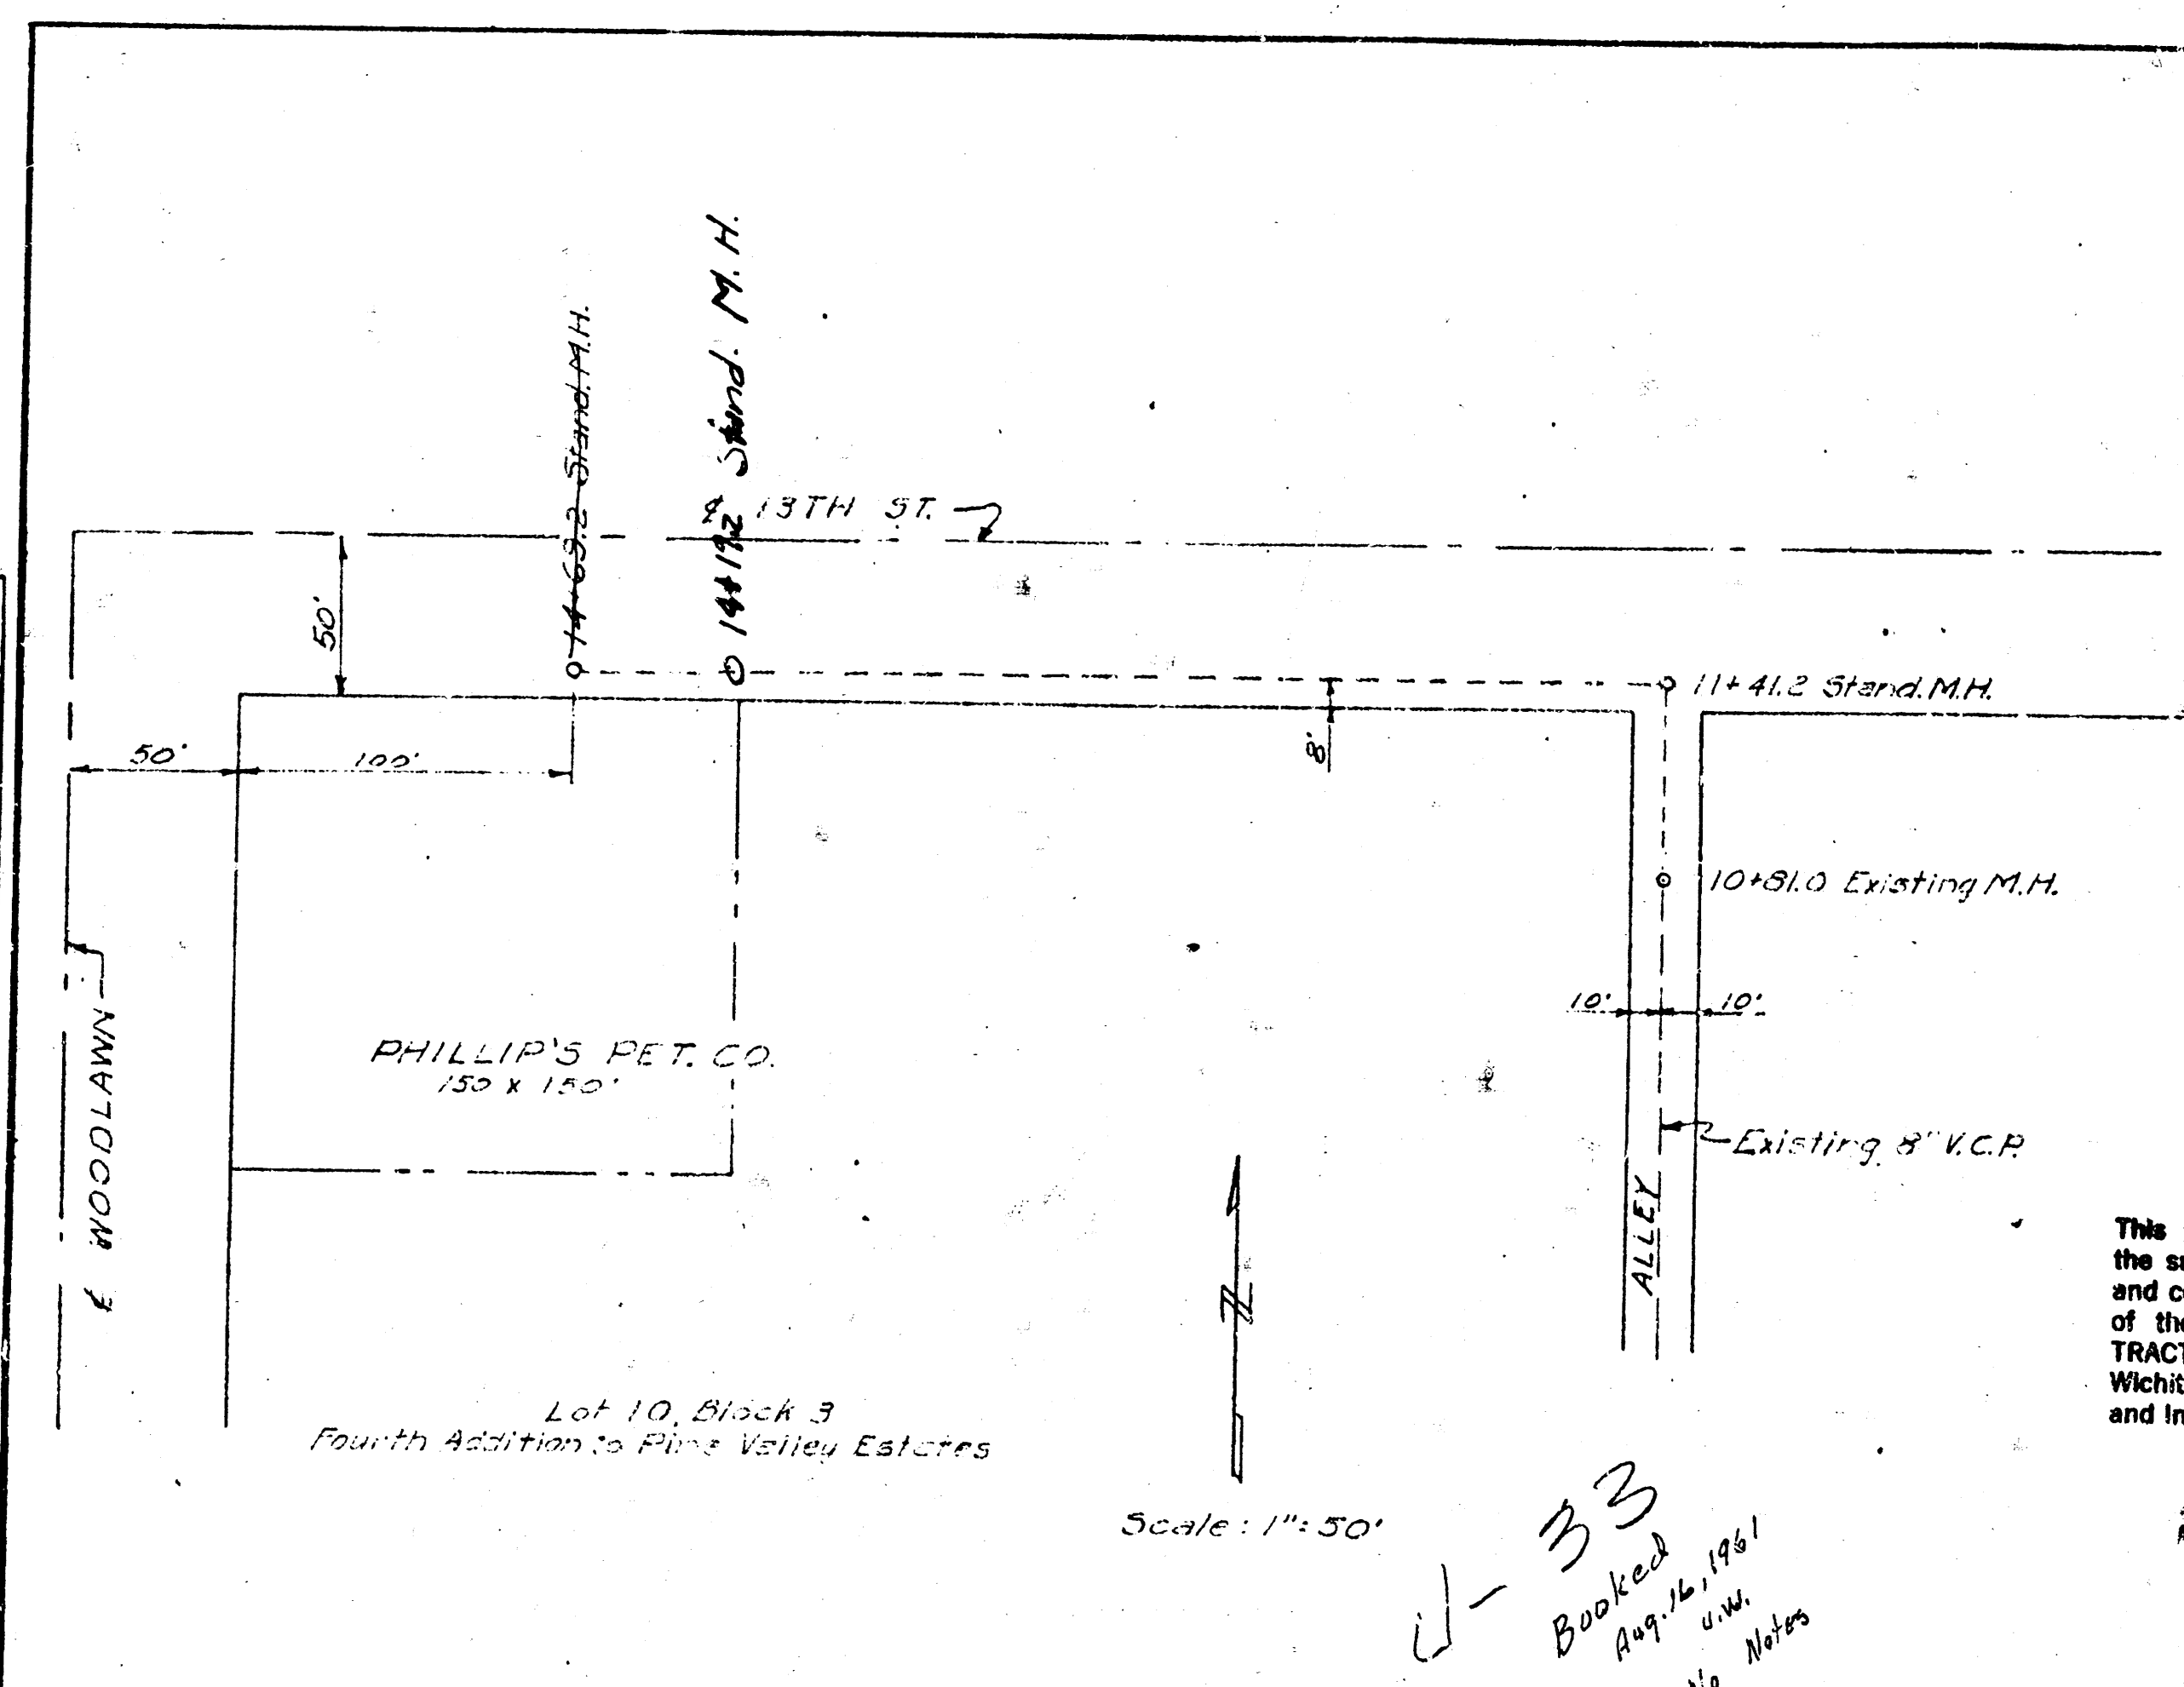


NOTE TO CONTRACTOR
 This project will be constructed under the supervision of the CITY ENGINEER and conforming to the SPECIFICATIONS of the CITY OF WICHITA. The CONTRACTOR will reimburse the City of Wichita for all cost of Engineering, Plans, and Inspection.

CITY OF WICHITA
 APPROVED: _____
 Date: 6/18/61
 Engineering Dr. Dan Sullivan

Handwritten: 33 Booked Aug. 16, 1961 d.w. No Notes

PROFILE	DATE
SURVEYED	BY
ALIGNED	BY
NOTE BOOK	DATE
NO.	

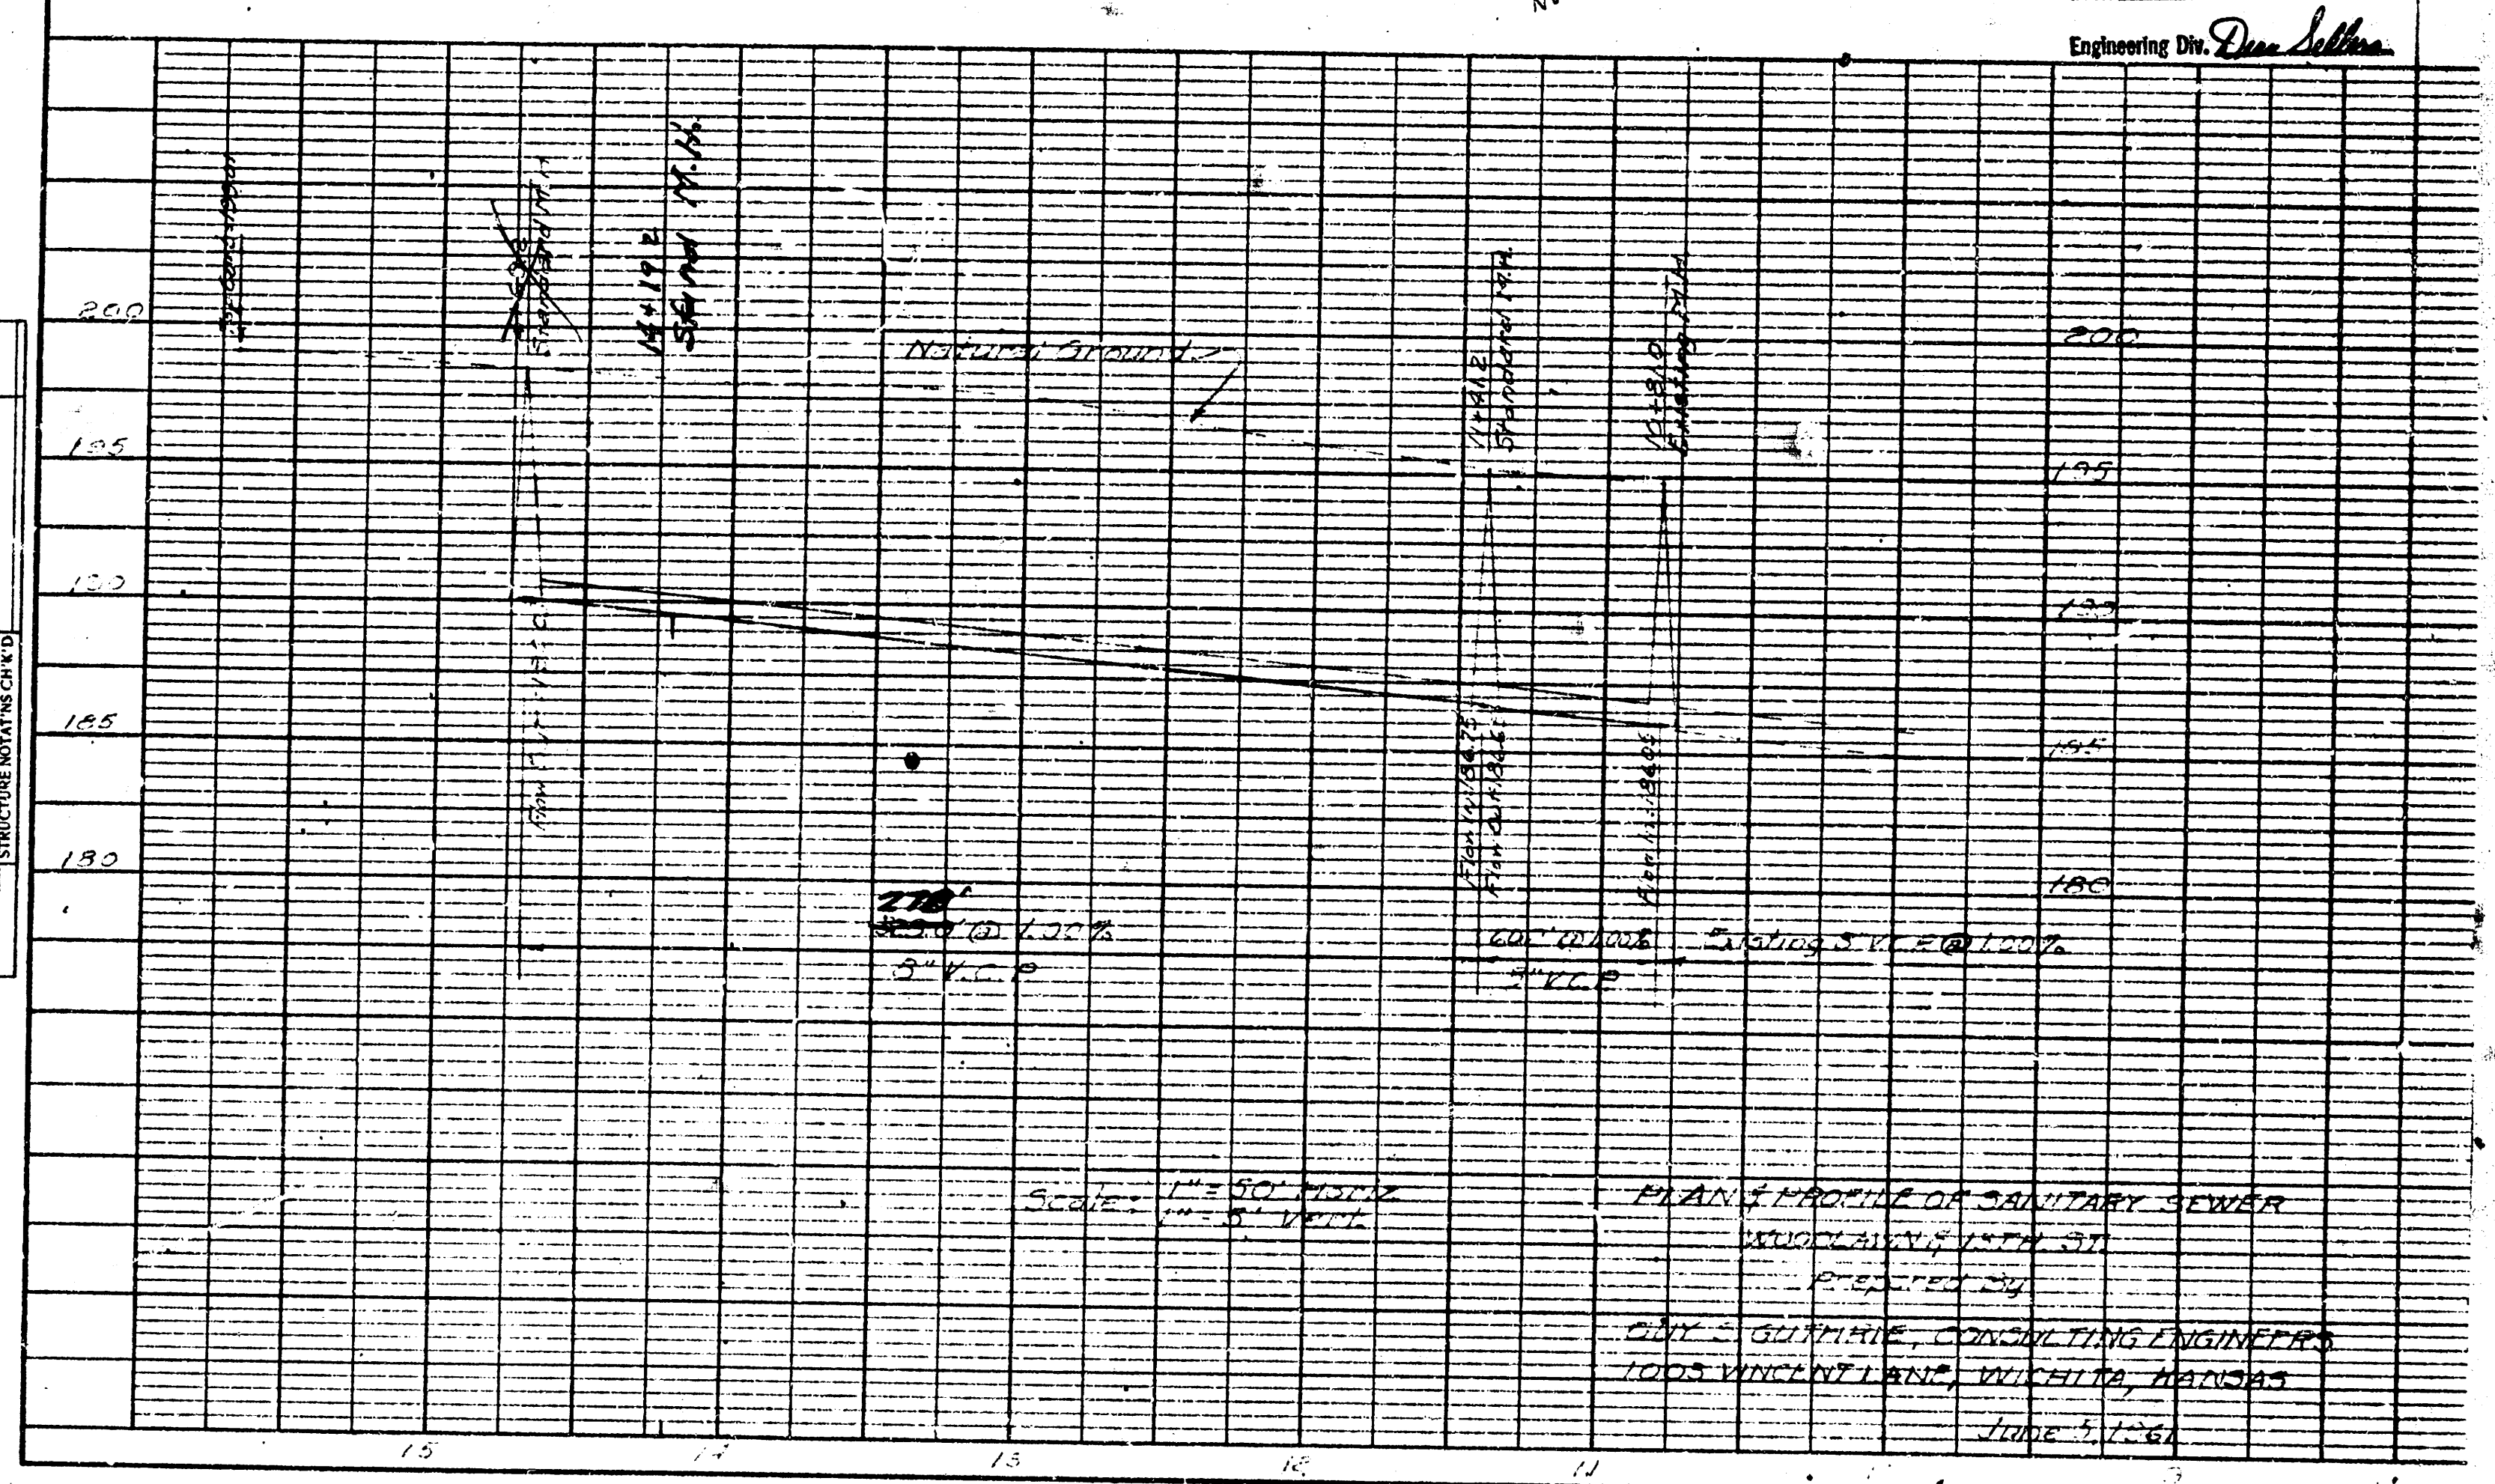

PLAN & PROFILE OF SANITARY SEWER
 1000 VINCENT LANE, WICHITA, KANSAS
 JUNE 1, 1961