


- NOTES
1. All manholes to be City of Wichita Standard Manholes, type A, M.H.-A1
  2. All manholes and sewers will be constructed in accordance with City of Wichita Specifications for these items.
  3. Sand backfill all sewer excavation.

7-18-73  
 APPROVED AS NOTED  
 by CITY ENGINEER OF WICHITA  
 Sanitary Sewers D.E.S.  
 Storm Sewers \_\_\_\_\_  
 Driveway Approaches \_\_\_\_\_

NOTE TO CONTRACTOR  
 This project will be constructed under the supervision of the CITY ENGINEER and conforming to the SPECIFICATIONS of the CITY OF WICHITA. The CONTRACTOR will reimburse the City of Wichita for all cost of Engineering, Plans and Inspection.

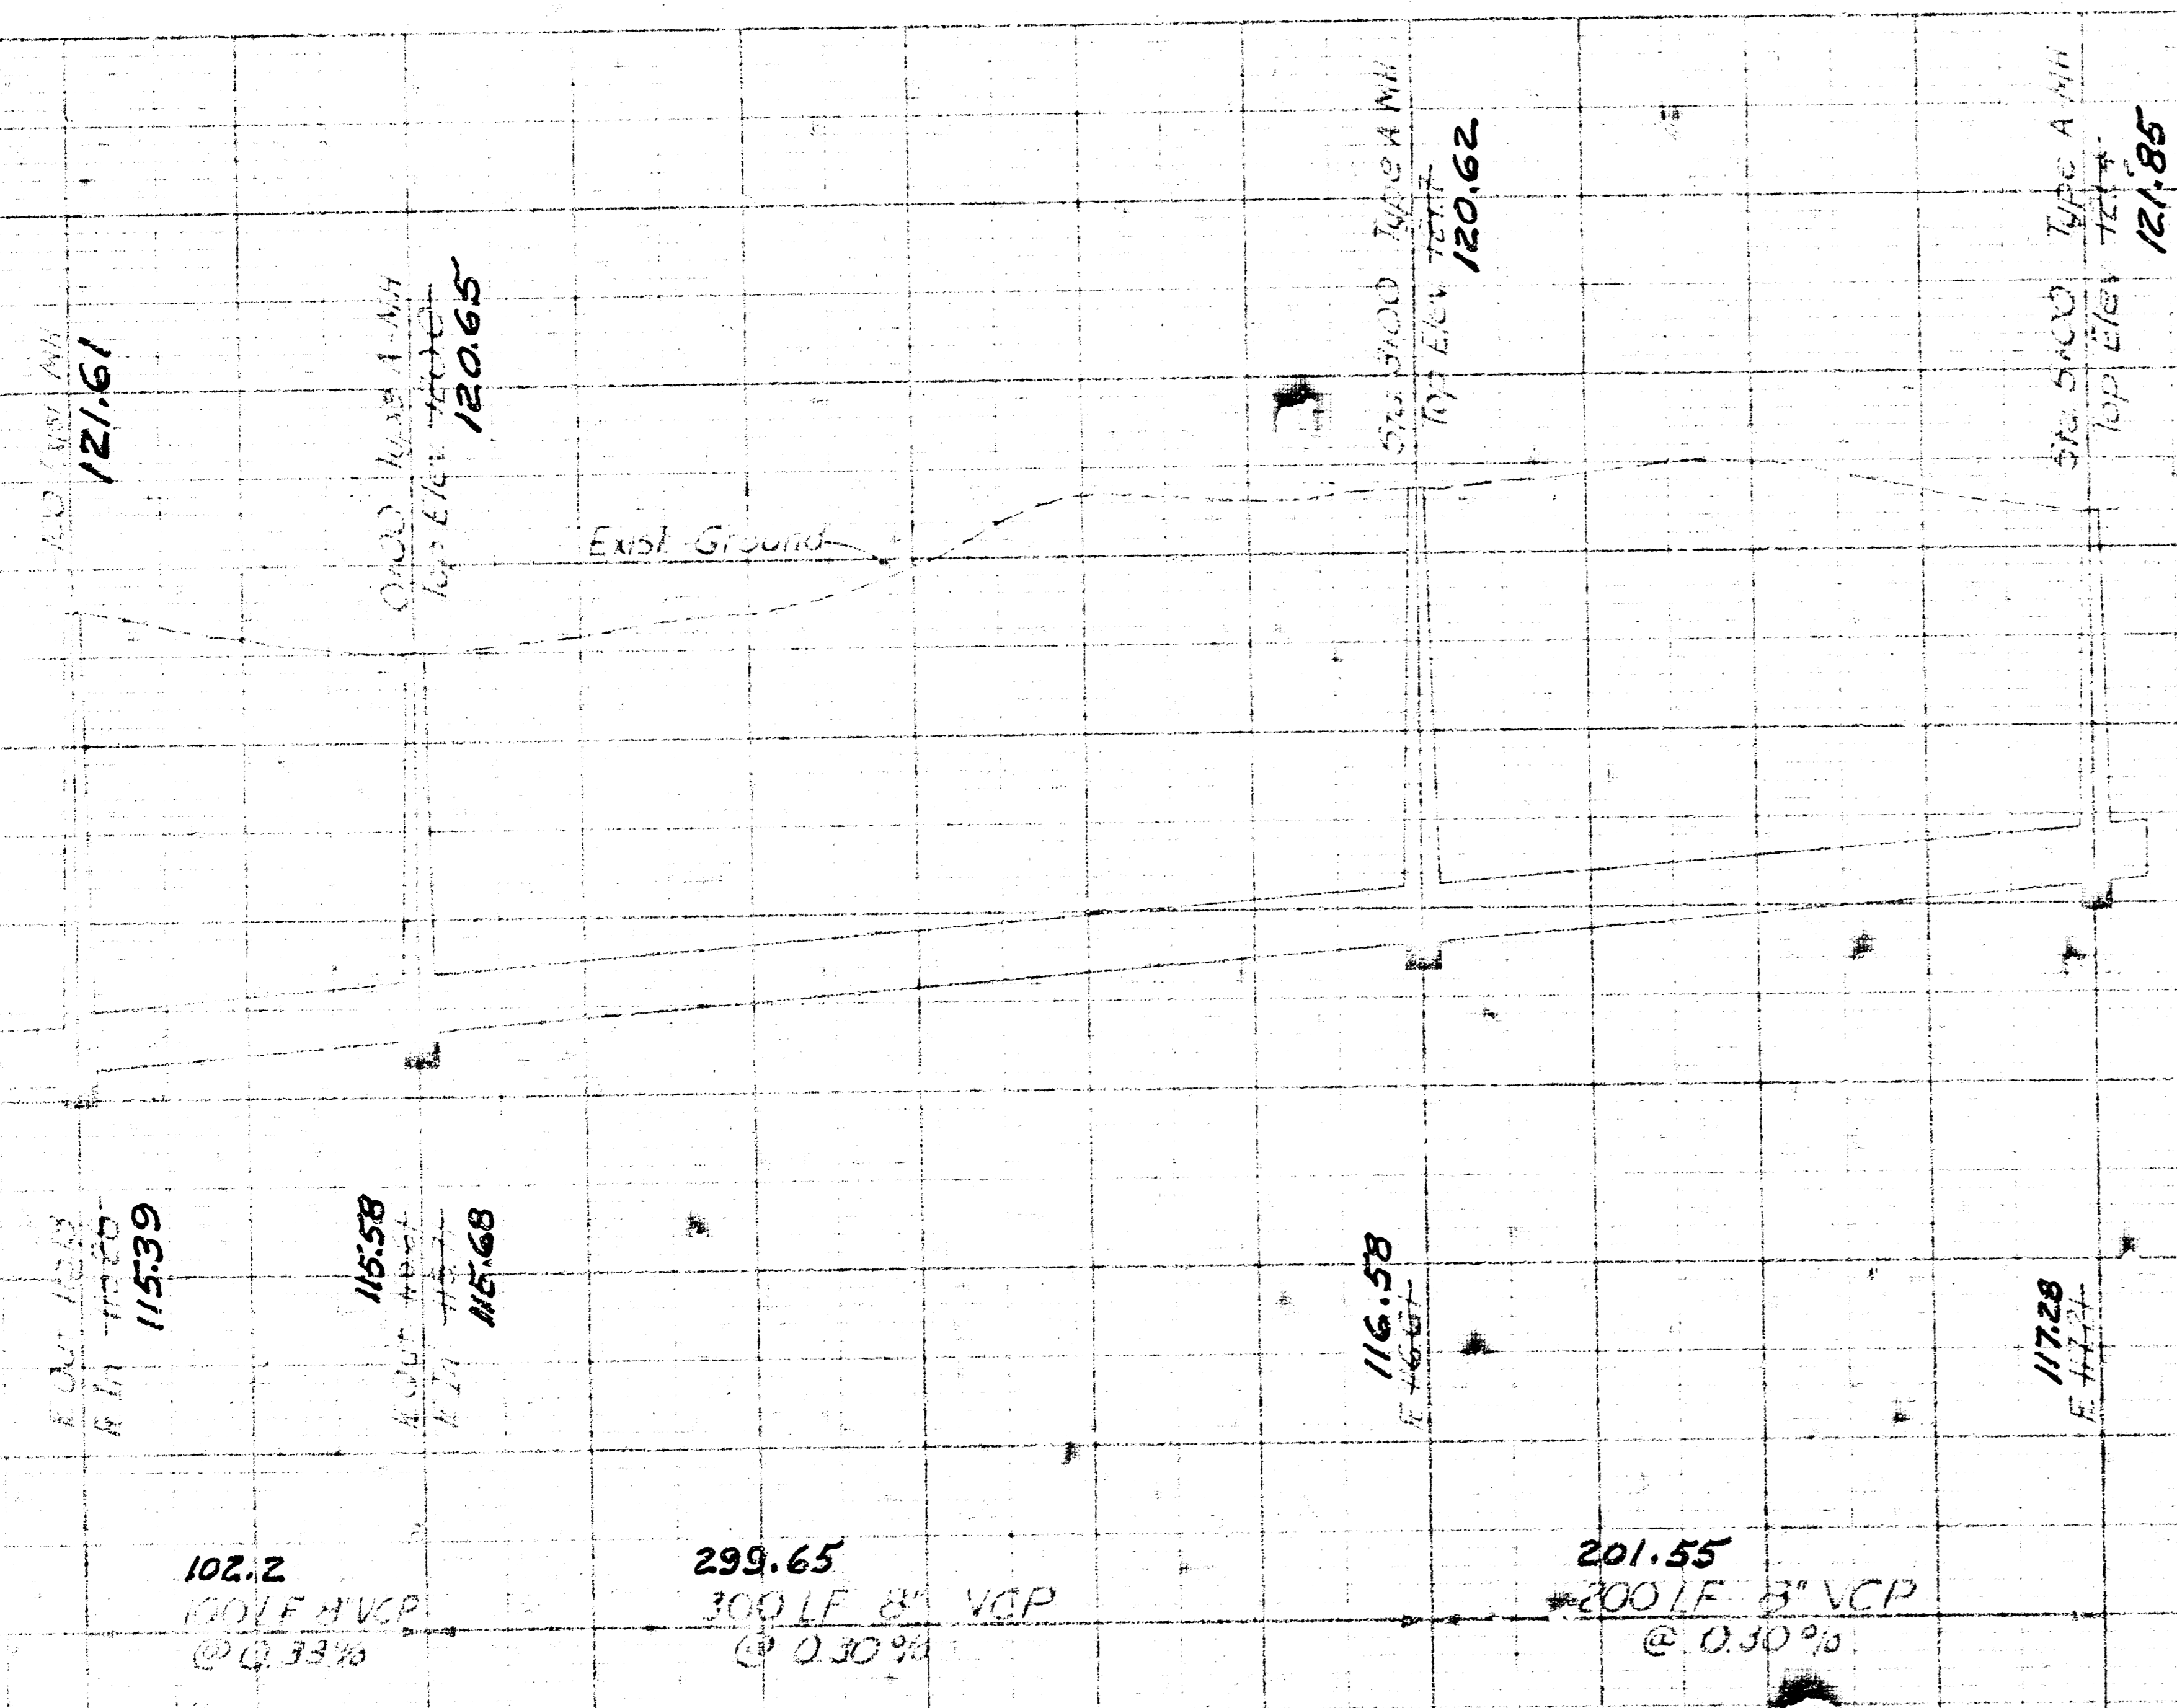

PLAZA WEST  
 SHOPPING CENTER  
 Sanitary Sewer 503045  
 Proj. No. BHB 50345

